


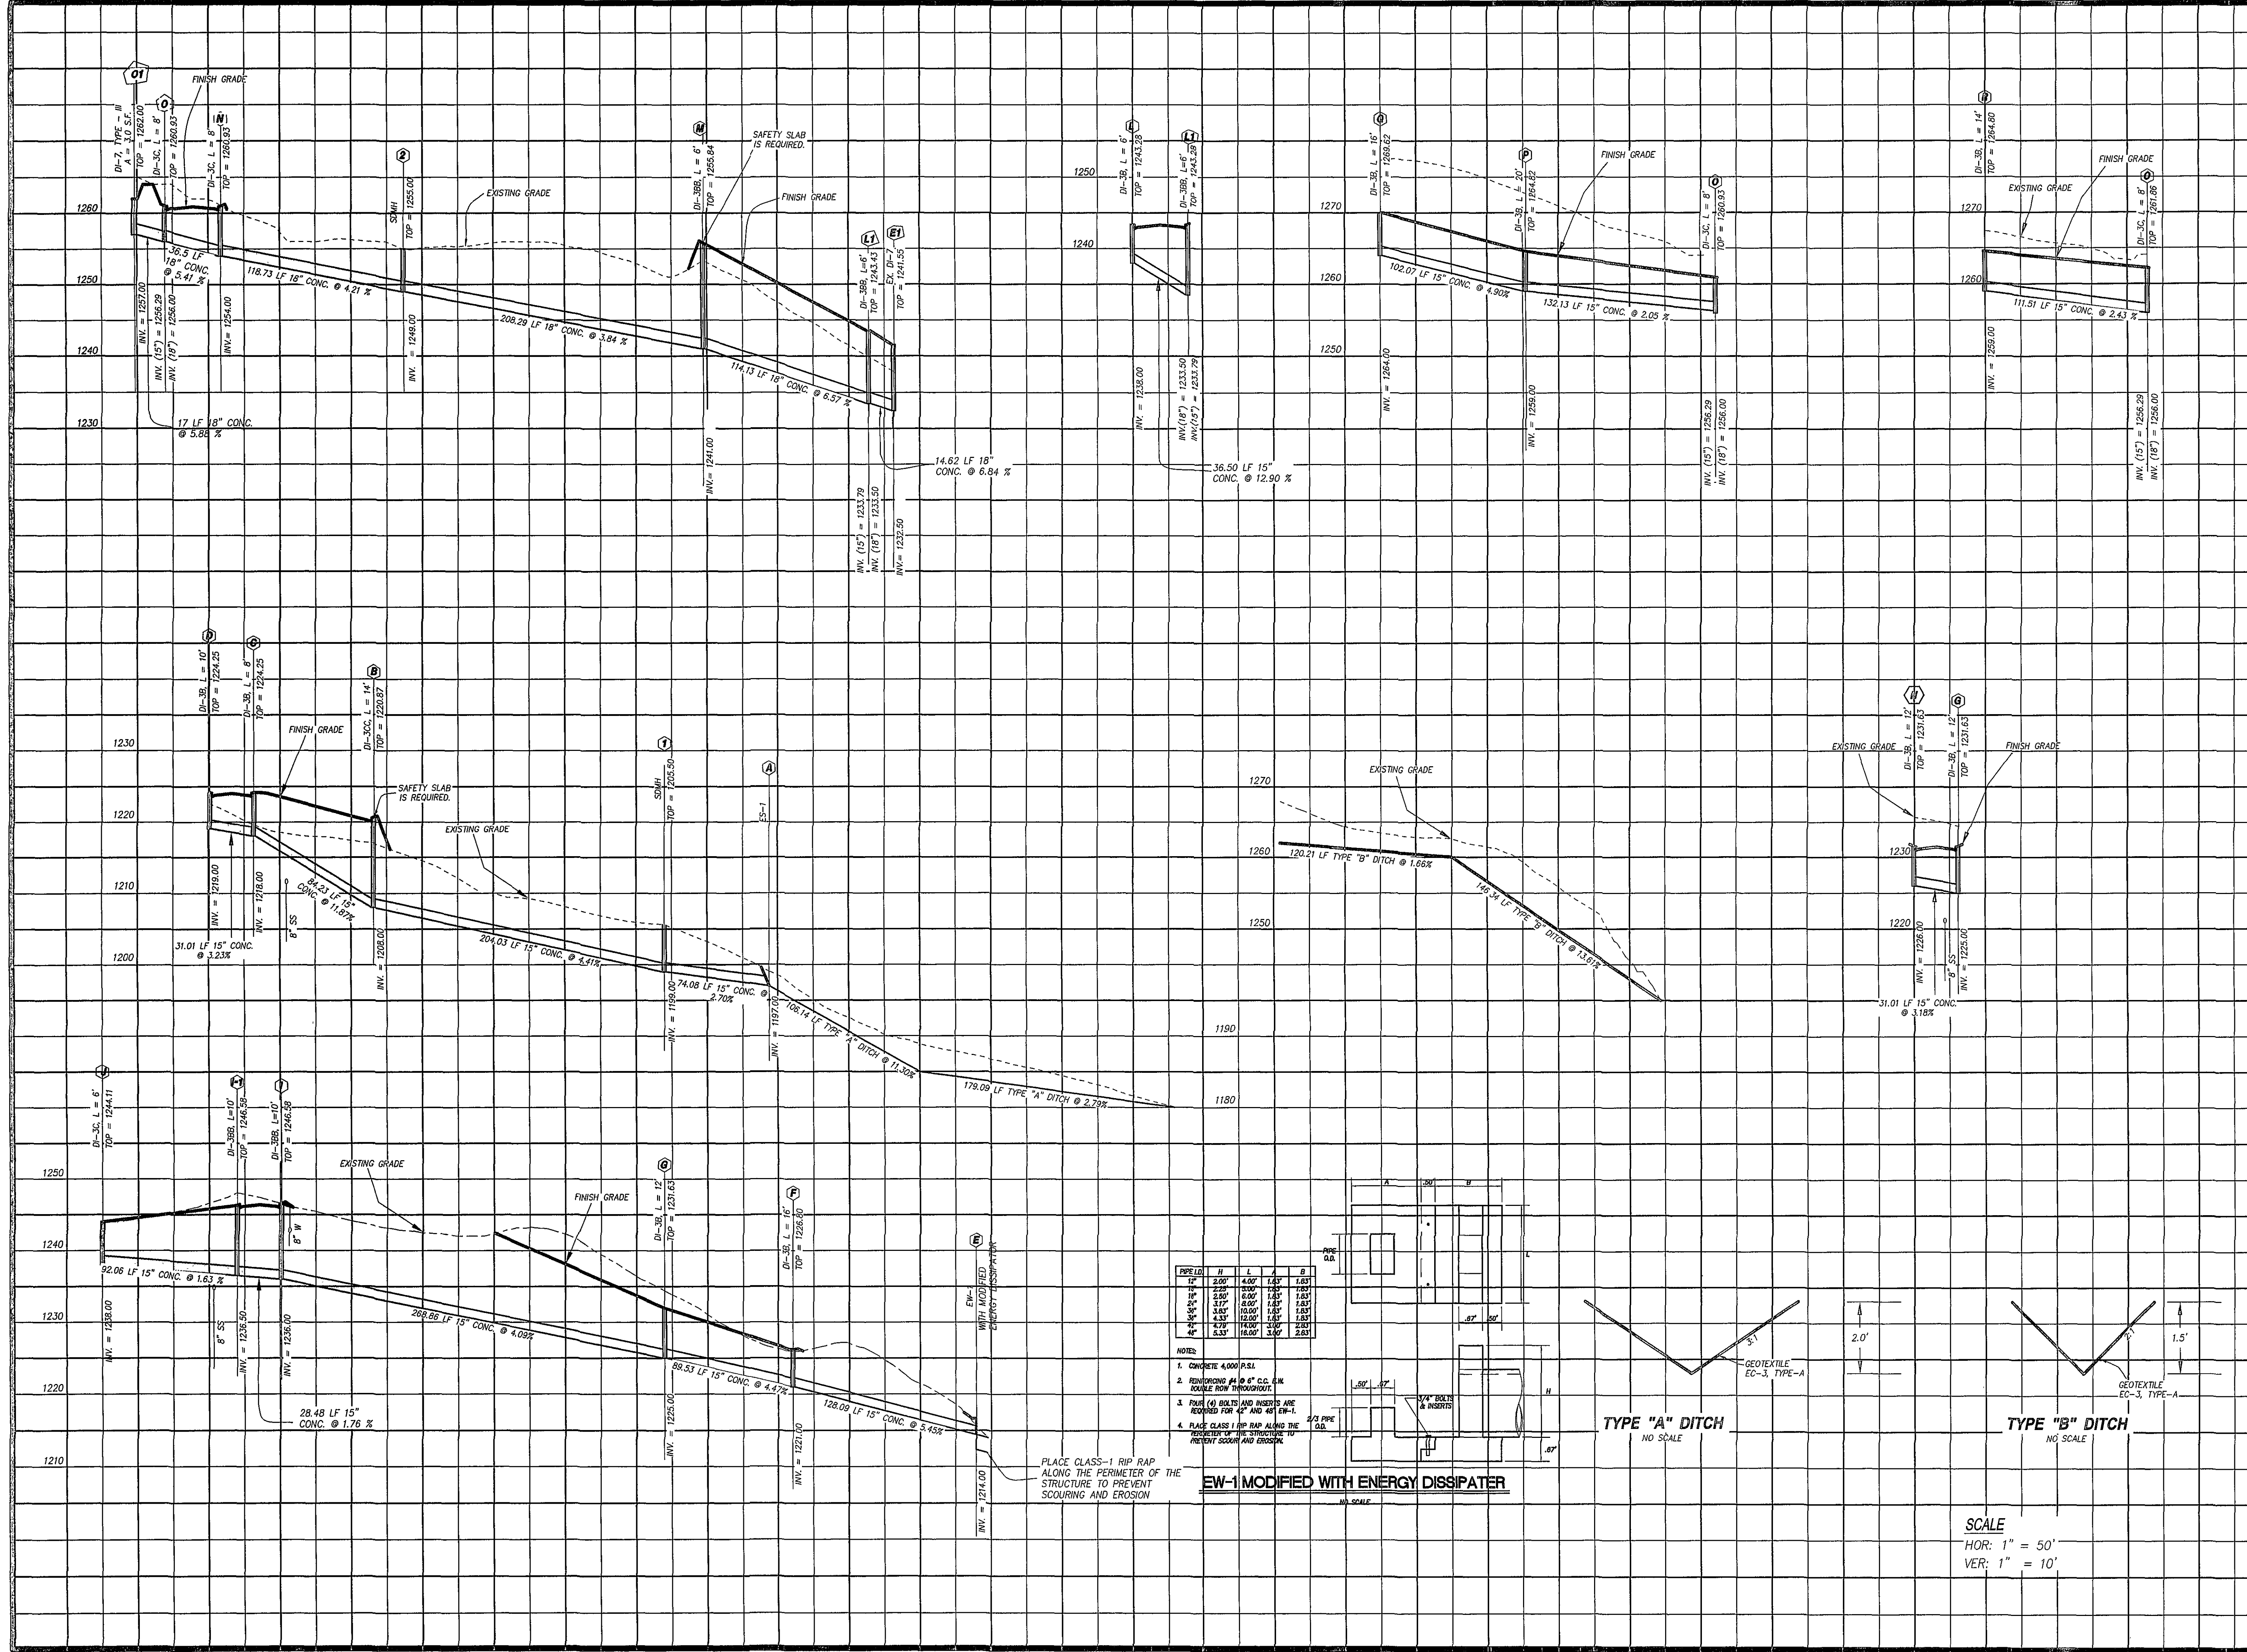

LUMSDEN ASSOCIATES, P.C.
ENGINEERS-SURVEYORS-PLANNERS
ROANOKE, VIRGINIA

PHONE: (540) 774-4411
FAX: (540) 772-9443
P.O. BOX 20669
ROANOKE, VIRGINIA 24018
E-MAIL: MAIL@LUMSDENPC.COM

SECTION No. 11
WISTERIA PLACE AT THE ORCHARDS
F & W COMMUNITY DEVELOPMENT CORP
HOLLINS MAGISTERIAL DISTRICT
ROANOKE COUNTY, VIRGINIA

NO.	DATE	DESCRIPTION
1	5/16/05	REVISED DRAWING NAME & ROAD
2	9/16/2005	AS-BUILT FROM WMA
3		GPS FIELD WORK
4		
5		

DATE: MAY 10, 2004
SCALE: AS SHOWN
COMMISSION NO.: 2003-133
CADD FILE: F:\2003\10313\ENG\10313COMP.DWG
SHEET 11 OF 13