



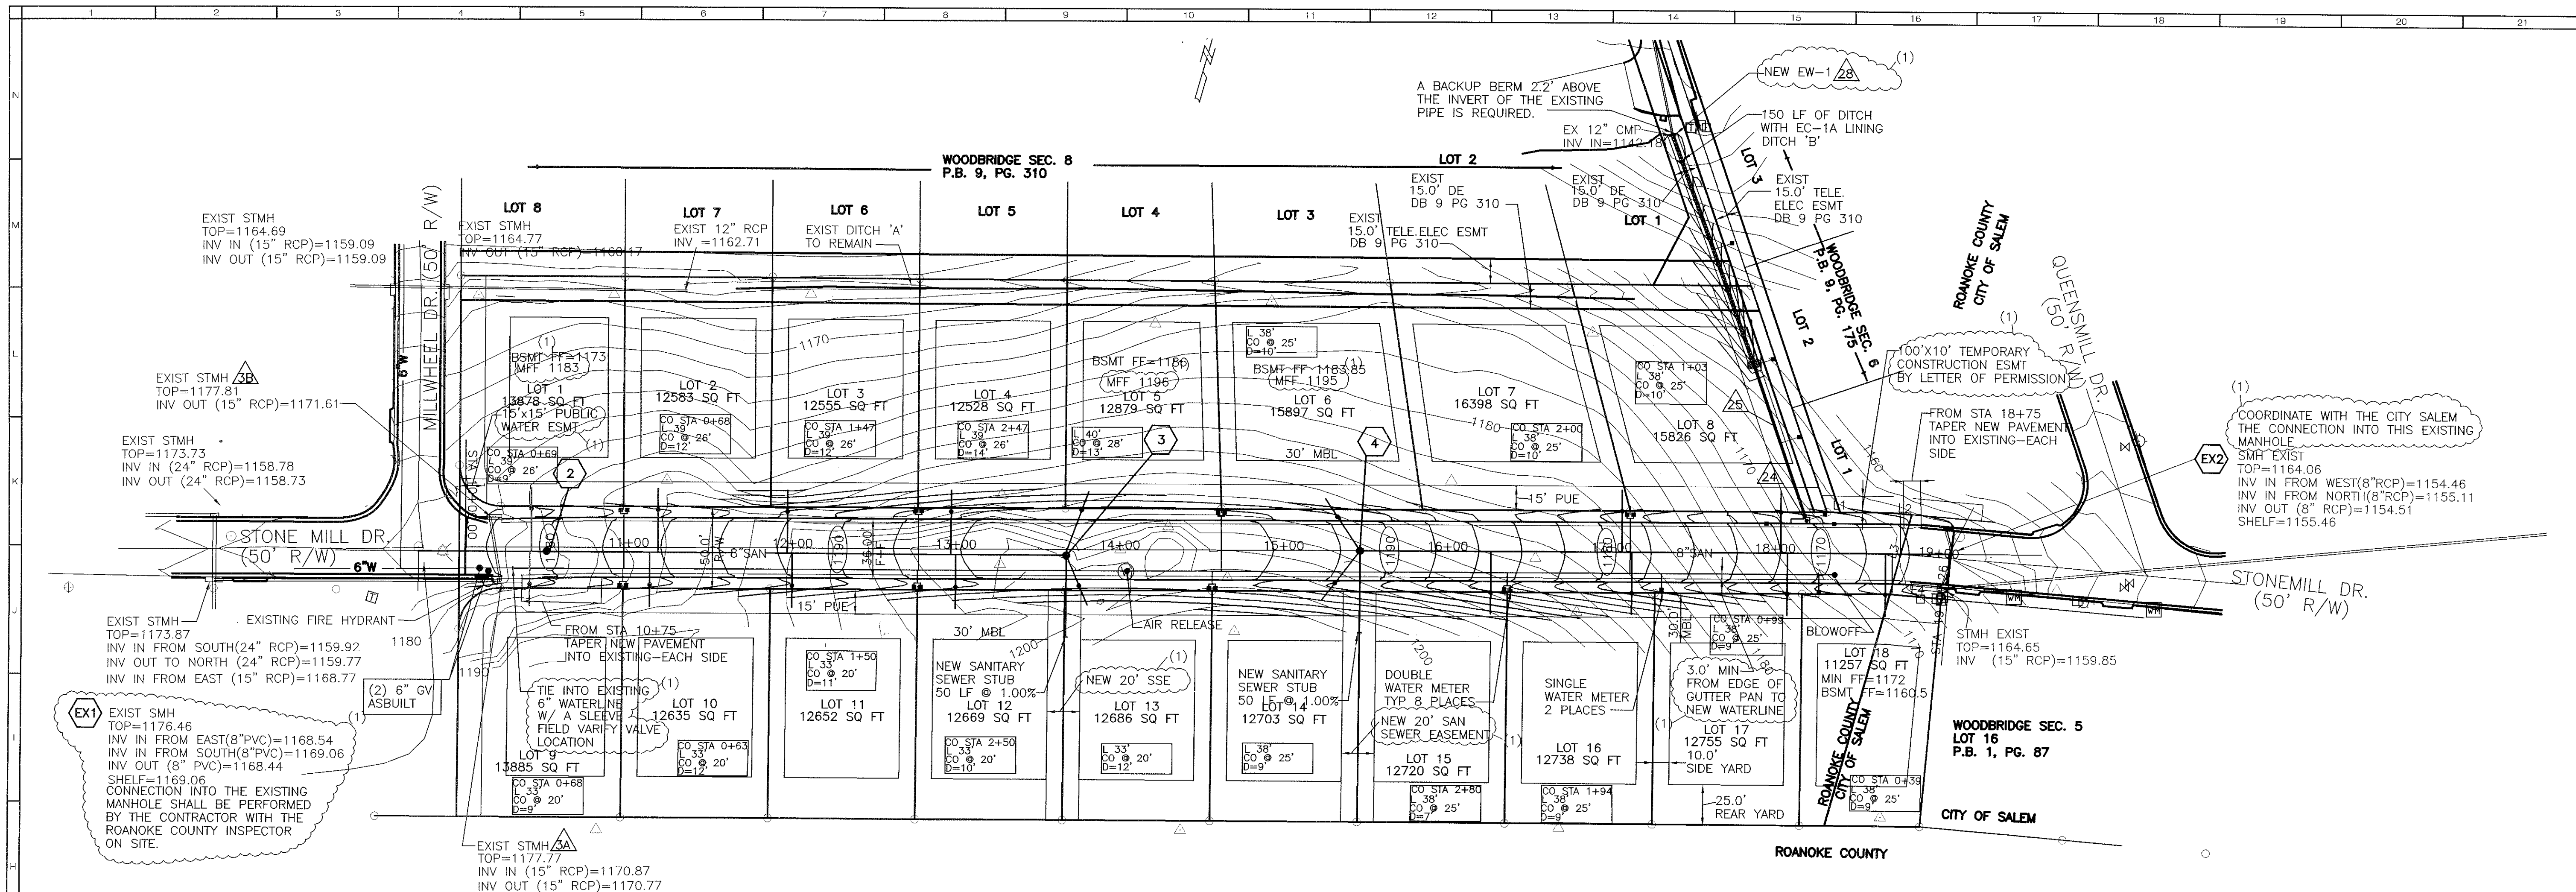


STONE MILL DRIVE-PLAN
SCALE: 1"=50'

N/F
HELEN M. & KAREN N.
JOHNSTON
TM# 56.03-2-43
DB 470 DC 519

LINE BEARING	DIST.
L1 N74°13'56"E	40.64'
L2 N78°59'50"E	11.31'
L3 S00°38'44"E	50.44'
L4 N78°59'50"E	31.66'

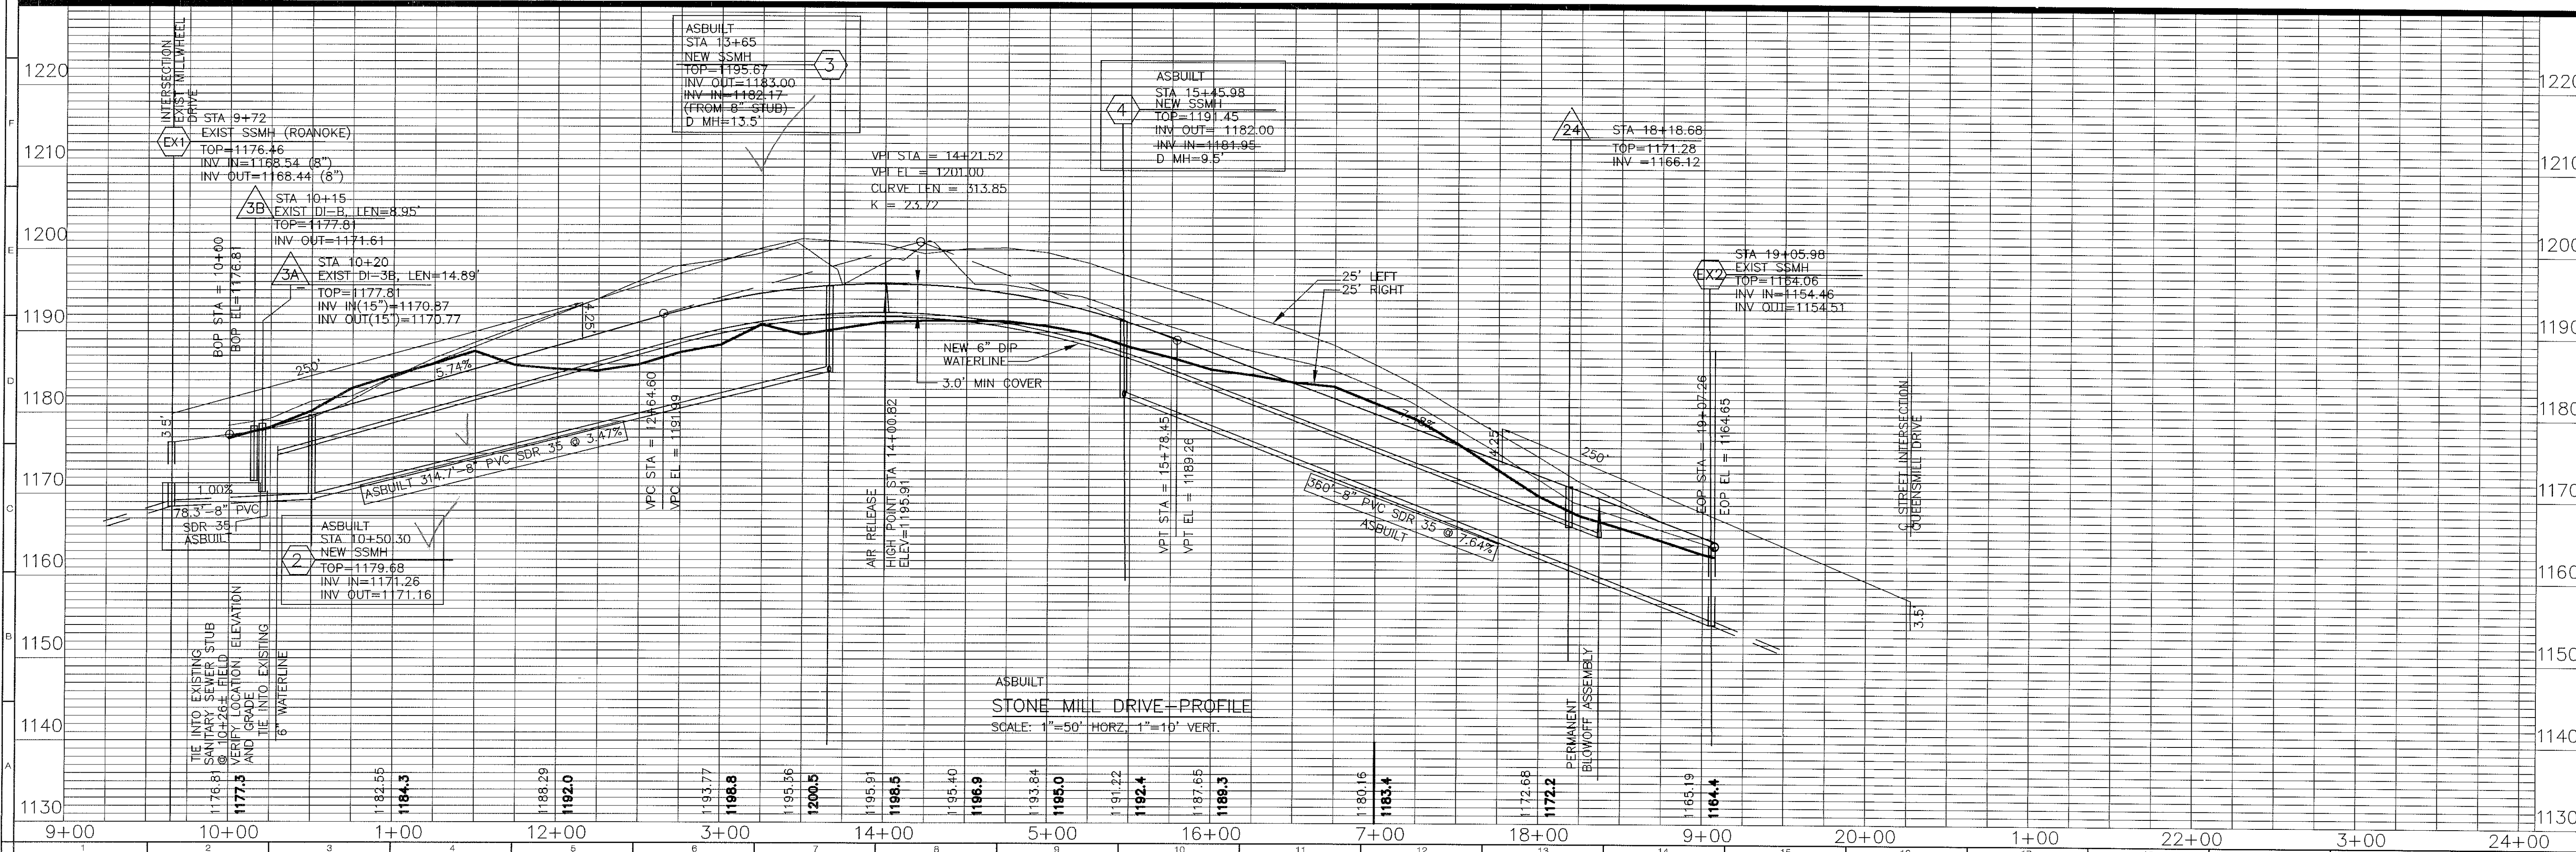

STONE MILL DRIVE-PROFILE
SCALE: 1"=50' HORIZ, 1"=10' VERT.

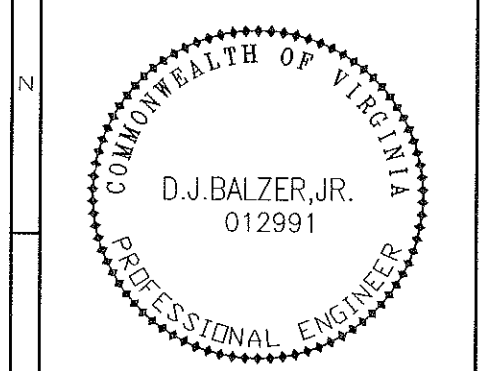

BALZER
AND ASSOCIATES, INC.
BALZER
REFLECTING TOMORROW
• PLANNERS • ARCHITECTS
• ENGINEERS • SURVEYORS

1208 Corporate Circle
Roanoke, Virginia 24018
Phone: 804/772-9580
FAX: 804/772-8050

501 Branchway Road
Suite 100
Richmond, Virginia 23296
Phone: 804/794-0571
FAX: 804/794-2635

880 Technology Park Drive
Suite 200
Glen Allen, Virginia 23059
Phone: 804/553-0132
FAX: 804/553-0133

WOODBRIDGE
SECTION 18
ASBUILT-PLAN AND PROFILE
CATAWBA DISTRICT
ROANOKE COUNTY, VIRGINIA

DRAWN BY: DRB
DESIGNED BY: DRB
CHECKED BY: DJB
DATE: SEPT 27, 1999
REVISIONS:
(1) 11-5-99
(2) 11-30-99
(3) 12-3-99
(4) 5-17-00
(5) 8-22-00
(6) 11-08-04

SCALE: AS SHOWN
SHEET NO.
C3
JOB NO.
R99147