
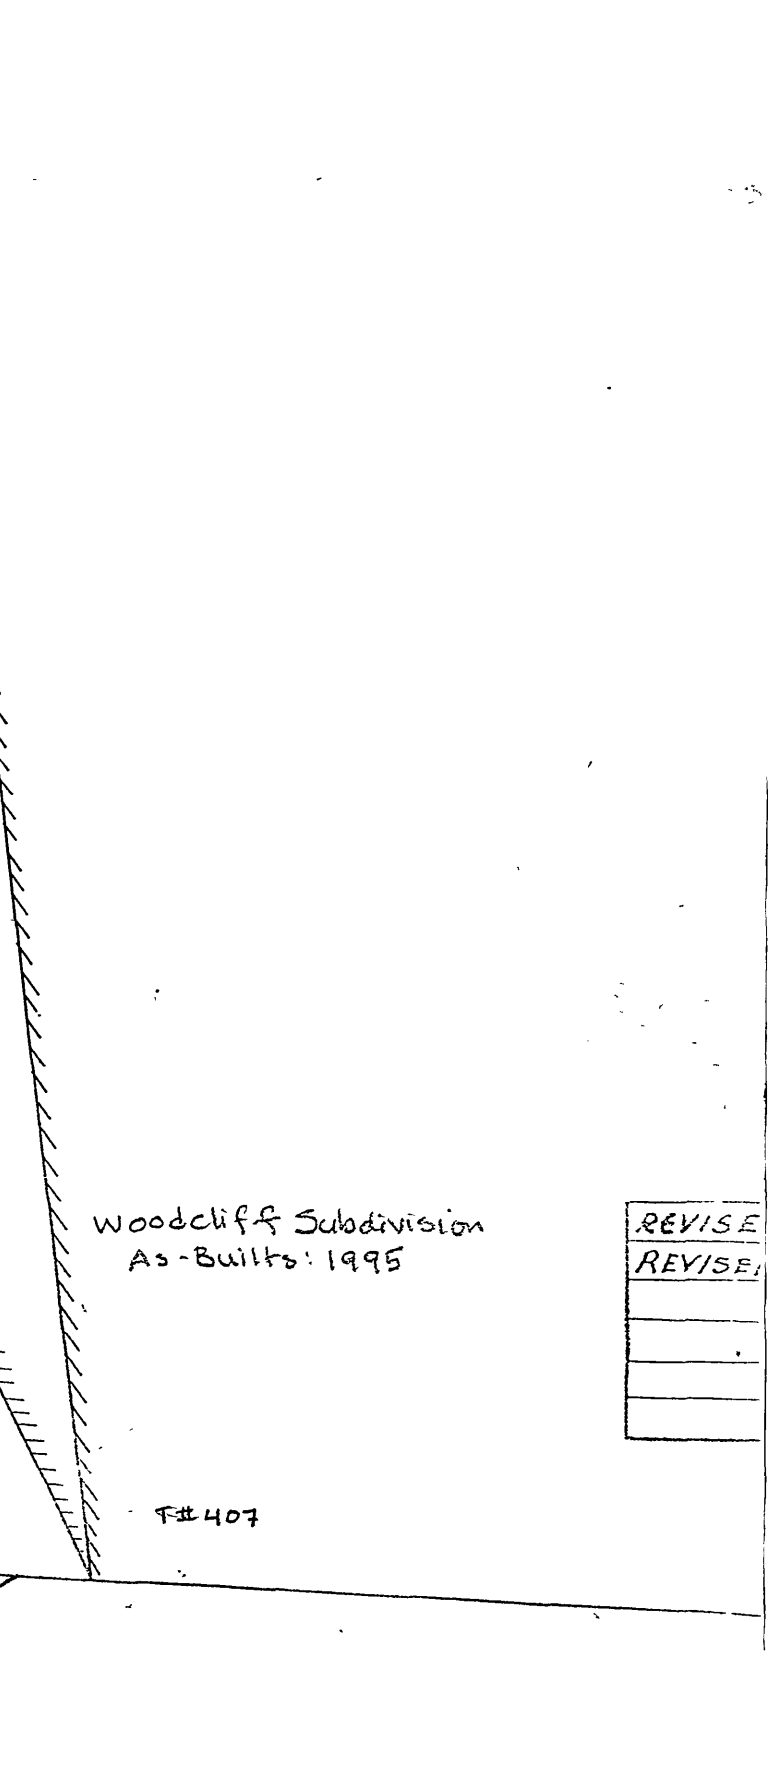
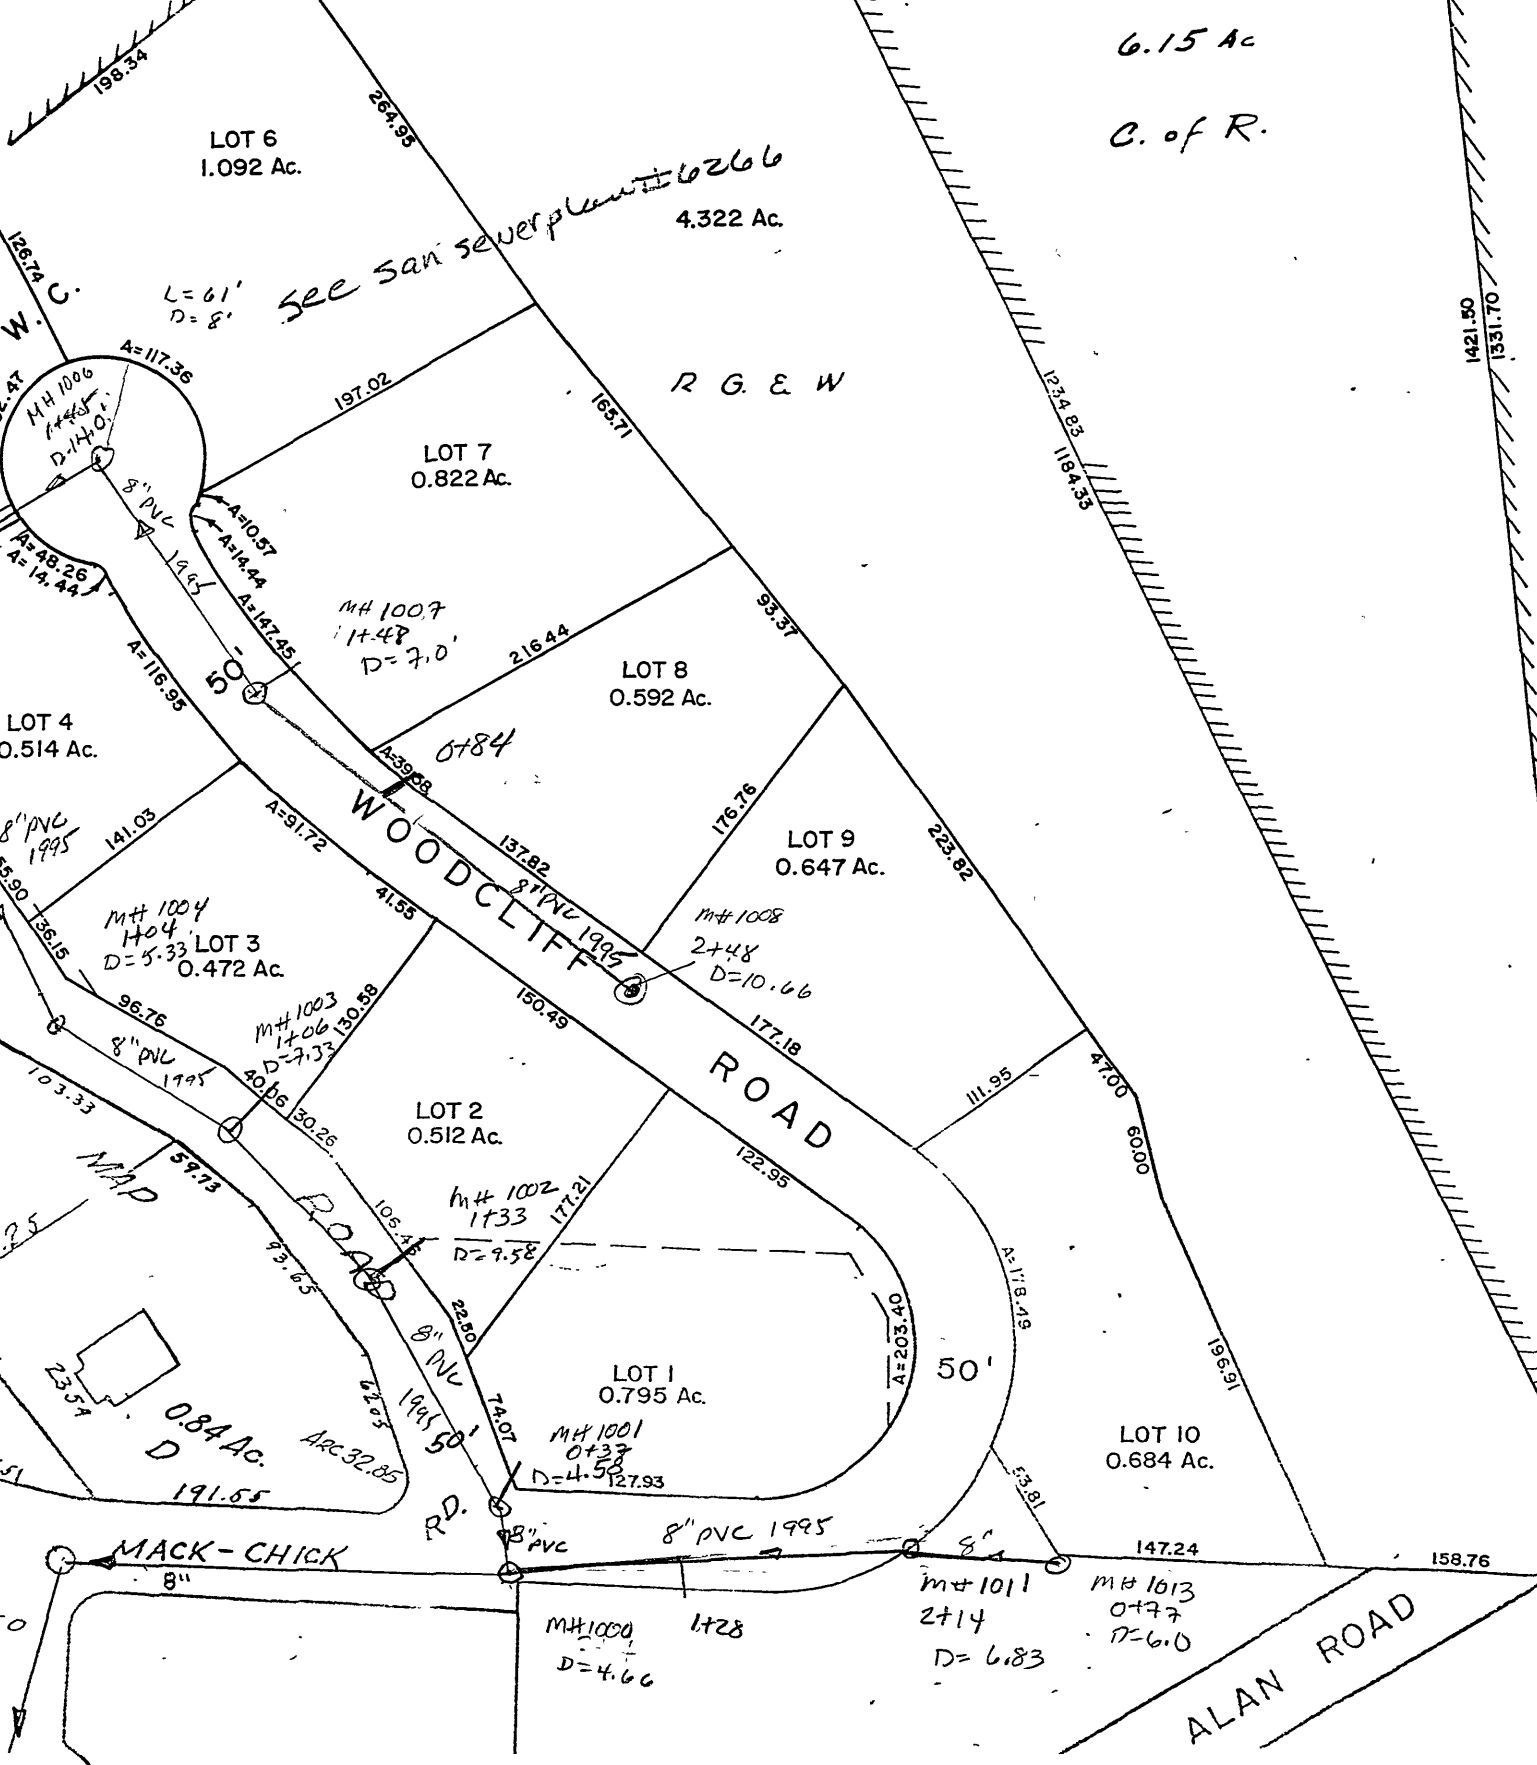
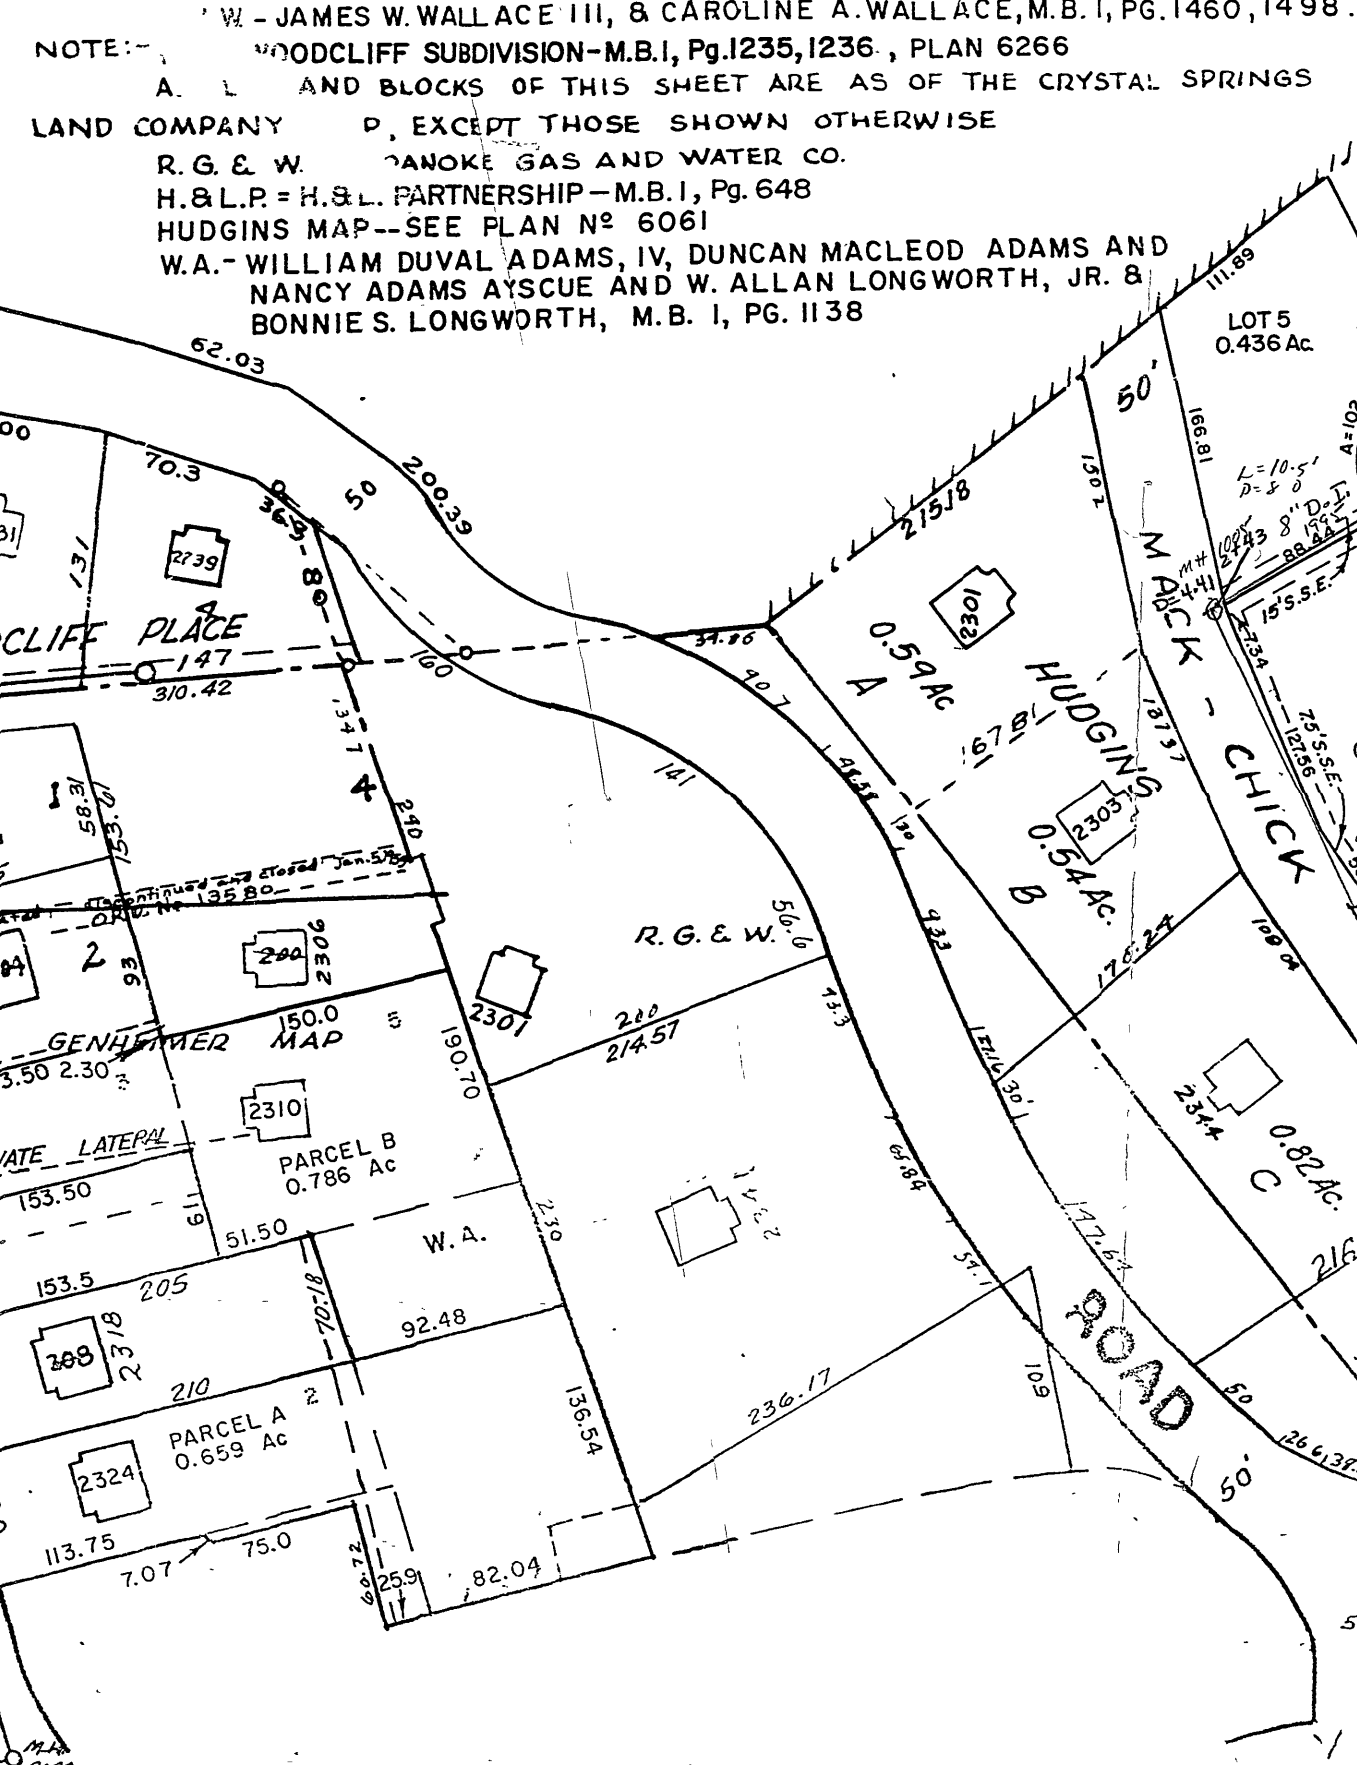
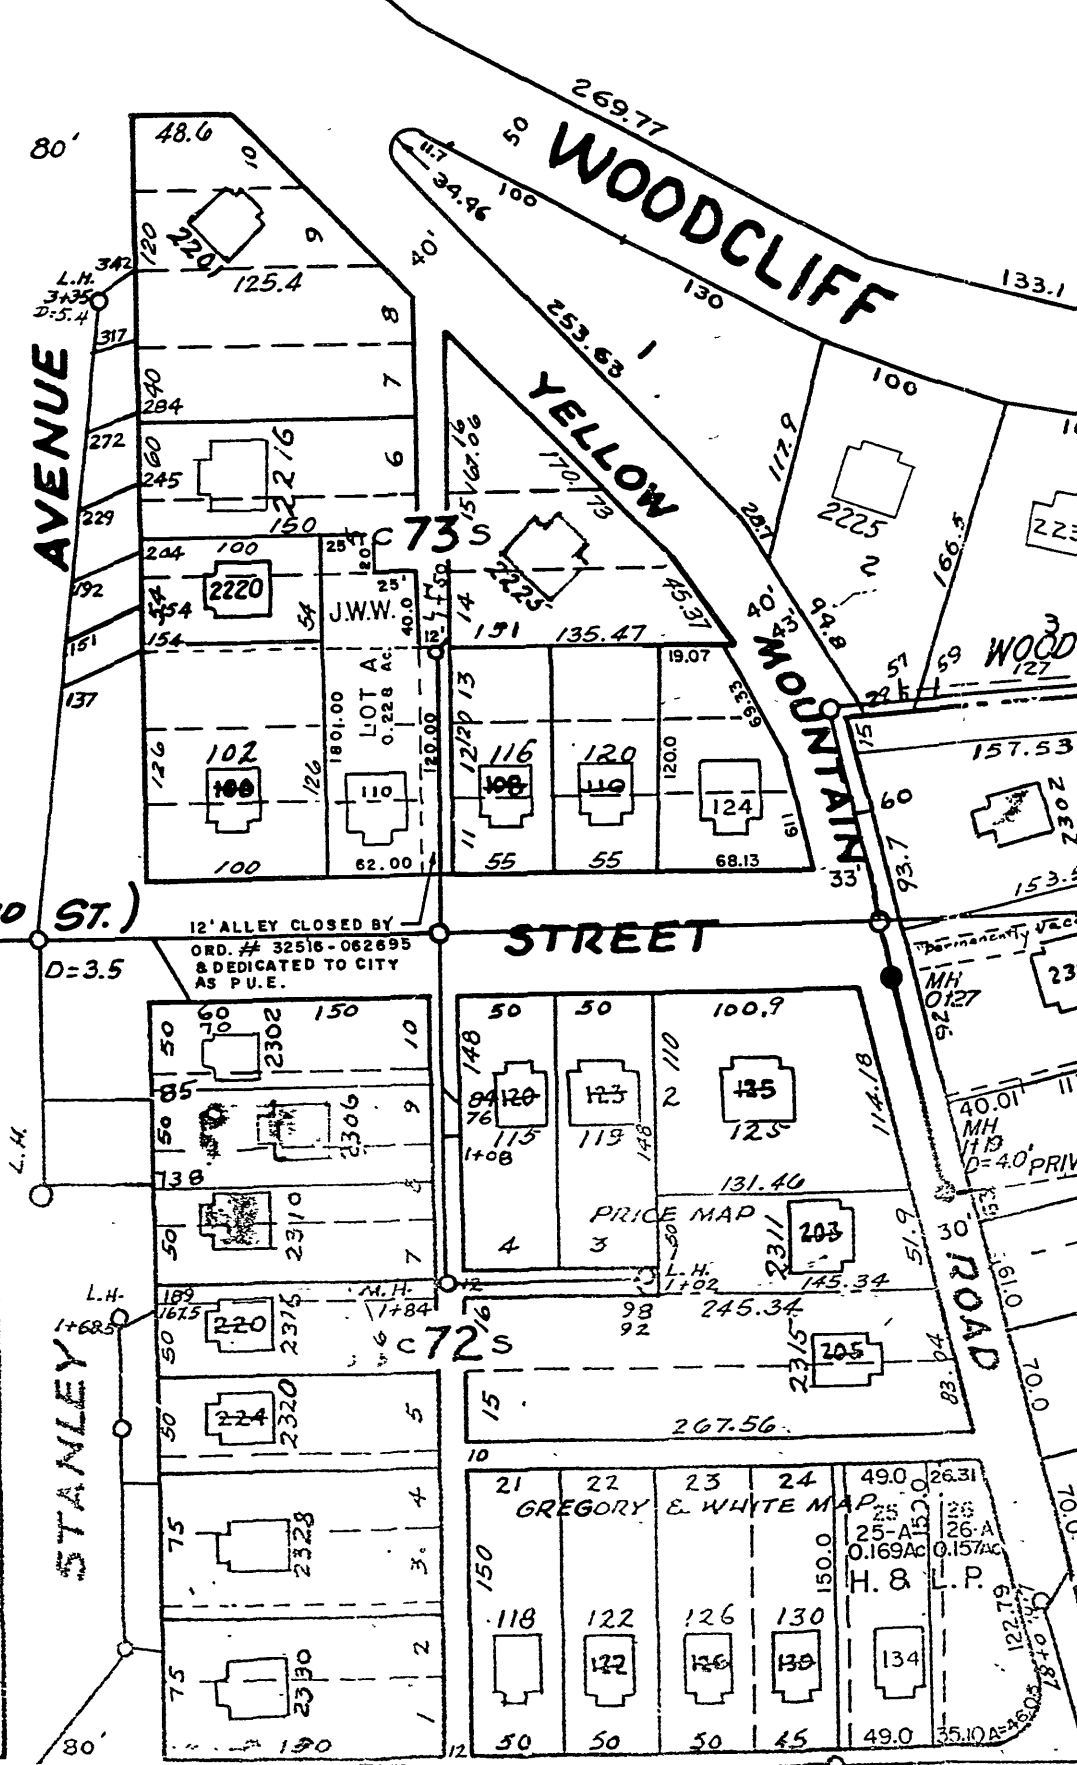


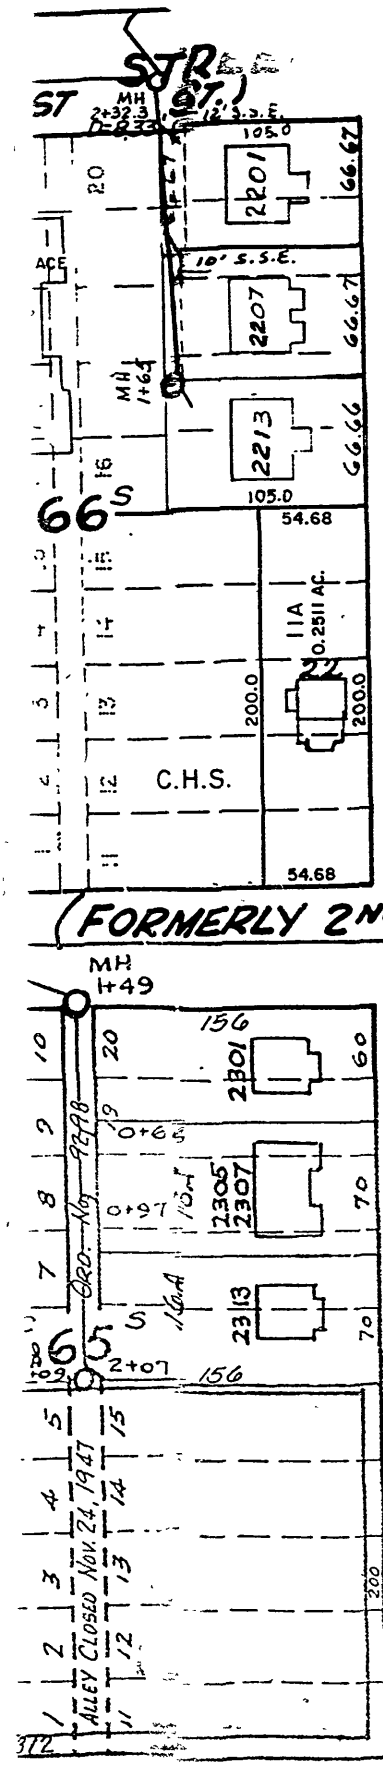

J.P.C.-SOUTH JEFFERSON PLACE CONDOS-M.B.I., PG. 1626-1628
S.-C.H.S. INC.-M.B.I., PG. 1525
W.-JAMES W. WALLACE III, & CAROLINE A. WALLACE, M.B.I., PG. 1460, 1498.
NOTE: WOODCLIFF SUBDIVISION-M.B.I., PG. 1235, 1236, PLAN 6266
A. L. AND BLOCKS OF THIS SHEET ARE AS OF THE CRYSTAL SPRINGS
LAND COMPANY P, EXCEPT THOSE SHOWN OTHERWISE
R.G. & W. PANOKO GAS AND WATER CO.
H.&L.P.=H.&L. PARTNERSHIP-M.B.I., PG. 648
HUDGINS MAP-SEE PLAN N° 6061
W.A.-WILLIAM DUVAL ADAMS, IV, DUNCAN MACLEOD ADAMS AND
NANCY ADAMS AYSUE AND W. ALLAN LONGWORTH, JR. &
BONNIE S. LONGWORTH, M.B. I, PG. 1138

6.15 Ac
C. of R.

Woodcliff Subdivision
As-Built: 1995

REVISE
REVISE