



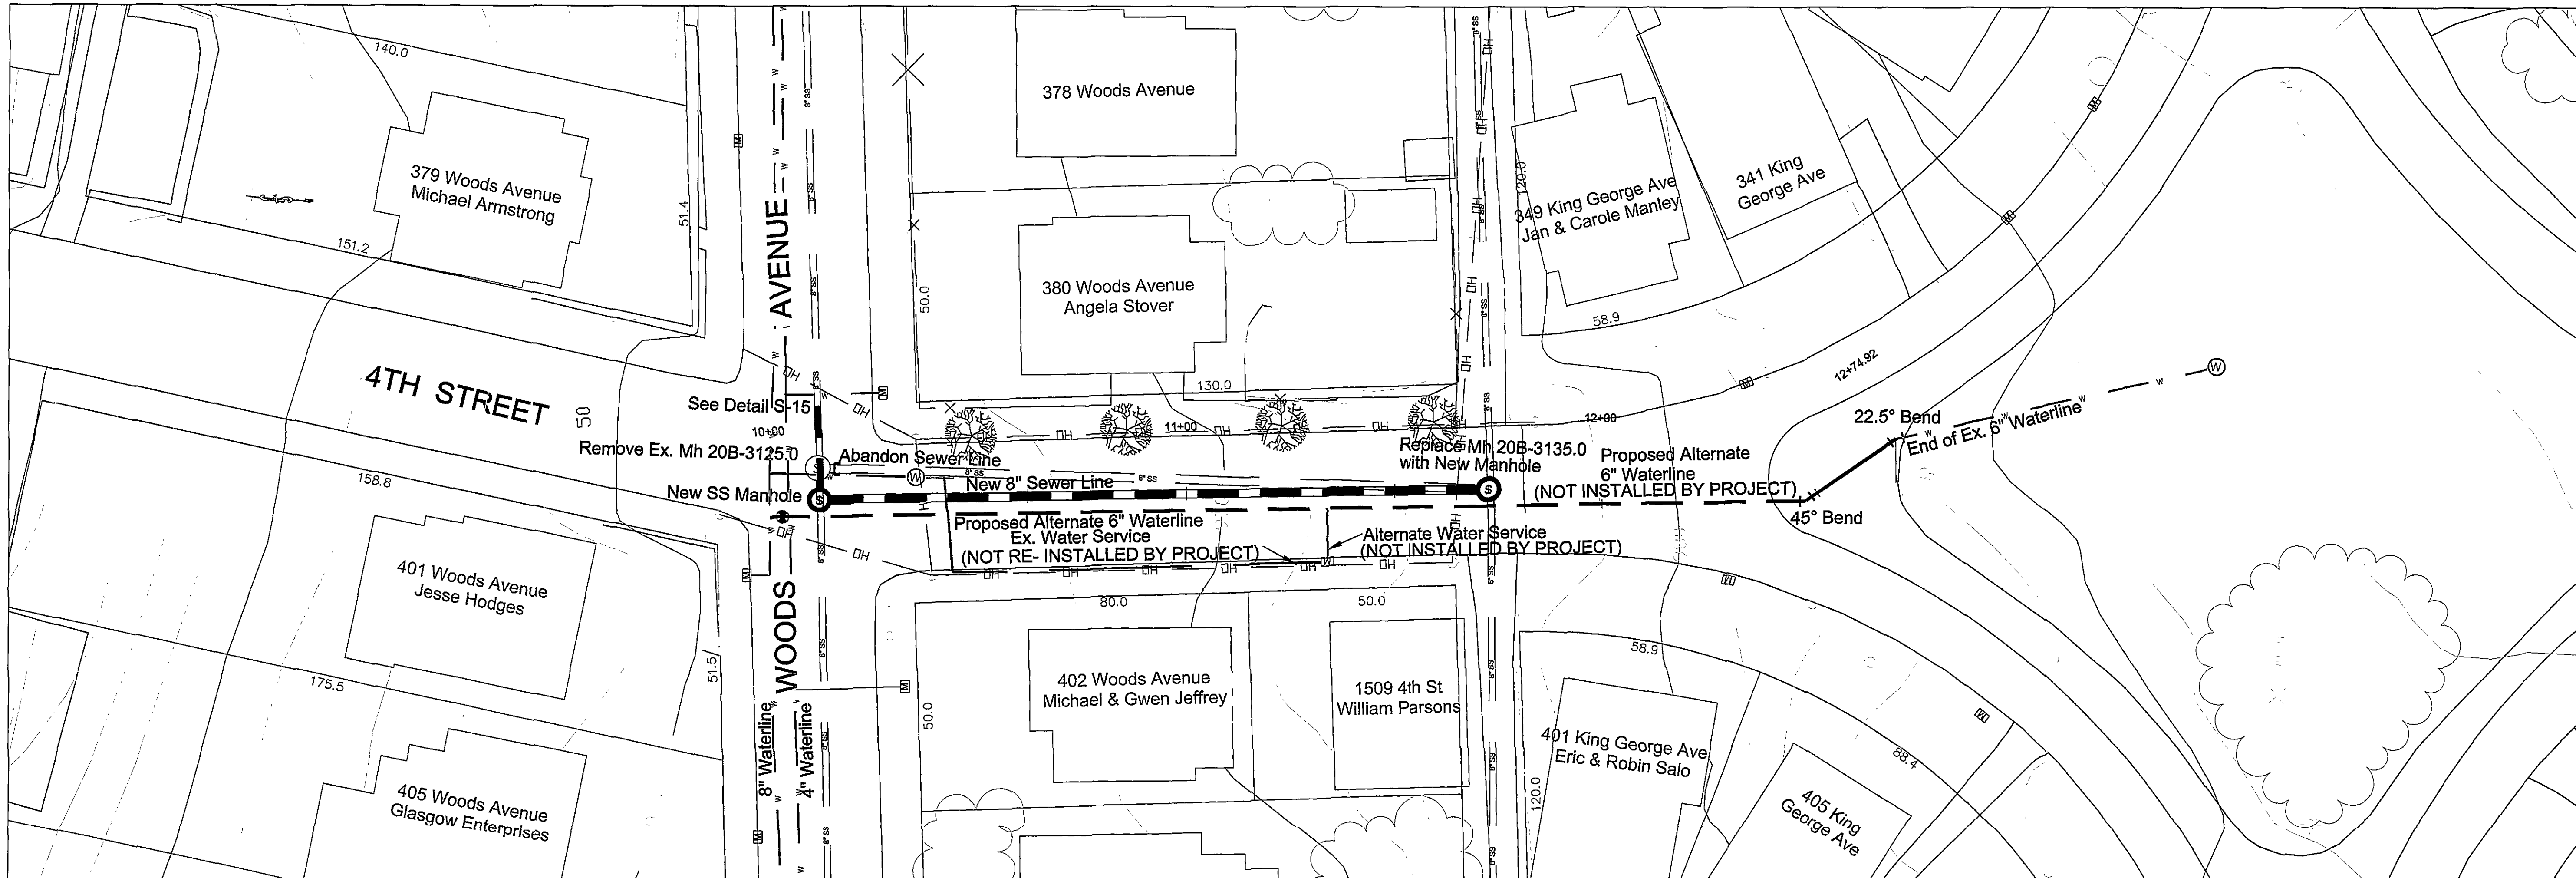

WESTERN VIRGINIA
WATER AUTHORITY
ENGINEERING SERVICES
601 S JEFFERSON ST, SUITE 300
ROANOKE, VA 24011
540-853-5700

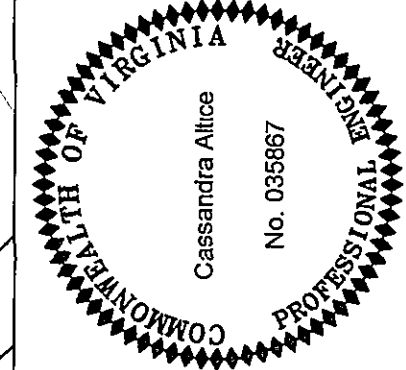


**380 WOODS AVENUE
SEWER REPLACEMENT
CIVIL/SITEWORK
PLAN**



Legend:

- New Sewer Manhole
- New Sewer line
- Ex. Waterline
- Ex. Water Meter
- Ex. Overhead Electric Lines
- Ex. Sanitary Sewer

- NOTES:**
- Contractor shall verify all manhole inverts prior to construction.
 - Water Service at 1509 4th Street -
 - Shall be replaced in existing location if it is galvanized and the alternate waterline is not constructed
 - New water service (as shown on the plans) shall be constructed if the alternate waterline is constructed.
 - If alternate waterline is constructed, the existing 6" waterline on 4th St from the intersection of Woods and 4th St, will be abandoned and the valve will be removed below grade.

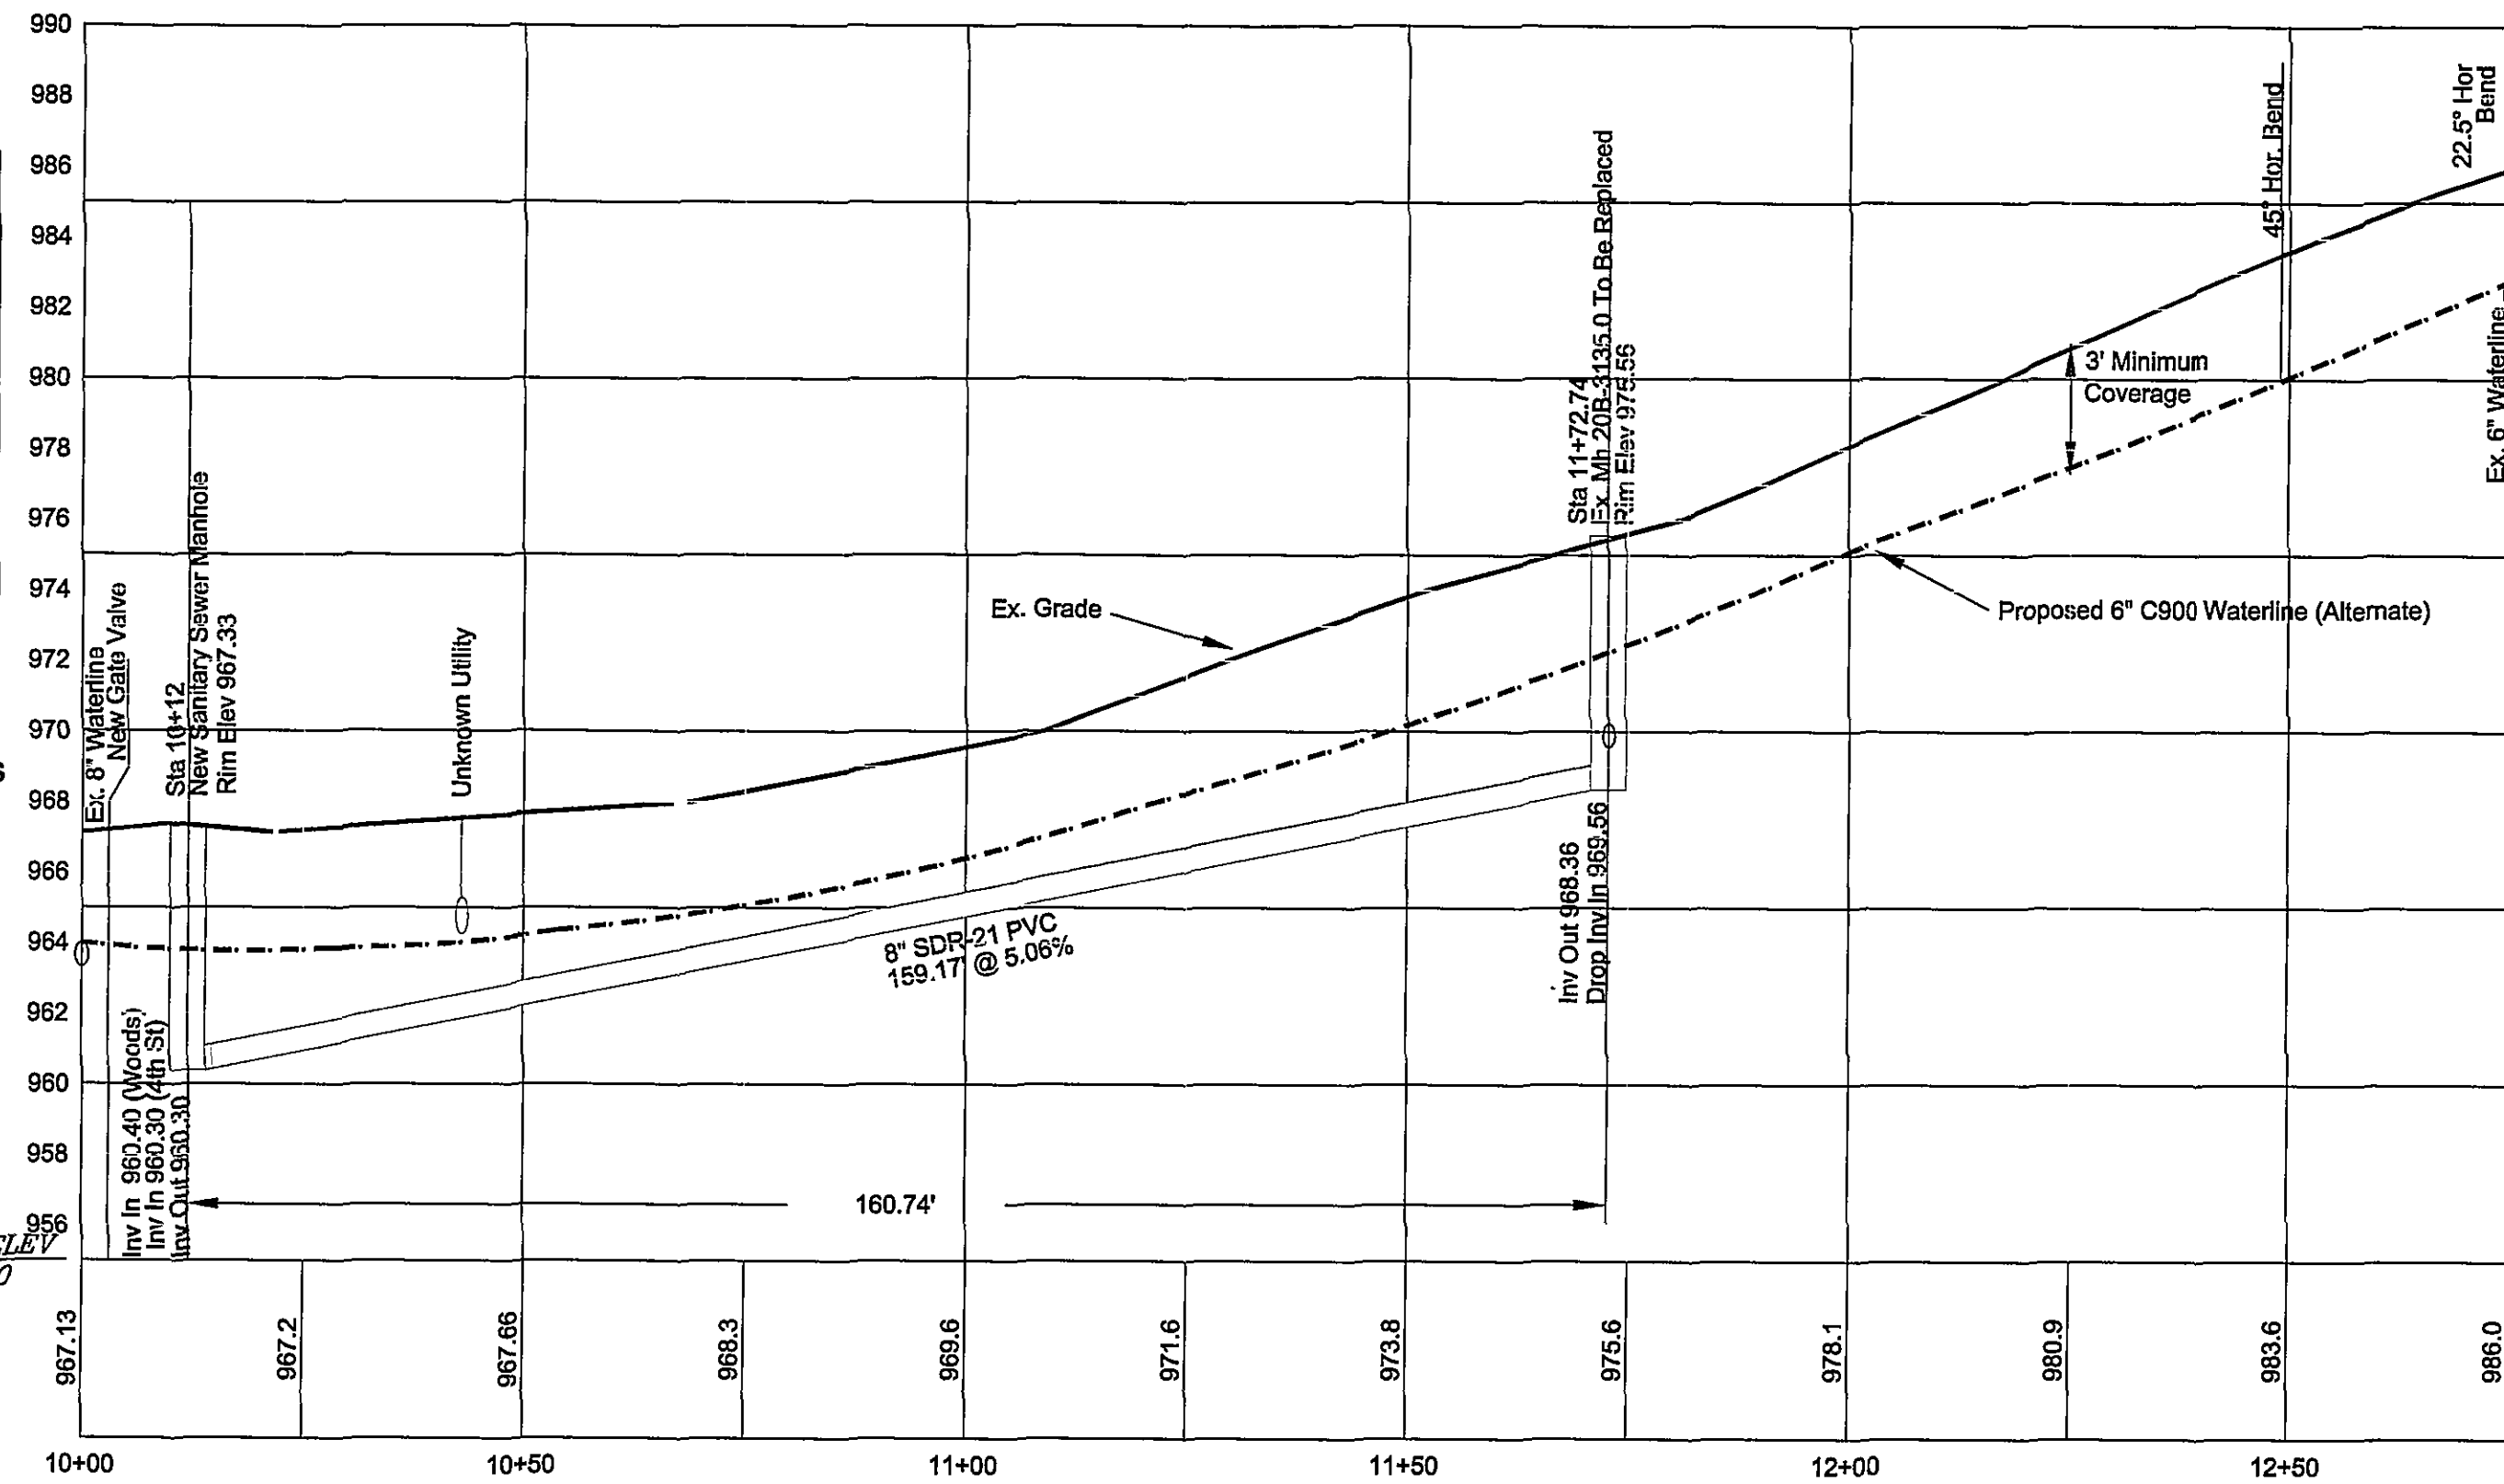

AS-BUILT

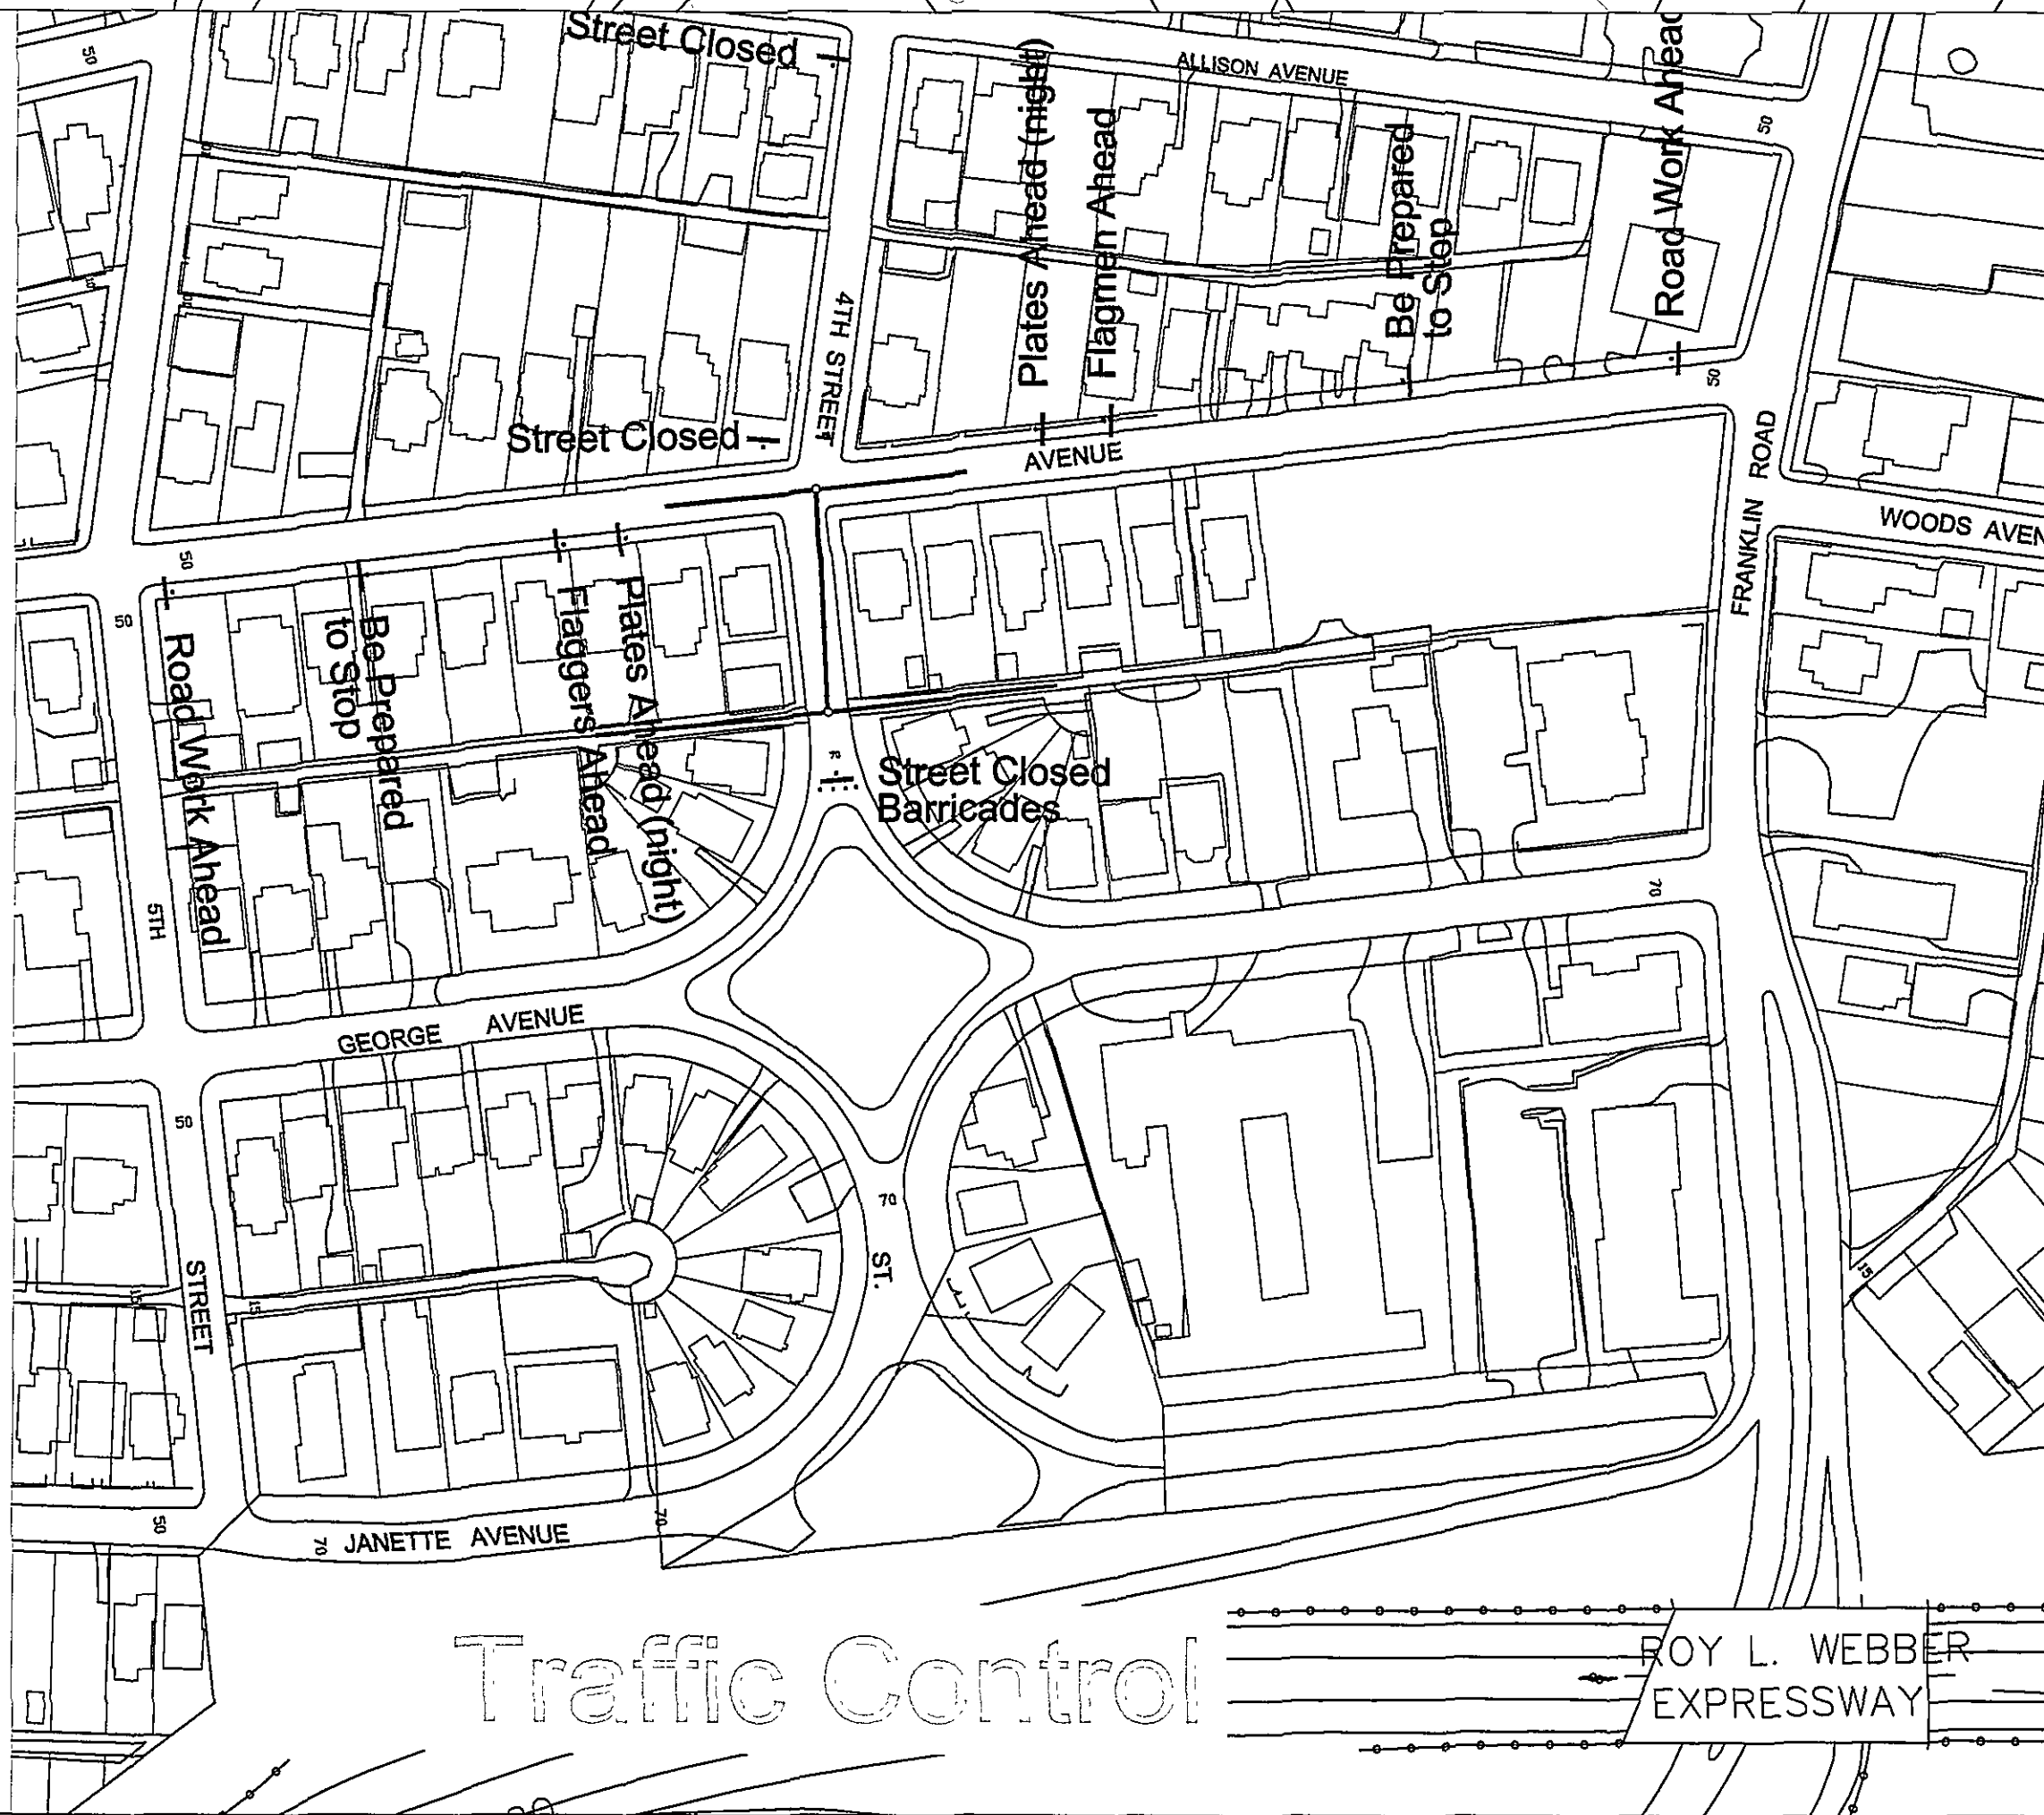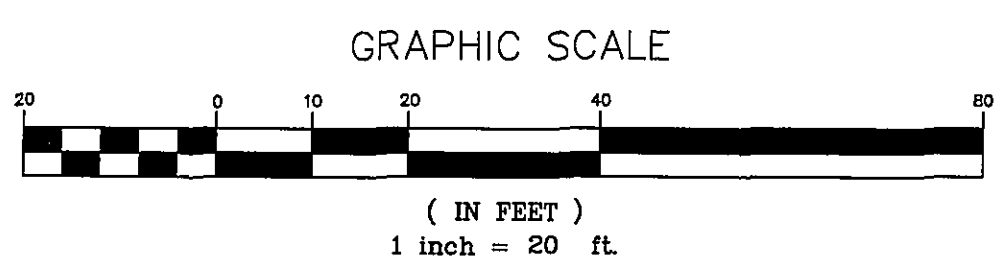

Rev	Description	Date	By
1	AS-BUILT	7/26/07	CDA
Designed: CDA			
Drawn: CDA			
Checked: CDA			
Approved: JGR			
Date: 14 MAY 2007			
Project: 6YDKVM			
C2			
Sheet 2 of 2			