
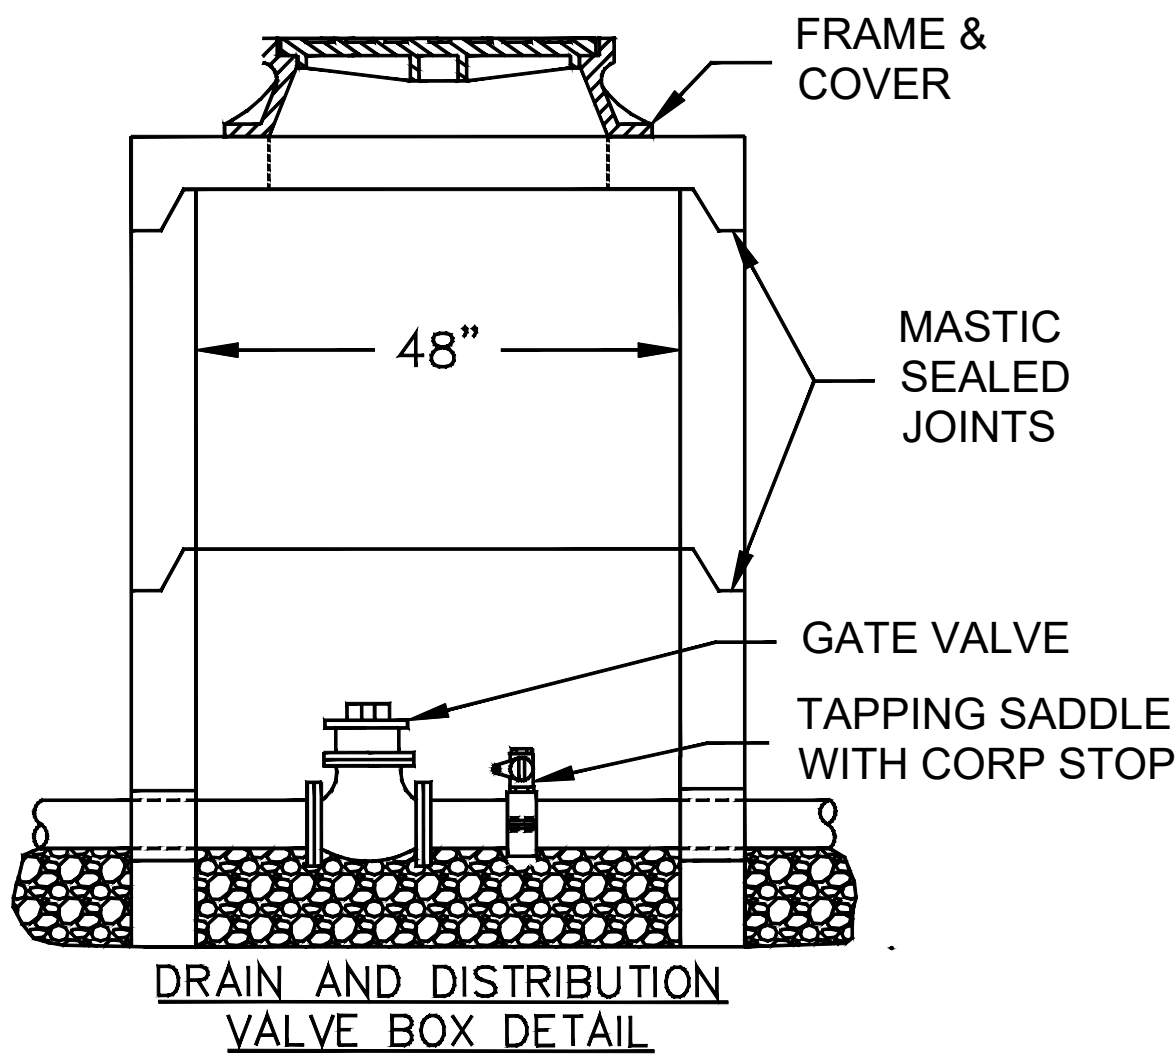


TANK OVERFLOW DETAIL

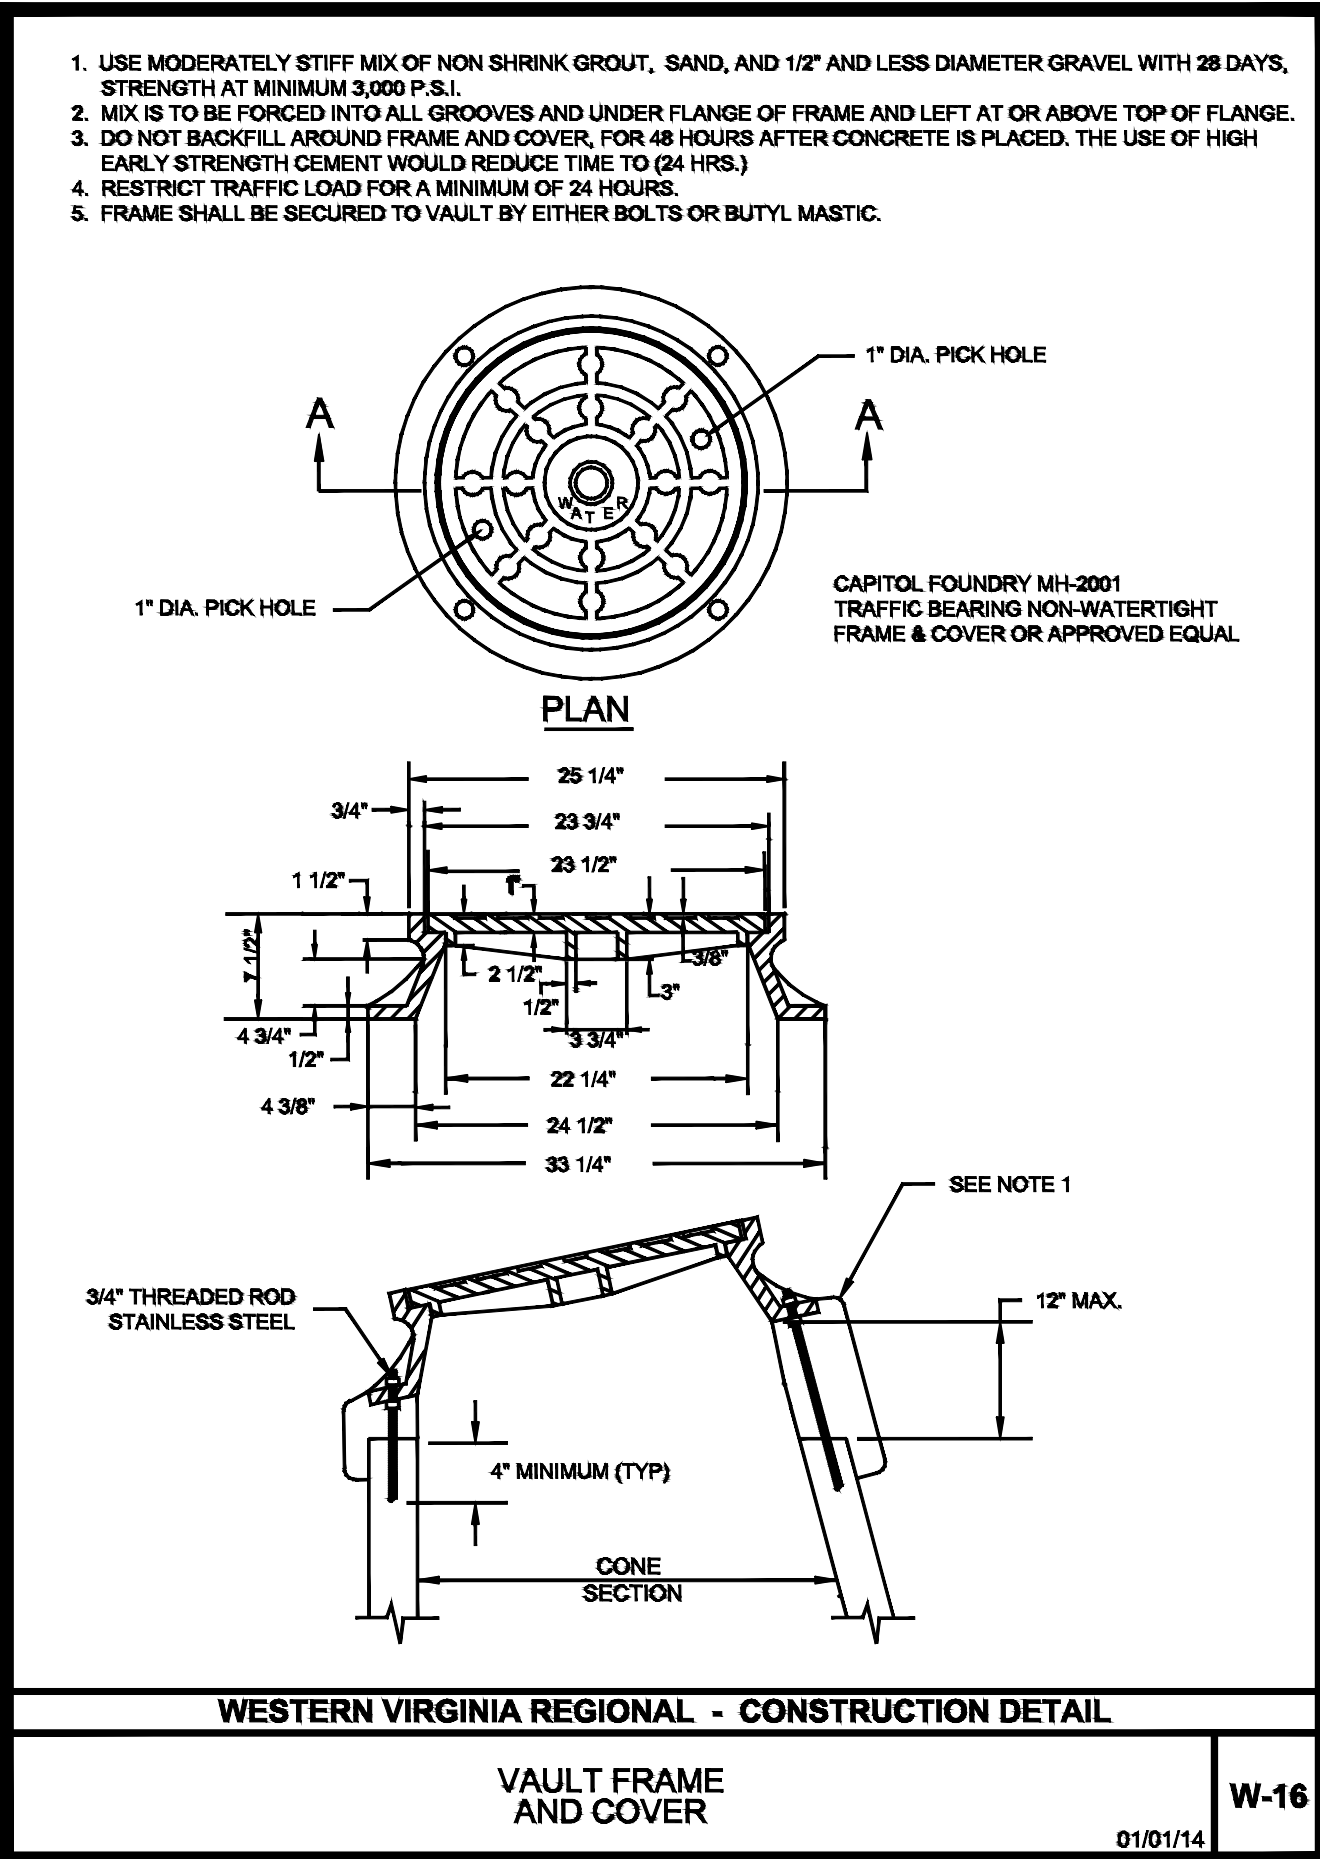

Notes:

1. TANK SHALL BE IN ACCORDANCE WITH AWWA D100.
2. STEEL CONSTRUCTION SHALL CONFORM TO APPLICABLE PROVISIONS OF THE AISC CODE OF STANDARD PRACTICE FOR STEEL BUILDINGS AND BRIDGES; THE AISC SPECIFICATIONS FOR THE DESIGN, FABRICATION, AND ERECTION OF STRUCTURAL STEEL FOR BUILDINGS; AND THE AWS CODE FOR WELDING IN BUILDING CONSTRUCTION.
3. WELDING SHALL BE PERFORMED BY WELDERS QUALIFIED IN ACCORDANCE WITH THE REQUIREMENTS OF THE AWS CODE.
4. ELECTRODES SHALL BE E6010.
5. STRUCTURAL BOLTS SHALL BE A325.
6. ALL TANK ACCESSORIES TO BE FIELD LOCATED BY OWNER'S REPRESENTATIVE.
7. EXACT LOCATION OF INLET, OUTLET, DRAIN AND OVERFLOW TO BE DETERMINED DURING FIELD CONSTRUCTION.
10. WATER LINES TO BE TIED TO EXISTING WATER LINES.

REV:	DESCRIPTION:	BY:	DATE:
STATUS: AS BUILT			

**AYERS**  
Engineering, LLC  
P.O. Box 923, Bluefield, VA 24605  
www.AyersEngineering.com

TANK SUPPLIER:	EASTERN TANK 145 KRIT ROAD PRINCETON, WV 24739
CONTRACTOR:	

SITE:		EAGLE ROCK TANK EAGLE ROCK, VA			
TITLE:		TANK DETAILS			
SCALE AT A1: NTS		DATE: 12/06/21	DRAWN: BA	CHECKED: BA	
PROJECT NO: 21041		DRAWING NO: T3	REVISION: 0		