



LIQUID LEVEL INDICATOR DETAIL

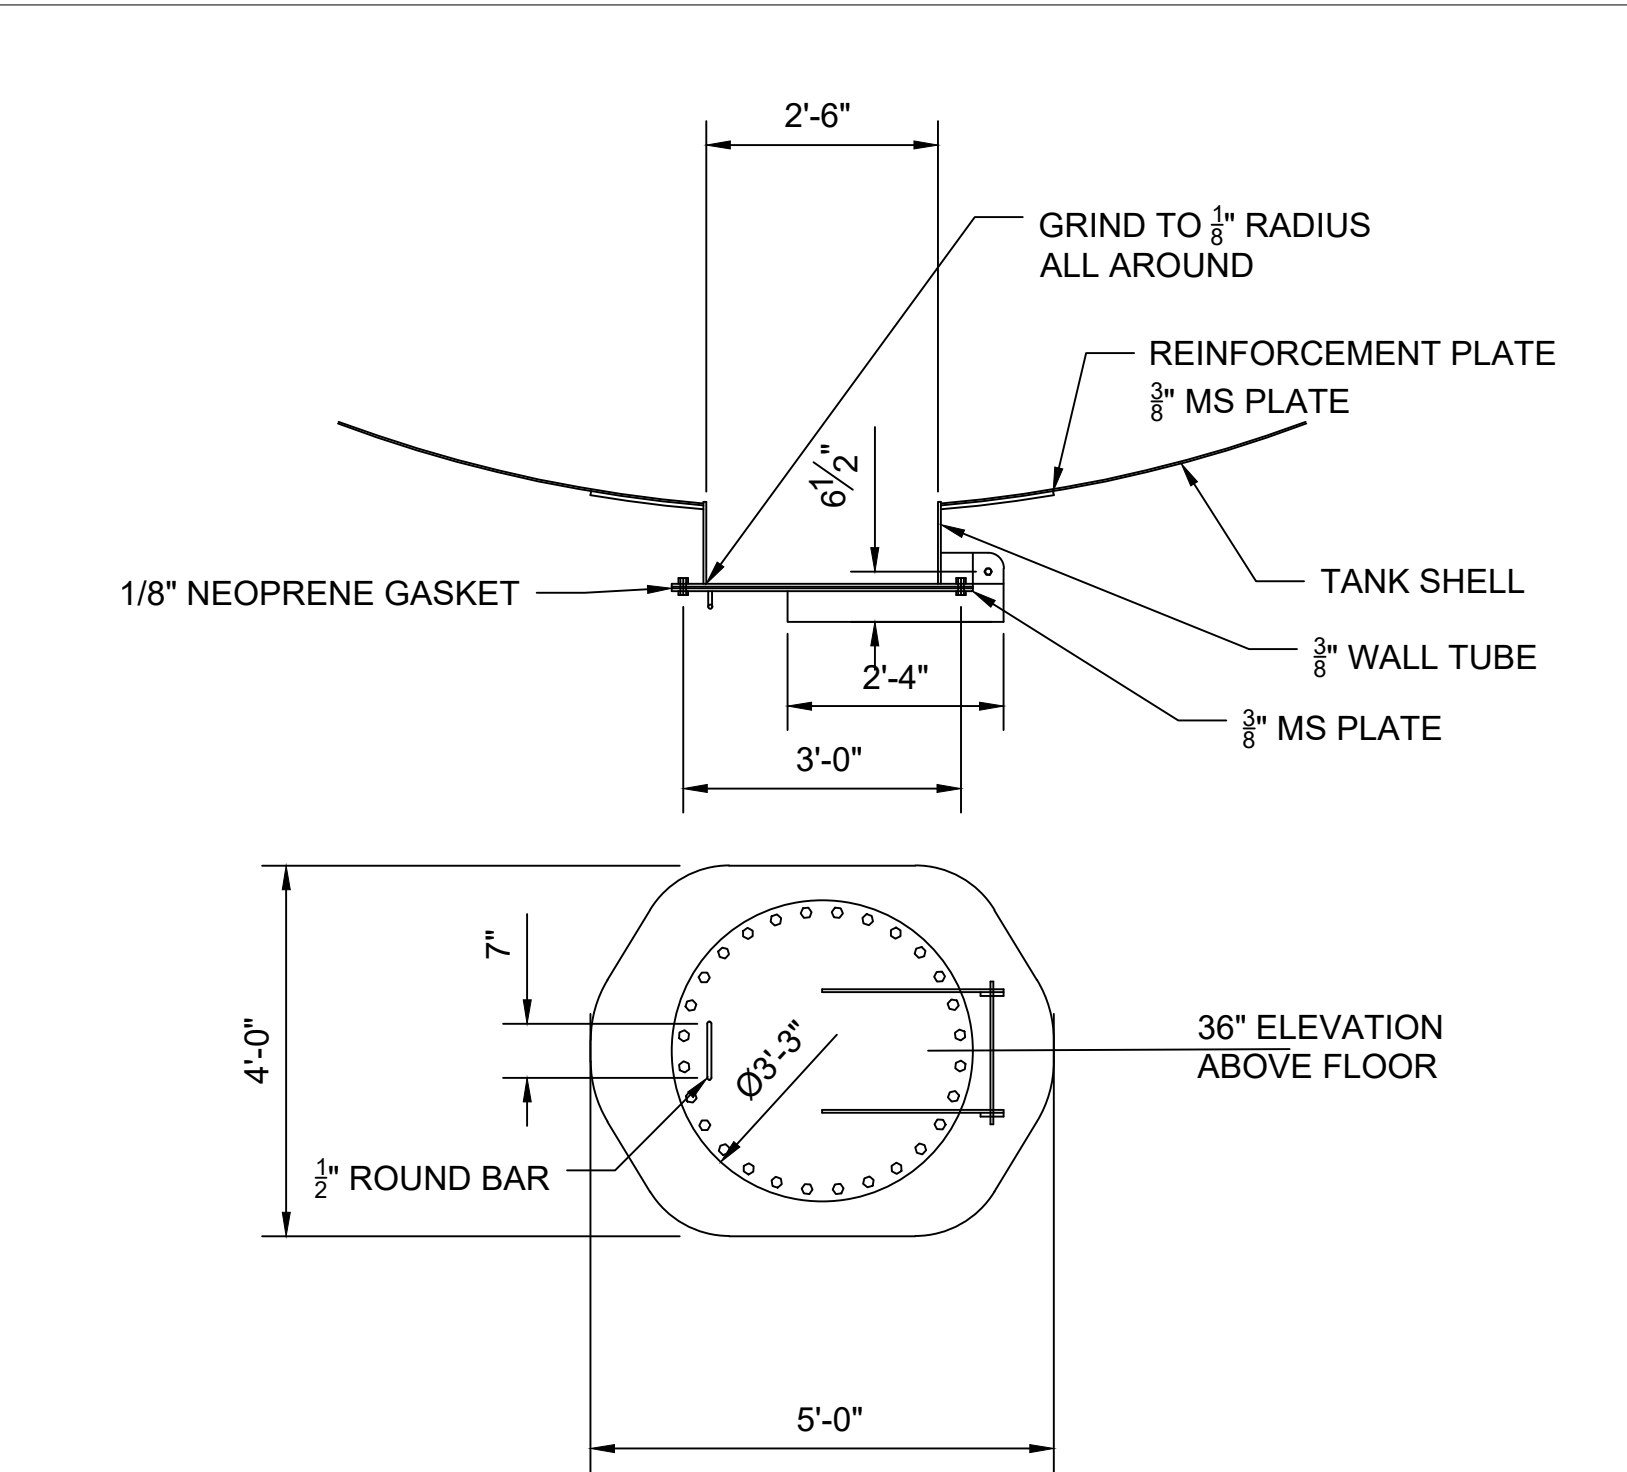


30" MANWAY DETAIL

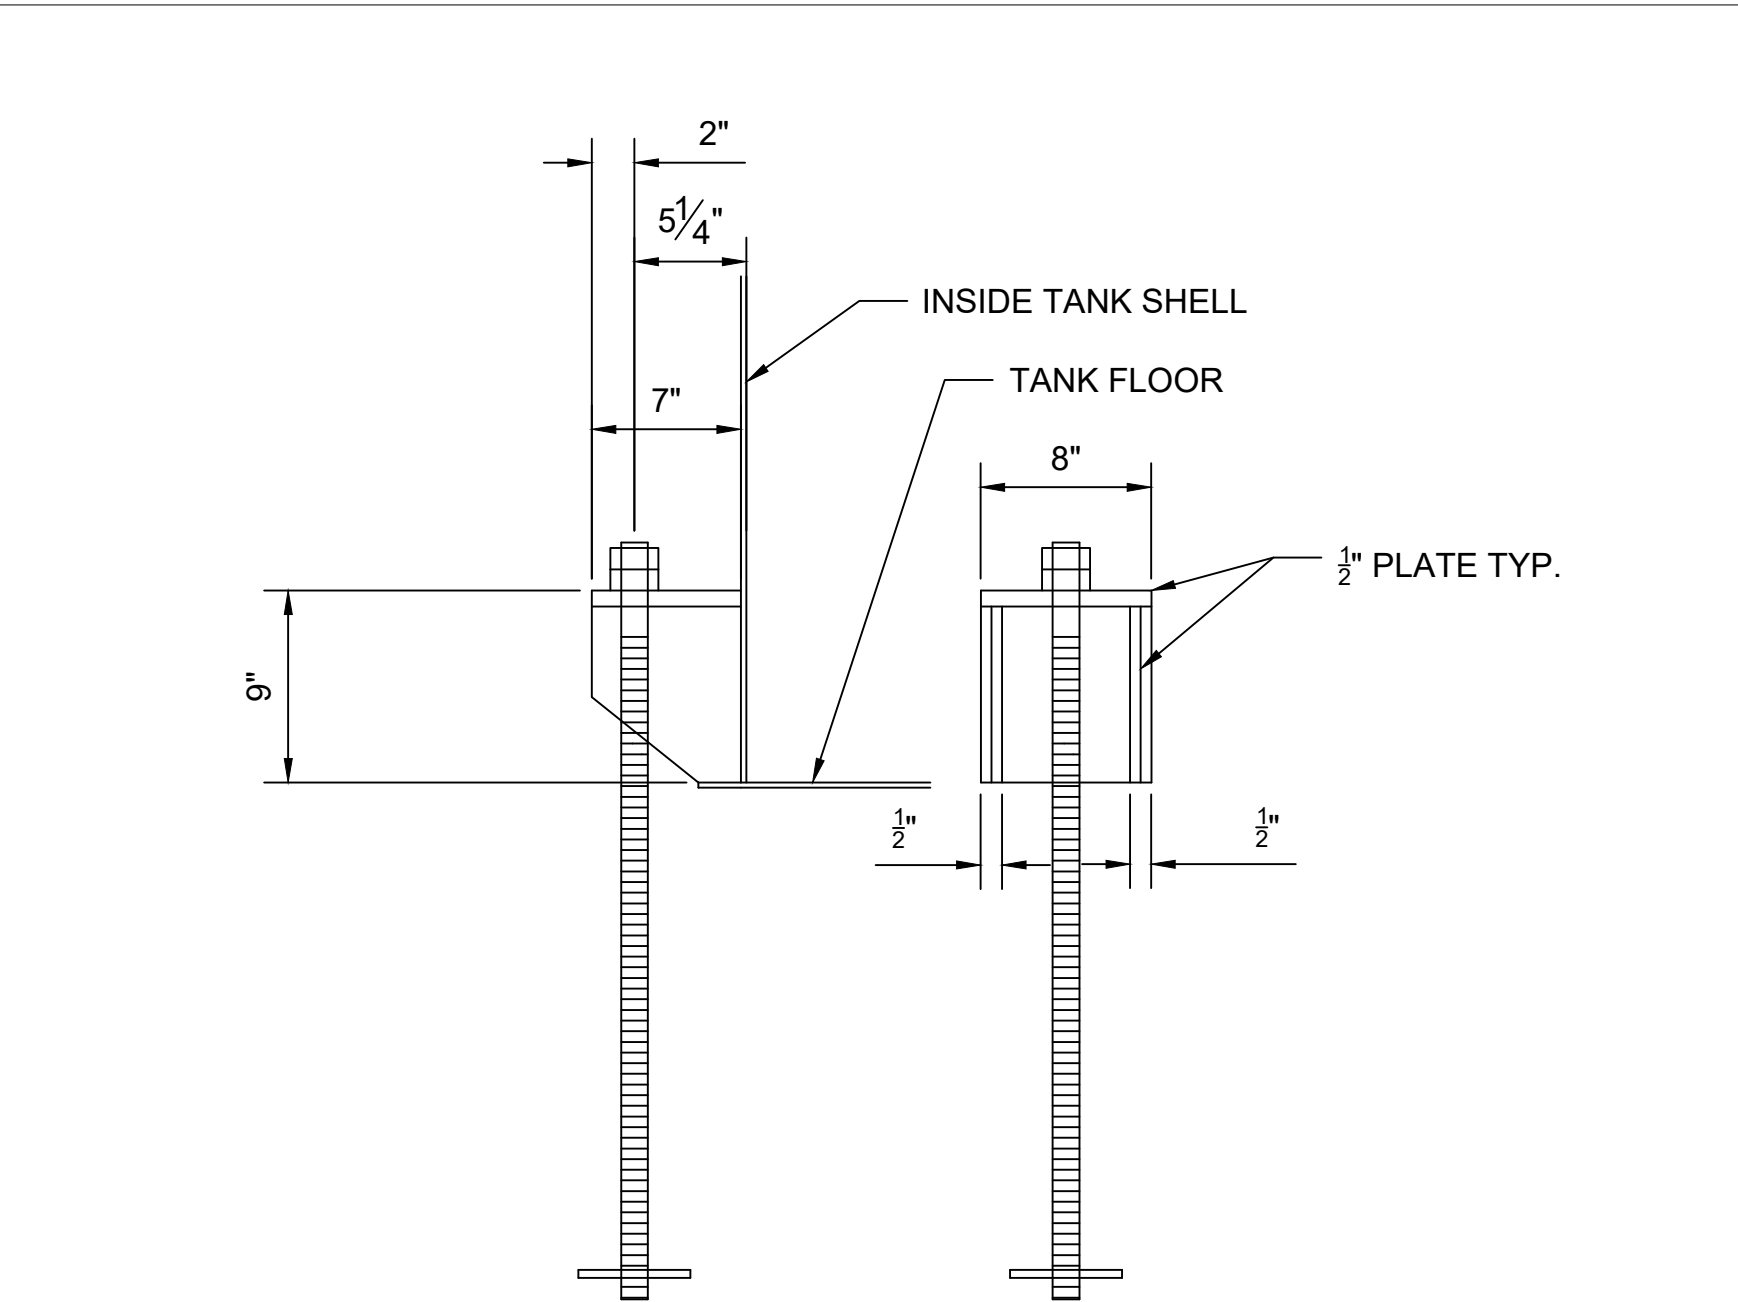


TANK ANCHOR DETAIL

REFER TO SHEET F1 / SECTION A - FOUNDATION DETAIL FOR ANCHOR BOLT INFORMATION.


This bracket was installed upside down from that shown. Greg Taylor.

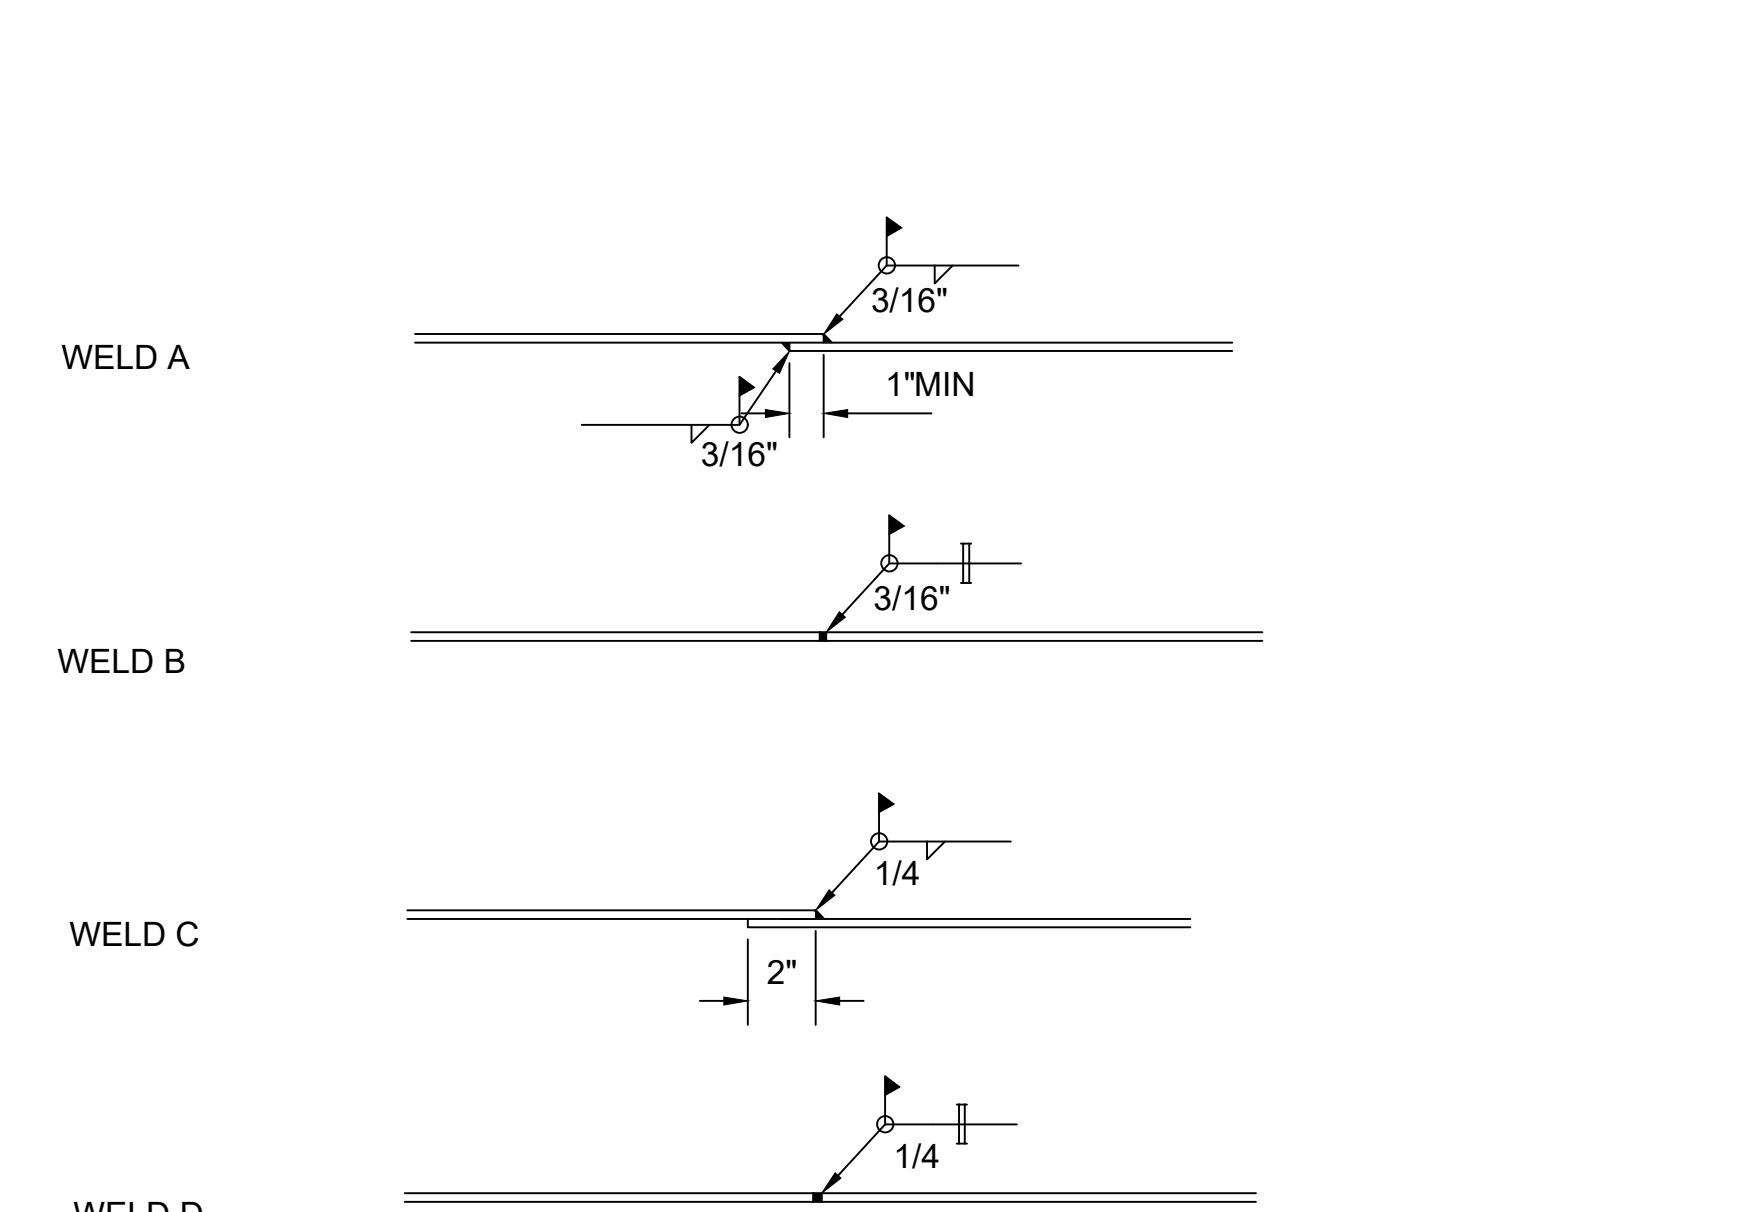

WELD DETAILS

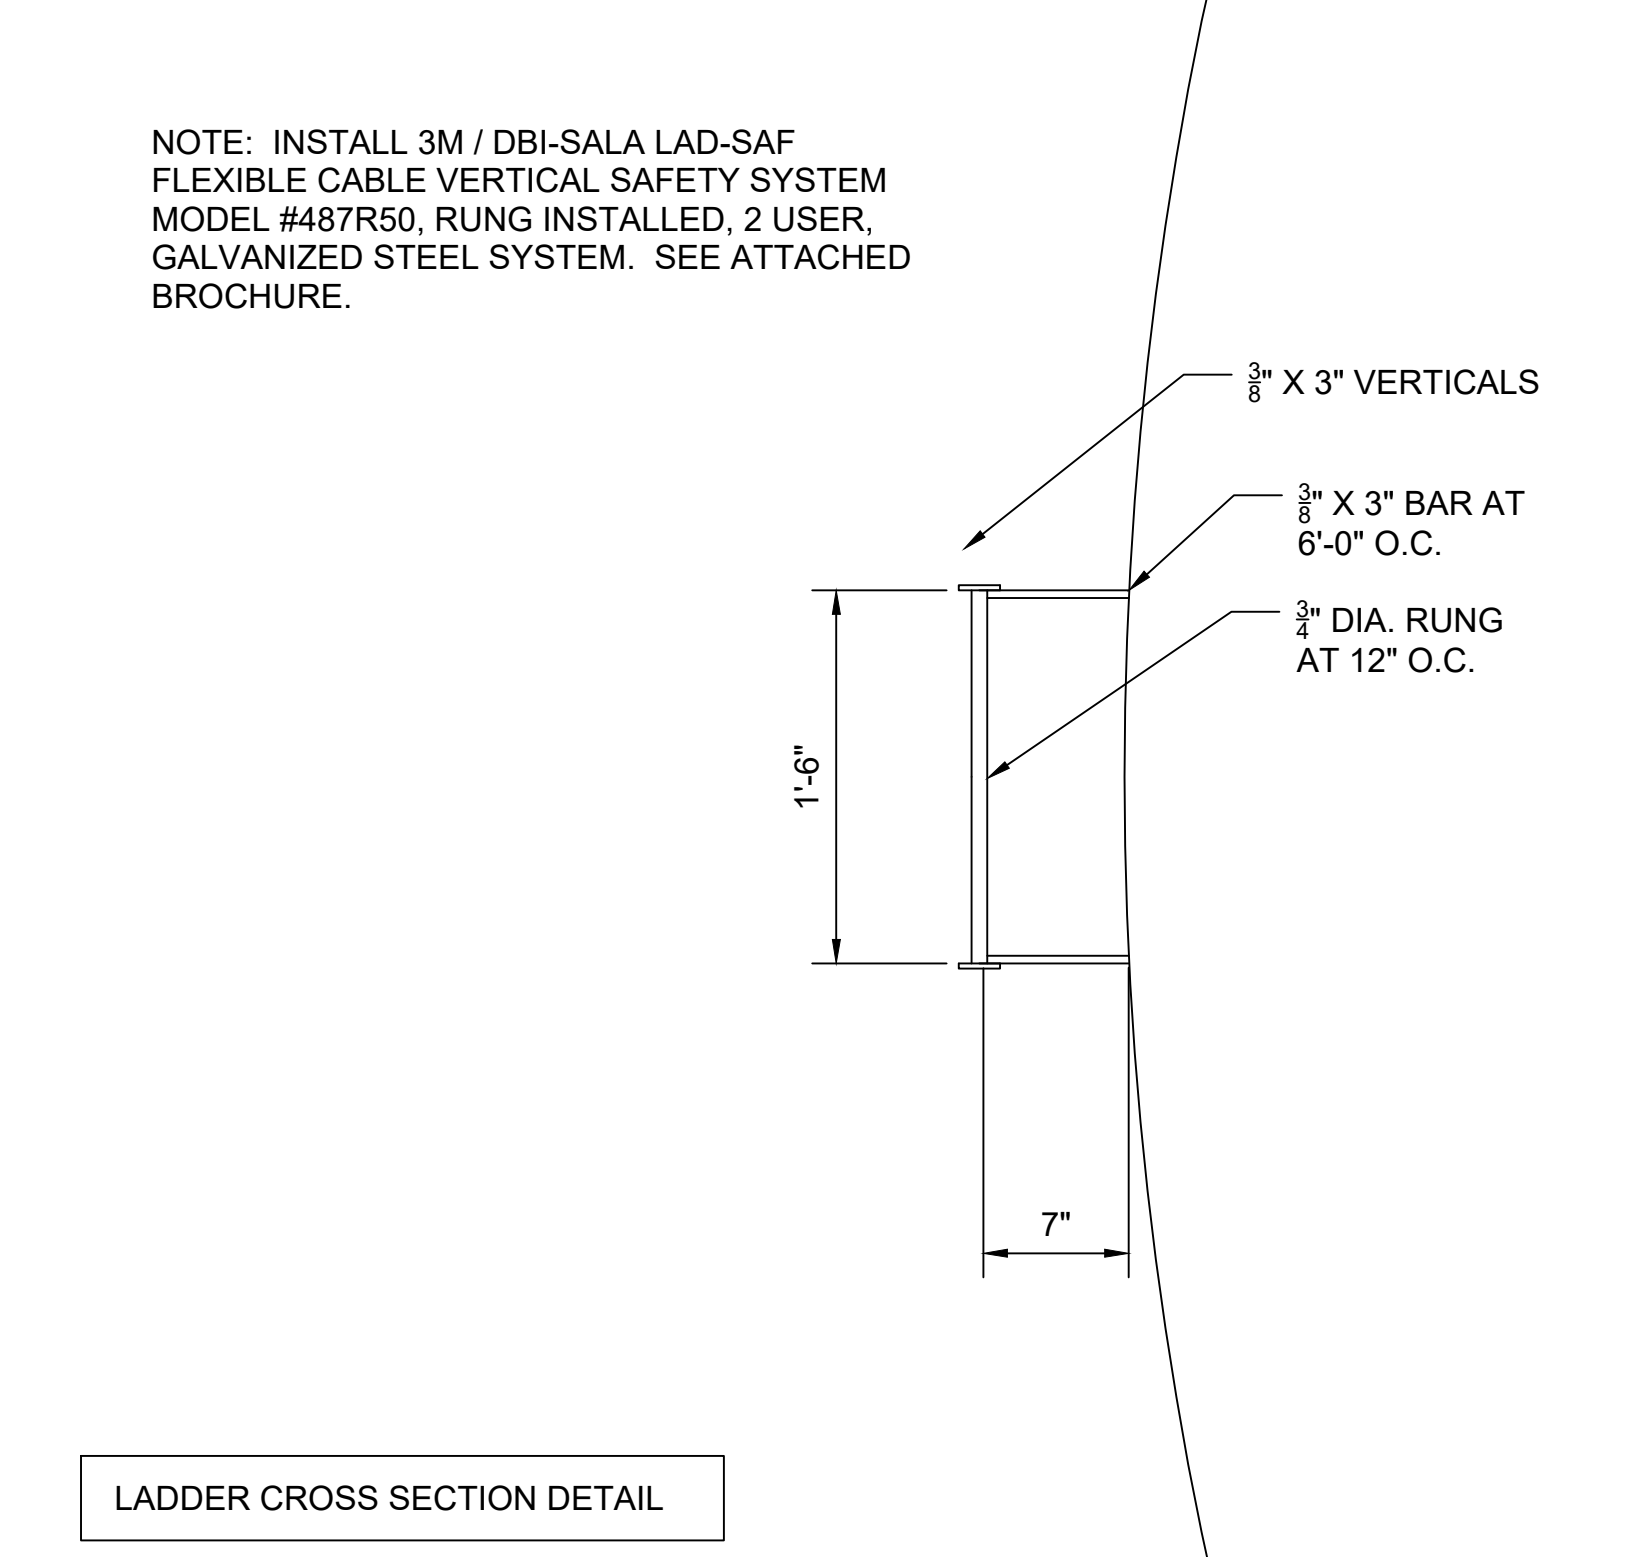

LADDER CROSS SECTION DETAIL

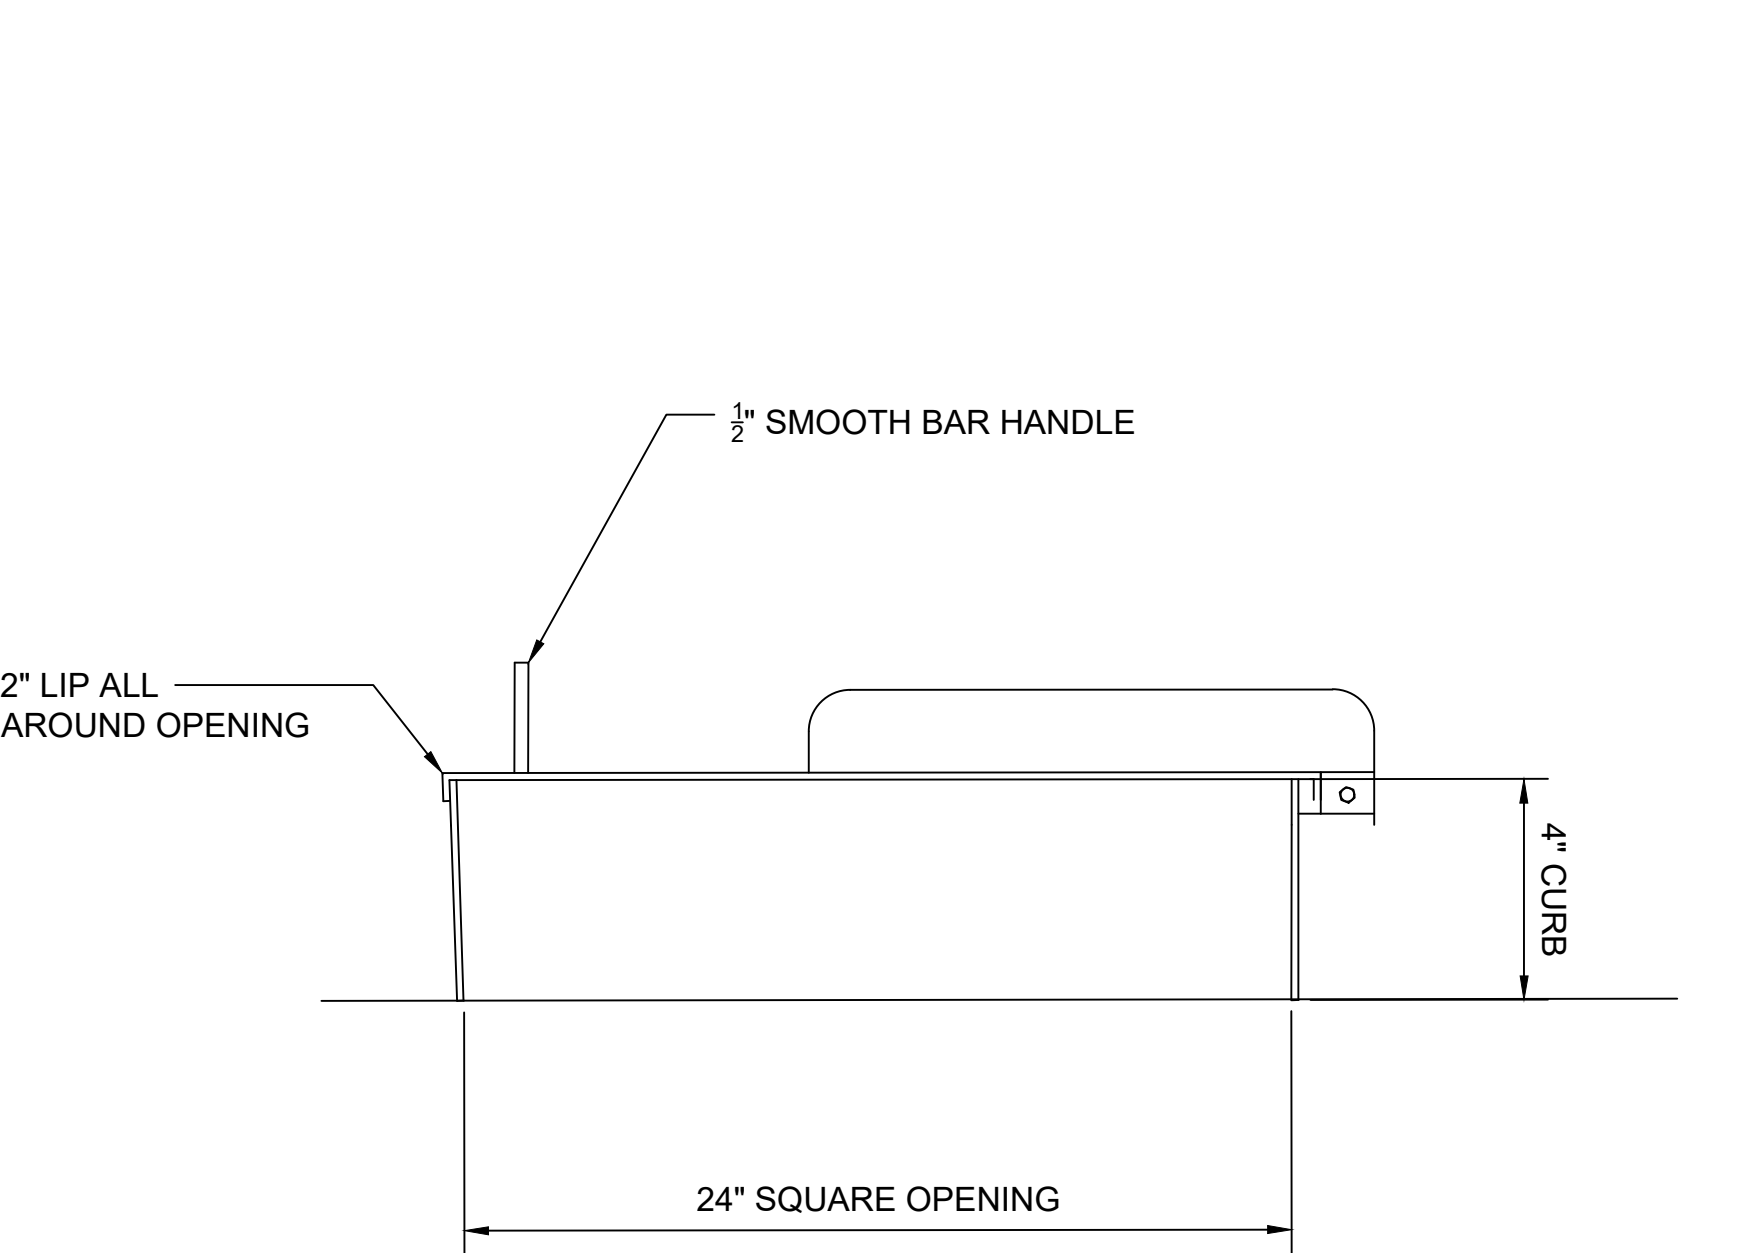

ROOF HATCH DETAIL

- Notes:
- TANK SHALL BE IN ACCORDANCE WITH AWWA D100.
 - STEEL CONSTRUCTION SHALL CONFORM TO APPLICABLE PROVISIONS OF THE AISC CODE OF STANDARD PRACTICE FOR STEEL BUILDINGS AND BRIDGES; THE AISC SPECIFICATIONS FOR THE DESIGN, FABRICATION, AND ERECTION OF STRUCTURAL STEEL FOR BUILDINGS; AND THE AWS CODE FOR WELDING IN BUILDING CONSTRUCTION.
 - WELDING SHALL BE PERFORMED BY WELDERS QUALIFIED IN ACCORDANCE WITH THE REQUIREMENTS OF THE AWS CODE.
 - ELECTRODES SHALL BE E6010.
 - STRUCTURAL BOLTS SHALL BE A325.
 - ALL TANK ACCESSORIES TO BE FIELD LOCATED BY OWNER'S REPRESENTATIVE.
 - EXACT LOCATION OF INLET, OUTLET, DRAIN AND OVERFLOW TO BE DETERMINED DURING FIELD CONSTRUCTION.
 - WATER LINES TO BE TIED TO EXISTING WATER LINES.

REV:	DESCRIPTION:	BY:	DATE:
STATUS:	AS BUILT		

AYERS
Engineering, LLC
P.O. Box 923, Bluefield, VA 24605
www.AyersEngineering.com

TANK SUPPLIER:	EASTERN TANK 145 KRIT ROAD PRINCETON, WV 24739
CONTRACTOR:	

SITE:		EAGLE ROCK TANK EAGLE ROCK, VA			
TITLE:		TANK DETAILS			
SCALE AT A1: NTS		DATE: 12/06/21	DRAWN: BA	CHECKED: BA	
PROJECT NO: 21041		DRAWING NO: T2	REVISION: 0		