
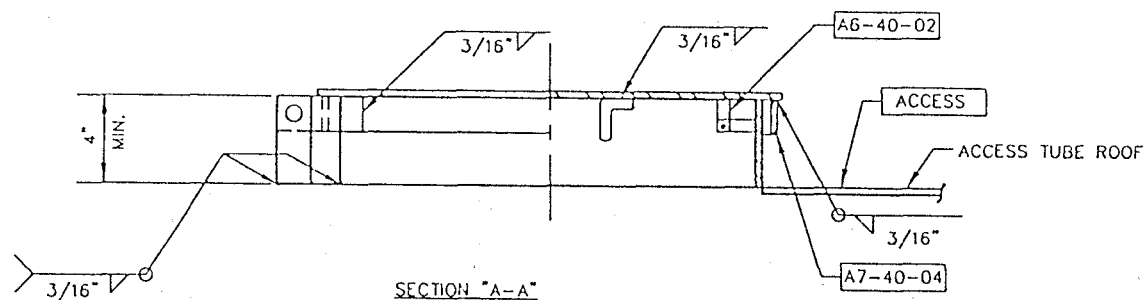
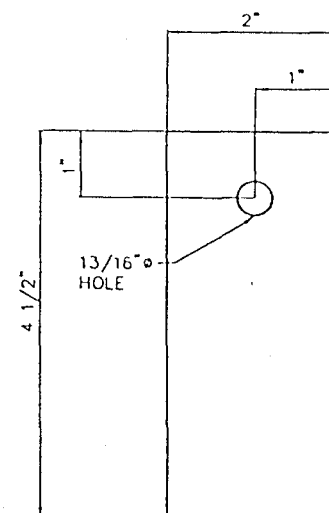
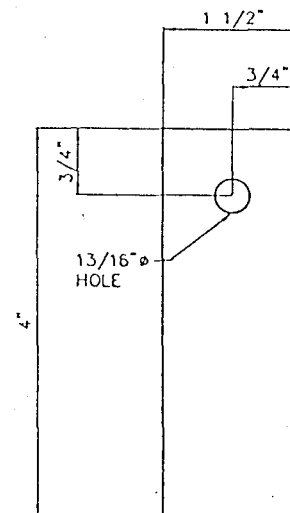


| SUB ASS'Y NO. | PART NO. | QUANTITY | DESCRIPTION                                  | MATERIAL REQ'D.               | WEIGHT |
|---------------|----------|----------|----------------------------------------------|-------------------------------|--------|
| A7-M1-30      |          | 1        | 30" DIA. MANHOLE ON 36", 42" & 48" A.T. ROOF |                               | 180    |
|               | A6-40-01 | 4        | HINGE BAR w/ 13/16" HOLE (STD.)              | 2" x 3/8" x 4 1/2" LG.        |        |
|               | A7-10-03 | 1        | 3/16" MIN. COVER PLT.                        | 33" O.D. x 3/16" MIN. PLT.    |        |
|               | A7-40-04 | 1        | OVERLAPPING BAR RING (ROLL 32 1/2" O.D.)     | 2" x 1/4" x 101 5/16" LG.     |        |
|               | A6-40-02 | 2        | LATCH BAR w/ 13/16" HOLE (STD.)              | 1 1/2" x 1/4" x 4" LG.        |        |
|               | A4-86-01 | 3        | M. BOLTS w/ NUTS (STD.)                      | 3/4" DIA. x 1 1/2" LG.        |        |
|               | A1-35-04 | 1        | HANDLE- INSTALL UNDER LID (BENT ROD) (STD.)  | 5/8" DIA. x 15" LG.           |        |
|               | A5-20-02 | 1        | STEEL TUBE (STD.)                            | 30" O.D. x 1/4" MIN. x 6" LG. |        |
|               |          | 1        | A.T. ROOF PLATE (REF. TO ACCESS TUBE DETAIL) |                               |        |

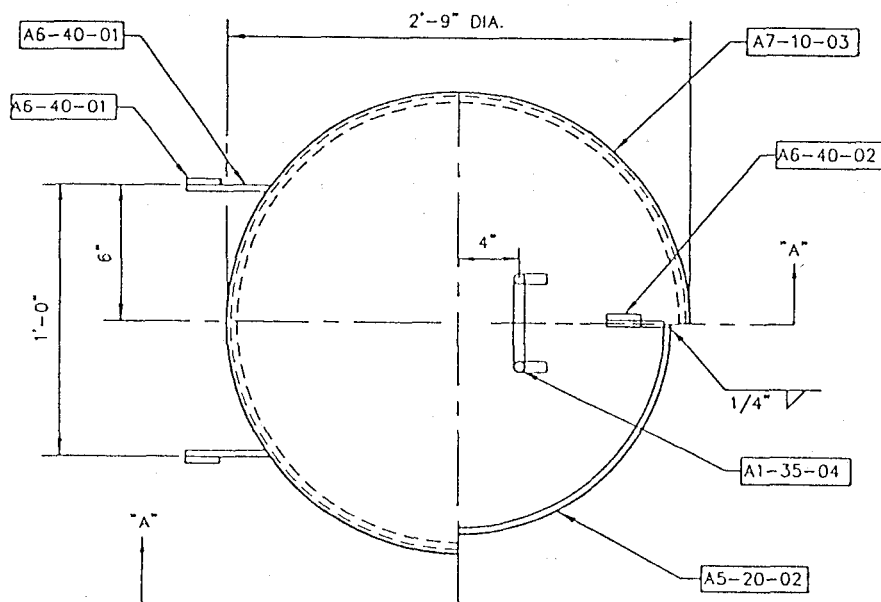

30" DIA. ACCESS MANWAY w/  
INSIDE LATCH BAR

AS BUILT DRAWING

CALDWELL TANKS, INC.  
LOUISVILLE, KY.

TITLE:  
30" DIA. MANHOLE ON  
36", 42" & 48" ACCESS TUBE ROOF

DRAWING NO.:

A7