




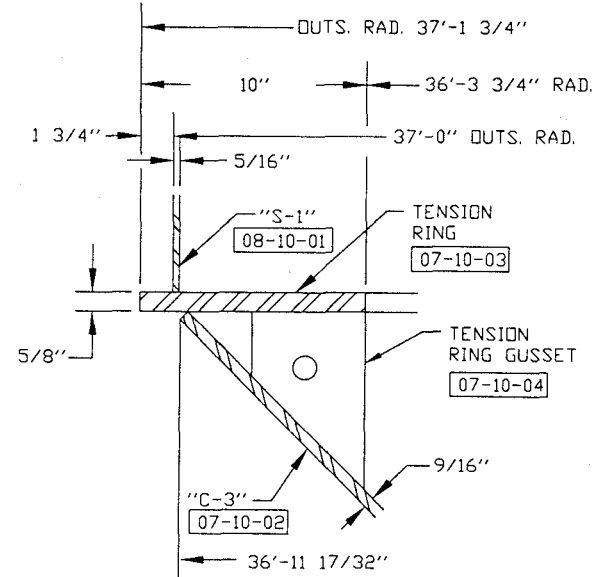


ASS'Y DETAILS @ TENSION RING

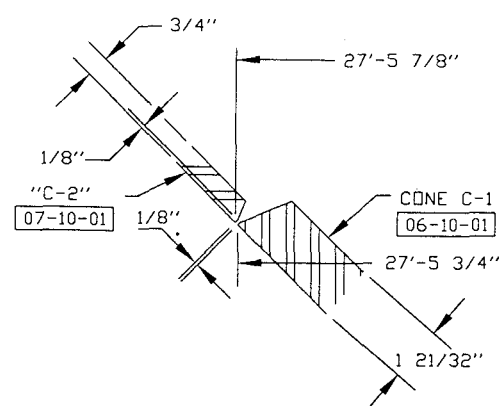



CONE ASSY DETAILS
@ TOP OF CONE "C-1"

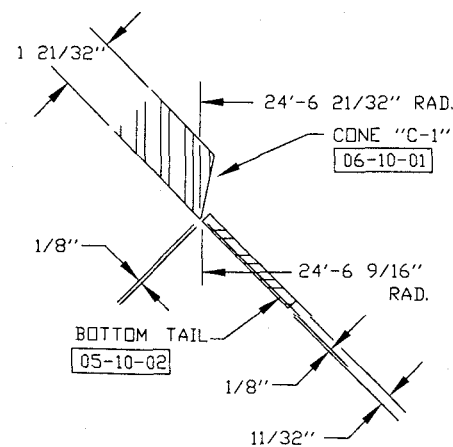


CONE ASSY DETAILS
@ BOTTOM OF CONE "C-1"

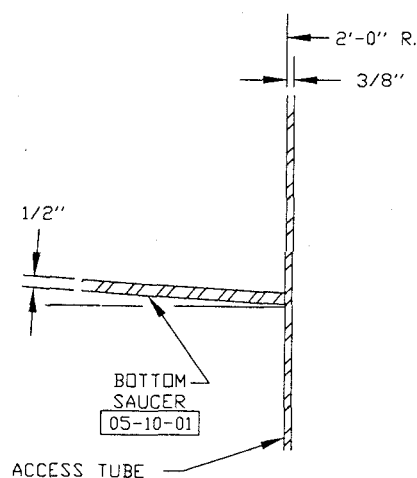


BOTTOM TO ACCESS TUBE CONNECTION

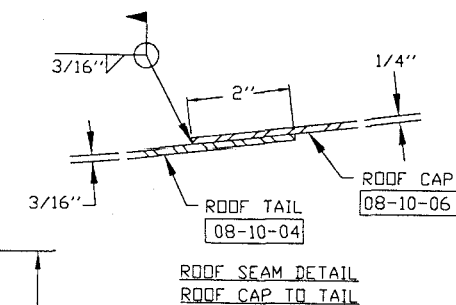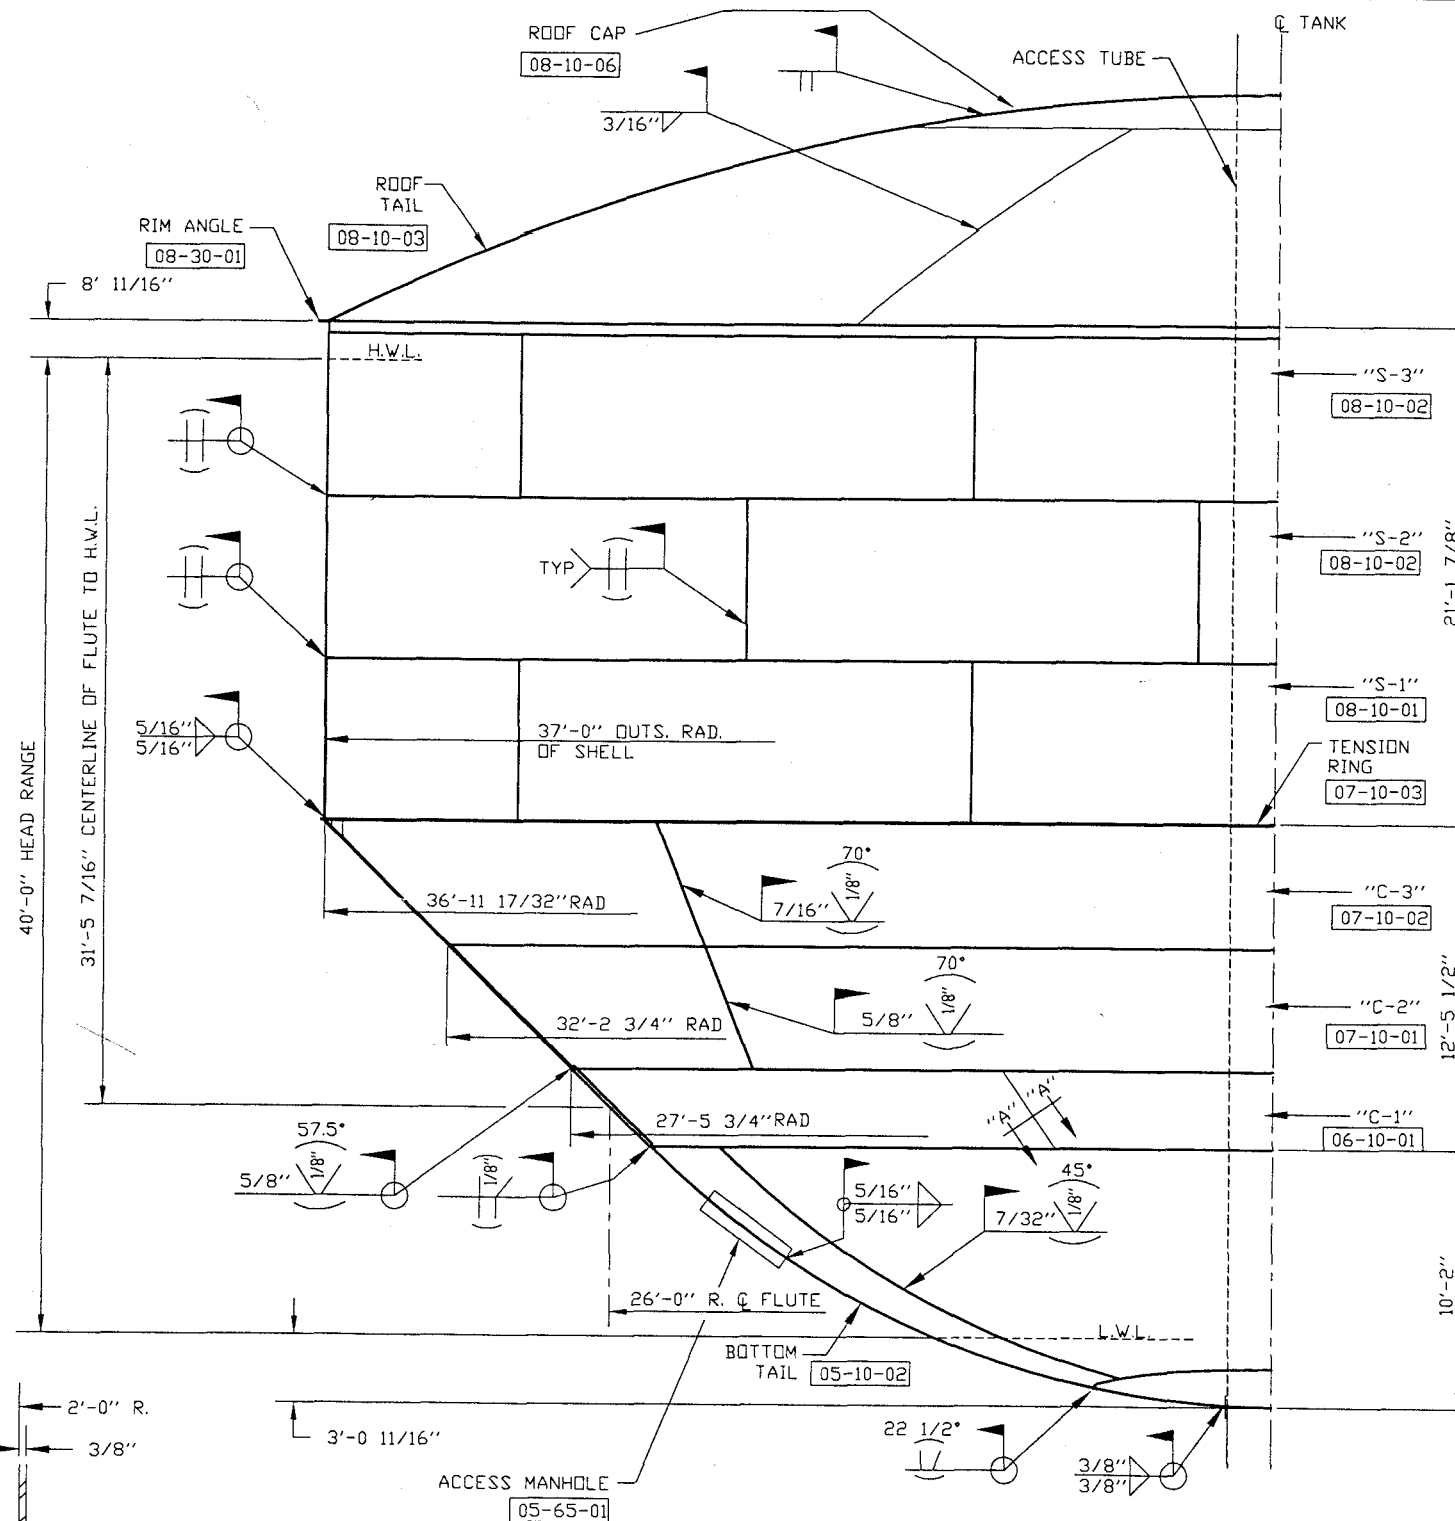

ROOF SEAM DETAIL
ROOF CAP TO TAIL

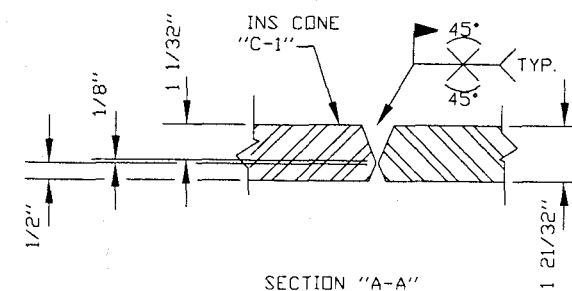

SECTION "A-A"

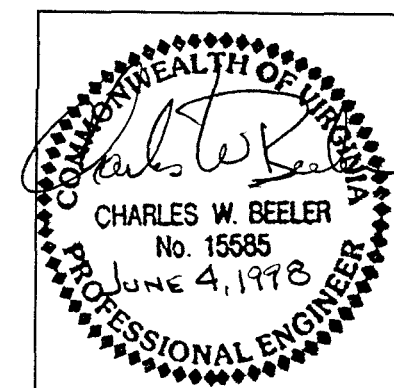

REV.	BY:	DATE	REMARKS
Caldwell Tanks, Inc. LOUISVILLE, KY.			
BOTETOURT COUNTY, VA			
BY:	BAW ✓	TITLE:	TANK ASSEMBLY DETAILS
DATE:	4-98	DRAWING NO:	E-4291 04