

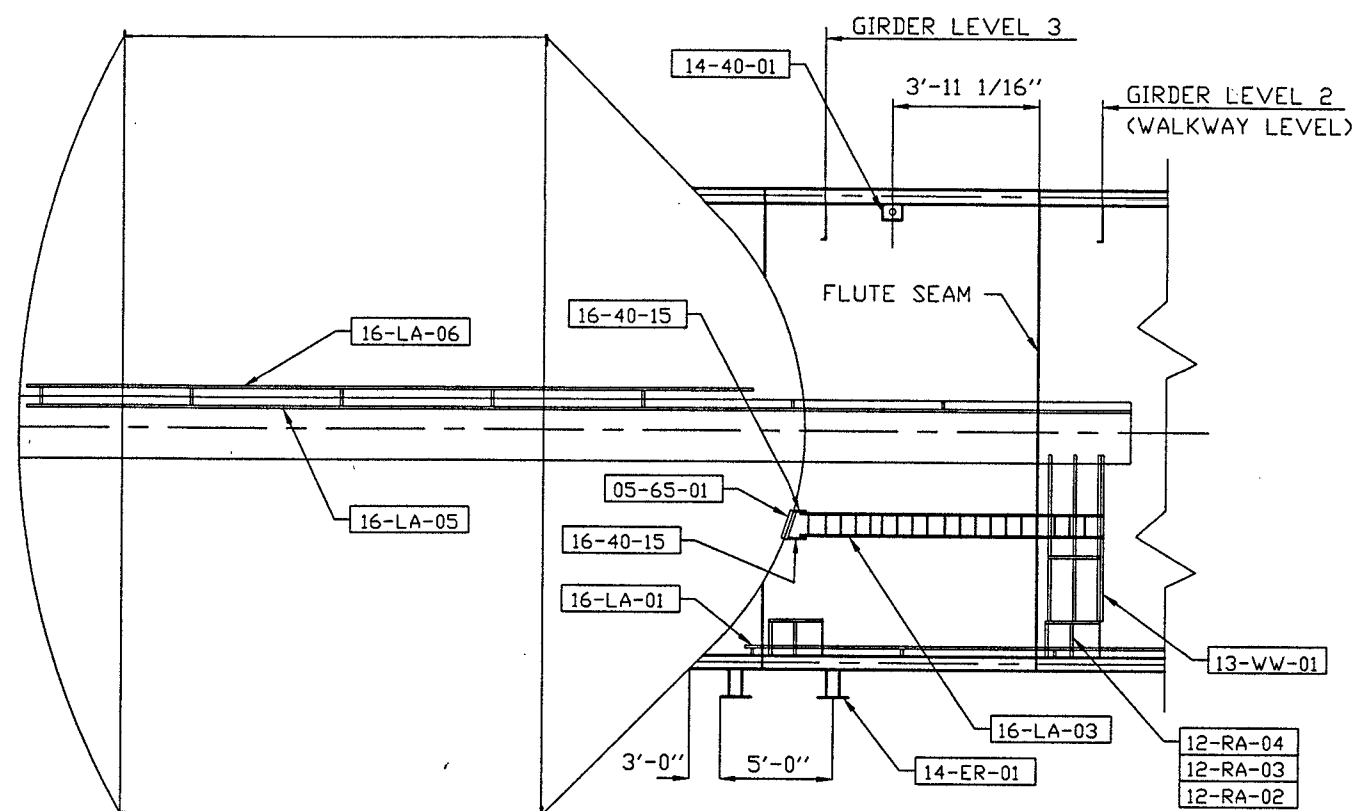


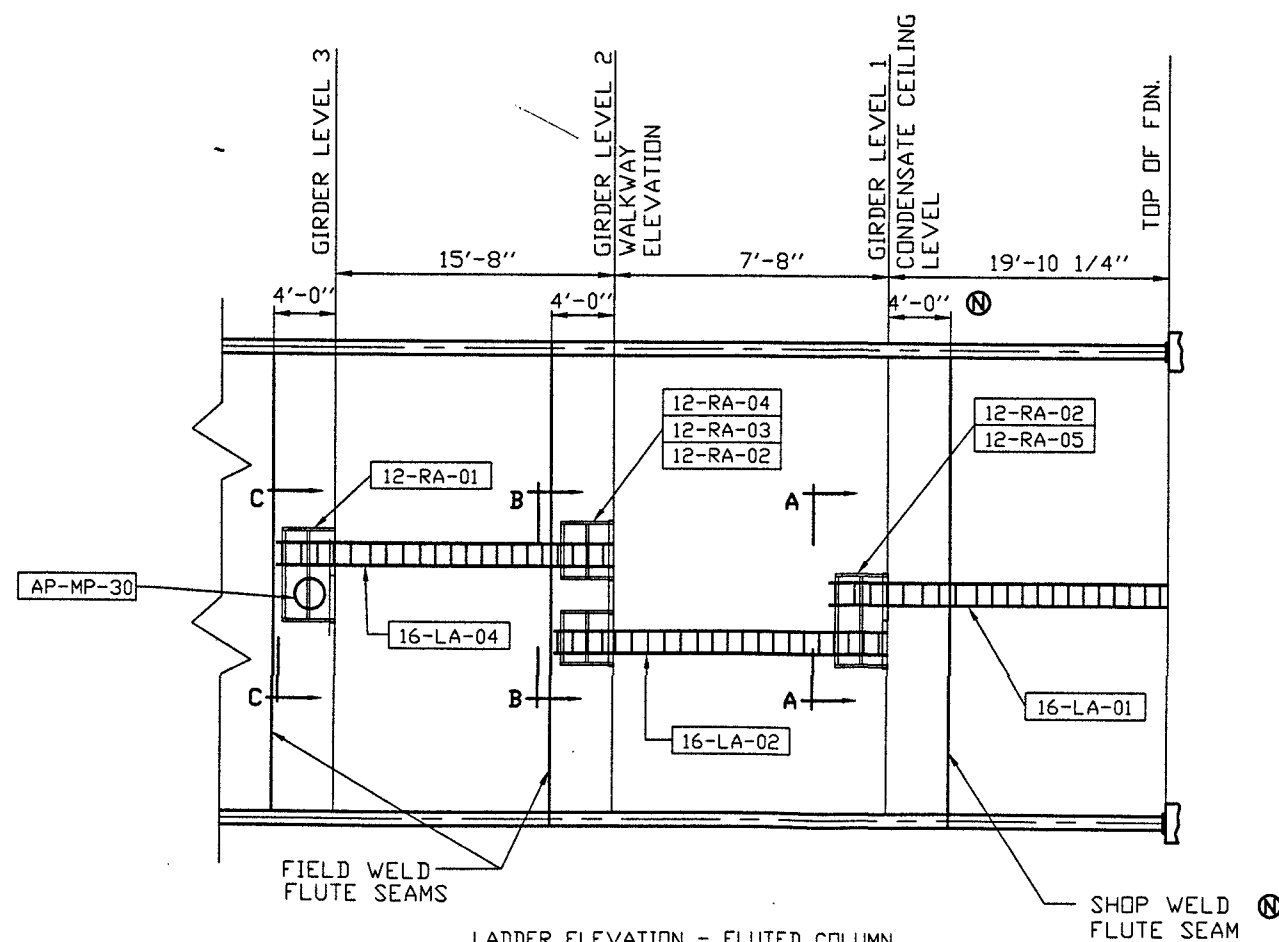


LADDER ELEVATION
(ROTATED 90° TO SHOW WALKWAY)

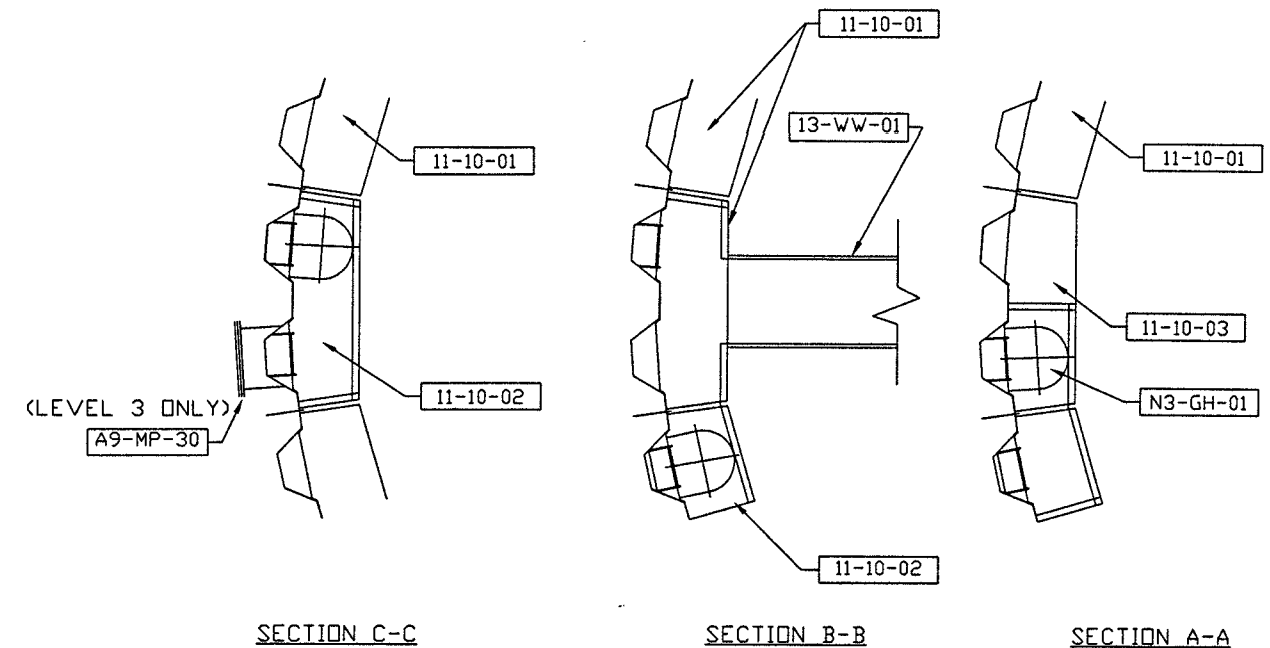

LADDER ELEVATION - FLUTED COLUMN
(VIEW FROM CL. TANK - OUTWARD)

NOTES:
SEE DWG. 16 FOR LADDER DETAILS
SEE DWG. 11 & 12 FOR GIRDER DETAILS
SEE DWG. N3 FOR GIRDER HATCH DETAILS.

Ⓝ DENOTES NON-STANDARD PRACTICE

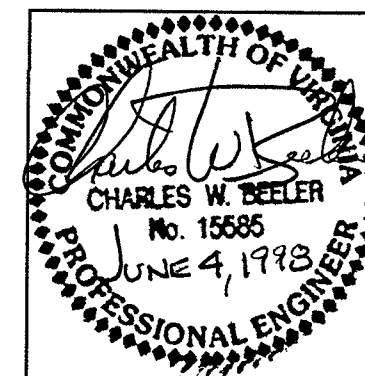

REV.	BY:	DATE	REMARKS
COLDWELL TANKS, INC. LOUISVILLE, KY.			
BOTETOURT COUNTY, VA			
BY: BAW/TB	TITLE: LADDER ELEVATION		
DATE: 4-98	DRAWING NO: E-4291	15	