

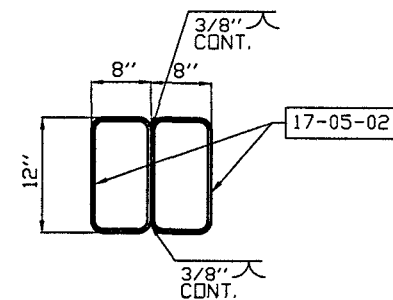


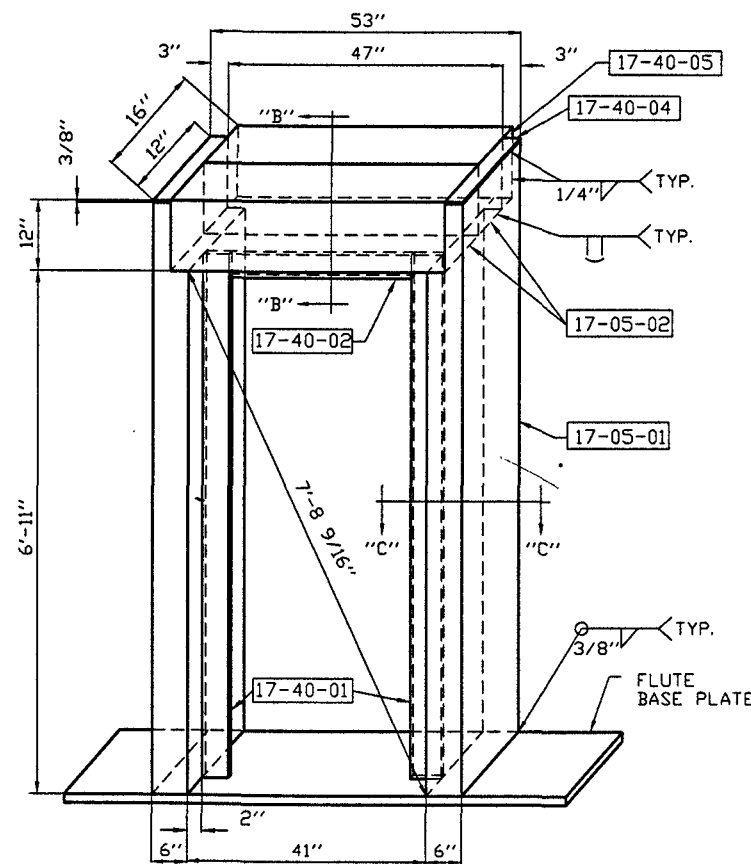


SECTION B-B


BILL OF MATERIAL					
SUB-ASS'Y NO.	PART NO.	QUANTITY	DESCRIPTION	MATERIAL REQ'D.	PC. WT.
17-DA-01		1	PEDESTRIAN DOOR REINFORCEMENT	(INSTALL ON 03-BF-01)	
	17-05-01	2	DOOR SIDE FRAME	12" X 6" X 3/8" WL. X 7'-10 5/8" LG.	360
	17-05-02	2	TOP BEAMS	12" X 8" X 3/8" WL. X 3'-11" LG.	185
	17-40-01	2	FRAME BARS	1 3/4" X 1/4" X 6'-11" LG.	11
	17-40-02	1	FRAME BARS	1 3/4" X 1/4" X 36 1/2" LG.	5
	17-40-04	2	COVER PLATES	3" X 3/8" X 16" LG.	5
	17-40-05	2	COVER PLATES	4" X 3/8" X 12" LG.	6
	26-NP-01	1	NAMEPLATE ASSY.	SEE DWG. 26	
	17-40-03	3	FRAME BARS	2" X 1/4" X 8" LG.	
	17-90-01	1	HOLLOW STEEL DOOR FRAME	FOR 36" X 80" HOLLOW STEEL DOOR	
ITEMS LISTED BELOW ARE SHIPPED LOOSE					
	17-90-02	1	PEDESTRIAN DOOR	36" X 80" HOLLOW STEEL DOOR	

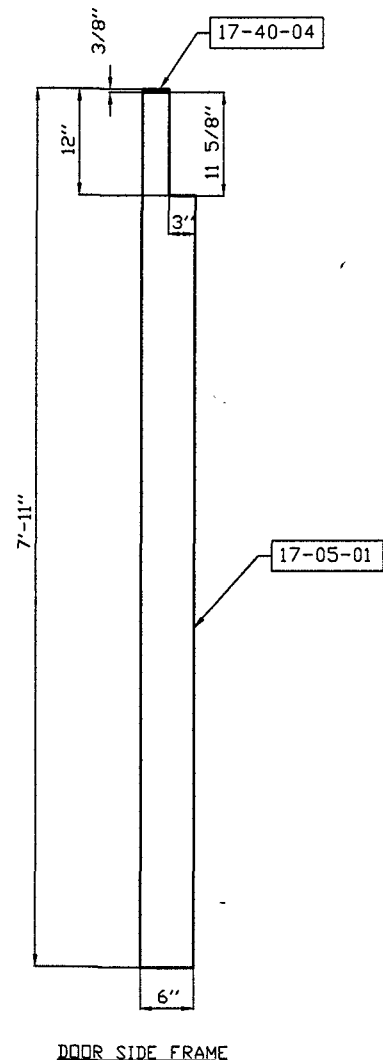

PEDESTRIAN DOOR REINFORCEMENT FRAME
SHOP ASSEMBLY

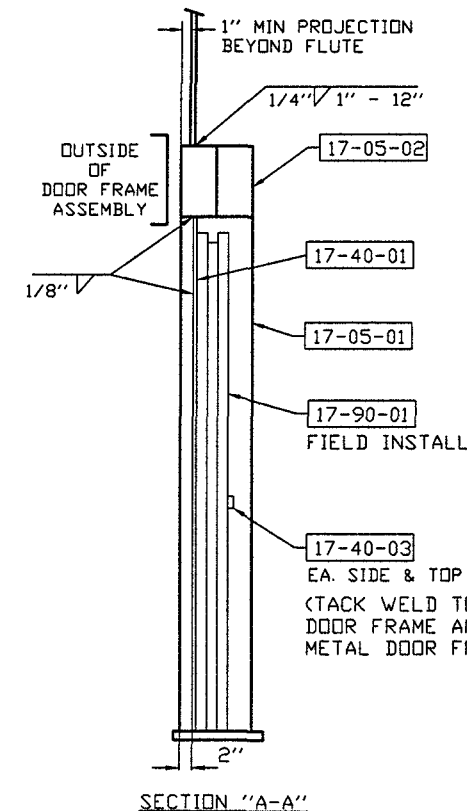


SECTION "A-A"

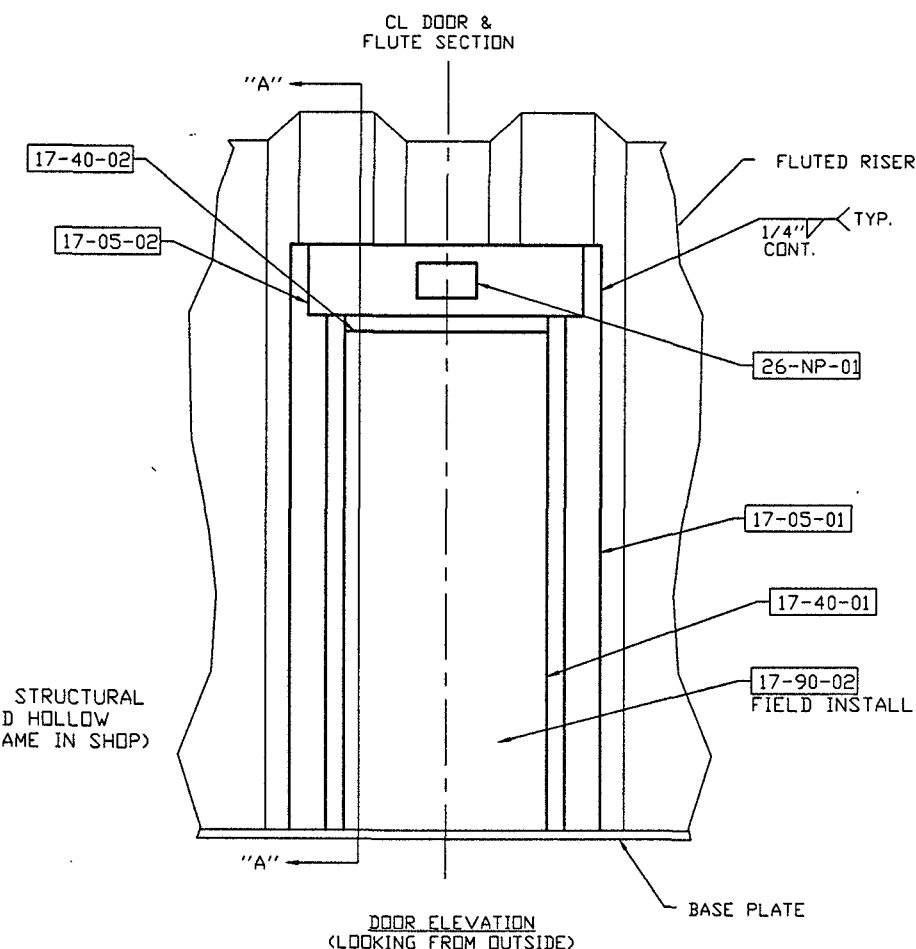

DOOR ELEVATION
(LOOKING FROM OUTSIDE)

- NOTES:
1. DOOR AND FRAME SHALL BE PRIMED WITH A PRIMER COMPATIBLE WITH SHOP PRIME.
 2. SEE DRAWING E-4291 02 FOR ORIENTATION.
 3. SHOP HANG AND CHECK DOOR IN ASSEMBLY. REMOVE AND PROTECT DOOR FOR SHIPMENT.

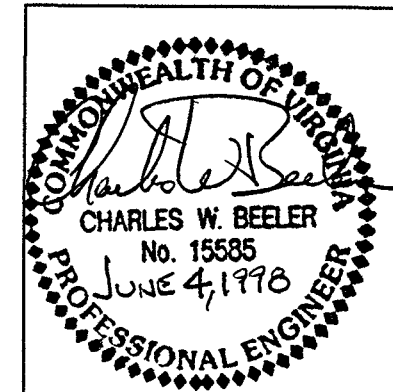

REV.	BY:	DATE	REMARKS
Caldwell Tanks, Inc. Louisville, KY.			
BOTETOURT COUNTY, VA			
BY:	BAW/TB	TITLE:	PEDESTRIAN DOOR
DATE:	4-98	DRAWING NO.:	E-4291