
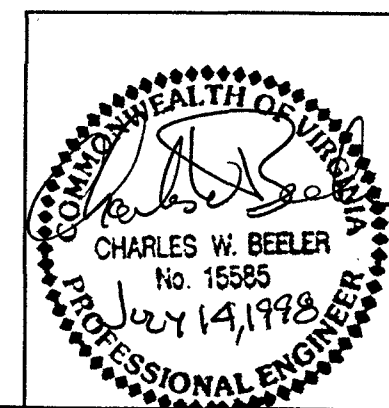


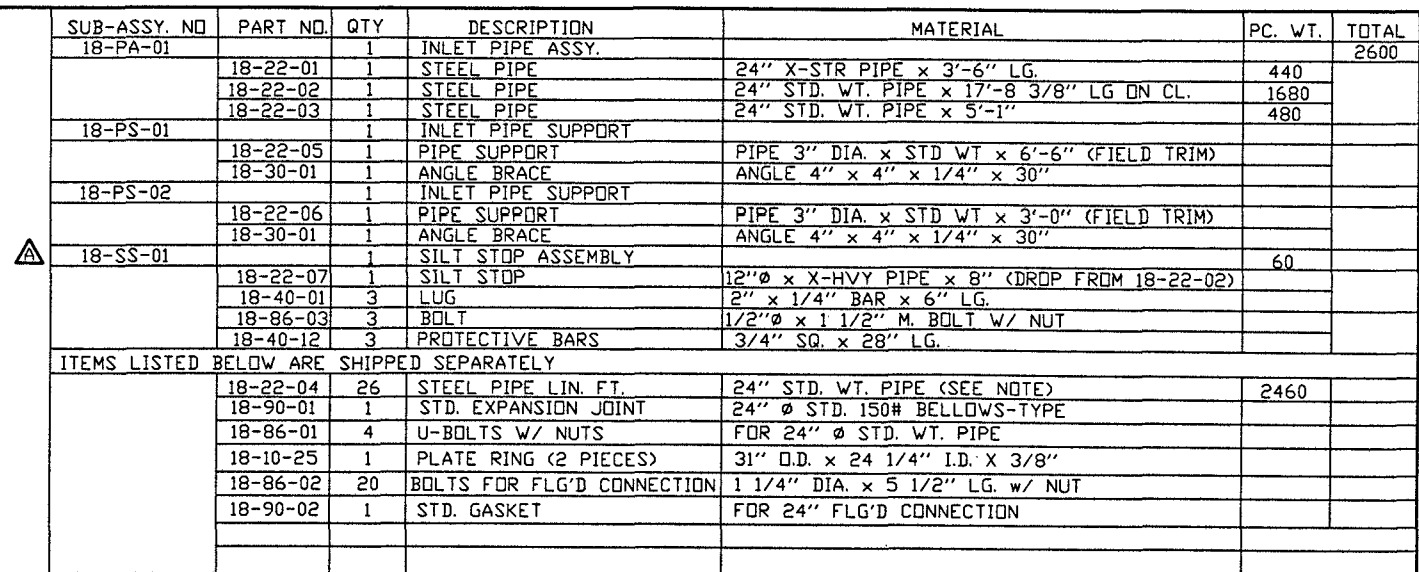

A	BAW	6/98	AS NOTED
REV.	BY:	DATE	REMARKS
CALDWELL TANKS, INC. LOUISVILLE, KY.			
BOTETOURT COUNTY, VA			
BY:	BAW <i>AB</i>	TITLE: INLET PIPING DETAILS	
DATE:	5-98	DRAWING NO.:	E-4291 18