

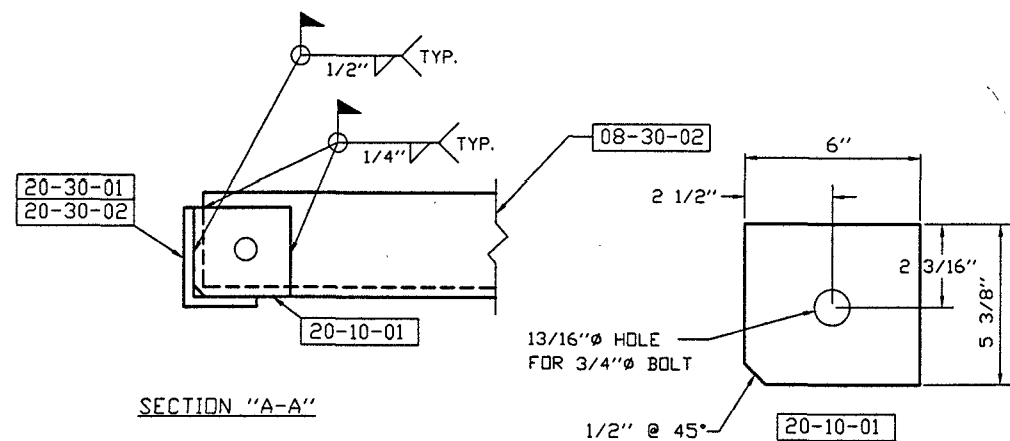
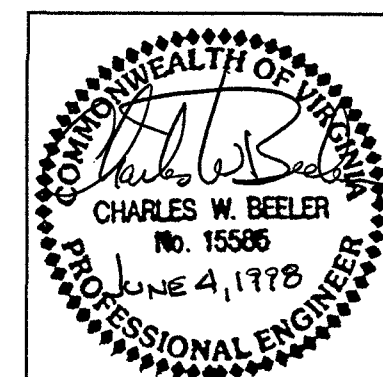
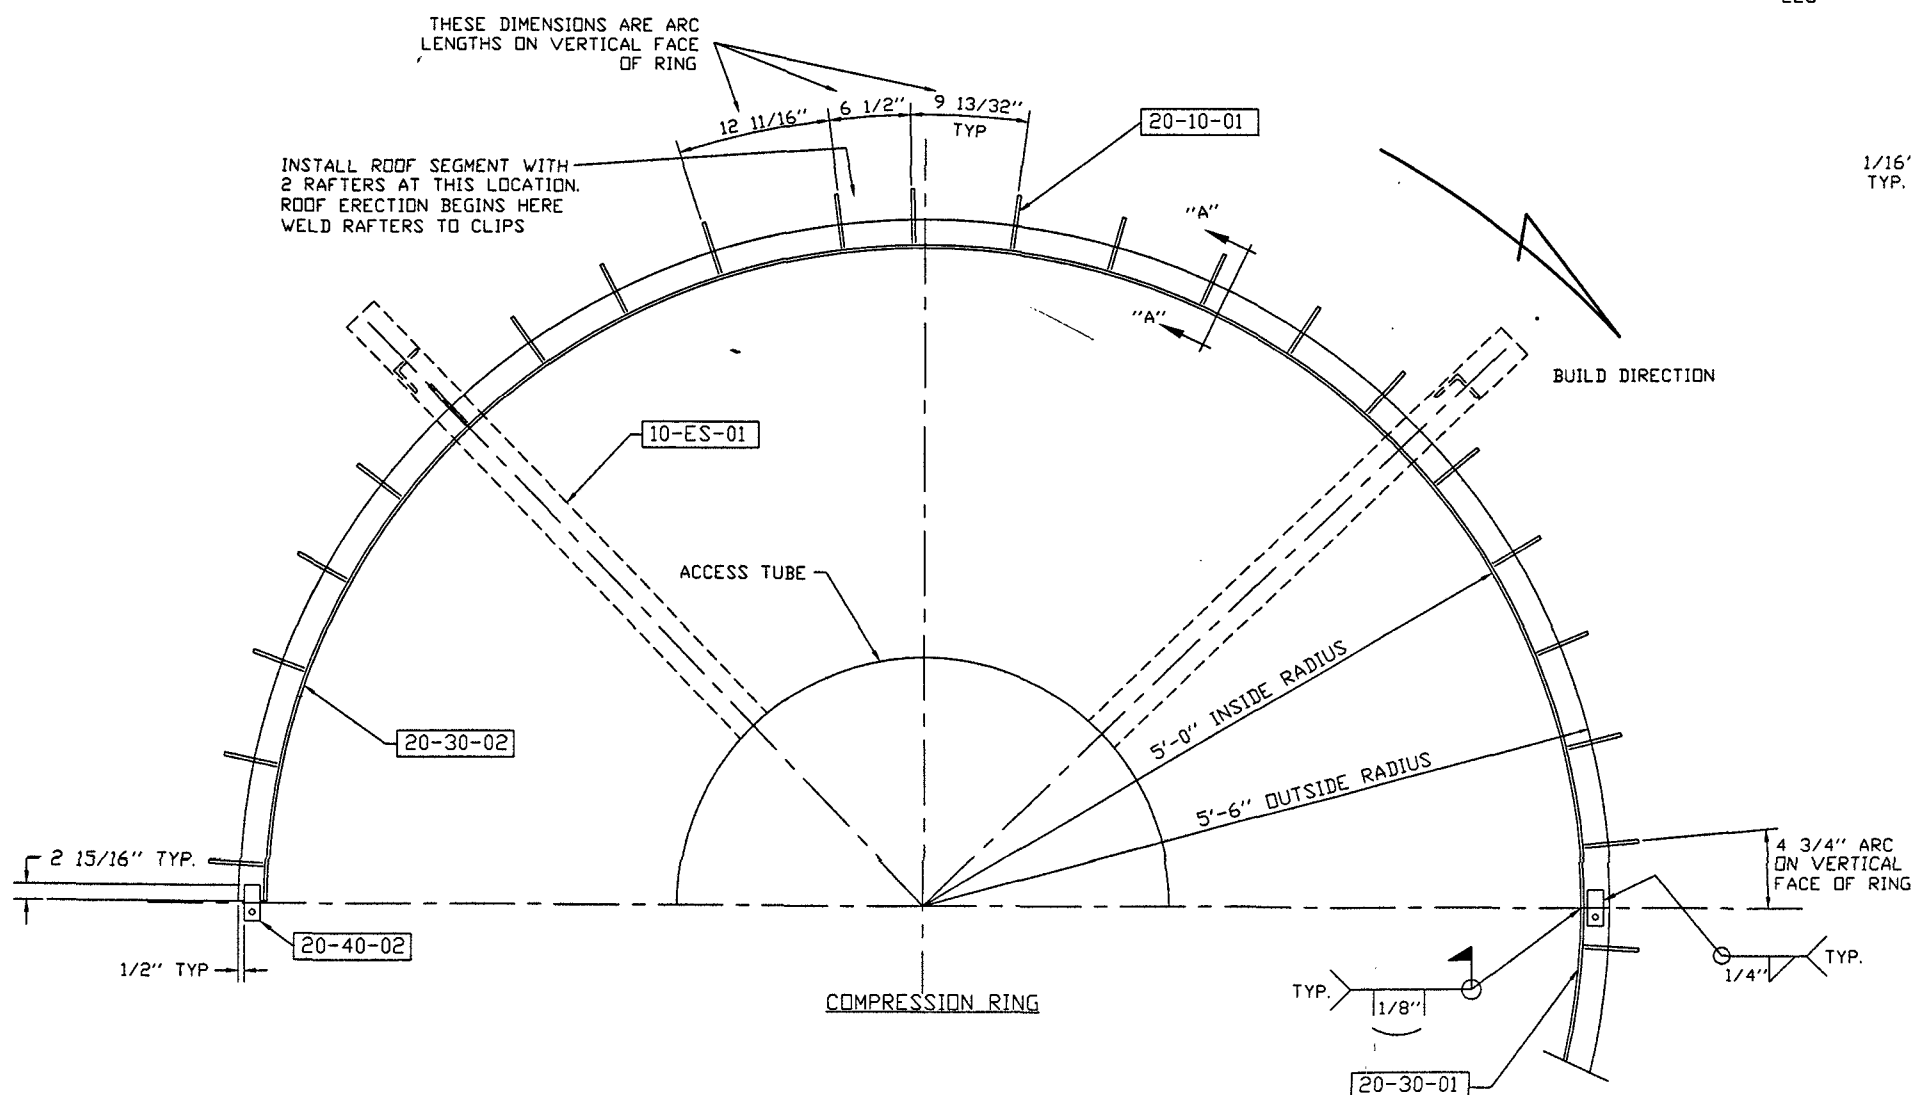


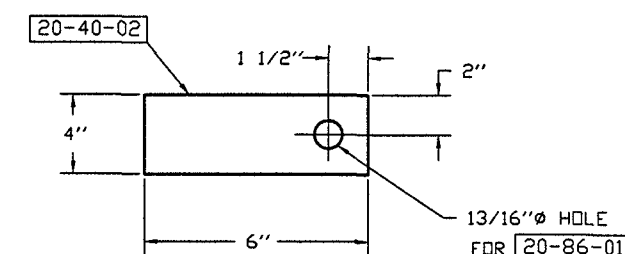

BILL OF MATERIAL					
SUB ASSY NO	PART NO	QTY.	DESCRIPTION	MATERIAL	WT./PC. TOTAL
20-CR-02		1	COMPRESSION RING ASSY.		455
	20-30-02	1	COMPRESSION RING W/D HOLES	6" x 6" x 5/8" STL. ANGLE 18'-5" LG.	450
	20-40-02	2	SPLICE BARS	4" x 3/8" STL. BAR X 6" LG.	
ITEMS LISTED BELOW ARE SHIPPED SEPARATELY					
	20-86-01	2	COMPRESSION RING BOLTS	3/4" Ø X 1 1/2" LG. M. BOLT	
	20-10-01	40	RAFTER CLIPS	6" x 1/2" PLATE x 5 3/8" LG.	
	20-86-02	40	RAFTER CLIP BOLT	BOLT 3/4" Ø x 1 1/2" LG. W/ NUT	
	20-30-01	1	COMPRESSION RING w/HOLES	6" x 6" x 5/8" STL. ANGLE 18'-5" LG.	450

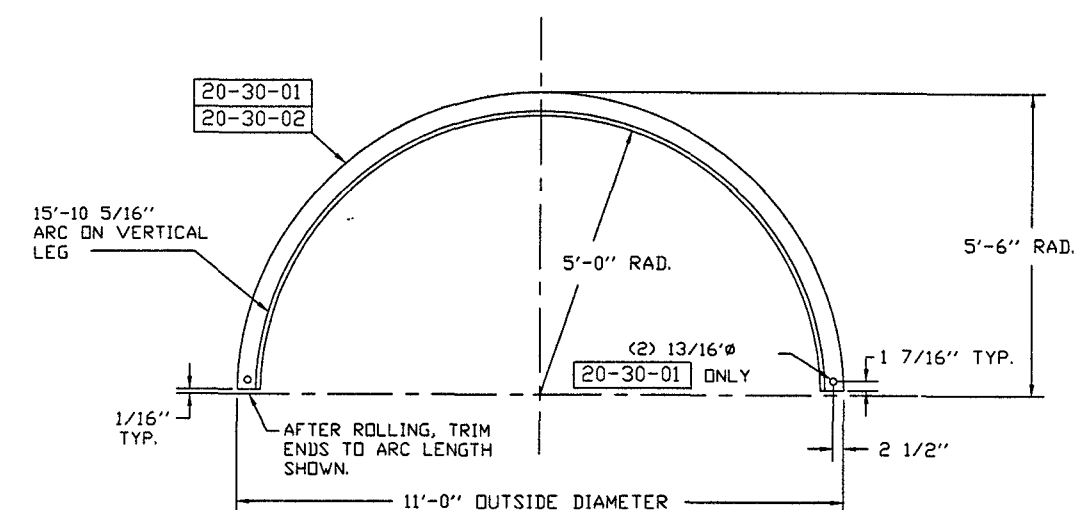

REV.	BY	DATE	REMARKS
Caldwell Tanks, Inc.			
LOUISVILLE, KY.			
BOTETOURT COUNTY, VA			
BY:	BAW/TB	TITLE:	ROOF COMPRESSION RING
DATE:	5-98	DRAWING NO.:	E-4291
			20