
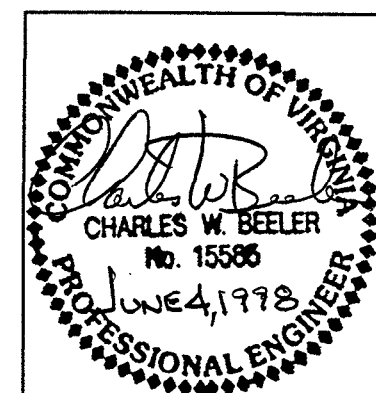
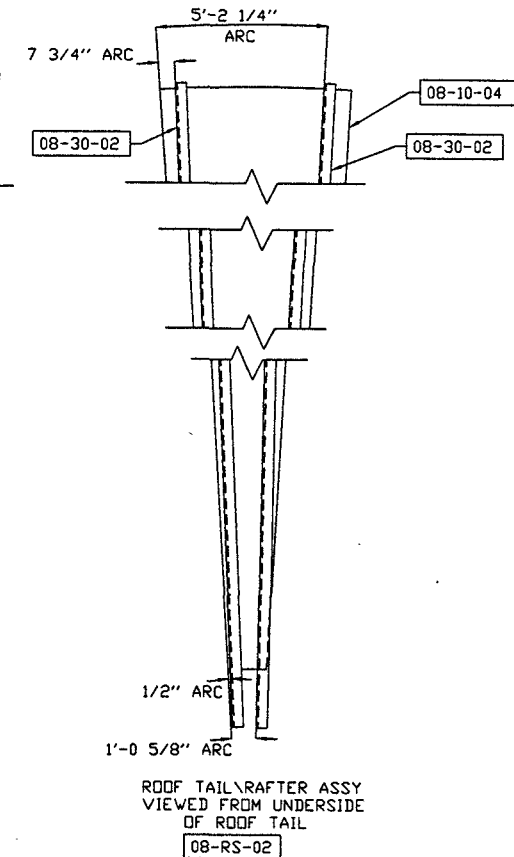
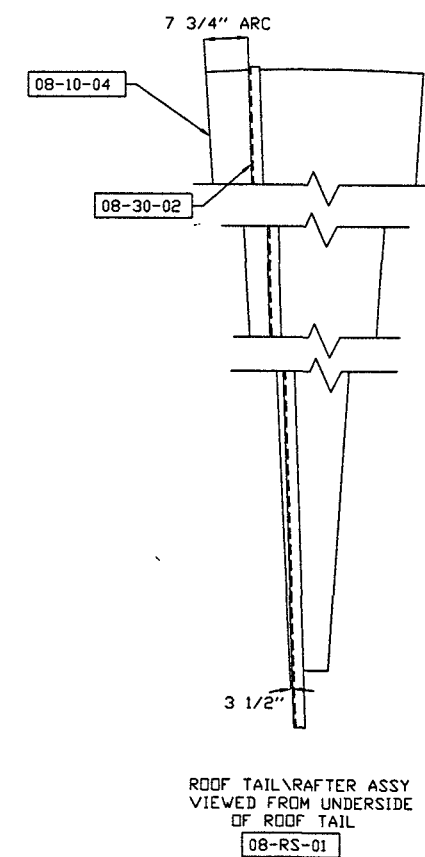
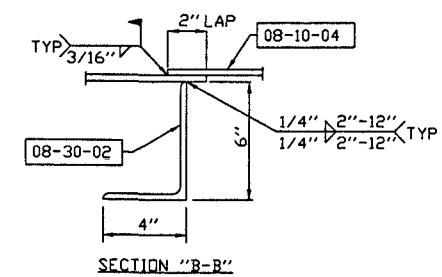
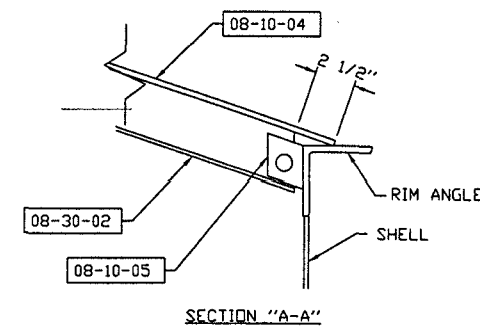


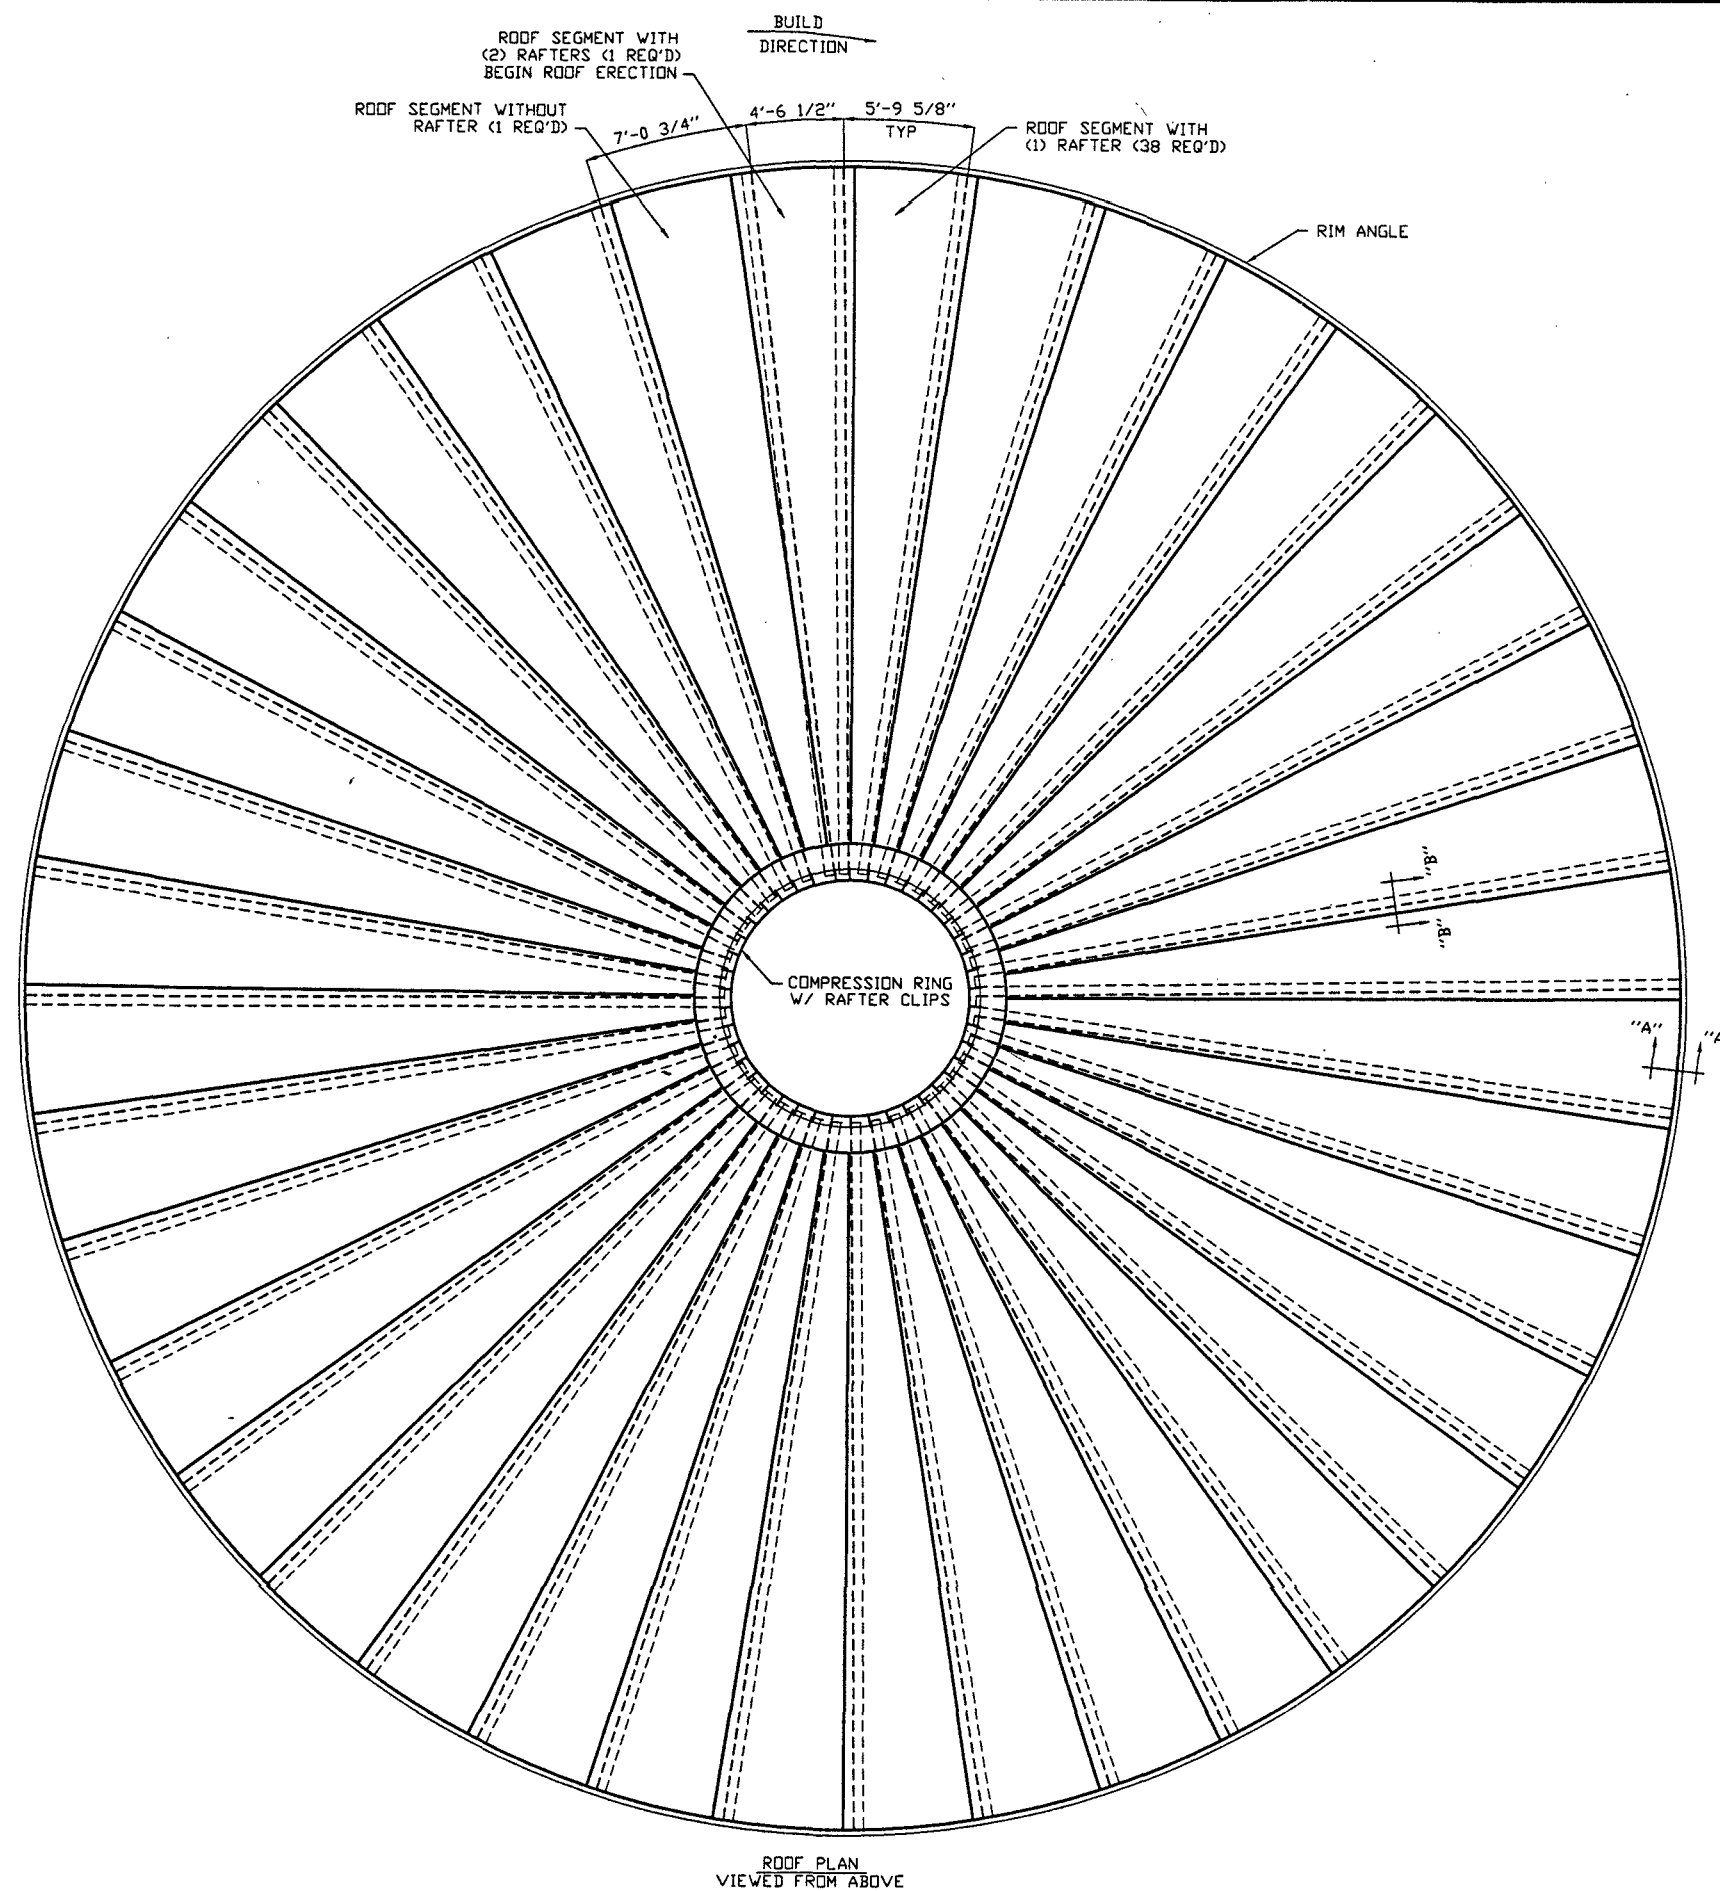

REV.	BY:	DATE	REMARKS
Caldwell Tanks, Inc. Louisville, KY			
BOTETOURT COUNTY, VA			
BY:	BAW	TB	TITLE: ROOF ASSEMBLY
DATE:	5-98	DRAWING NO:	E-4291 21