


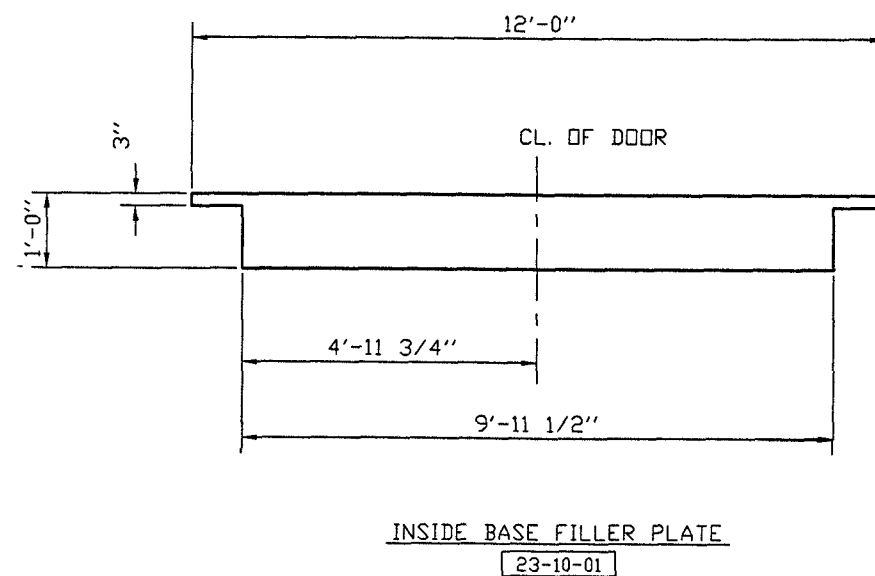


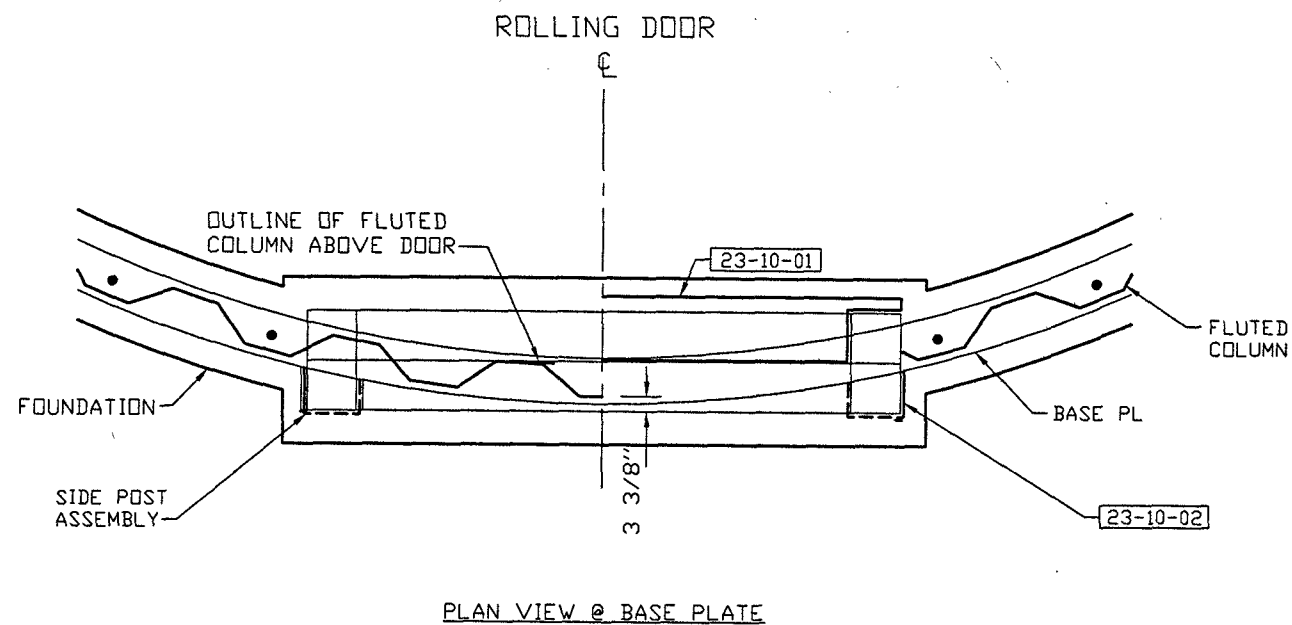


SUB ASS'Y NO.	PART NO.	QUANTITY	DESCRIPTION	MATERIAL REQ'D.	PC WT	TOT WT
ALL ITEMS SHIP LOOSE						
	23-10-01	1	INSIDE BASE FILLER PLATE	12" x 1/4" x 12'-0" LG.	143	
	23-10-02	2	BASE FILLER PLATE	1 1/4" PL. (MISC. DROP)	57	114

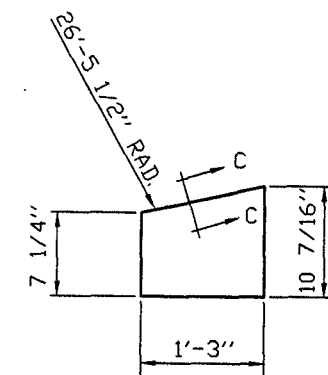

BASE FILLER PLATE
23-10-02
BEVEL ONE AS SHOWN
BEVEL ONE OPPOSITE HAND

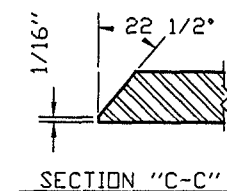

WORK THIS DRAWING
W/DWG. #22

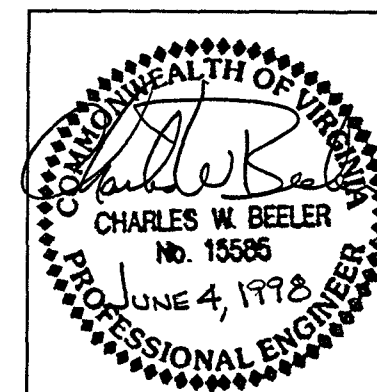

REV.	BY:	DATE	REMARKS
Caldwell Tanks, Inc. Louisville, KY.			
BOTETOURT COUNTY, VA			
BY:	BAW	DATE:	TITLE: ROLLING DOOR FRAMING
		5-98	DRAWING NO: E-4291
			23