


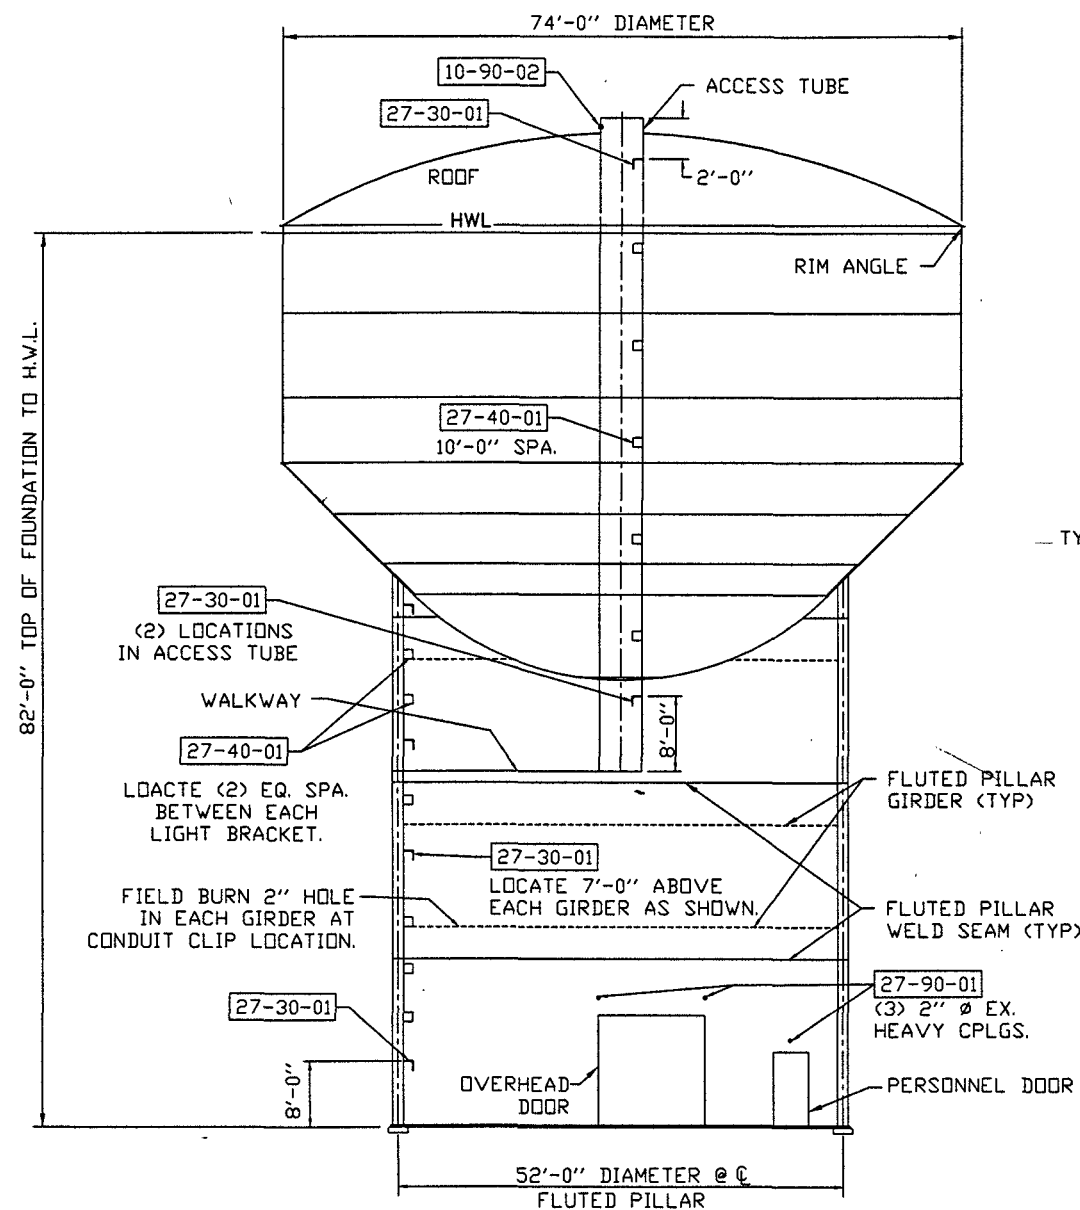


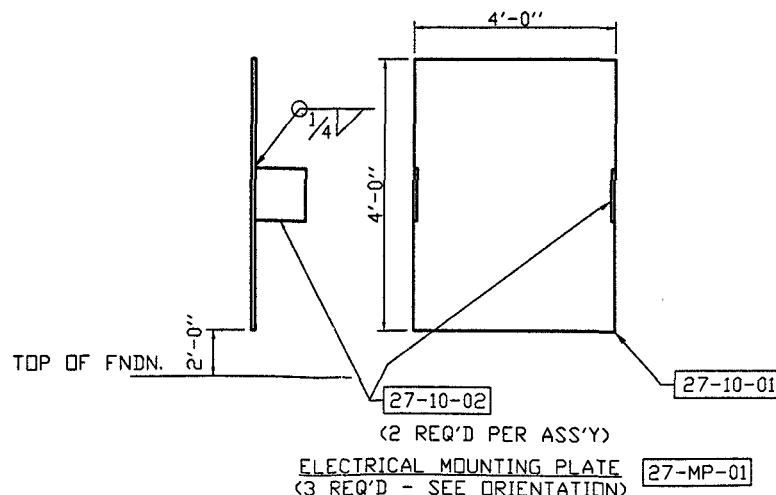

ELEVATION

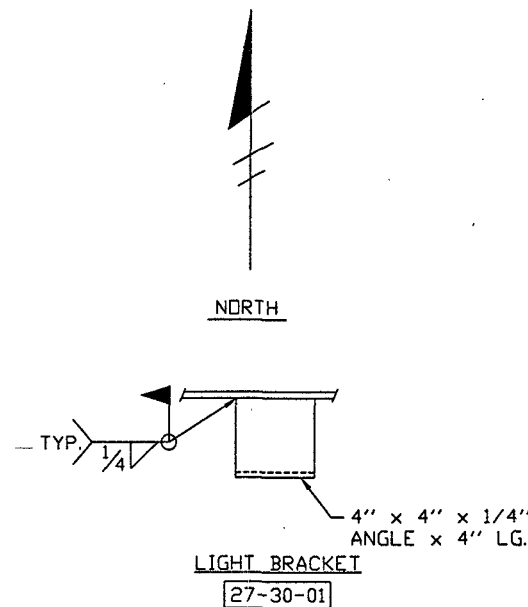


BILL OF MATERIAL				
SUB-ASS'Y NO.	PART NO.	QUANTITY	DESCRIPTION	MATERIAL REQ'D.
27-MP-01	27-10-01	3	ELECTRICAL MOUNTING PLATE	
	27-10-02	1	PLATE	48" x 1/4" PLATE x 48"
	27-10-02	2	SIDE BRACES	12" x 1/4" PLATE x 12" LG.
THE FOLLOWING ITEMS ARE TO BE SHIPPED LOOSE				
	27-30-01	15	LIGHT BRACKETS	4" x 4" x 1/4" ANGLE x 4" LG.
	27-40-01	21	CONDUIT CLIP	2" x 1/4" BAR x 6" LG.
	27-90-01	3	COUPLINGS	2" EXTRA HEAVY COUPLINGS w/PLUGS
THE FOLLOWING ITEMS ARE TO BE SHIPPED WITH ACCESS TUBE				
	27-30-01	2	LIGHT BRACKETS	4" x 4" x 1/4" ANGLE x 4" LG.
	27-40-01	6	CONDUIT CLIP	2" x 1/4" BAR x 6" LG.

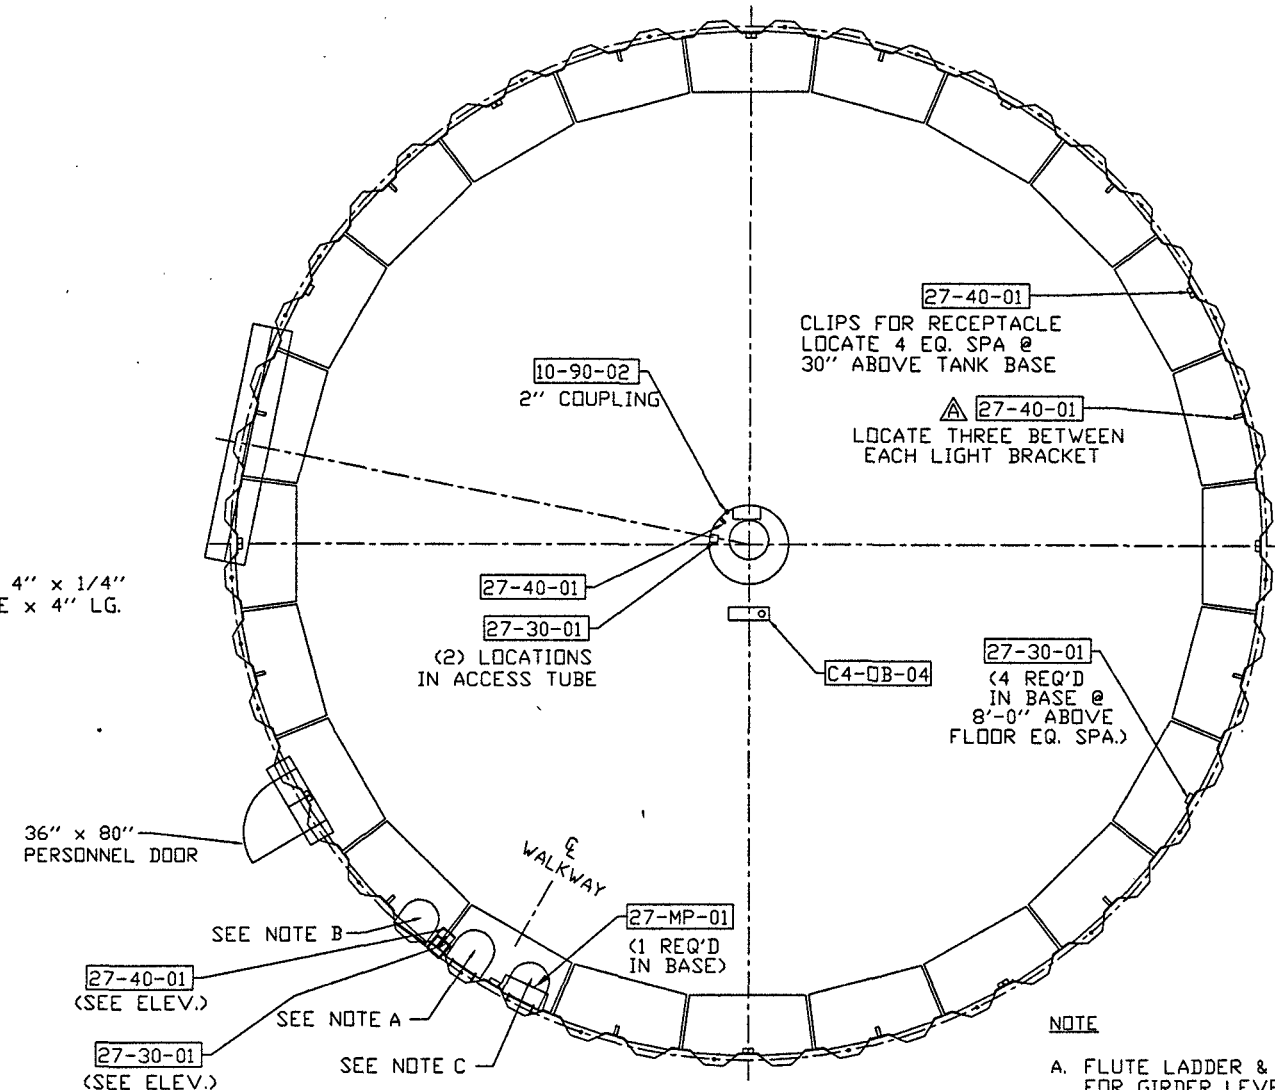

NOTE

- A. FLUTE LADDER & OPENING FOR GIRDER LEVEL 1
- B. FLUTE LADDER & OPENING FOR GIRDER LEVEL 2
- C. FLUTE LADDER & OPENING FOR GIRDER LEVEL 3

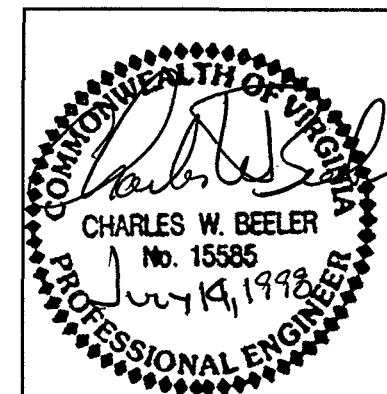

A	BAW	7/98	CORRECT REF. NUMBER
REV.	BY:	DATE	REMARKS
Caldwell Tanks, Inc.			
LOUISVILLE, KY.			
BOTETOURT COUNTY, VA			
BY: BAW	DATE: 5-98	TITLE: 1,000,000 GALLON FLUTED COLUMN ELECTRICAL CLIP DETAILS	DRAWING NO: E-4114