

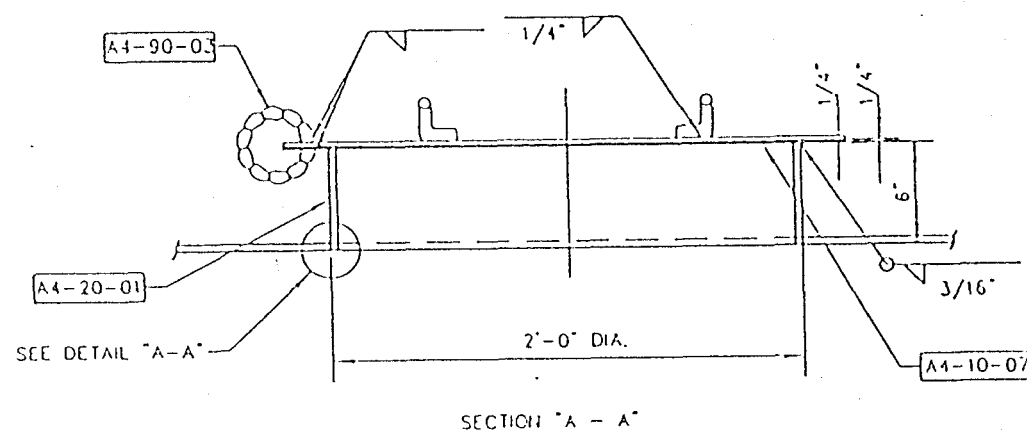


SUB ASS'Y NO.	PART NO.	QUANTITY	DESCRIPTION	MATERIAL REQ'D.	WEIGHT
A4-ME-24		1	24" DIA. ROOF MANHOLE (BOLTED) EXHAUST FAN		1547
	A4-10-06	1	STEEL PLATE w/ 4 - 13/16" DIA. HOLES	1/4" THK. x 2'-9" DIA.	
	A4-10-07	1	PLATE FLANGE w/ 4 - 13/16" DIA. HOLES	2'-9" O.D. x 1/4" x 2'-0" I.D.	
	A4-20-01	1	STEEL PIPE	24" O.D. x 1/4" x 11.111' x 6" LG.	
	A4-B6-01	4	M. BOLTS w/ NUTS (STD.)	3/4" DIA. x 1 1/2" LG. (ZINC PL.)	
	A1-35-04	2	BENT ROD (HANDLES) (STD.)	5/8" DIA. x 15" LG. (BENT)	
	A4-90-03	1	CHAIN (STD.)	3/0 x 12" LG.	

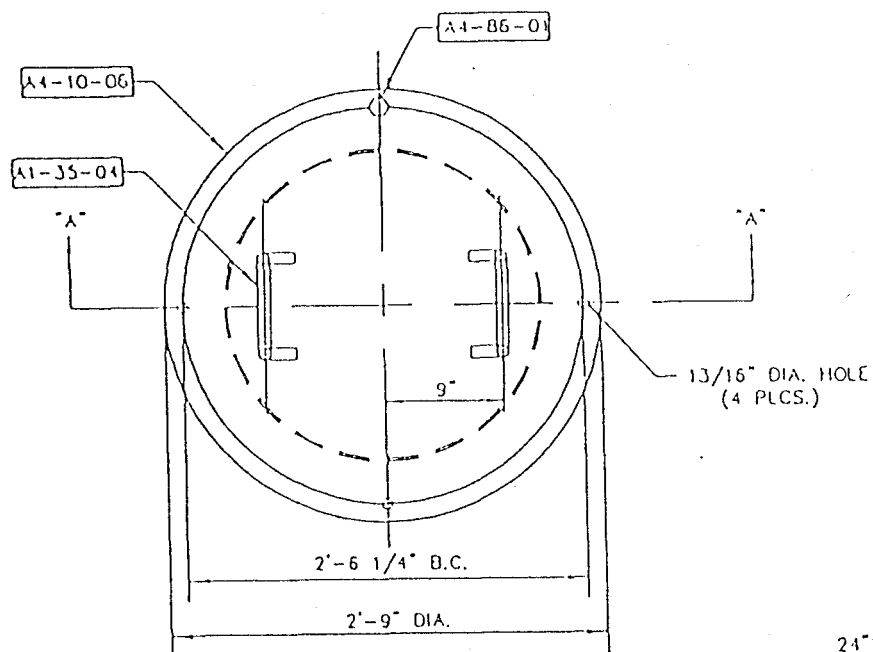

24" DIA. ROOF MANHOLE (BOLTED)

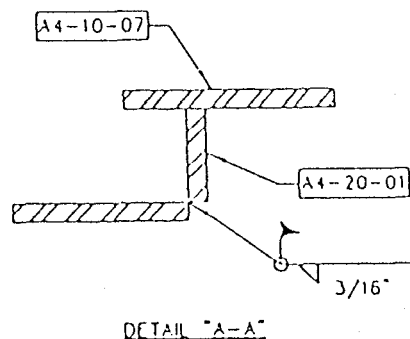

CALDWELL TANKS, INC.
LOUISVILLE, KY.

TITLE: 24" DIA. ROOF MANHOLE (BOLTED)
EXHAUST FAN MANHOLE

DRAWING NO.: A4