
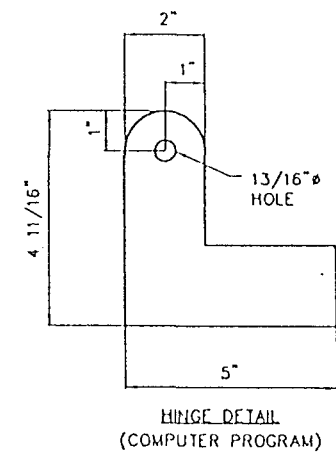
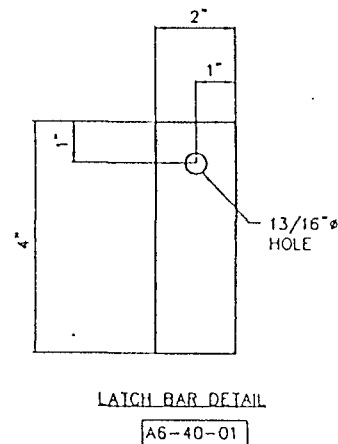


SUB ASS'Y NO.	PART NO.	QUANTITY	DESCRIPTION	MATERIAL REQ'D.	WEIGHT
A9-MP-30		1	30" ACCESS MANHOLE		138#
	A7-10-03	1	1/4" PLT. COVER (STD.)	33" O.D. x 3/16" MIN.	
	A7-40-04	1	OVERLAPING BAR RING ROLL TO 32 1/2" O.D. (STD.)	2" x 1/4" x 8'-5 5/16" LG.	
	A1-35-04	1	HANDLE- INSTALLED UNDERSIDE OF LID (FORMED ROD)	5/8" DIA. x 15" LG. (BENT)	
	A4-86-01	3	M. BOLTS w/ NUTS (STD.)	3/4" DIA. x 1 1/2" LG.	
	A9-20-04	1	STEEL TUBE	30" O.D. x 3/4" THK. x 14" LG	
		2	HINGE BARS (COMPUTER PROGRAM) (STD.)	3/8" MIN. PLT.	
	A8-90-01	1	SAFETY HASP		
	A6-40-01	2	HINGE BAR w/ 13/16" HOLE (STD.)	2" x 3/8" x 4" LG.	

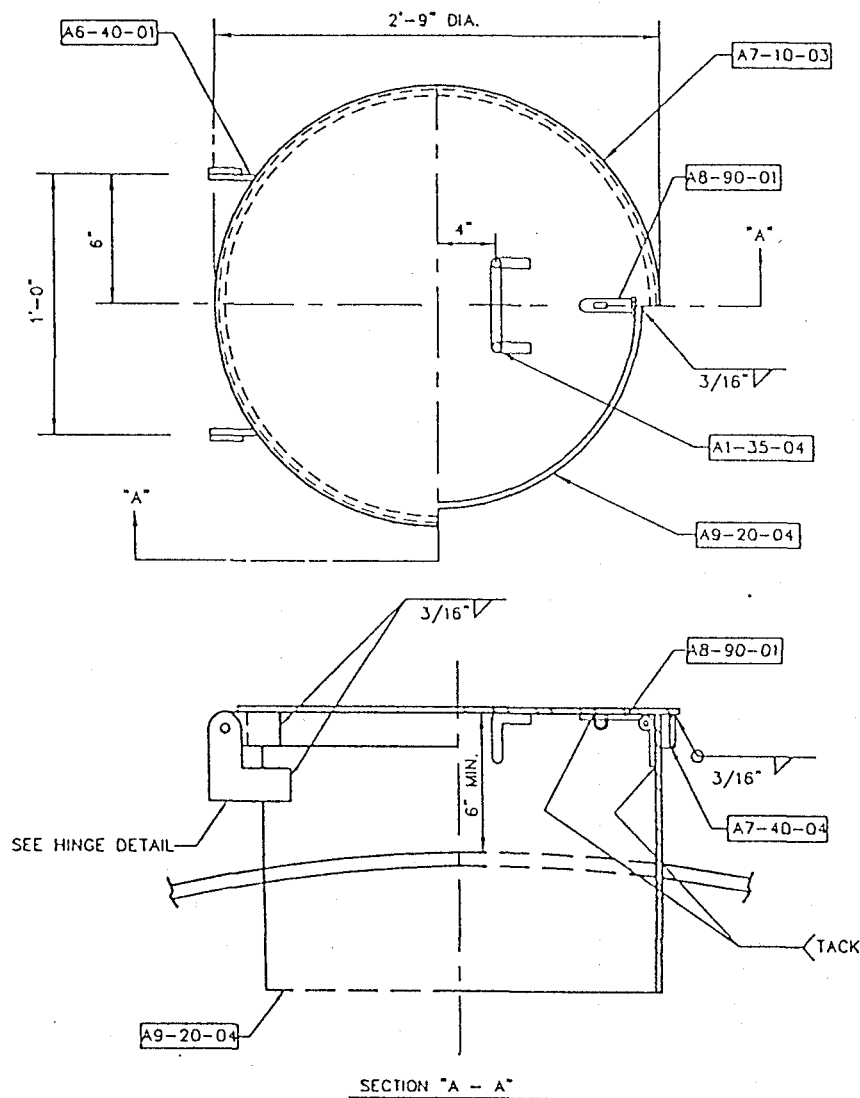

CALDWELL TANKS, INC.
LOUISVILLE, KY.

TITLE:

30" ACCESS MANHOLE

DRAWING NO.:

A9