

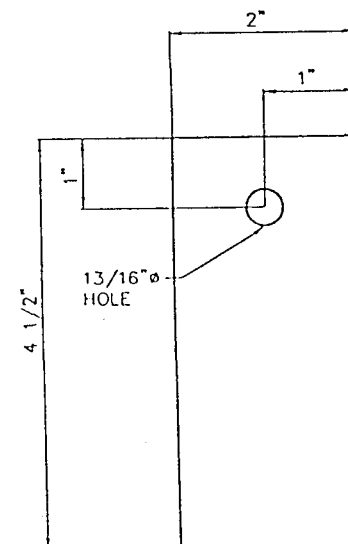


BILL OF MATERIAL					
SUB ASS'Y NO.	PART NO.	QUANTITY	DESCRIPTION	MATERIAL REQ'D.	WEIGHT
B2-MR-30		1	30" DIAMETER ROOF MANHOLE		149#
	A7-10-03	1	MANHOLE COVER (STD.)	33" DIA. x 3/16" MIN. PLT.	
	A7-40-04	1	OVERLAPING BAR RING (ROLL TO 32 1/2"OD)	2" x 1/4" BAR x 101 5/16" LG.	
	A6-40-01	6	HINGE / LATCH BAR (STD.)	2" x 3/8" BAR x 4 1/2"	
	A4-86-01	3	MACHINE BOLT / NUTS (STD.)	3/4" DIA. x 1 1/2" ZINC PL.	
ALL ITEMS LISTED BELOW ARE SHIPPED LOOSE					
	A5-20-02	1	MANHOLE NECK (STD.)	30" O.D. x 1/4" MIN. x 6" LG.	

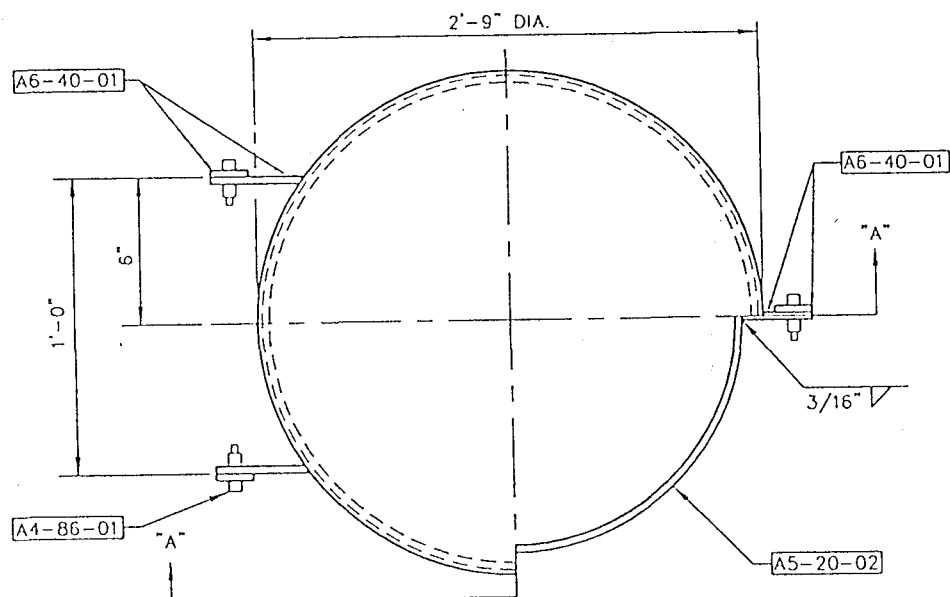

HINGE AND LATCH BAR DETAIL

A6-40-01

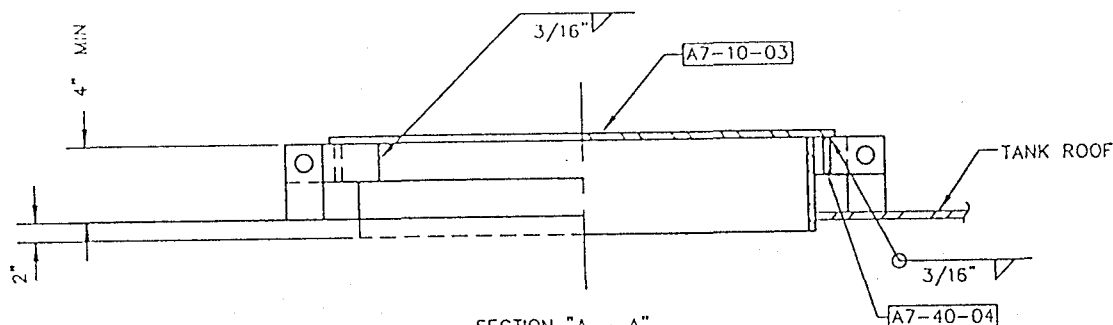

SECTION "A - A"
30" DIA. ROOF MANHOLE

B2-MR-30

CALDWELL TANKS, INC.
LOUISVILLE, KY.

TITLE: 30" DIAMETER ROOF MANHOLE

DRAWING NO.: B2