


BILL OF MATERIAL					
SUB-ASSY NO	PART NO	QTY	DESCRIPTION	MAT'L. REQ'D.	PC WT LBS
C4-OB-04		1	OBST. LIGHT BRACKET		
	C4-30-01	1	OBST. LIGHT BRACKET	3" x 3" x 1/4" x 4'-0" LG.	15
	C4-75-01	1	COUPLING	1" DIA. STD. WT. CPLG.	
ITEMS LISTED BELOW SHIP LOOSE (ELEVATED LEG TANKS ONLY)					
	C4-40-01	2	CONDUIT LUG	1 1/2" x 1/4" x 3" LG.	

NOTES:

C.T.I. SHALL FURNISH AND INSTALL FIXTURE SUPPORT BRACKET ON TANK ROOF

FOR ELEVATED LEG TANKS, INSTALL TWO CONDUIT LUGS BELOW LADDER ON LADDER COLUMN AND TANK ERECTOR SHALL CUT A 2" DIA. ENTRANCE HOLE IN BALCONY FLOOR IN LINE WITH TOWER LADDER BRACES.

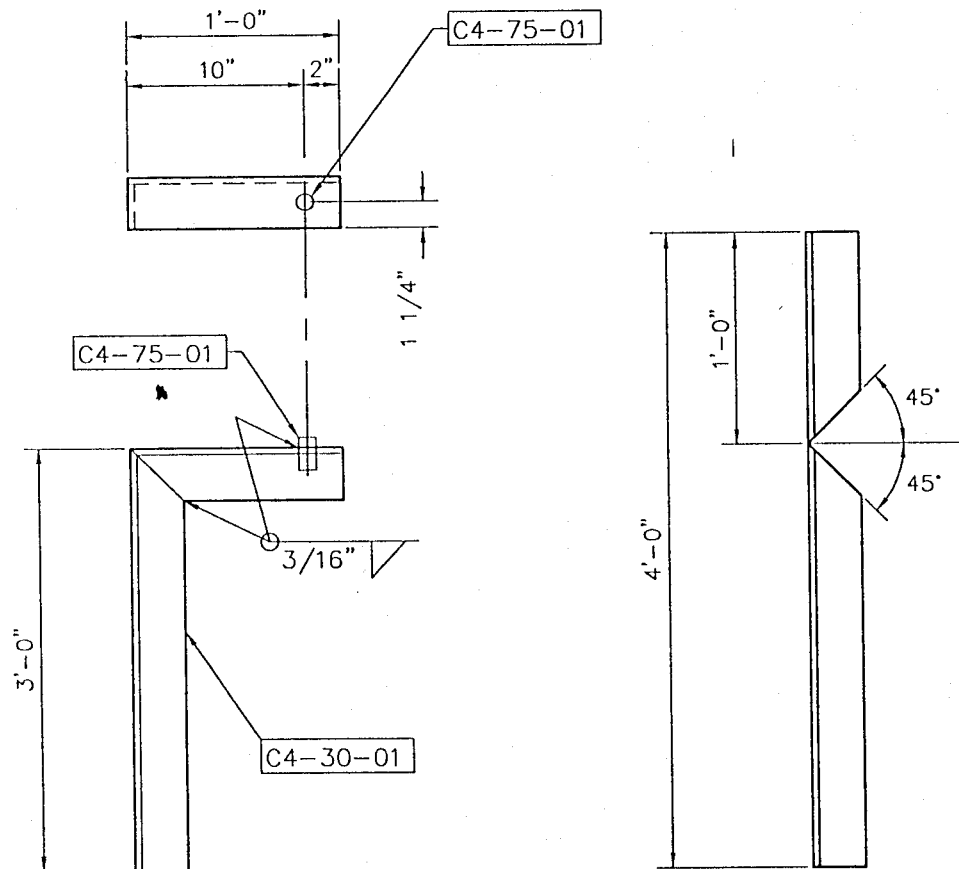

SNIDE 45° TYP.
BEND DOWN 90°

SUPPORT BRACKET

C4-OB-04

CALDWELL TANKS, INC.
LOUISVILLE, KY.

TITLE:

OBSTRUCTION LIGHT BRACKET

DRAWING NO.:

C4