


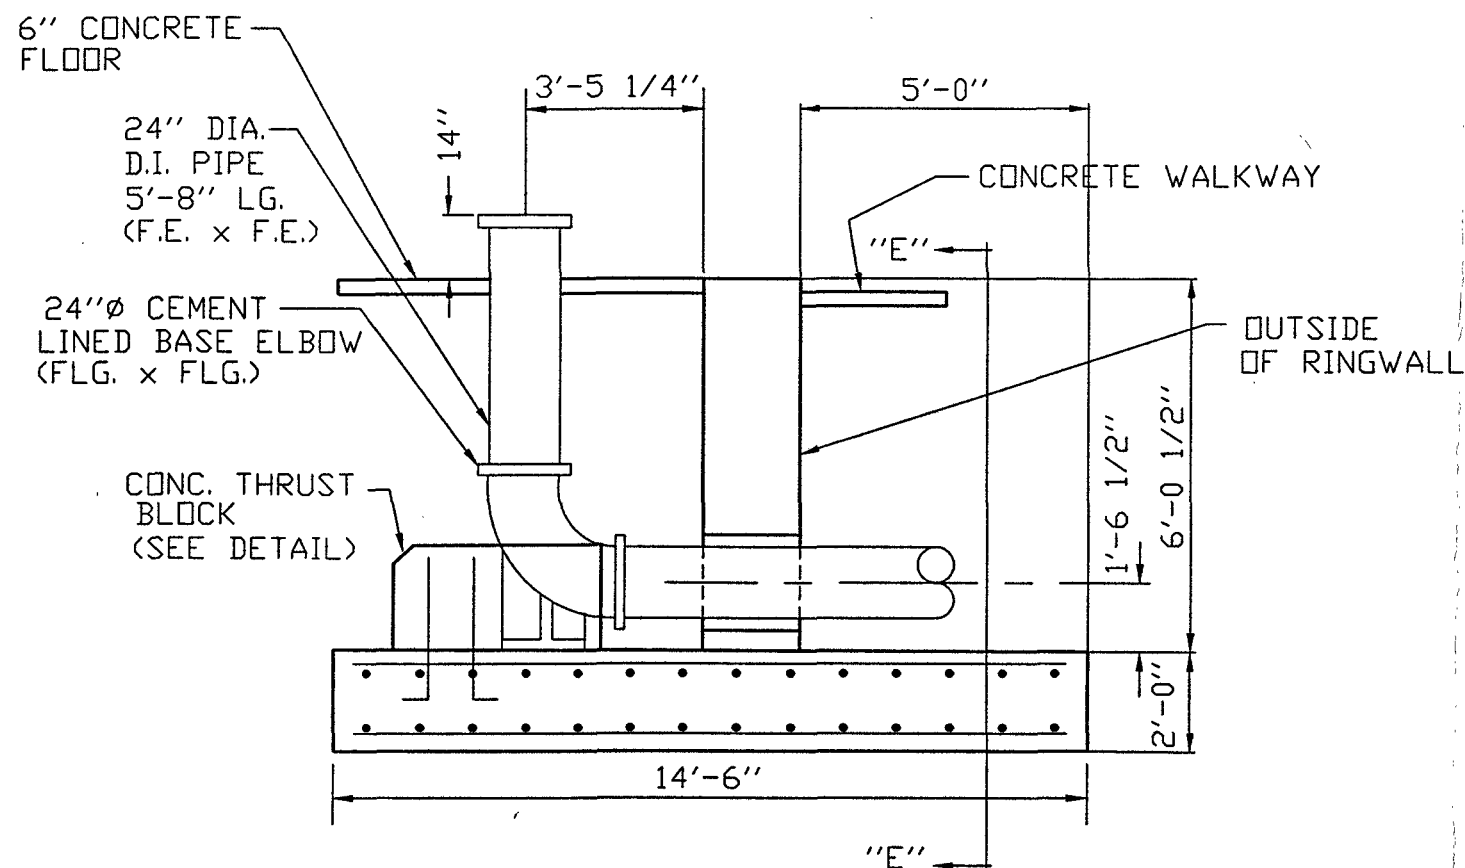


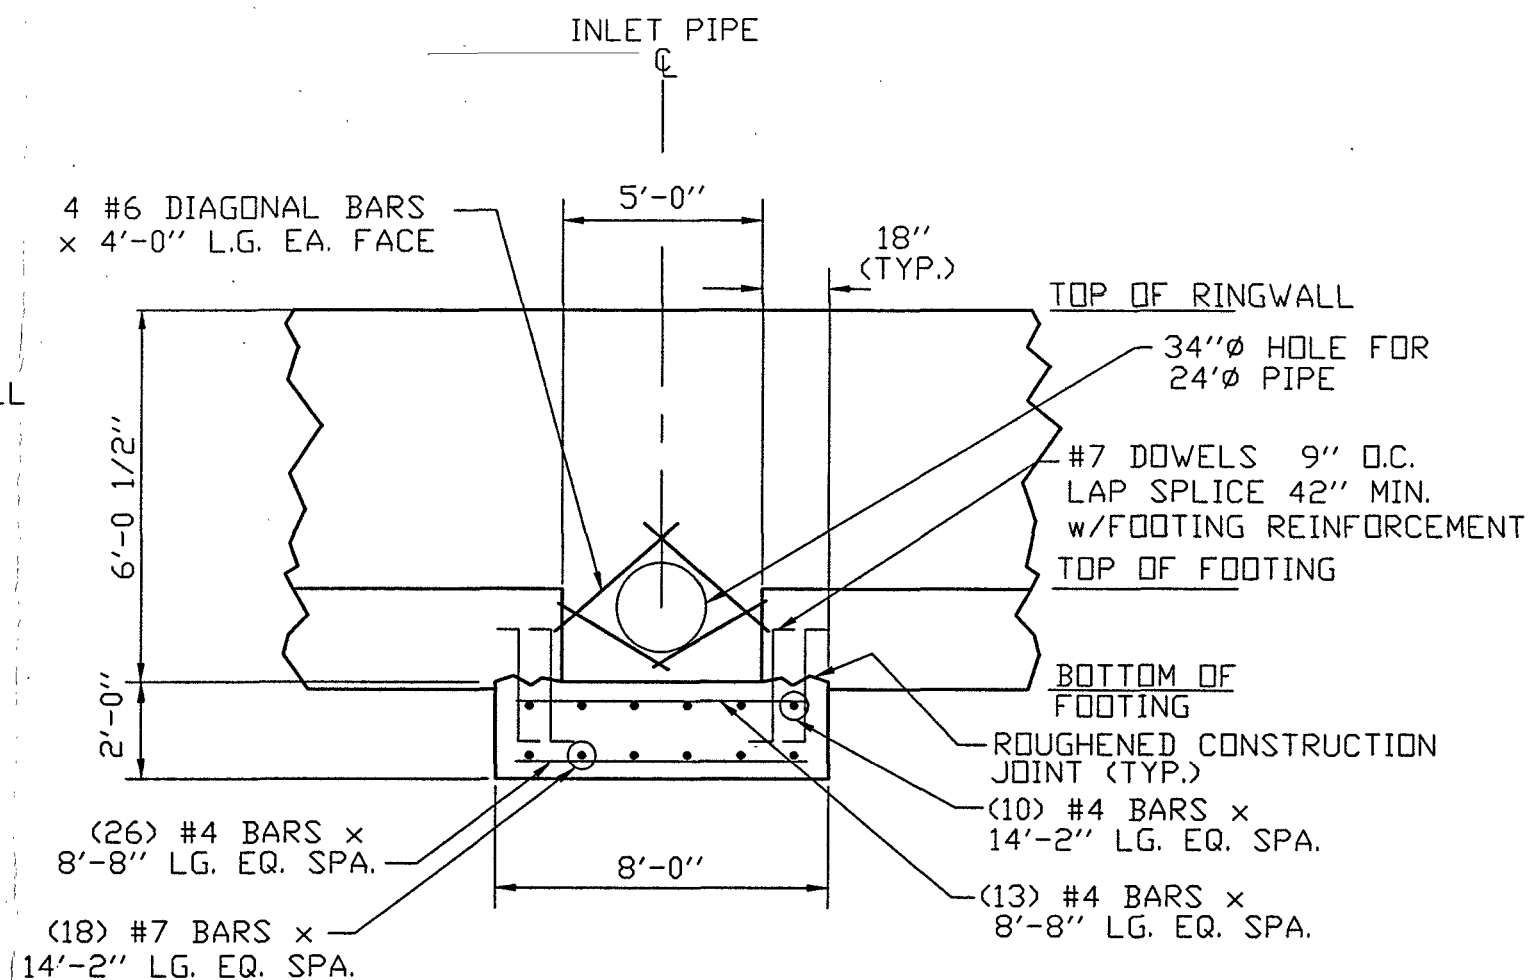


SECTION "D-D"  
FOOTING NOT SHOWN FOR CLARITY

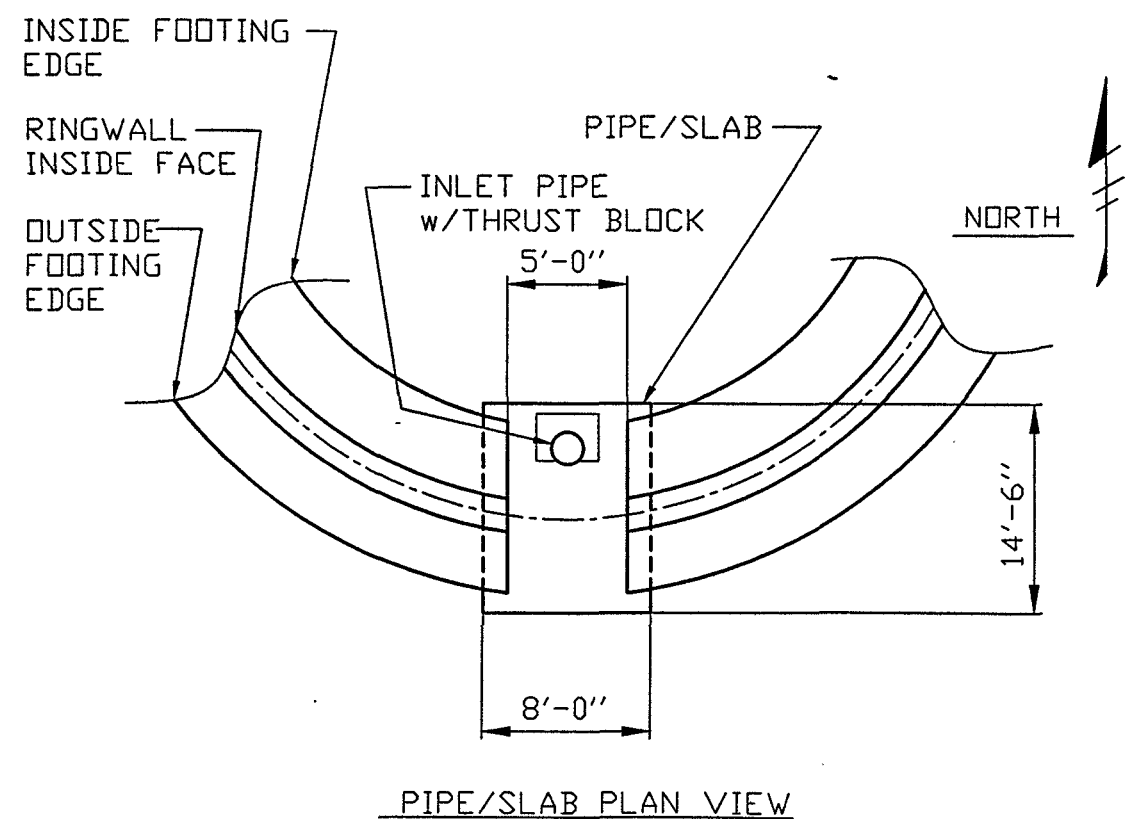

SECTION "E-E"

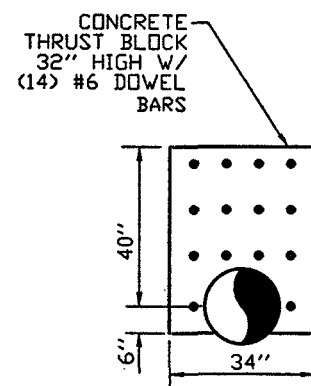

THRUST BLOCK DETAIL  
24" DIA. BASE ELL

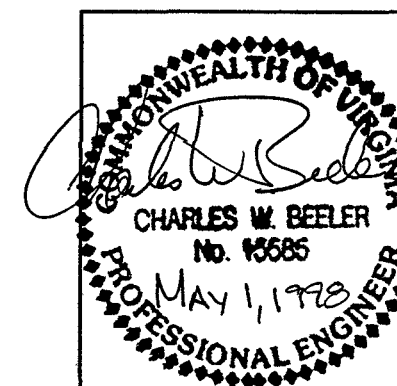

| REV.                           | BY:  | DATE         | REMARKS               |
|--------------------------------|------|--------------|-----------------------|
|                                |      |              |                       |
| Caldwell Tanks, Inc            |      |              |                       |
| LOUISVILLE, KY 40219           |      |              |                       |
| 1,000,000 GALLON FLUTED COLUMN |      |              |                       |
| BOTETOURT COUNTY, VIRGINIA     |      |              |                       |
| BY:                            | BAW  | TITLE:       | MISCELLANEOUS DETAILS |
| DATE:                          | 4-98 | DRAWING NO.: | E-4291 F4 OF 4        |