


MIXER PLATFORM DETAIL


SCALE: 1"=1'-0"

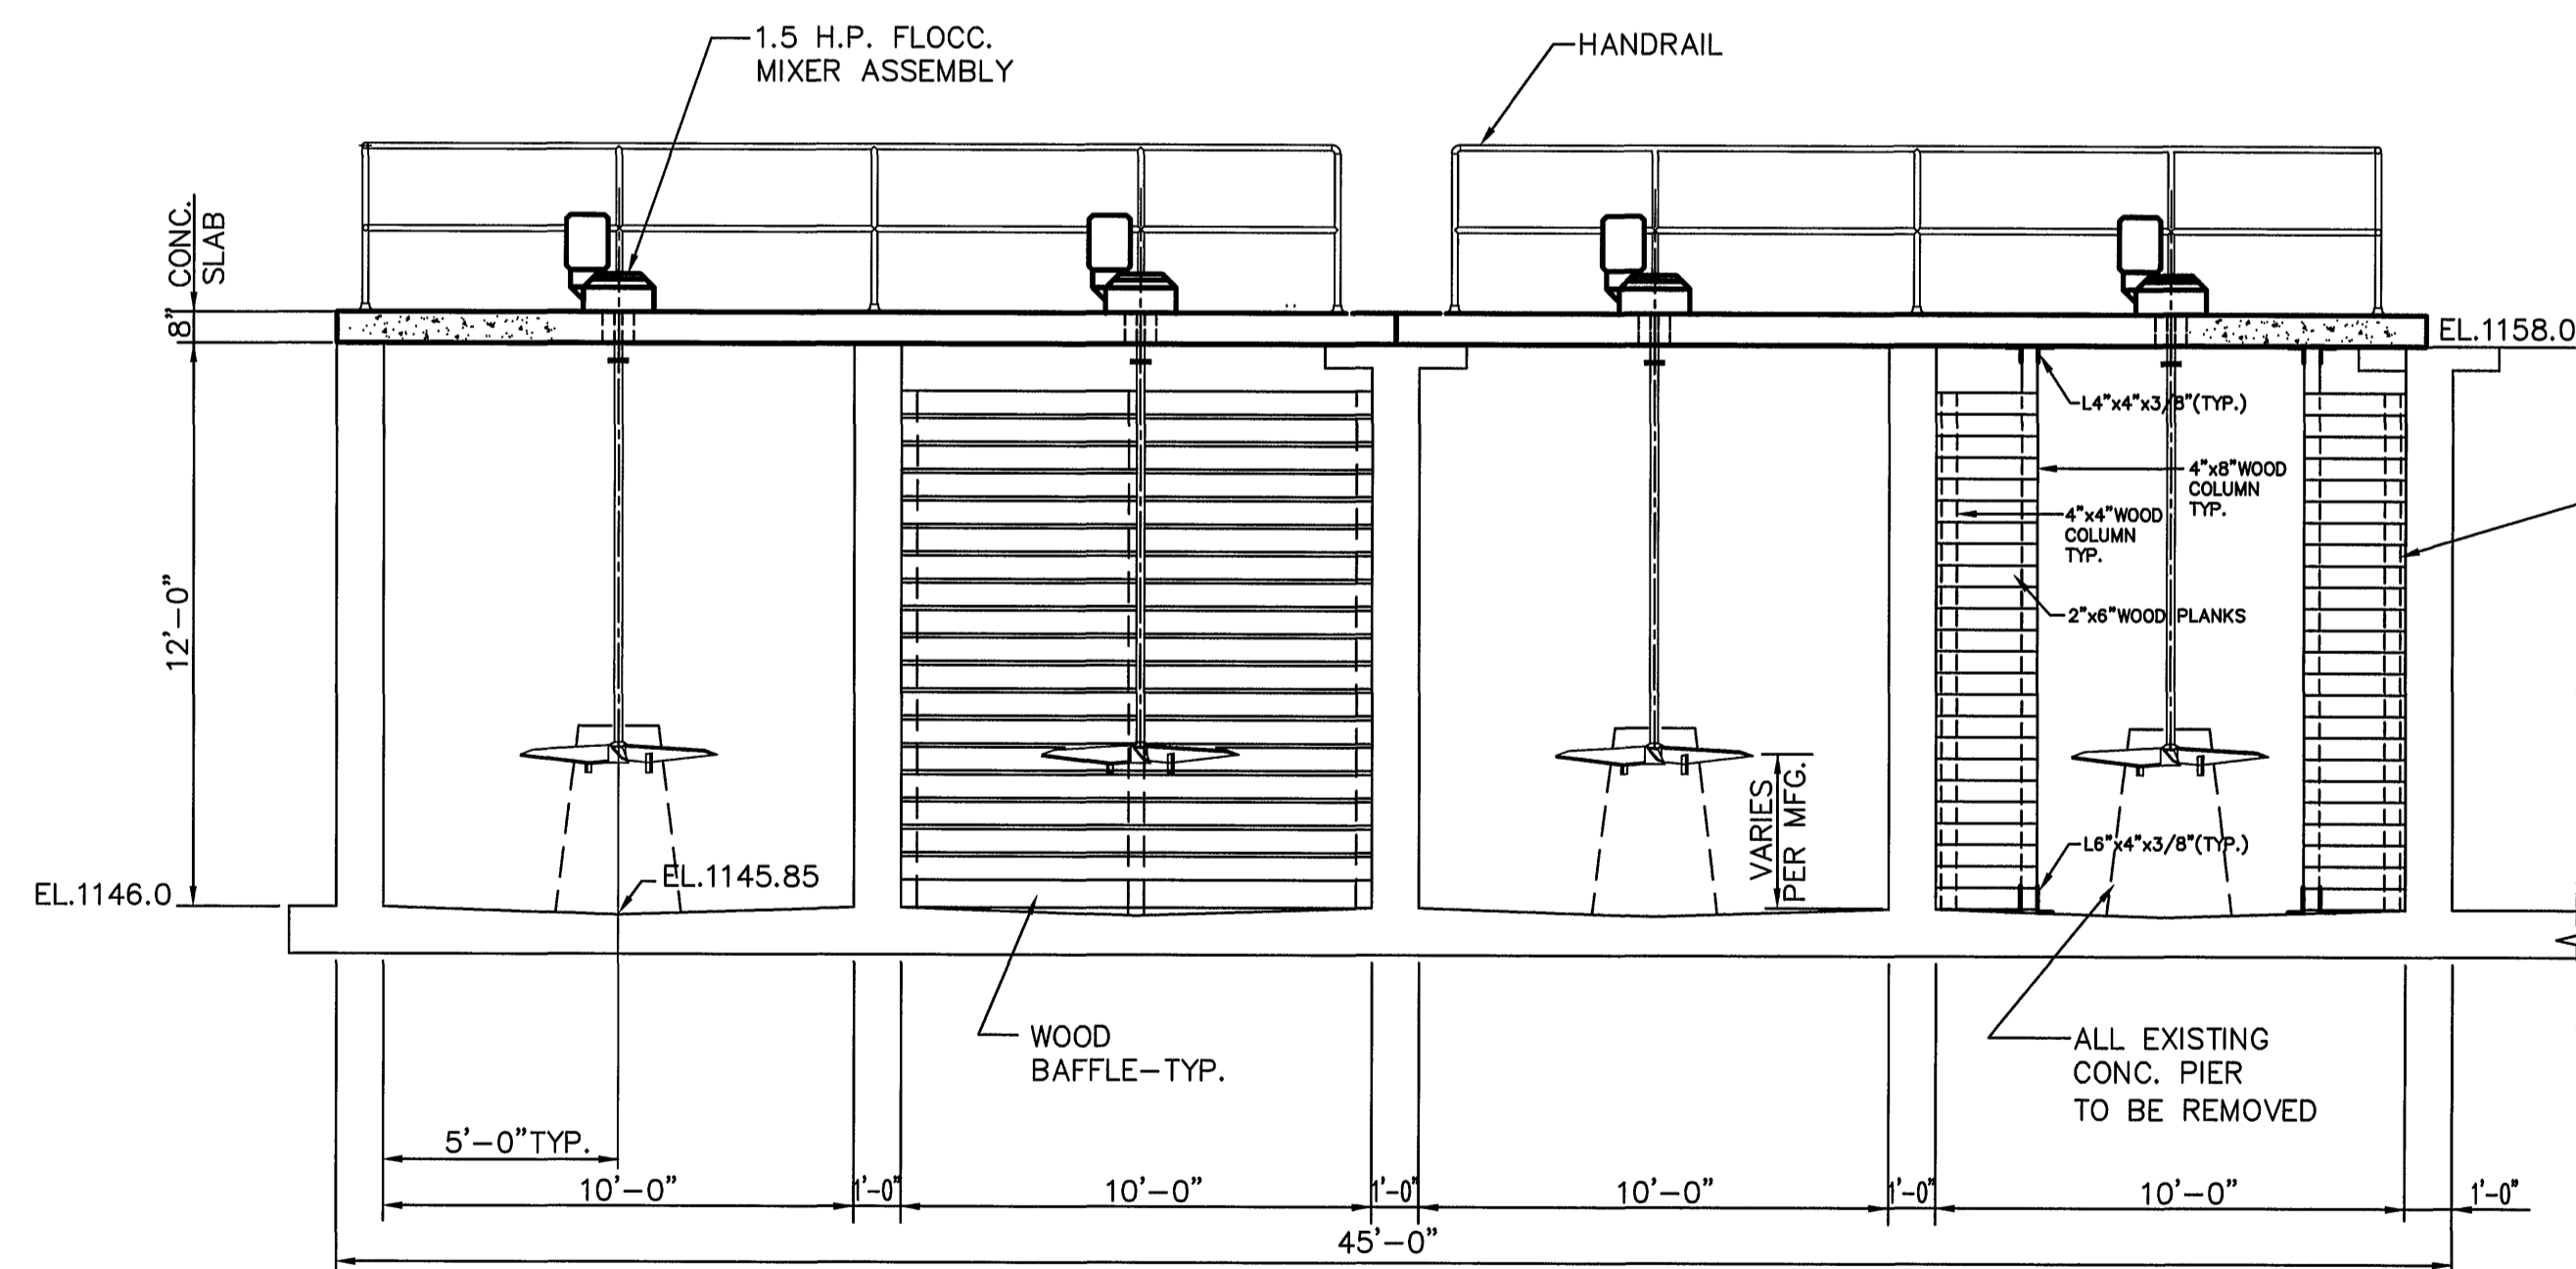

SECTION H


SCALE: 1/4"=1'-0"

SOLID WOOD WING WALL-TYP. SEE DWG. PB6 (EXCEPT BAFFLE DEPTH REQUIRED IS 11')

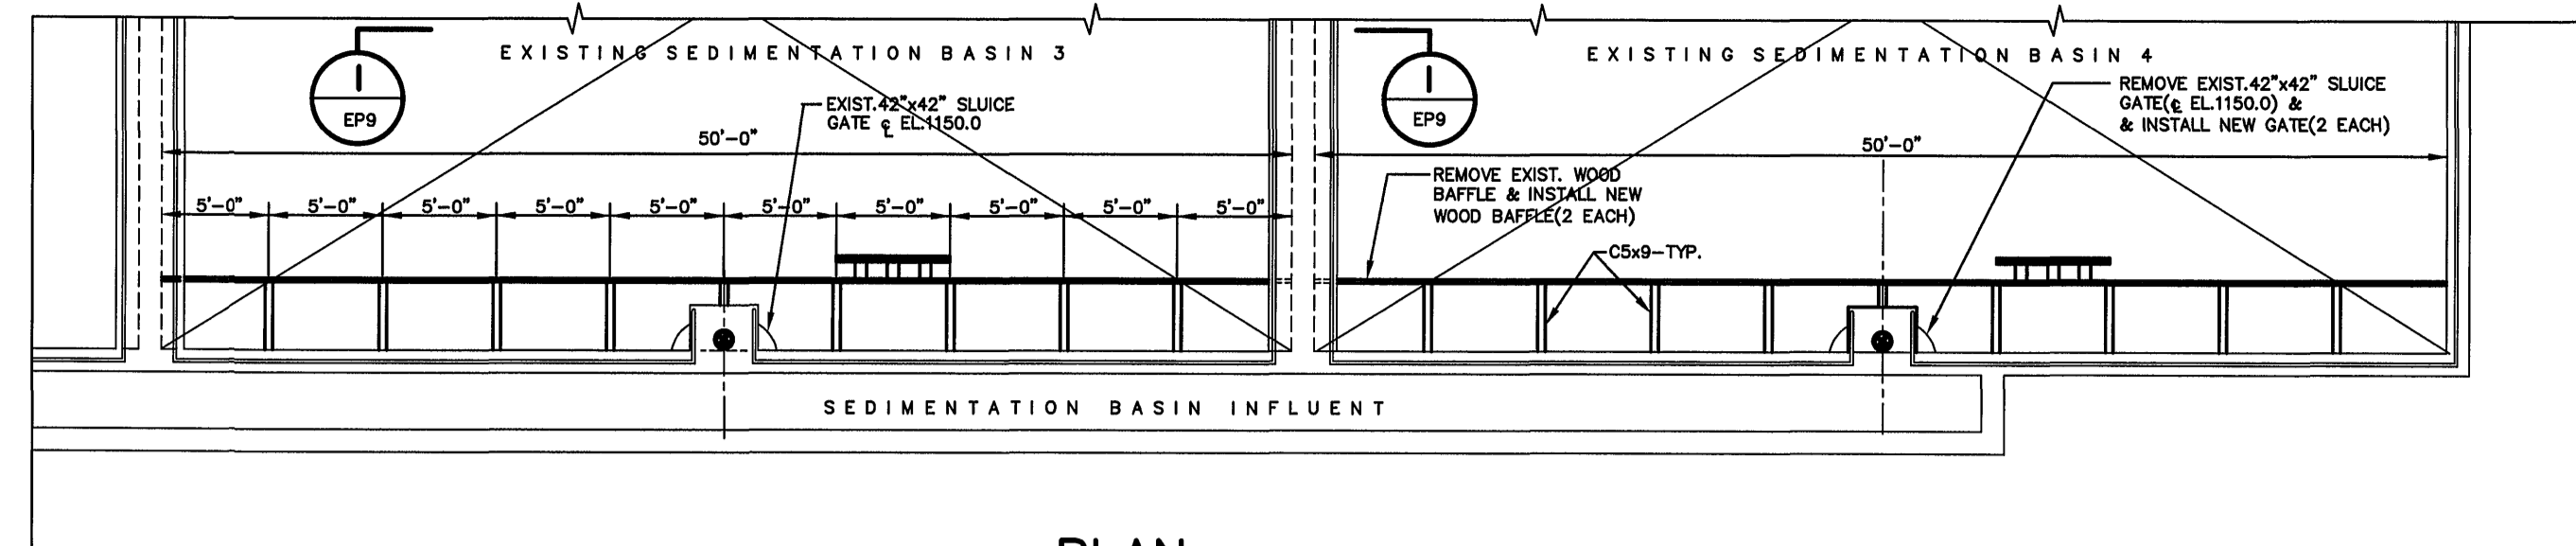


PLAN

SCALE: 1/8"=1'-0"

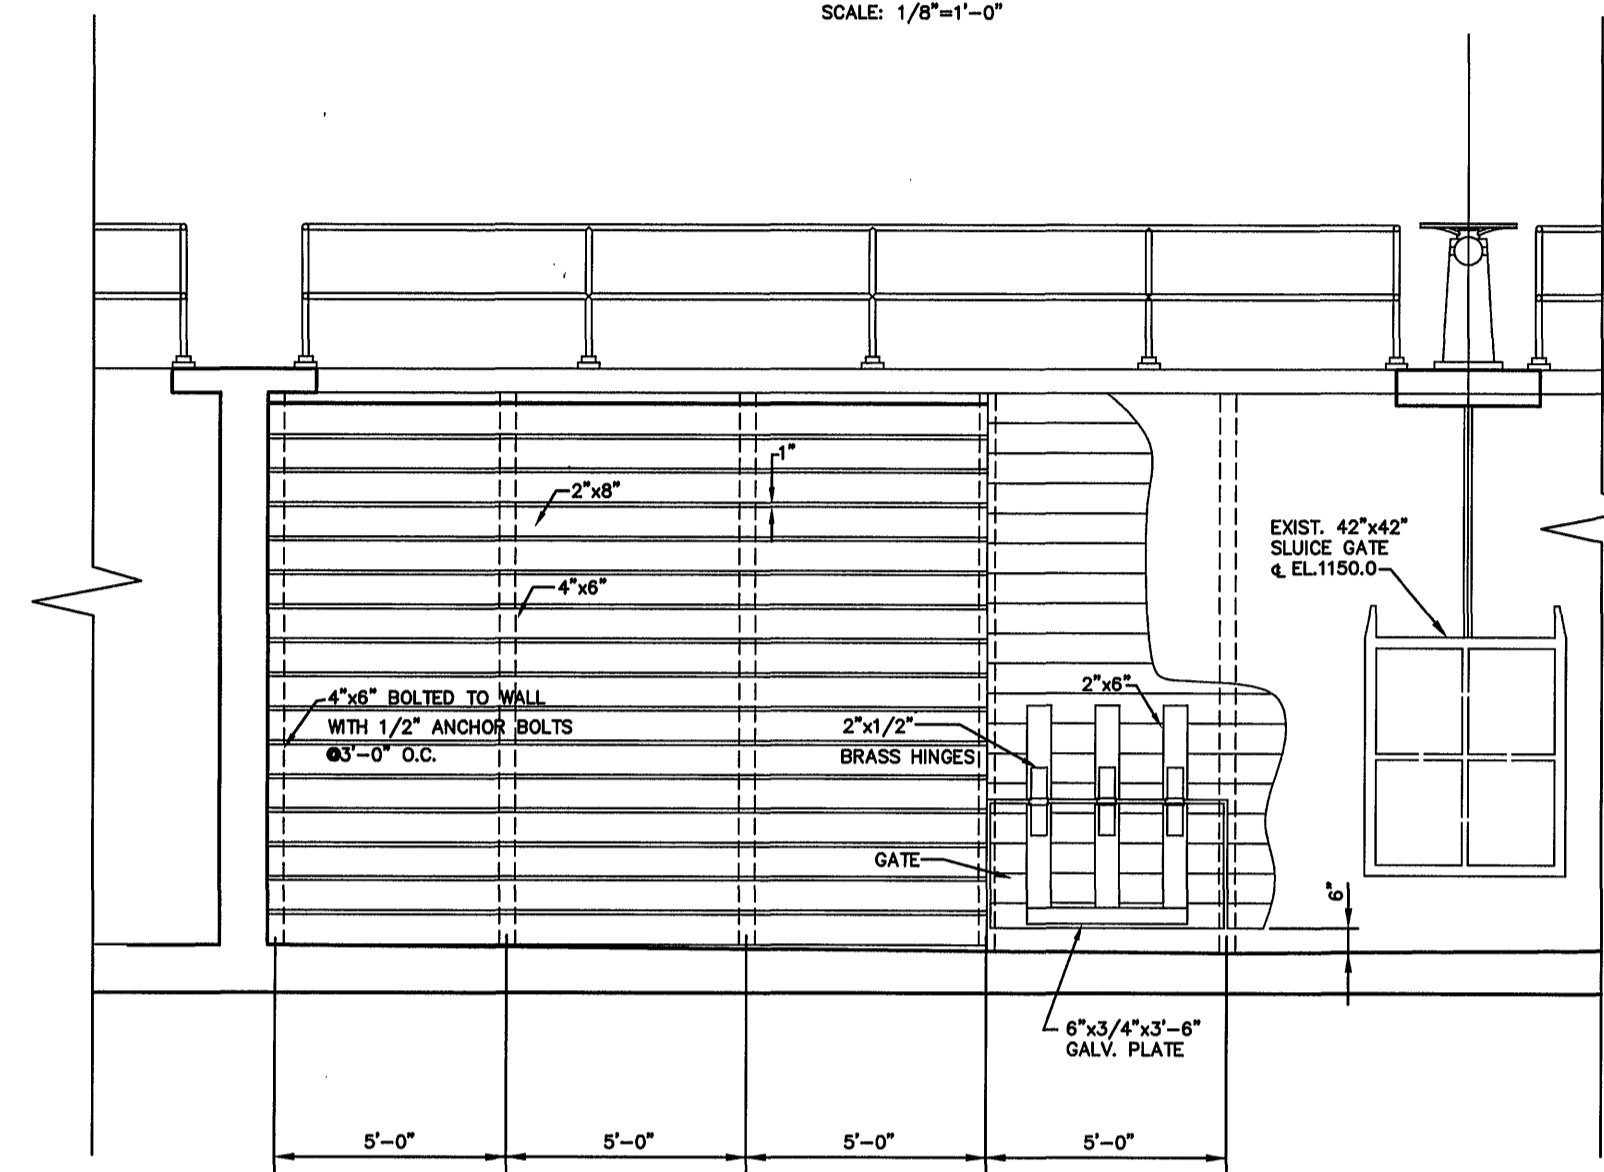

SECTION I

SCALE: 1/4"=1'-0"

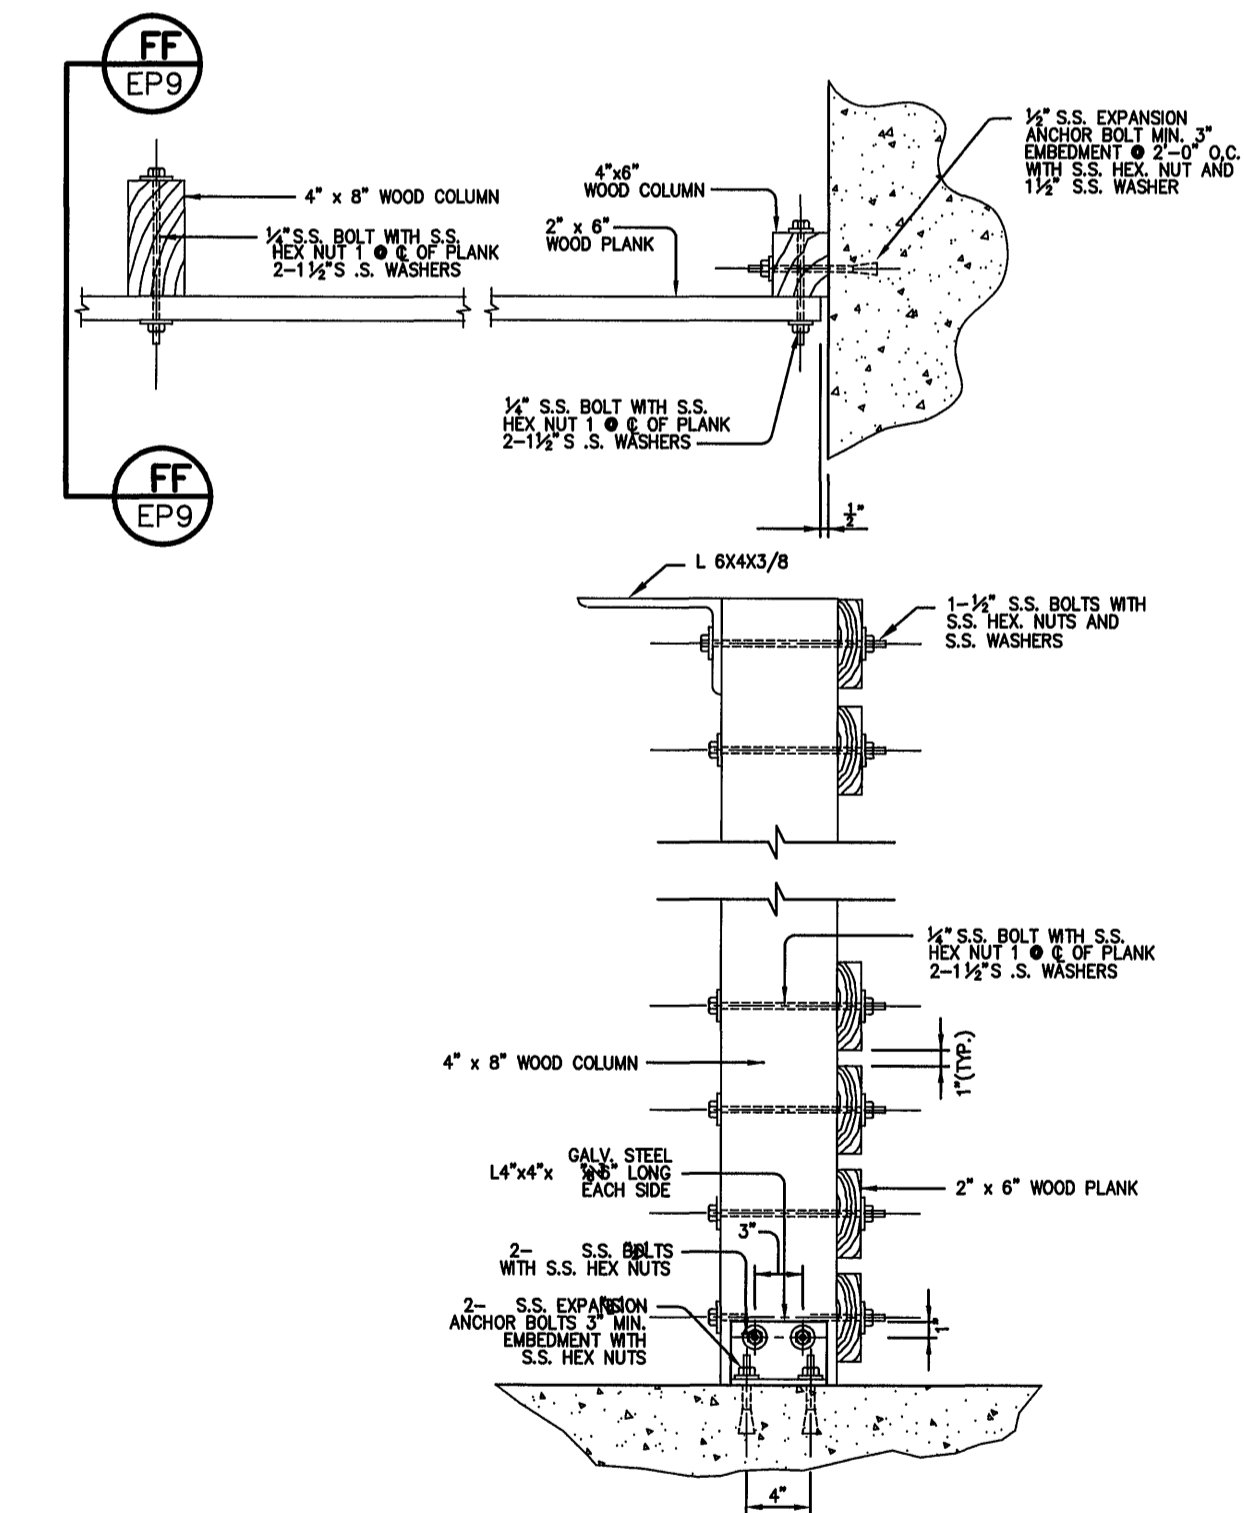

SECTION FF

SCALE: 1 1/2"=1'-0"

BAFFLE DETAILS

DRAWING OF RECORD

DATE: SEP 30 1997

SCALE OF DRAWING 1/4" = 1'-0"

SCALE OF DRAWING 1" = 1'-0"

SCALE OF DRAWING 1 1/2" = 1'-0"

SCALE OF DRAWING 1 1/2" = 1'-0"


SCALE OF DRAWING 1 1/2" = 1'-0"

SCALE OF DRAWING 1 1/2" = 1'-0"

MATTERN & CRAIG
CONSULTING ENGINEERS • SURVEYORS
ROANOKE VIRGINIA

ALVORD, BURDICK & HOWSON
ENGINEERS CHICAGO

DESIGNED: K.C. F.L.
DRAWN: H.F. R.T.
CHECKED: Y.T.L.

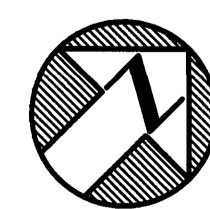

REV.	DATE	DESCRIPTION	BY	APP.

CARVINS COVE FILTER PLANT IMPROVEMENTS - PHASE I
ROANOKE, VIRGINIA

1954 FLOCC. MIXING BASIN AND
SEDIMENTATION BASIN IMPROVEMENTS

DATE
APRIL 1992
COMM. NO.
9130
SHEET
EP9