

WESTERN VIRGINIA WATER AUTHORITY  
ROANOKE, VIRGINIA

CARVINS COVE WATER TREATMENT FACILITY  
DISINFECTION IMPROVEMENTS

AS-BUILTS  
APRIL 2015



**HAZEN AND SAWYER**  
Environmental Engineers & Scientists

RECORD DRAWINGS

THESE "RECORD DRAWINGS" REPRESENT THE FINAL CONDITIONS OF THE CONSTRUCTION PROJECT BASED UPON THE LOCATIONS, DOCUMENTATION, AND INFORMATION FURNISHED TO HAZEN & SAWYER BY OTHERS, FIELD OBSERVATION AND SUPPORTING PROJECTS RECORDS.

ABBREVIATIONS										INDEX OF DRAWINGS									
AB	ANCHOR BOLT	FF	FINISH FLOOR	OC	ON CENTER	UG	UNDERGROUND			GENERAL									
AC	ALTERNATING CURRENT/ ASBESTOS CEMENT	FM	FIRE HYDRANT	OD	OUTSIDE DIAMETER	UH	UNIT HEATER			MECHANICAL									
ACT	ACOUSTIC TILE	FIN	FINISH	OF	OFFICE	UNFIN	UNFINISHED			ELECTRICAL									
AD	AREA DRAIN	FL	FLASHING/FLOOR	OPER	OPERATOR	UR	URINAL			LEGEND									
ADDL	ADDITIONAL	FLEX	FLEXIBLE	OPNG	OPENING	UTL	UTILITY			SECTION AND DETAIL KEYING									
ADJ	ADJUSTABLE	FLC	FLANGE	OPP	OPPOSITE					LINETYPES									
AFF	ABOVE FINISHED FLOOR	FLUOR	FLUORESCENT	ORIG	ORIGINAL	VAC	VACUUM			RECORD DRAWINGS									
AGGR	AGGREGATE	FLXC	FLEXIBLE CONNECTION	OT	OPEN TRUSS	VAT	VINYL ASBESTOS TILE			THE SCALE BAR SHOWN BELOW MEASURES ONE INCH LONG ON THE ORIGINAL DRAWING.									
AL	ALUMINUM	FM	FORCE MAIN	OVHD	OVERHEAD	VCP	VITRIFIED CLAY PIPE			DATE OCTOBER 2014									
ALLOW	ALLOWANCE/ALLOWABLE	FRP	FIREPROOF			VEL	VELOCITY			H&S JOB NUMBER 31197-000									
ALT	ALTERNATE	FRP	FIBERGLASS REINFORCED			VENT	VENTILATING/VENTILATION			CONTRACT NUMBER 1									
APPROX	APPROXIMATE	FT	FEET	PAR	PARALLEL	VERT	VERTICAL			DRAWING NUMBER G1									
ARCH	ARCHITECTURAL	FTG	FOOTING/FITTING	PC	POINT OF CURVE/PIECE	VOL	VOLUME			DESIGNED ABL									
ASB	ASBESTOS	FURR	FURRING/FURRED	PCC	POINT OF COMPOUND CURVE	VP	VENT PIPE			DRAWN KJO									
ASPH	ASPHALT			PE LINING	POLYETHYLENE LINING	VWC	VINYL WALL COVERING			CHECKED ALS									
AT	ASPHALT TILE			PERF	PERFORATED					PROJ.ENGR. ALS									
				PERP	PERPENDICULAR					RECORD DRAWINGS									
B	BORING	G	GAS/GAS LINE	PI	POINT OF INTERSECTION	W	WEST/WIDTH			04/2015									
BD	BOARD	GAL	GALVANIZED	P	PROPERTY LINE/PLATE	WC	WATER CLOSET			09/2014									
BFE	BOTTOM OF FITTING ELEV	GALV	GALVANIZED	P	PROPERTY LINE/PLATE	WF	WIDE FLANGE			ALS									
BFV	BUTTERFLY VALVE	GEN	GENERATOR	PP	POWER POLE	WH	WALL HYDRANT			BY									
BITUM	BITUMINOUS	Q	QUANTITY	PREFAB	PREFABRICATED	WI	WROUGHT IRON			APPROVED									
B	BASLINE	Q	QUANTITY	PRV	PRESSURE RELIEF VALVE	WL	WATER LEVEL												
BL	BUILDING LINE	CL	CLASS	PS	PUMPING STATION	W/L	WATER LINE												
BLDG	BUILDING	QPM	GALLONS PER MINUTE	PSF	POUNDS PER SQUARE FOOT	WO	WINDOW OPENING												
BLK	BLOCK	GR	GRADE	PSI	POUNDS PER SQUARE INCH	W/O	WITHOUT												
BM	BENCH MARK	GV	GATE VALVE	PT	POINT OF TANGENT/POINT	WP	WATERPROOF												
BCC	BACK OF CURB	GW	GUY WIRE	PTN	PARTITION	WPG	WATER PROOFING												
BOT	BOTTOM	GWB	GYP/SM WALL BOARD	PV	PLUG VALVE	WPT	WALL PENETRATING TYPE												
BRG	BEARING	QWF	GLAZED WALL FINISH	PVC	POLYVINYL CHLORIDE	WSE	WATER SURFACE ELEVATION												
BRK	BRICK	GYP	GYP/SM	PVMT	PAVEMENT	WSP	WEATHERSTRIP												
BRZ	BRONZE			PW	POTABLE WATER	WT	WEIGHT												
BSTMT	BASEMENT					WY	WATER VALVE												
BT	BOLT	H	HEIGHT	QTY	QUANTITY	WVF	WEIGHTED WIRE FABRIC												
BUR	BUILT-UP ROOFING	HDW	HARDWARE			YD	YARD												
BV	BALL VALVE	HEX	HEXAGONAL			YR	YEAR												
		HM	HOLLOW METAL																
C	CLOSET/CARPET/CHANNEL	HORZ	HORIZONTAL	R	RADIUS/RISER														
CAB	CABINET	HP	HORSEPOWER	RCP	REINFORCED CONCRETE PIPE														
CB	CATCH BASIN	HPT	HIGH POINT	RD	ROAD/ROOF DRAIN														
C/C	CENTER TO CENTER	HTR	HEATER	RECIR	RECIRCULATION														
CE	CONSTRUCTION EASEMENT	HVAC	HEATING, VENTILATING AND AIR CONDITIONING	RECT	RECTANGULAR														
CEM	CEMENT	IHW	HIGHWAY	RED	REDUCER														
CER	CERAMIC	HWM	HIGHWAY	REF	REFERENCE														
CF	CUBIC FEET	HWY	HIGHWAY	REG	REGISTER														
CFM	CUBIC FEET PER MINUTE	HYD	HYDRAULIC	REIN	REINFORCING														
Q	CAST IRON/CUBIC INCHES			REIN	REINFORCING														
QIP	CAST IRON PIPE			REQD	REQUIRED														
CL	CENTER LINE			REST	RESTRAINED														
CL2	CHLORINE	I	IRON	REV	REVISE														
CLG	CEILING	ID	INSIDE DIAMETER	RF	ROOF														
CLKG	CAULKING	IF	INSIDE FACE	RFG	ROOFING														
CLR	CLEAR	IN	INCH	RJ	RESTRAINED JOINT														
CMP	CORRUGATED METAL PIPE	INCL	INCLUDED	RM	ROOM														
CMU	CONCRETE MASONRY UNIT	INF	INFLUENT	RND	ROUND														
CO	CLEANOUT	INS	INSULATION	RO	ROUGH OPENING														
COL	COLUMN	INT	INTERIOR	RPM	REVOLUTIONS PER MINUTE														
CONC	CONCRETE	INV	INVERT	RR	RAILROAD														
CONST	CONSTRUCTION			RT	RIGHT														
CONT	CONTINUOUS	J	JOIST	RTU	REMOTE TERMINAL UNIT														
CONTR	CONTRACTOR	JB	JUNCTION BOX	RW	RAW WATER														
CORP	CORPORATION	JCT	JUNCTION	R/W	RIGHT OF WAY														
CORR	CORRIDOR	JT	JOINT																
CP	CONCRETE PLANK			S	SOUTH/SLOPE														
CP	COURSE			SAN	SANITARY														
CRS	CERAMIC TILE	L	LENGTH/ANGLE	SBL	SURVEY BASELINE														
CT	CONTROL JOINT	LAB	LABORATORY	SCH	SCHEDULE														
CU	COPPER	LAM	LAMINATED	SD	STORM/SITE DRAIN														
CV	CHECK VALVE	LAT	LATERAL	SECT	SECTION														
CW	COLD WATER	LAV	LAVATORY	SERV	SERVICE														
CY	CUBIC YARD	LB	POUND/LINE BACK	SF	SQUARE FEET														
		LF	LINEAR FEET	SHT	SHEET														
DC	DIRECT CURRENT	LG	LONG	SHI	SQUARE INCH														
DET	DETAIL	LL	LIVE LOAD	SI	SIMILAR														
DF	DRINKING FOUNTAIN	LLH	LONG LEG HORIZONTAL	SM	STEEL JOIST														
DIA (Y)	DIAMETER	LV	LONG LEG VERTICAL	SJ	SPECIFICATION														
DIAG	DIAGONAL	LPT	LOW POINT	SPEC	SPECIFICATION														
DIM	DIMENSION	LQ	LONG	SQ	SQUARE														
DIP	DUCTILE IRON PIPE	LRT	LOW POINT	SS	SANITARY SEWER														
DISCH	DISCHARGE	LT	LIGHT	SST	STAINLESS STEEL														
DIST	DISTRIBUTION	LTG	LIGHTING	ST	STREET														
DJ	DOUBLE JOIST	LVR	LOUVER	STA	STATION														
DL	DEAD LOAD	LWL	LOW WATER LEVEL	STD	STANDARD														
DN	DOWN			STG	STORAGE														
DOZ	DOZEN			STR	STIRRUP														
DR	DOOR	MAINT	MAINTENANCE	STL	STEEL														
DWG	DRAWING	MATL	MATERIAL	STR	STRUCTURAL														
DWL	DOWEL	MECH	MECHANICAL	SUB	SUBSTITUTE														
		MEMB	MEMBRANE	SUP	SUPPLY														
E	EAST/EASEMENT	MFR	MANUFACTURER	SUPT	SUPERINTENDENT														
EACH	EACH	MG	MILLION GALLONS	SUR	SURFACE														
ECC	ECCENTRIC	MG	MILLION GALLONS	SUSP	SUSPENDED														
EF	EACH FACE	MGD	MILLION GALLONS PER DAY	SW	SWITCH														
EFF	EFLUENT	MH	MANHOLE	SWB	SWITCHBOARD														
EIP	EXIST IRON PIPE	MIN	MINIMUM	SWD	SIDE WATER DEPTH														
EL OR ELEV	ELEVATION	MISC	MISCELLANEOUS	SYM	SYMMETRICAL														
ELEC	ELECTRIC/ELECTRICAL	MJ	MECHANICAL JOINT	T	TREAD														
ELL	ELBOW	MDO	MOLDING	T&B	TOP AND BOTTOM														
ENGR	ENGINEER	MOD	MODIFY/MODIFIED	T&G	TONGUE AND GROOVE														
ENT	ENTRANCE	MON	MONUMENT	TAN	TANGENT														
EOG	EDGE OF GRAVEL	MT	MOUNTED	TBM	TEMPORARY BENCH MARK														
EOP	EDGE OF PAVEMENT	MTG	MOUNTING	TC	TOP OF CURB														
EQ	EQUAL	MULT	MULTIPLE	TDH	TOTAL DYNAMIC HEAD														
EQPT	EQUIPMENT			TECH	TELEPHONE														
EW	EACH WAY	TEL	TEMPERATURE	TER	TERRAZZO														
EX	EXISTING	TEMP	TEMPERATURE	THK	THICK														
EXC	EXCAVATE	THRU	THROUGH	TOL	TOLERANCE														
EXH	EXHAUST	TOW	TOP OF DECK	TOW	TOP OF FOOTING														
EXP	EXPANSION	TOM	TOP OF MASONRY/MANHOLE	TOW	TOP OF SLAB														
EXT	EXTERIOR	TOW	TOP OF WALL	TOW	TOP OF WALL														
		TOW	TOP OF WALL	TOW	TOP OF WALL														
FAB	FABRICATE	TOW	TOP OF WALL	TOW	TOP OF WALL														
F&C	FRAME AND COVER	TOW	TOP OF WALL	TOW	TOP OF WALL														
F&G	FRAME AND GRATE	TOW	TOP OF WALL	TOW	TOP OF WALL														
FC	FLASHING CONNECTION	TOW	TOP OF WALL	TOW	TOP OF WALL														
FD	FLOOR DRAIN	TOW	TOP OF WALL	TOW	TOP OF WALL														
FDN	FOUNDATION	TOW	TOP OF WALL	TOW	TOP OF WALL														
FE	FIRE EXTINGUISHER	TOW	TOP OF WALL	TOW	TOP OF WALL														

PIPE DESIGNATIONS										LEGEND																															
MATERIALS					SYMBOLS					SECTION AND DETAIL KEYING					LINETYPES																										
AM	AMMONIA	BWD	BACKWASH DRAIN	BWS	BACKWASH SUPPLY	BWW	BACKWASH WASTE	CLG	CHLORINE GAS	CLS	CHLORINE SOLUTION	D	DRAIN	F	FLUORIDE	FLW	FILTERED WATER	FW	FINISHED WATER	NPW	NONPOTABLE WATER	PW	POTABLE WATER	RC	RECYCLE	RW	RAW WATER	SLW	SETTLED WATER	SN	SUPERNATANT	SO	SOLIDS	SPD	SUMP PUMP DISCHARGE	SS	SANITARY SEWER	SW	SOFTENED WATER	TW	TEMPERED WATER
GRADE OR EARTH					ROCK					WALL PENETRATION					DRAWINGS ARE CROSS REFERENCED IN THE FOLLOWING METHOD: (A) A SECTION CUT ON DRAWING A3 IS IDENTIFIED AS FOLLOWS:					PROPOSED ITEMS																					
ASPHALT PAVING					STEEL					MECHANICAL COUPLING					EXISTING ITEMS																										
SAND					INSULATION					WELDED JOINT					HIDDEN ITEMS																										
GRAVEL					WATER SURFACE					FLANGED JOINT					DEMOLITION ITEMS																										
CONCRETE					CHECKERED PLATE					MECHANICAL, PUSH ON OR RESTRAINED JOINT					CENTER LINE																										
CONC. FILL OR GROUT					GLASS					SLUICE GATE					MATCH LINE																										
CONC. MASONRY UNIT					WOOD BLOCKING					SLIDE GATE/STOP GATE																															
BRICK										FLUSHING CONNECTION																															
										HOSE BIBB																															
										QUICK DISCONNECT FITTING																															
										YARD HYDRANT																															
										FIRE HYDRANT																															
										SOIL BORING																															

WESTERN VIRGINIA WATER AUTHORITY ROANOKE, VIRGINIA										CARVINS COVE WATER TREATMENT FACILITY DISINFECTION IMPROVEMENTS									
RECORD DRAWING										INDEX, ABBREVIATIONS AND LEGEND									
THIS DRAWING HAS BEEN MODIFIED TO REFLECT FIELD CHANGES REPORTED BY THE CONTRACTOR OR ANOTHER PARTY, BUT NOT VERIFIED BY THE CERTIFYING ENGINEER										THE SCALE BAR SHOWN BELOW MEASURES ONE INCH LONG ON THE ORIGINAL DRAWING.									
DESIGNED ABL										DATE OCTOBER 2014									
DRAWN KJO										H&S JOB NUMBER 31197-000									
CHECKED ALS										CONTRACT NUMBER 1									
PROJ.ENGR. ALS										DRAWING NUMBER G1									

2

RECORD DRAWINGS

04/2015

ALS

1

FINAL DESIGN

09/2014

ALS

NO.

ISSUED FOR

DATE

BY

APPROVED

HAZEN AND SAWYER

Environmental Engineers & Scientists

4011 WestChase Boulevard, Suite 500

Raleigh, North Carolina 27607

License No. : C-0381

RECORD DRAWING

THIS DRAWING HAS BEEN MODIFIED TO REFLECT FIELD CHANGES REPORTED BY THE CONTRACTOR OR ANOTHER PARTY, BUT NOT VERIFIED BY THE CERTIFYING ENGINEER

THIS DOCUMENT ORIGINALLY ISSUED FOR CONSTRUCTION AND SEALED BY ALAN L. STONE, LIC NUMBER 24446

WESTERN VIRGINIA WATER AUTHORITY

ROANOKE, VIRGINIA

CARVINS COVE WATER TREATMENT FACILITY

DISINFECTION IMPROVEMENTS

INDEX, ABBREVIATIONS AND LEGEND

THE SCALE BAR SHOWN BELOW MEASURES ONE INCH LONG ON THE ORIGINAL DRAWING.

DATE OCTOBER 2014

H&S JOB NUMBER 31197-000

CONTRACT NUMBER 1

DRAWING NUMBER G1



G-1 THE DESIGN IS IN ACCORDANCE WITH AND ALL CONSTRUCTION SHALL COMPLY WITH THE PROVISIONS OF THE 2012 VIRGINIA UNIFORM STATEWIDE BUILDING CODE.

G-2 ALL DIMENSIONS INDICATED (\*) SHALL BE VERIFIED EITHER BY FIELD MEASUREMENTS FOR EXISTING STRUCTURES OR BY SHOP DRAWINGS, FOR EQUIPMENT FURNISHED. STRUCTURAL DIMENSIONS NOT SHOWN BUT CONTROLLED BY OR RELATED TO EQUIPMENT SHALL BE VERIFIED BY THE CONTRACTOR WITH THE MANUFACTURER PRIOR TO CONSTRUCTION.

G-3 THE CONTRACTOR IS RESPONSIBLE FOR VERIFYING ALL EXISTING INFORMATION IN THE FIELD AS REQUIRED FOR NEW WORK.

G-4 IF A CONFLICT IS FOUND BETWEEN DIFFERENT PORTIONS OF THE CONTRACT DOCUMENTS, THE CONTRACTOR SHALL NOTIFY THE ENGINEER IMMEDIATELY. CONTINUED CONSTRUCTION OF THE AREA IN CONFLICT SHALL BE AT THE CONTRACTOR'S OWN RISK UNTIL THE CONFLICT IS RESOLVED.

G-5 EQUIPMENT ANCHOR BOLT SIZES, TYPES, EMBEDMENT AND PATTERNS SHALL BE VERIFIED WITH THE MANUFACTURER. ALL BOLT PATTERNS SHALL BE TEMPLATED TO INSURE ACCURACY OF PLACEMENT.

G-6 THESE NOTES SHALL BE USED IN COORDINATION WITH THE DRAWINGS OF ALL OTHER DISCIPLINES AND MANUFACTURER'S SHOP DRAWINGS.

G-7 STRUCTURES HAVE BEEN DESIGNED FOR OPERATIONAL LOADS ON THE COMPLETED STRUCTURE. DURING CONSTRUCTION, THE STRUCTURES SHALL BE PROTECTED BY BRACING AND TEMPORARY SUPPORTS WHEREVER EXCESSIVE CONSTRUCTION LOADS MAY OCCUR. OVERSTRESSING OF ANY STRUCTURAL ELEMENT IS PROHIBITED.

G-8 NO GEOTECHNICAL INVESTIGATION WAS PERFORMED FOR THIS CONTRACT. AS SUCH, FOR THE DESIGN OF EQUIPMENT ANCHORAGE THE CONTRACTOR SHALL ASSUME A SITE CLASS D AND AN OCCUPANCY CATEGORY III.

M-1	DETAIL, FABRICATE, AND ERECT STRUCTURAL STEEL IN ACCORDANCE WITH AISC SPECIFICATION FOR STRUCTURAL STEEL BUILDINGS, ALLOWABLE STRESS DESIGN AND PLASTIC DESIGN, LATEST EDITION.	
M-2	STEEL MATERIAL:	
	A) STRUCTURAL TUBING:	ASTM A500, GRADE B OR A501 (42 KSI)
	B) STRUCTURAL PIPE:	ASTM A53, TYPE E OR S, GRADE B (35 KSI)
	C) PLATES AND ANGLES:	ASTM A36 UNO (36 KSI)
	D) STRUCTURAL W SHAPES:	ASTM A992 (50 KSI)
	E) STRUCTURAL S, M, C & H SHAPES:	ASTM A572 GRADE 50 (50 KSI)

M-4 DO NOT PAINT STEEL SURFACES WHICH ARE TO BE WELDED OR ARE TO BE ENCASED IN CONCRETE.

A-1 ALL ARCHITECTURAL, MECHANICAL, AND ELECTRICAL COMPONENTS SHALL BE DESIGNED AND INSTALLED TO RESIST THE CONTROLLING CONDITION OF OPERATIONAL FORCES OR SEISMIC FORCES IN ACCORDANCE WITH THE GOVERNING BUILDING CODE. SEISMIC FORCES SHALL ALSO BE AS PER ASCE 7. COMPONENT SEISMIC ATTACHMENTS SHALL BE BOLTED, WELDED, OR OTHERWISE POSITIVELY FASTENED WITHOUT CONSIDERATION OF FRICTIONAL RESISTANCE PRODUCED BY THE EFFECTS OF GRAVITY. A CONTINUOUS LOAD PATH OF SUFFICIENT STRENGTH AND STIFFNESS BETWEEN THE COMPONENT AND THE SUPPORTING STRUCTURE SHALL BE PROVIDED. CONNECTIONS FOR BOTH ORTHOGONAL DIRECTIONS (TRANSVERSE AND LONGITUDINAL) SHALL BE DESIGNED BY A PROFESSIONAL ENGINEER CURRENTLY REGISTERED IN THE COMMONWEALTH OF VIRGINIA.

A-3 CONTRACTOR SHALL PROVIDE SPECIAL SEISMIC CERTIFICATION (SSC) FROM MANUFACTURER OF EQUIPMENT FOR ALL SYSTEMS DEEMED NECESSARY BY SPECIFICATIONS. SPECIAL SEISMIC CERTIFICATION SHALL BE IN COMPLIANCE WITH ASCE 7.

## FRP-1 SEE SPECIFICATION 06610 FOR REQUIREMENTS

PC-1 PRECAST VAULTS AND MANHOLES SHALL BE DESIGNED BY A PROFESSIONAL ENGINEER CURRENTLY REGISTERED IN THE COMMONWEALTH OF VIRGINIA. STRUCTURAL DRAWINGS SHALL INDICATE DESIGN IS IN COMPLIANCE WITH THE VIRGINIA UNIFORM STATEWIDE BUILDING CODE.

C-1 CONCRETE MIX DESIGN:

A. COMPRESSIVE STRENGTH (28 DAY) 4500 PSI (MINIMUM)

B. MAXIMUM WATER/CEMENTITIOUS MATERIAL RATIO (BY WEIGHT) 0.42

C. SLUMP RANGE 4" NOMINAL

D. AIR CONTENT  $6\% \pm 1.5\%$

E. PORTLAND CEMENT: TYPE I OR TYPE II CONFORMING TO ASTM C 150 WITH TOTAL ALKALIS IN THE CEMENT NOT EXCEEDING 0.80%, TRICALCIUM ALUMINATE NOT MORE THAN 8% AND TETRACALCIUM ALUMINO-FERRITE NOT MORE THAN 12%

F. FLY ASH: FLY ASH SHALL MEET THE REQUIREMENTS OF ASTM C 618 FOR CLASS F AND SHALL CONSTITUTE BETWEEN 15% AND 25% OF THE TOTAL WEIGHT OF THE COMBINED PORTLAND CEMENT AND FLY ASH.

G. SLAG CEMENT: SLAG CEMENT SHALL MEET THE REQUIREMENTS OF ASTM C 989, INCLUDING APPENDIX X3, AND SHALL CONSTITUTE BETWEEN 35% AND 45% OF THE TOTAL WEIGHT OF THE COMBINED PORTLAND CEMENT AND SLAG

H. WATER: WATER USED FOR MIXING CONCRETE SHALL BE CLEAR, POTABLE AND FREE FROM DELETERIOUS SUBSTANCES.

I. COARSE AND FINE AGGREGATES: AGGREGATES SHALL MEET THE GRADATION REQUIREMENTS OF ASTM C 33. COARSE AGGREGATES SHALL BE EITHER SIZE #57 OR SIZE #67 STONE. FINE AGGREGATES SHALL CONSIST OF EITHER NATURAL OR MANUFACTURED SILICEOUS SANDS. AGGREGATES SHALL BE TESTED FOR GRADATION IN CONFORMANCE WITH ASTM C 136.

J. AIR ENTRAINING ADMIXTURE: AIR ENTRAINING ADMIXTURES SHALL BE ADDED TO ALL CONCRETE AND SHALL CONSIST OF A NEUTRALIZED VINYL RESIN SOLUTION OF PURIFIED HYDROCARBON WITH CEMENT CATALYST AND SHALL MEET THE REQUIREMENTS OF ASTM 260.

K. WATER REDUCING ADMIXTURE: WATER REDUCING ADMIXTURE SHALL CONFORM TO ASTM C 494, TYPE A AND SHALL CONTAIN NO MORE THAN 0.05% CHLORIDE IONS. ACCEPTABLE PRODUCTS ARE "EUCON SERIES" BY THE EUCLID CHEMICAL COMPANY, "POZZOLITH SERIES" BY BASF, AND "PLASTOCRETIC SERIES" BY SIKKA CORPORATION.

L. ADMIXTURES CONTAINING CALCIUM CHLORIDE, THIOCYANATE OR MORE THAN 0.05 PERCENT CHLORIDE IONS ARE NOT PERMITTED.

M. THE USE OF FLY ASH OR SLAG CEMENT WITHIN THE MIX IS MANDATORY.

N. SUBMITTALS: SUBMIT TO THE ENGINEER CONCRETE MIX DESIGN INCLUDING SOURCES OF ALL MATERIALS, CHEMICAL ANALYSIS OF PORTLAND CEMENT (LESS THAN 1 YEAR OLD), CHEMICAL ANALYSIS OF FLY ASH OR SLAG (LESS THAN 1 YEAR OLD), MANUFACTURERS DATA ON ALL ADMIXTURES AND FIELD EXPERIENCE RECORDS OR TRIAL MIX DATA FOR PROPOSED CONCRETE MIX.

O. CONCRETE SHALL BE SUPPLIED BY A READY MIXED PLANT AND SHALL BE DELIVERED TO THE JOB SITE IN A TRUCK EQUIPPED WITH A MIXING DRUM. ALL CONCRETE DELIVERIES SHALL BE ACCOMPANIED BY A DELIVERY TICKET. ANY CONCRETE DELIVERY THAT DOES NOT INCLUDE A DELIVERY TICKET WILL BE REJECTED.

P. PLACEMENT AND CURING OF CONCRETE SHALL MEET THE REQUIREMENTS OF ACI 305 - SPECIFICATION FOR HOT WEATHER CONCRETING AND ACI 308 STANDARD SPECIFICATION FOR COLD WEATHER CONCRETING WHEN ENVIRONMENTAL CONDITIONS DICTATE SUCH. IN ADDITION, FOR CONCRETE PLACED OUTSIDE OF STRUCTURES, THE SUBGRADE SHALL BE FREE OF FROST AND MOIST PRIOR TO THE PLACING OF CONCRETE.

Q. ALL EXPOSED CONCRETE EDGES SHALL HAVE MINIMUM 3/4" CHAMFER.

C-2 CONCRETE ACCESSORIES:

A. FORMS: FORMS SHALL BE CONSTRUCTED OF WOOD, METAL OR FIBERGLASS AND SHALL BE UTILIZED FOR ALL CONCRETE WORK EXCEPT CONCRETE PLACED DIRECTLY AGAINST GRADE AND THE USE OF SIDE FORMS IS MANDATORY FOR CONSTRUCTION OF EXTERIOR CONCRETE PADS. FORMS SHALL BE COATED WITH A NON-STAINING FORM RELEASE AGENT. SUBMIT MANUFACTURERS DATA FOR FORM RELEASE AGENT TO BE USED.

B. REINFORCING BARS: ALL BAR REINFORCING SHALL CONFORM TO ASTM A615, GRADE 60 FOR DEFORMED BARS. WELDED WIRE FABRIC SHALL CONFORM TO ASTM A185. CONTRACTOR SHALL SUBMIT REINFORCING PLACEMENT DRAWINGS FOR ENGINEERS REVIEW

C. REINFORCING BAR ACCESSORIES: ACCESSORIES SHALL INCLUDE ALL NECESSARY CHAIRS, SLAB BOLSTERS, CONCRETE BLOCKS, THE WIRES, DIPS, SUPPORTS, SPACERS AND OTHER DEVICES TO POSITION REINFORCING DURING CONCRETE PLACEMENT. SLAB BOLSTERS SHALL HAVE GRAY PLASTIC-COATED LEGS. CONCRETE BLOCKS (DOBIES), USED TO SUPPORT AND POSITION BOTTOM REINFORCING STEEL, SHALL HAVE THE SAME OR HIGHER COMPRESSIVE STRENGTH AS SPECIFIED FOR THE CONCRETE IN WHICH IT IS LOCATED. REINFORCING BARS AND ACCESSORIES SHALL NOT BE IN CONTACT WITH ANY METAL PIPE, PIPE FLANGE, METAL CONDUIT, OR OTHER METAL PARTS EMBEDDED IN CONCRETE. A MINIMUM CLEARANCE OF 2" SHALL BE PROVIDED.

D. DOWEL ADHESIVE SYSTEM: WHERE SHOWN ON THE DRAWINGS, REINFORCING BARS ANCHORED INTO HARDENED CONCRETE WITH A DOWEL ADHESIVE SYSTEM SHALL USE A TWO-COMPONENT ADHESIVE MIX WHICH SHALL BE INJECTED WITH A STATIC MIXING NOZZLE FOLLOWING MANUFACTURER'S INSTRUCTIONS. ALL HOLES SHALL BE DRILLED WITH A CARBIDE BIT UNLESS OTHERWISE RECOMMENDED BY THE MANUFACTURER AND SHALL BE NO LARGER THAN 1/8" THE BAR DIAMETER. IF CORING HOLES IS ALLOWED BY THE MANUFACTURER AND APPROVED BY THE ENGINEER, CORED HOLES SHALL BE ROUGHENED IN ACCORDANCE WITH MANUFACTURER REQUIREMENTS. THOROUGHLY CLEAN DRILL HOLES OF ALL DEBRIS AND DRILL DUST WITH COMPRESSED AIR FOLLOWED BY A WIRE BRUSH PRIOR TO INSTALLATION OF ADHESIVE AND REINFORCING BAR. DEGREE OF HOLE DAMPENESS SHALL BE IN STRICT ACCORDANCE WITH MANUFACTURER RECOMMENDATIONS. WHERE DEPTH OF HOLE EXCEEDS THE LENGTH OF THE STATIC MIXING NOZZLE, A PLASTIC EXTENSION HOSE SHALL BE USED TO ENSURE PROPER ADHESIVE INJECTION FROM THE BACK OF THE HOLE. INJECTION OF ADHESIVE INTO THE HOLE SHALL UTILIZE A PISTON PLUG TO MINIMIZE THE FORMATION OF AIR POCKETS. THE EMBEDMENT DEPTH OF THE BAR SHALL BE PER MANUFACTURER'S RECOMMENDATIONS, SO AS TO PROVIDE A MINIMUM ALLOWABLE BOND STRENGTH THAT IS EQUAL TO 125 PERCENT OF THE YIELD STRENGTH OF THE BAR, UNLESS NOTED OTHERWISE ON THE DRAWINGS. THE ADHESIVE SYSTEM SHALL BE "EPICON SYSTEM G5" AS MANUFACTURED BY ITW REDHEAD, "HIT HY 200 INJECTION ADHESIVE ANCHOR SYSTEM" AS MANUFACTURED BY HILTI, INC. "SET-XP" AS MANUFACTURED BY SIMPSON STRONG-TIE CO. OR "PE-1000 SD" BY POWERS FASTENERS. ENGINEER'S APPROVAL IS REQUIRED FOR USE OF THIS SYSTEM IN LOCATIONS OTHER THAN THOSE SHOWN ON THE DRAWINGS. FAST-SET EPOXY FORMULATIONS SHALL NOT BE ACCEPTABLE. NO OR EQUAL PRODUCTS WILL BE CONSIDERED, UNLESS PRE-QUALIFIED AND APPROVED BY ENGINEER AND OWNER. SUBMIT MANUFACTURERS DATA FOR SYSTEM TO BE USED.

E. EXPANSION JOINT MATERIAL: EXPANSION JOINT MATERIAL SHALL BE SPONGE RUBBER CONFORMING TO ASTM D1752, TYPE I. ALL EXPANSION JOINTS EXPOSED IN THE FINISH WORK SHALL BE SEALED WITH A JOINT SEALER WITH A BOND BREAKER INSTALLED BETWEEN THE EXPANSION JOINT MATERIAL AND THE SEALER. THE SEALER SHALL BE A MULTI-COMPONENT, NON-SAG, LOW-MODULUS POLYURETHANE RUBBER SEALANT MEETING ASTM C-920 TYPE M, GRADE NS, CLASS 25, USE NT, M, A, AND Q. CAPABLE OF WITHSTANDING 50% IN EXTENSION OR COMPRESSION SUCH AS SIKAFLEX-2C NS/SL, SIKKA CORPORATION, OR SONOLASTIC NP-2, SONNEBORN, OR DYNATROL II BY PECORA CORPORATION.

C-3 CONCRETE FINISHES: CONCRETE EQUIPMENT PADS SHALL BE SKEEDED AND FLOATED WITH A WOOD OR MAGNESIUM FLOAT AFTER CONCRETE PLACEMENT AND ALL EDGES SHALL BE EDGED WITH A CONCRETE EDGING TOOL. FOLLOWING FLOATING THE CONCRETE SHALL RECEIVE A TEXTURED FINISH CREATED BY DRAWING A BROOM OR BURLAP BELT ACROSS THE SURFACE.

ALL EXPOSED SURFACES OF CONCRETE WALLS SHALL HAVE ALL FINIS, BURRS, OFFSETS, MARKS AND ALL OTHER PROJECTIONS LEFT BY THE FORMS REMOVED. ALL HOLES LEFT BY REMOVAL OF ENDS OF TIES, AND ALL OTHER HOLES, DEPRESSIONS, BUGHOLES, AIR/BLOW HOLES OR VOIDS SHALL BE FILLED SOLID WITH CEMENT GROUT AFTER FIRST BEING THOROUGHLY WETTED AND THEN STRUCK OFF FLUSH. ALL HOLES SHALL BE FILLED WITH TOOLS, SUCH AS SPONGE FLOATS AND TROWELS WHICH WILL PERMIT PACKING THE HOLE SOLIDLY WITH CEMENT GROUT. CEMENT GROUT SHALL CONSIST OF ONE PART CEMENT TO THREE PARTS SAND, EPOXY BONDING AGENT (FOR TIE HOLES ONLY) AND THE AMOUNT OF MIXING WATER SHALL BE AS LITTLE AS CONSISTENT WITH THE REQUIREMENTS OF HANDLING AND PLACING. COLOR OF CEMENT GROUT SHALL MATCH THE ADJACENT WALL SURFACE. AFTER ALL SURFACE IMPERFECTIONS HAVE BEEN REPAIRED THE SURFACE SHALL BE PREPARED AND GROUT CLEANED WITH A SLURRY CONSISTING OF ONE PART CEMENT (INCLUDING AN APPROPRIATE QUANTITY OF WHITE CEMENT IN ORDER TO PRODUCE A COLOR MATCHING THE SURROUNDING CONCRETE) AND 1-1/2 PARTS SAND PASSING THE NO. 16 SIEVE, BY DAMP LOOSE VOLUME. THE SLURRY SHALL BE SPREAD OVER THE SURFACE WITH CLEAN BURLAP PADS OR SPONGE RUBBER FLOATS. MIX PROPORTIONS SHALL BE SUBMITTED TO THE ENGINEER AFTER A SAMPLE OF THE WORK IS ESTABLISHED AND ACCEPTED. ANY SURPLUS SHALL BE REMOVED BY SCRAPING AND THEN RUBBING WITH CLEAN BURLAP.

C-4 CURING: CONCRETE SHALL BE CURED BY PONDING OR CONTINUOUS FOGGING OR SPRINKLING, APPLICATIONS OF MATS OR FABRIC KEPT CONTINUOUSLY WET, CONTINUOUS APPLICATION OF STEAM OR APPLICATION OF SHEETING MATERIALS CONFORMING TO ASTM C 171.

C-5 CLEAR DISTANCE FROM ANCHOR BOLTS TO ANY CONCRETE EDGE SHALL BE 4" MINIMUM UNLESS OTHERWISE NOTED.

C-6 CHEMICAL RESISTANT RETROFIT WATERSTOPS: RETROFIT WATERSTOPS SHALL BE MANUFACTURED OF THERMOPLASTIC ELASTOMERIC RUBBER (TPER) UNLESS ALTERNATIVE MATERIAL IS RECOMMENDED BY THE MANUFACTURER AND THE MANUFACTURER SHALL PROVIDE A COMPLETE SYSTEM INCLUDING WATERSTOP, STAINLESS STEEL ANCHORING HARDWARE AND BATTEN BARS AND EPOXY FOR INSTALLATION. AT WATERSTOP INTERSECTIONS FACTORY FABRICATED CORNERS AND TRANSITIONS SHALL BE USED AND SPLICES SHALL BE MADE WITH A THERMOSTATICALLY CONTROLLED HEATING ELEMENT AS APPROVED BY THE MANUFACTURER, WATERSTOP SHALL BE WESTEC MODEL 629 BY SIKA GREENSTREAK OR APPROVED EQUAL.

D-1 THE CONTRACTOR SHALL TAKE NECESSARY PRECAUTIONS TO PREVENT DUST FROM RISING BY WETTING DEMOLISHED MASONRY, CONCRETE, PLASTER AND SIMILAR DEBRIS. UNALTERED PORTIONS OF THE EXISTING BUILDINGS AFFECTED BY THE WORK SHALL BE PROTECTED BY DUST-PROOF PARTITIONS AND OTHER ADEQUATE MEANS.

D-2 CONCRETE DEMOLITION WITHIN STRUCTURES BEING MODIFIED SHALL BE SELECTIVE DEMOLITION BY CORE DRILLING OR SAWCUTTING AND CAREFUL REMOVAL OF CONCRETE SHOWN TO BE REMOVED. NO OVER CUTTING OF AREAS TO BE DEMOLISHED SHALL BE PERMITTED. CONTRACTOR SHALL CORE DRILL CORNERS OF OPENING PRIOR TO SAWCUTTING IF NECESSARY. VIBRATORY HAMMERS SHALL NOT BE USED FOR SELECT DEMOLITION WORK. JACK HAMMERS, HOE RAMS AND OTHER HIGH ENERGY DEMOLITION EQUIPMENT MAY BE USED FOR COMPLETE REMOVAL OF A STRUCTURE. EXPLOSIVES SHALL NOT BE USED FOR ANY DEMOLITION.

D-3 UNLESS ANCHORING DEVICES AND/OR REINFORCEMENT ARE NOTED TO REMAIN FOLLOWING DEMOLITION, REMOVE AND/OR BURN BACK ANCHORS AND REINFORCEMENT STEEL 1/2" MIN BELOW SURFACE. VOIDS CREATED SHALL BE FILLED WITH EPOXY RESIN BINDER.

D-4 WHERE DRAWINGS INDICATE A CONCRETE EQUIPMENT PAD TO BE DEMOLISHED, THE FLOOR SLAB SURFACE SHALL BE REPAIRED AS APPROVED BY ENGINEER. FOLLOWING SELECT DEMOLITION AND REMOVAL OF THE EQUIPMENT PAD, THE FLOOR SLAB SURFACE SHALL BE INSPECTED. IF THE FLOOR SLAB IS DAMAGED FROM THE EQUIPMENT PAD REMOVAL THE REPAIR SHALL BE:


- A) SAW CUT THE FLOOR SLAB AROUND THE EQUIPMENT PAD PERIMETER TO A DEPTH OF 1/4 INCH.
- B) SCARIFY AND REMOVE SLAB CONCRETE WITHIN THE PERIMETER TO A NOMINAL 1/4 INCH DEPTH. CLEAN AND REMOVE ALL CONCRETE LAINTANCE.
- C) RESURFACE THE AREA BY APPLYING A POLYMER MODIFIED OR SILICA FUME ENHANCED CEMENTITIOUS REPAIR MORTAR, APPROVED BY THE ENGINEER, FOLLOWING THE MANUFACTURERS SURFACE PREPARATION AND APPLICATION RECOMMENDATIONS. LEVEL AND FINISH THE SURFACE TO MATCH THE FLOOR SLAB SURROUNDING AREA.

D-5 CONCRETE SURFACES LEFT EXPOSED FOLLOWING DEMOLITION SHALL BE SEALED WITH A HIGH-BUILD, MOISTURE TOLERANT, EPOXY RESIN COATING. THE COATING SHALL BE SIKAGUARD 62 BY SIKA CORPORATION OR APPROVED EQUAL FOR POTABLE WATER APPLICATIONS, REQUIREMENTS OF ANSI/NSF STANDARD 61 SHALL BE SATISFIED.


D-6 A DETAILED CONSTRUCTION AND DEMOLITION PLAN SHALL BE SUBMITTED TO THE ENGINEER AND APPROVED BY THE ENGINEER AND OWNER PRIOR TO BEGINNING CONSTRUCTION. ANY SHUTDOWNS SHALL BE SUBMITTED TO, COORDINATED WITH, AND APPROVED BY THE OWNER IN ACCORDANCE WITH THE CONTRACT DOCUMENTS.

X-1 ALL EXISTING INFORMATION SHOWN ON THESE DRAWINGS INCLUDING LOCATION, DIMENSIONS, ELEVATIONS, AND CONFIGURATIONS IS DERIVED FROM THE "CARVINS COVE FILTER PLANT IMPROVEMENTS - PHASE 1, APRIL 1992 BY MATTERN AND CRAIG CONSULTING ENGINEERS" CONTRACT DRAWINGS AND IS NOT GUARANTEED TO BE COMPLETE OR CORRECT.

X-2 THE CONTRACTOR IS RESPONSIBLE FOR VERIFYING ALL EXISTING INFORMATION IN THE FIELD AS REQUIRED FOR DEMOLITION AND MODIFICATIONS.

				DESIGNED _____ AGM		<b>RECORD DRAWING</b> THIS DRAWING HAS BEEN MODIFIED TO REFLECT FIELD CHANGES REPORTED BY THE CONTRACTOR OR ANOTHER PARTY, BUT NOT VERIFIED BY THE CERTIFYING ENGINEER	<b>THIS DOCUMENT</b> ORIGINALLY ISSUED FOR CONSTRUCTION AND SEALED BY ALAN L. STONE, LIC NUMBER 24446	<b>Hazen and Sawyer</b> Environmental Engineers & Scientists  4011 WestChase Boulevard, Suite 500 Raleigh, North Carolina 27607 License No. : C-0381	<b>WESTERN VIRGINIA WATER AUTHORITY</b> <b>ROANOKE, VIRGINIA</b>	<b>GENERAL NOTES</b>	THE SCALE BAR SHOWN BELOW MEASURES ONE INCH LONG ON THE ORIGINAL DRAWING.	DATE OCTOBER 2014 HAS JOB NUMBER 31197-000	CONTRACT NUMBER	DRAWING NUMBER				
				DRAWN _____ KJO														
				CHECKED _____														
2	RECORD DRAWINGS	04/2015	ALS	PROJ.ENGR. _____ ALS										<b>CARVINS COVE WATER TREATMENT FACILITY</b> <b>DISINFECTION IMPROVEMENTS</b>				
1	FINAL DESIGN	09/2014	ALS															
NO.	ISSUED FOR	DATE	BY	APPROVED _____														



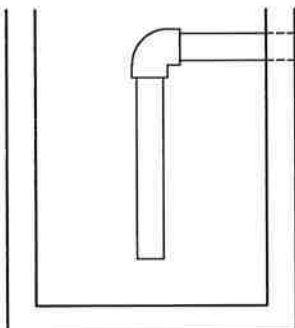


1
M1



1"=20'-0"



THE SCALE BAR SHOWN BELOW MEASURES ONE INCH LONG ON THE ORIGINAL DRAWING. 	DATE OCTOBER 2014	
	H&S JOB NUMBER 31197-000	
	CONTRACT NUMBER  1	DRAWING NUMBER  M1

## RECORD DRAWINGS



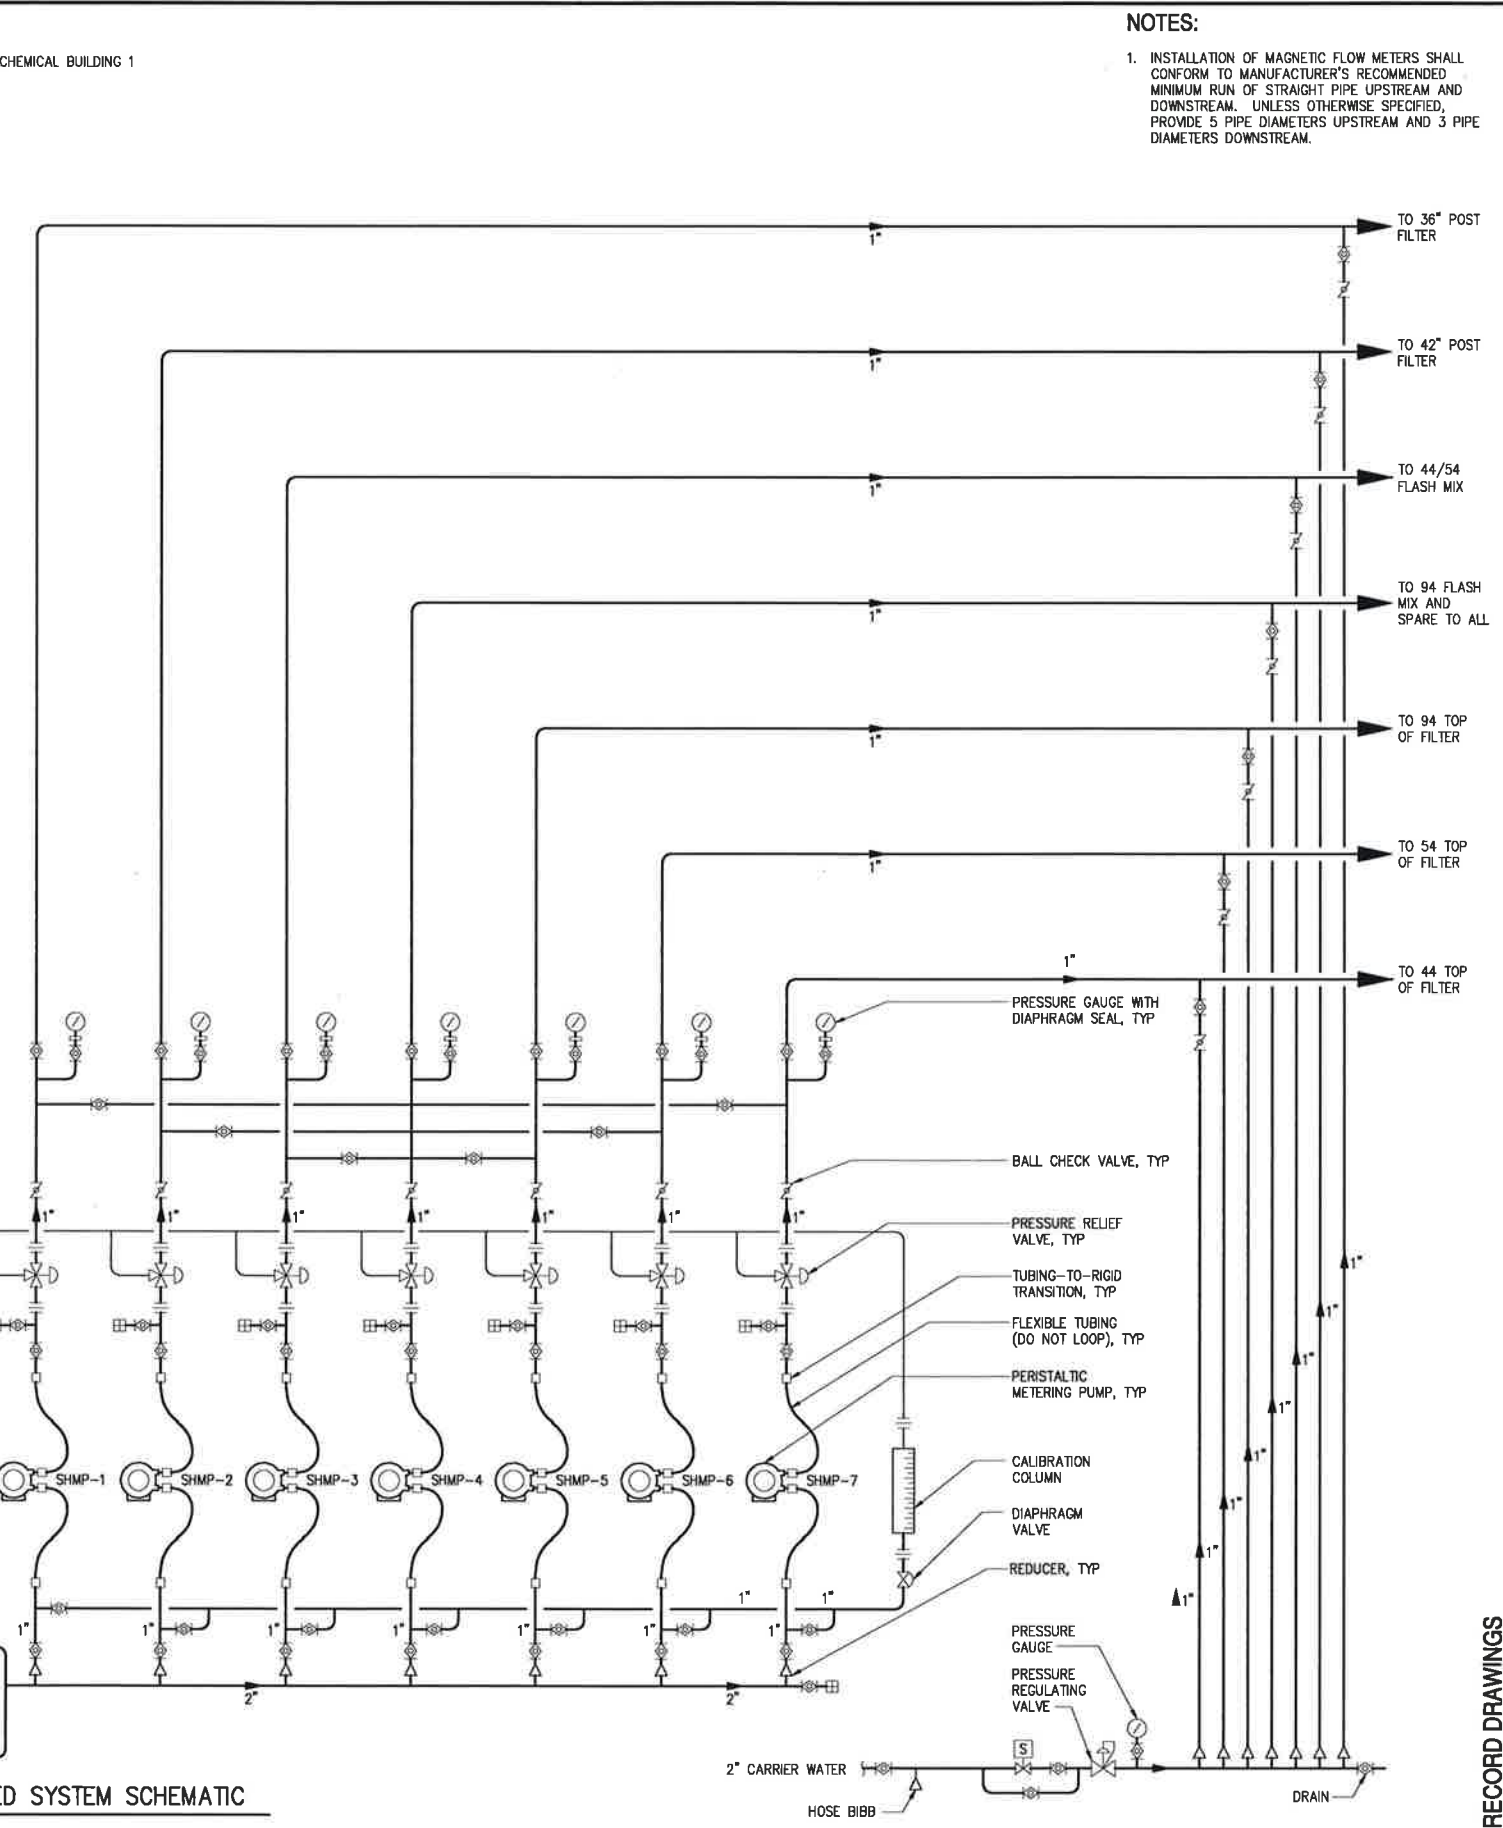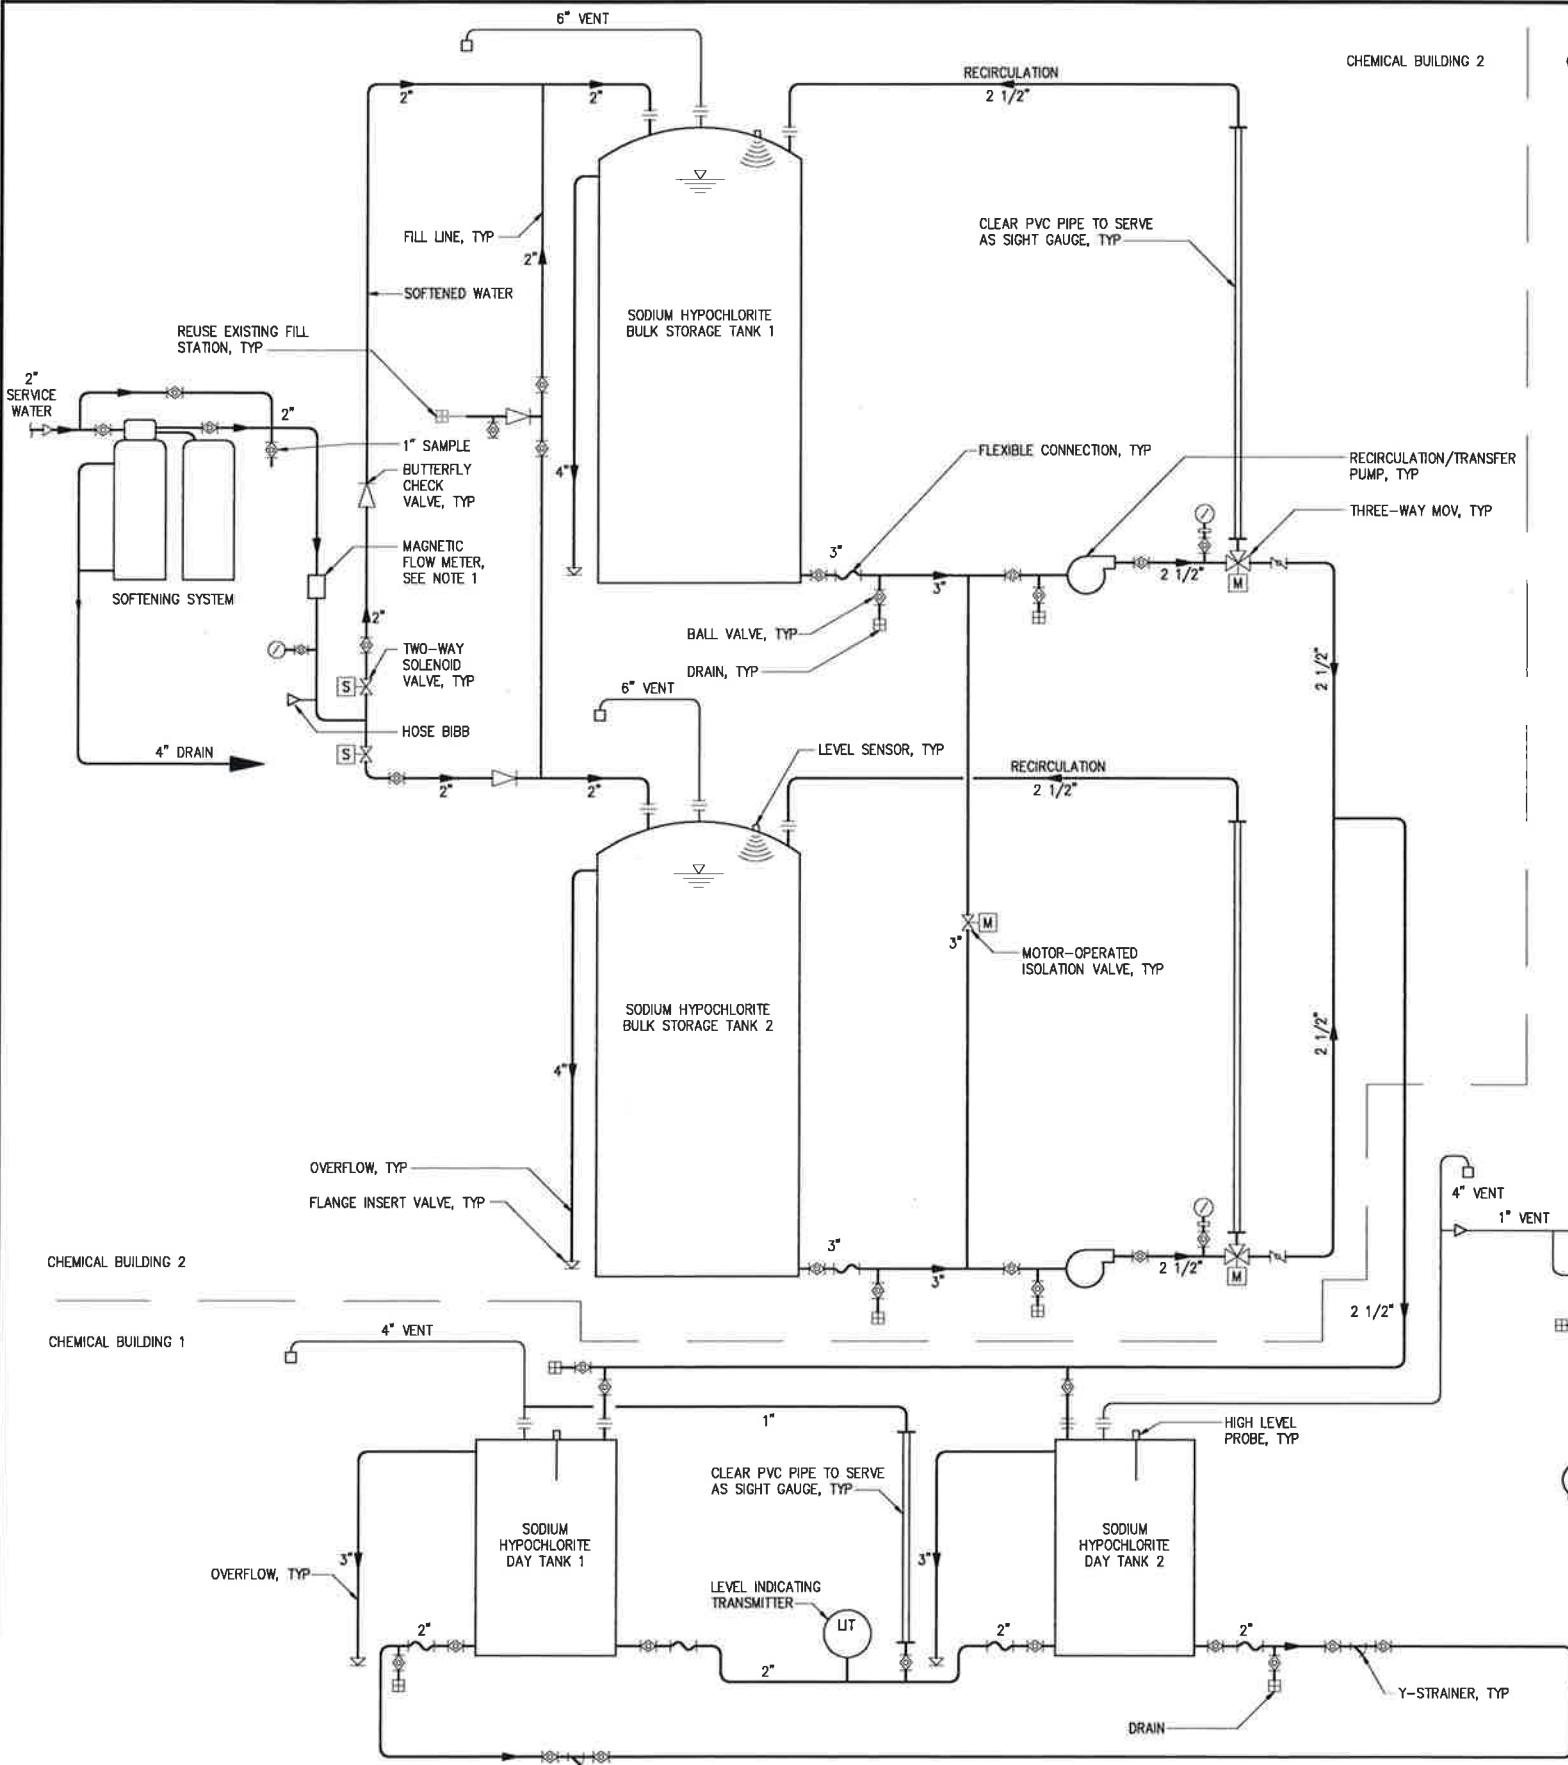

**NOTES:**  
1. INSTALLATION OF MAGNETIC FLOW METERS SHALL CONFORM TO MANUFACTURER'S RECOMMENDED MINIMUM RUN OF STRAIGHT PIPE UPSTREAM AND DOWNSTREAM. UNLESS OTHERWISE SPECIFIED, PROVIDE 5 PIPE DIAMETERS UPSTREAM AND 3 PIPE DIAMETERS DOWNSTREAM.

SODIUM HYPOCHLORITE FEED SYSTEM SCHEMATIC

File: C:\1197-000\1197-000\1197-000.dwg Plot Date: 4/8/2015 8:33 AM BY: TUNZ

DESIGNED	ABL
DRAWN	KJO
CHECKED	
PROJ. ENGR.	ALS
NO.	
2	RECORD DRAWINGS
1	FINAL DESIGN
	ISSUED FOR
DATE	04/2015
BY	ALS
APPROVED	



**RECORD DRAWING**  
THIS DRAWING HAS BEEN MODIFIED TO REFLECT FIELD CHANGES REPORTED BY THE CONTRACTOR OR ANOTHER PARTY, BUT NOT VERIFIED BY THE CERTIFYING ENGINEER.

THIS DOCUMENT ORIGINALLY ISSUED FOR CONSTRUCTION AND SEALED BY ALAN L. STONE, LIC NUMBER 24446

**HAZEN AND SAWYER**  
Environmental Engineers & Scientists  
4011 WestChase Boulevard, Suite 500  
Raleigh, North Carolina 27607  
License No.: C-0381

**WESTERN VIRGINIA WATER AUTHORITY**  
ROANOKE, VIRGINIA

**CARVINS COVE WATER TREATMENT FACILITY**  
DISINFECTION IMPROVEMENTS

**SODIUM HYPOCHLORITE FEED SYSTEM SCHEMATIC**


THE SCALE BAR SHOWN BELOW MEASURES ONE INCH LONG ON THE ORIGINAL DRAWING.	DATE	OCTOBER 2014
	H&S JOB NUMBER	31197-000
	CONTRACT NUMBER	
	DRAWING NUMBER	M100
	1	

RECORD DRAWINGS






1. PROVIDE A CHEMICAL RESIST CONTAINMENT LINER, AS INDICATED IN SPECIFICATION 09900, ON ALL VERTICAL AND HORIZONTAL CONCRETE SURFACES OF THE PROPOSED CONTAINMENT AREA AND THE EXISTING PUMP PIT.
2. SEE DRAWING M101 FOR SERVICE WATER SCHEMATIC.

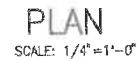

## RECORD DRAWINGS

				DESIGNED	ABL
				DRAWN	KJO
				CHECKED	
				PROJ.ENGR.	ALS
2	RECORD DRAWINGS	04/2015	ALS		
1	FINAL DESIGN	09/2014	ALS		
NO.	ISSUED FOR	DATE	BY	APPROVED	

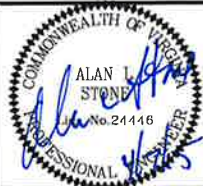

**RECORD DRAWING**

THIS DRAWING HAS BEEN  
MODIFIED TO REFLECT FIELD  
CHANGES REPORTED BY  
THE CONTRACTOR OR  
ANOTHER PARTY, BUT NOT  
VERIFIED BY THE  
CERTIFYING ENGINEER


THIS DOCUMENT  
ORIGINALLY ISSUED  
FOR CONSTRUCTION  
AND SEALED BY  
ALAN L. STONE, LIC  
NUMBER 24446

**HAZEN AND SAWYER**  
Environmental Engineers & Scientists  
4011 WestChase Boulevard, Suite 500  
Raleigh, North Carolina 27607  
License No. : C-0381

**WESTERN VIRGINIA WATER AUTHORITY**  
**ROANOKE, VIRGINIA**


## CARVINS COVE WATER TREATMENT FACILITY DISINFECTION IMPROVEMENTS

## CHEMICAL BUILDING 1 DAY TANK AND FEED PUMPS

THE SCALE BAR SHOWN BELOW MEASURES ONE INCH LONG ON THE ORIGINAL DRAWING. 	DATE OCTOBER 2014	
	H&S JOB NUMBER 31197-000	
	CONTRACT NUMBER 1	DRAWING NUMBER M102


NOTES:

1. EXISTING UNGROUTED CMU WALL DOES NOT HAVE SUFFICIENT STRENGTH TO ALLOW CONTAINMENT WALL TO BE CONSTRUCTED IN ONE FULL HEIGHT PLACEMENT. AS SUCH, THE NORTHERN MOST CONTAINMENT WALL SHALL BE PLACED IN TWO 12" LIFTS WITH A CHEMICAL RESISTANT WATERSTOP IN THE JOINT BETWEEN LIFTS. IN LIEU OF PLACING IN TWO LIFTS THE CONTRACTOR MAY BRACE THE CMU WALL TO PREVENT OVER STRESSING OR SHIFTING OF THE CMU WALL AND PLACE THE PROPOSED CONCRETE WALL IN ONE LIFT. IF BRACING IS DESIRED SUBMIT INTENDED METHOD OF BRACING TO ENGINEER FOR REVIEW. LOCATION AND LENGTH OF TIME BRACING WILL BE IN PLACE SHALL BE COORDINATED WITH AND APPROVED BY THE OWNER PRIOR TO INSTALLATION.
2. EXISTING DRAWINGS INDICATE THAT THE EXTERIOR WALLS OF CHEMICAL BUILDING 1 CONSIST OF A 24" HIGH CONCRETE KNEE WALL. WHERE THIS KNEE WALL EXISTS THE PROPOSED CONCRETE CONTAINMENT WALL MAY BE PLACED FULL HEIGHT. IF AT ANY LOCATION ALONG THE EXTERIOR WALLS THIS CONCRETE KNEE WALL DOES NOT EXIST THEN THE PROPOSED WALL SHALL BE PLACED AS REQUIRED BY SECTION B/M103.

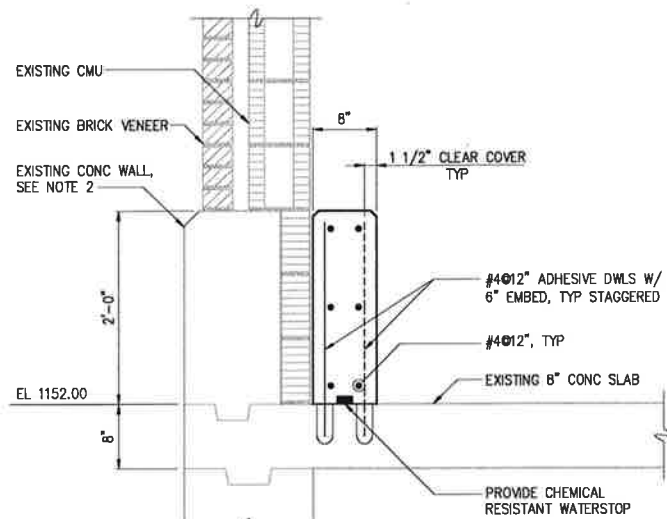


TYPICAL CONTAINMENT WALL

SECTION A  
1" = 1'-0" M102

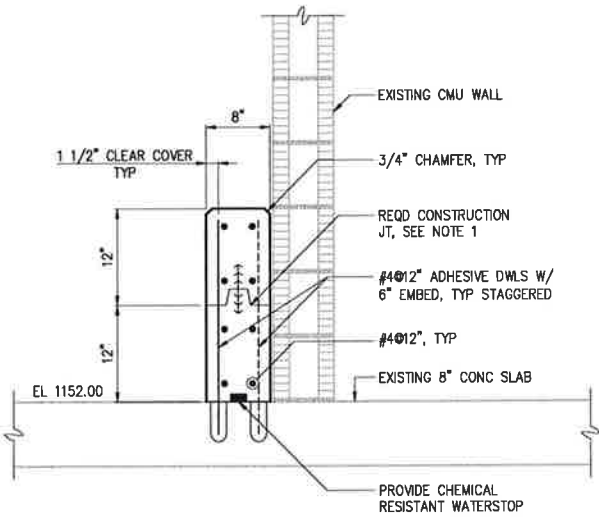

SECTION AT UNREINFORCED CMU

SECTION B  
1" = 1'-0" M102

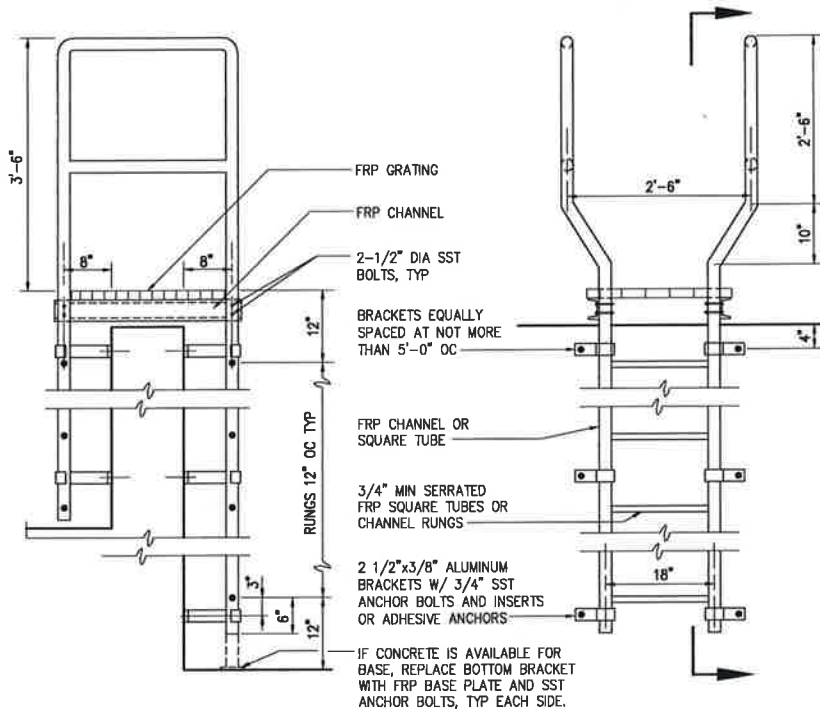


SECTION

ELEVATION

FRP CROSSOVER LADDER


DETAIL 4  
NTS M102

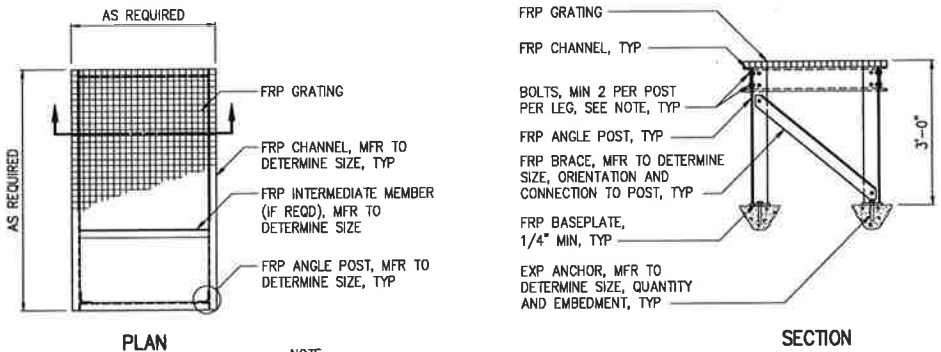

NOTE:  
SEE SPECIFICATION SECTION 06610, GLASS FIBER AND RESIN APPLICATIONS, FOR REQUIREMENTS OF FRP GRATING, STRUCTURAL SHAPES AND BOLTED CONNECTIONS.

FRP EQUIPMENT TABLE


DETAIL 1  
1" = 1'-0" M102

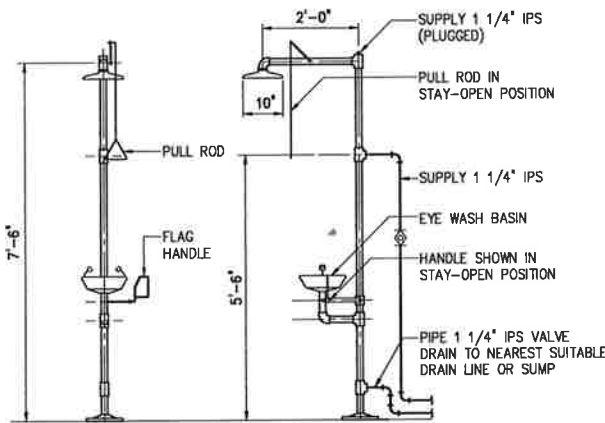

EMERGENCY SHOWER AND EYEWASH

DETAIL 2  
1" = 1'-0" M102

ADDITIONAL DIAGONAL BARS, REQUIRED IN LIQUID RETAINING WALLS ONLY, ALTERNATE WITH HORIZONTAL BARS AND SIZE PER CHART.

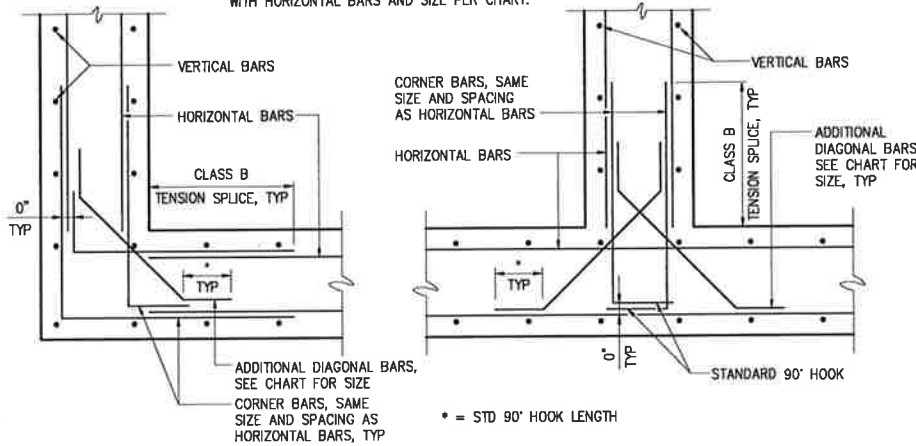


CORNER

INTERSECTION

TYPICAL WALL REINFORCING

DETAIL 5  
1" = 1'-0" M102

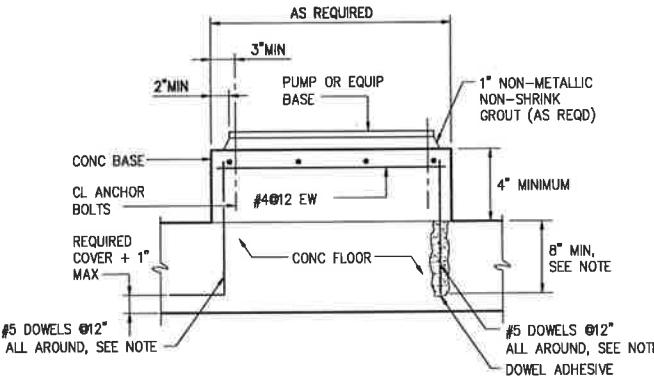

NOTE:  
DOWELS MAY BE CAST IN WITH 90° HOOK OR ANCHORED WITH DOWEL ADHESIVE AT CONTRACTOR'S OPTION. WHERE FLOOR IS 8" THICK OR LESS, USE #4 DOWELS EMBEDDED TO WITHIN 2" OF BOTTOM OF FLOOR SLAB.

CONCRETE EQUIPMENT PAD

DETAIL 3  
1" = 1'-0" M102

DIAGONAL BAR SIZE CHART	
BAR SIZE - HORIZONTAL REINFORCEMENT	BAR SIZE - DIAGONAL REINFORCEMENT
# 3	# 3
# 4	# 3
# 5	# 4
# 6	# 5
# 7	# 5
# 8	# 6
# 9	# 7
# 10	# 8
# 11	# 9

AT LOCATIONS WHERE DIFFERENT SIZE HORIZONTAL BARS CONVERGE, THE LARGER BAR SIZE SHALL CONTROL.

\* = STD 90° HOOK LENGTH

NO.	RECORD DRAWINGS	DATE	BY	APPROVED
2	RECORD DRAWINGS	04/2015	ALS	
1	FINAL DESIGN	09/2014	ALS	
	ISSUED FOR			

DESIGNED	AGM
DRAWN	KJO
CHECKED	
PROJ. ENGR.	ALS
APPROVED	



RECORD DRAWING  
THIS DRAWING HAS BEEN MODIFIED TO REFLECT FIELD CHANGES REPORTED BY THE CONTRACTOR OR ANOTHER PARTY, BUT NOT VERIFIED BY THE CERTIFYING ENGINEER

THIS DOCUMENT ORIGINALLY ISSUED FOR CONSTRUCTION AND SEALED BY ALAN L. STONE, LIC NUMBER 24446

**HAZEN AND SAWYER**  
Environmental Engineers & Scientists  
4011 WestChase Boulevard, Suite 500  
Raleigh, North Carolina 27607  
License No.: C-0381

WESTERN VIRGINIA WATER AUTHORITY  
ROANOKE, VIRGINIA  
CARVINS COVE WATER TREATMENT FACILITY  
DISINFECTION IMPROVEMENTS


CHEMICAL BUILDING 1  
DETAILS

THE SCALE BAR SHOWN BELOW MEASURES ONE INCH LONG ON THE ORIGINAL DRAWING.	DATE: OCTOBER 2014 H&S JOB NUMBER: 31197-000
	CONTRACT NUMBER: 1 DRAWING NUMBER: M103






BLOCK DIAGRAMS

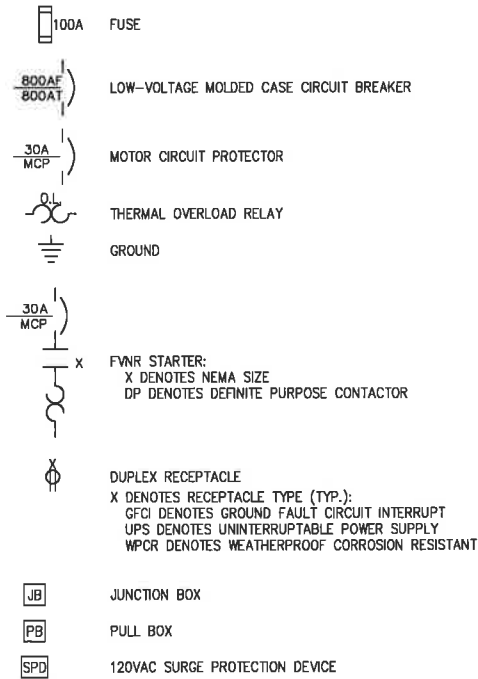

ELEMENTARY CONTROL SCHEMATICS

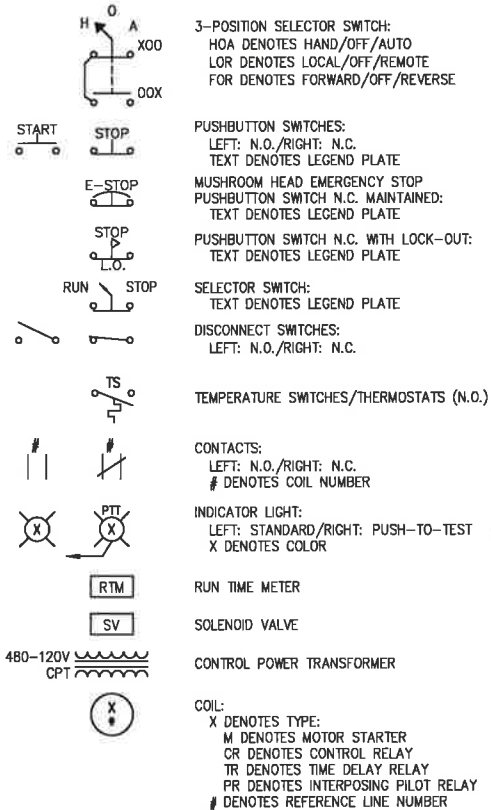

ABBREVIATIONS

ANSI	AMERICAN NATIONAL STANDARDS INSTITUTE
ASCE	AMERICAN SOCIETY OF CIVIL ENGINEERS
ASME	AMERICAN SOCIETY OF MECHANICAL ENGINEERS
ATS	AUTOMATIC TRANSFER SWITCH
BC	BYPASS CONTACTOR
CT	CURRENT TRANSFORMER
DB	DUCTBANK
DSW	DISCONNECT SWITCH
EHH	ELECTRIC HAND HOLE
EMH	ELECTRIC MANHOLE
EO	ELECTRICALLY OPERATED
FAAP	FIRE ALARM ANNUNCIATOR PANEL
FACP	FIRE ALARM CONTROL PANEL
FVNR	FULL VOLTAGE NON-REVERSING
FVR	FULL VOLTAGE REVERSING
GFCI	GROUND FAULT CIRCUIT INTERRUPT
GFCT	GROUND FAULT CURRENT TRANSFORMER
IC	INPUT CONTACTOR
IEEE	INSTITUTE OF ELECTRICAL AND ELECTRONICS ENGINEERS
ISO	INTL. ORGANIZATION FOR STANDARDIZATION
LCS	LOCAL CONTROL STATION
LP	LIGHTING PANEL
MFR	MULTI-FUNCTION RELAY
MOD	MOTOR OPERATED DAMPER
MOG	MOTOR OPERATED GATE
MOL	MOTOR OPERATED LOUVER
MOV	MOTOR OPERATED VALVE
MTS	MANUAL TRANSFER SWITCH
NC/NO	NORMALLY CLOSED/NORMALLY OPEN
NEC	NATIONAL ELECTRICAL CODE
NEMA	NATIONAL ELECTRICAL MANUFACTURERS ASSN
NTS	NOT TO SCALE
OC	OUTPUT CONTACTOR
OL	OVERLOAD
PC	PHOTOCELL
PCC	POINT OF COMMON COUPLING
PLC	PROGRAMMABLE LOGIC CONTROLLER
PNL	PANEL
PP	POWER PANEL
PT	POTENTIAL TRANSFORMER
RCS	REMOTE CONTROL STATION
RIO	REMOTE I/O
RVAT	REDUCED VOLTAGE AUTO TRANSFORMER
RVSS	REDUCED VOLTAGE SOLID STATE
SP. C.	SPARE CONDUIT
SST	STAINLESS STEEL
TB	TEST BLOCK
TC/TO	TIMED CLOSE//TIMED OPEN
TSH	TWISTED SHIELDED
TX	TRANSFORMER
UPS	UNINTERRUPTABLE POWER SUPPLY
VFD	VARIABLE FREQUENCY DRIVE
WPCR	WEATHER PROOF CORROSION RESISTANT
WT	WALK THROUGH

EQUIPMENT/DEVICE LOCATION SYMBOLS


*	LOCATED AT MCC
△	LOCATED IN FIELD
○ <sub>X</sub>	LOCATED AT PANEL: X DENOTES PANEL ID

NOTES:

- UNLESS OTHERWISE SPECIFIED OR NOTED, ALL WALL MOUNTED ELECTRICAL PANELS, ENCLOSURES, AND SIMILAR EQUIPMENT SHALL BE MOUNTED 6'-6" (MAX) FROM THE TOP OF THE PANEL TO FINISHED FLOOR OR GRADE.
- UNLESS OTHERWISE NOTED, ALL LIGHTING SWITCHES, CONTROL SWITCHES, AND SIMILAR EQUIPMENT SHALL BE MOUNTED WITH THEIR CENTERLINE APPROXIMATELY 4'-0" ABOVE FINISHED FLOOR, SLAB, OR GRADE.
- A SEPARATE EQUIPMENT GROUNDING CONDUCTOR SHALL BE PROVIDED FOR EACH CIRCUIT (SEPARATE CONDUCTOR IN THE CONDUIT). THE CONDUCTOR SHALL BE TERMINATED AT THE PROPER DEVICE, TERMINAL, OR LUG AT THE POWER SOURCE (MCC GROUND BUS, PANELBOARD GROUND BUS, ETC.). GROUND CONDUCTOR SIZE SHALL BE PER THE LATEST EDITION OF THE NEC.

DESIGNED	JAD
DRAWN	JAD
CHECKED	
PROJ. ENGR.	ALS
APPROVED	

NO.	2	RECORD DRAWINGS	04/2015	ALS
	1	FINAL DESIGN	09/2014	ALS
ISSUED FOR				

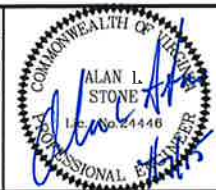

RECORD DRAWING

THIS DRAWING HAS BEEN MODIFIED TO REFLECT FIELD CHANGES REPORTED BY THE CONTRACTOR OR ANOTHER PARTY, BUT NOT VERIFIED BY THE CERTIFYING ENGINEER

THIS DOCUMENT ORIGINALLY ISSUED FOR CONSTRUCTION AND SEALED BY JASON A. DAVIS, L.C. NUMBER 052009

**HAZEN AND SAWYER**  
Environmental Engineers & Scientists

4011 WestChase Boulevard, Suite 500  
Raleigh, North Carolina 27607  
License No.: C-0381

WESTERN VIRGINIA WATER AUTHORITY  
ROANOKE, VIRGINIA


CARVINS COVE WATER TREATMENT FACILITY  
DISINFECTION IMPROVEMENTS

ELECTRICAL  
LEGEND AND GENERAL NOTES

THE SCALE BAR SHOWN BELOW MEASURES ONE INCH LONG ON THE ORIGINAL DRAWING.	DATE: OCTOBER 2014
	H&S JOB NUMBER: 31197-000
	CONTRACT NUMBER: 1
	DRAWING NUMBER: E1



- NOTES:
1. ALL CONDUIT SHALL BE SCHEDULE 80 PVC. CONDUIT SHALL BE LISTED TO UL-651.
  2. FLOAT LEVEL SWITCH IS LOCATED 6" ABOVE THE BOTTOM OF SUMP.

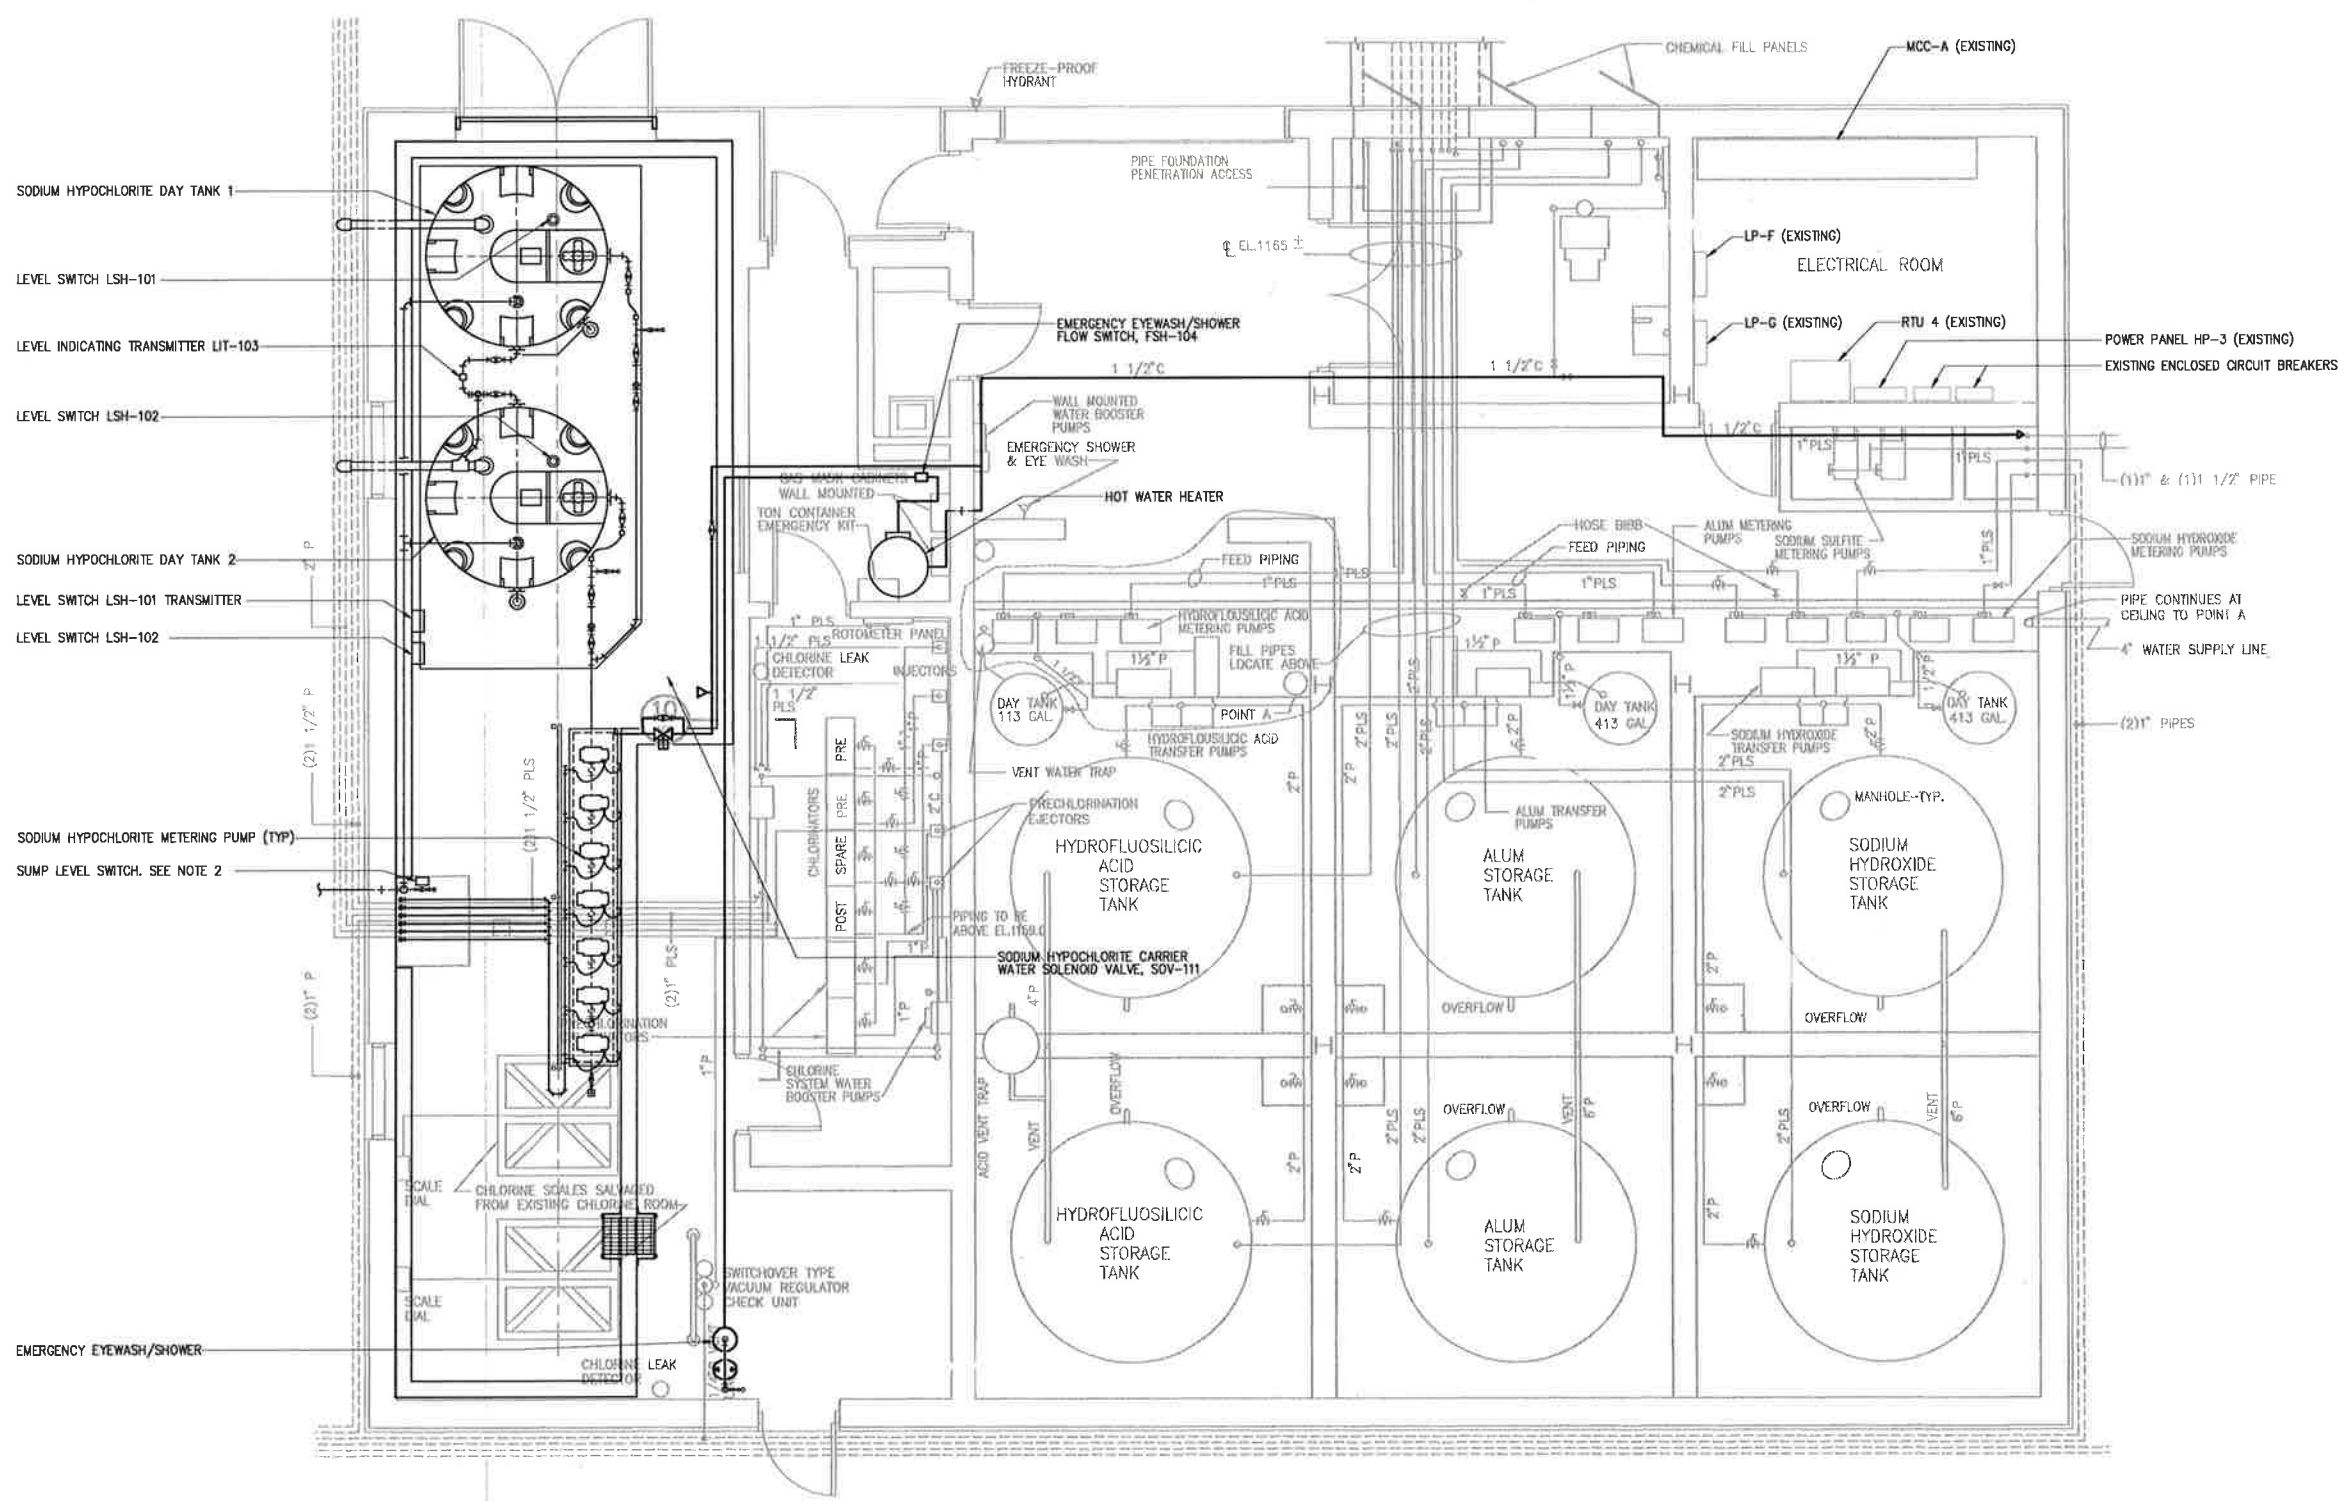


POWER PLAN  
1/4"=1'-0"

\\s:\197-000\Drawings\197-000.dwg 10/20/2014 8:14 AM  
2014 10/20/2014 8:14 AM 10/20/2014

DESIGNED	JAD
DRAWN	JAD
CHECKED	
PROJENGR.	ALS
APPROVED	

2	RECORD DRAWINGS	04/2015	ALS
1	FINAL DESIGN	09/2014	ALS
NO.	ISSUED FOR	DATE	BY

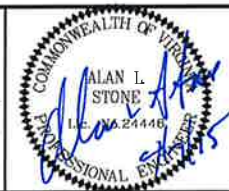

RECORD DRAWING  
THIS DRAWING HAS BEEN MODIFIED TO REFLECT FIELD CHANGES REPORTED BY THE CONTRACTOR OR ANOTHER PARTY, BUT NOT VERIFIED BY THE CERTIFYING ENGINEER

THIS DOCUMENT ORIGINALLY ISSUED FOR CONSTRUCTION AND SEALED BY JASON A. DAVIS, LIC NUMBER 052009

**HAZEN AND SAWYER**  
Environmental Engineers & Scientists  
4011 WestChase Boulevard, Suite 500  
Raleigh, North Carolina 27607  
License No. : C-0381

WESTERN VIRGINIA WATER AUTHORITY  
ROANOKE, VIRGINIA  
CARVINS COVE WATER TREATMENT FACILITY  
DISINFECTION IMPROVEMENTS


ELECTRICAL  
CHEMICAL BUILDING 1 POWER PLAN

THE SCALE BAR SHOWN BELOW MEASURES ONE INCH LONG ON THE ORIGINAL DRAWING.	DATE OCTOBER 2014
	H&S JOB NUMBER 31197-000
	CONTRACT NUMBER 1
	DRAWING NUMBER E100

RECORD DRAWINGS

1. FURNISH AND INSTALL NEW MOLDED CASE CIRCUIT BREAKER AS INDICATED. CIRCUIT BREAKER SHALL BE 120VAC, 1-POLE, 1-PHASE, BOLT-ON TYPE WITH 10KA SHORT CIRCUIT RATING MATCHING THE EXISTING PANEL.
2. FURNISH AND INSTALL NEW CIRCUIT BREAKER, ALLEN-BRADLEY MODEL 2193FZ-AKB-32TGM, AND BLANK DOOR, ALLEN-BRADLEY MODEL 2100-BK05, IN EXISTING SPARE MCC SPACE IN SECTION 6G.




THE SCALE BAR SHOWN BELOW MEASURES ONE INCH LONG ON THE ORIGINAL DRAWING. 	DATE OCTOBER 2014	
	H&S JOB NUMBER 31197-000	
	CONTRACT NUMBER  1	DRAWING NUMBER  E101





- NOTES:
1. MOUNT TWO NEW LEVEL INDICATING TRANSMITTERS, ONE NEW SURGE PROTECTION DEVICE AND NEW JUNCTION BOX ABOVE THE EXISTING MILLITRONICS AIRANGER XPL LEVEL MEASUREMENT SYSTEM.
  2. ALL CONDUIT SHALL BE SCHEDULE 80 PVC. CONDUIT SHALL BE LISTED TO UL-651.

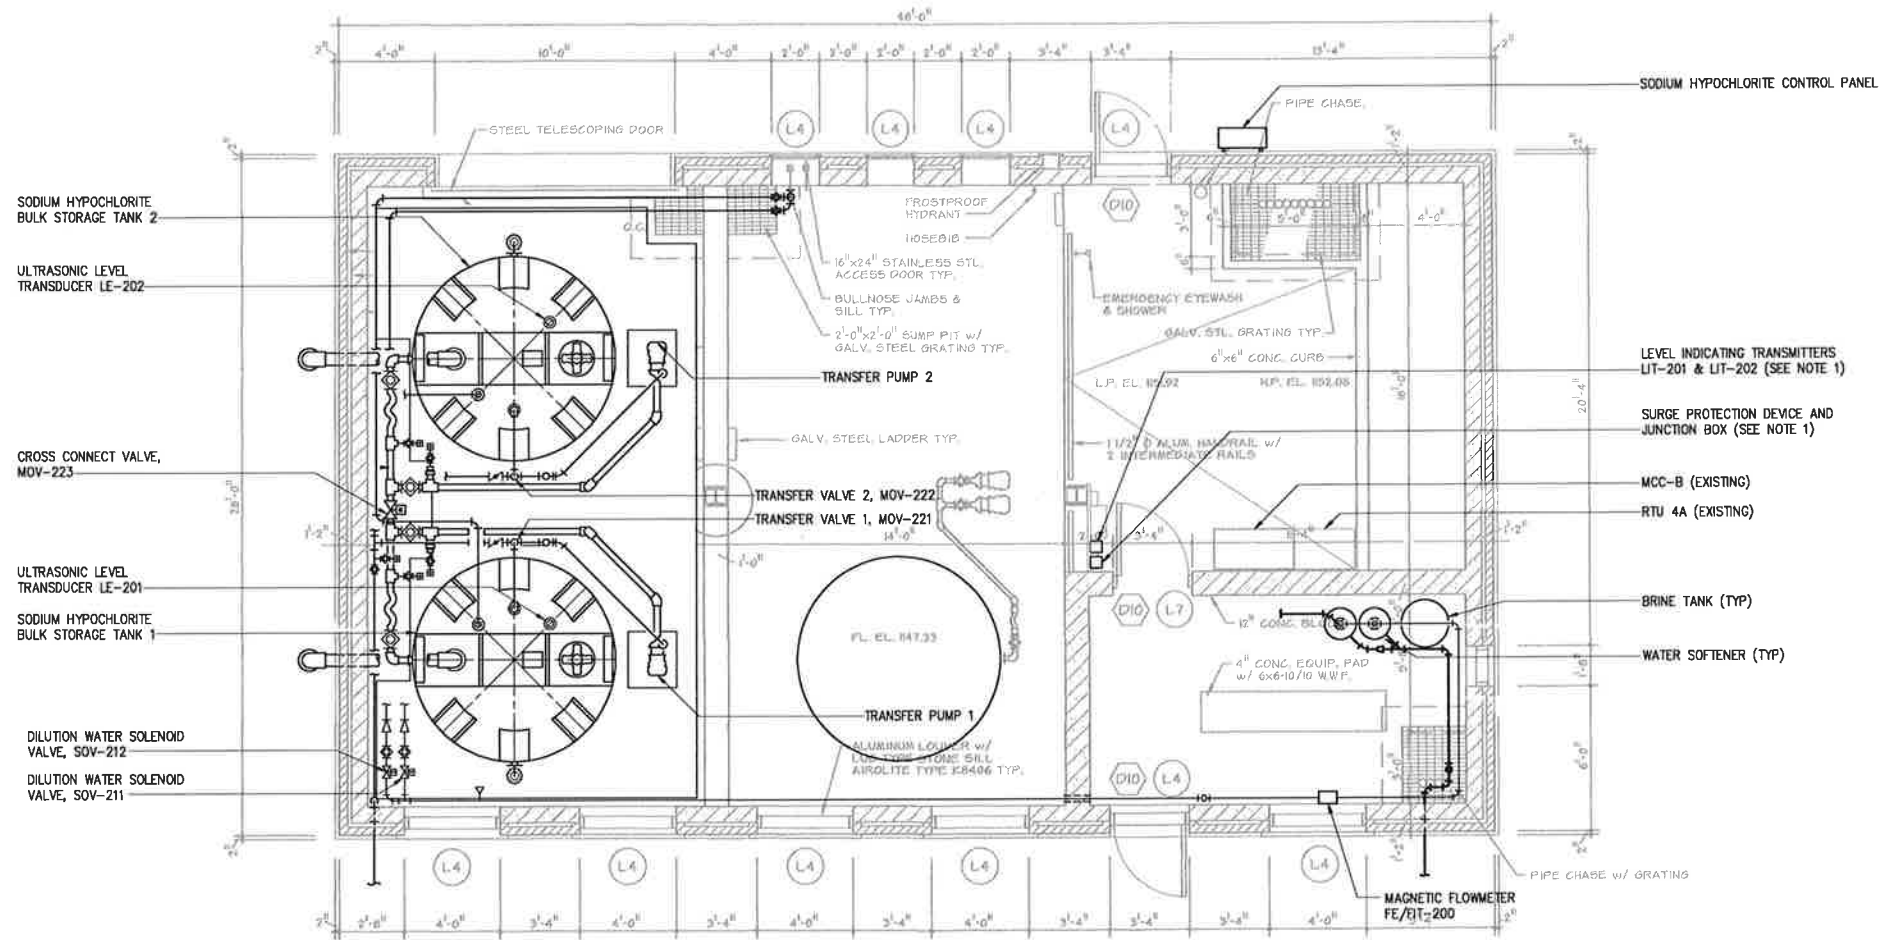


POWER PLAN

1/4"=1'-0"

File: C:\31197-000\31197-000\31197-000\31197-000.dwg Plot Date: 4/10/2015 1:08 PM

NO.	RECORD DRAWINGS	DATE	BY	APPROVED
2	FINAL DESIGN	04/2015	ALS	
1	ISSUED FOR	09/2014	ALS	

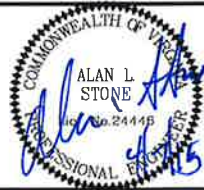

RECORD DRAWING  
THIS DRAWING HAS BEEN  
MODIFIED TO REFLECT FIELD  
CHANGES REPORTED BY  
THE CONTRACTOR OR  
ANOTHER PARTY, BUT NOT  
VERIFIED BY THE  
CERTIFYING ENGINEER

THIS DOCUMENT  
ORIGINALLY ISSUED  
FOR CONSTRUCTION  
AND SEALED BY  
JASON A. DAVIS,  
IIC NUMBER 052009

**HAZEN AND SAWYER**  
Environmental Engineers & Scientists  
4011 WestChase Boulevard, Suite 500  
Raleigh, North Carolina 27607  
License No.: C-0381

WESTERN VIRGINIA WATER AUTHORITY  
ROANOKE, VIRGINIA  
CARVINS COVE WATER TREATMENT FACILITY  
DISINFECTION IMPROVEMENTS


ELECTRICAL  
CHEMICAL BUILDING 2 PLAN

THE SCALE BAR SHOWN BELOW MEASURES ONE INCH LONG ON THE ORIGINAL DRAWING.	DATE OCTOBER 2014
	H&S JOB NUMBER 31197-000
	CONTRACT NUMBER 1
	DRAWING NUMBER E200

RECORD DRAWINGS

NOTES:

1. DISCONNECT AND REMOVE THE TWO EXISTING CABLES CURRENTLY ROUTED FROM THE EXISTING ULTRASONIC LEVEL MEASUREMENT SYSTEM TO THE FURTHEST STORAGE TANK LEVEL TRANSDUCERS.
2. FURNISH AND INSTALL NEW CABLES FROM THE NEW LEVEL INDICATING TRANSMITTERS TO THE ASSOCIATED LEVEL TRANSDUCERS USING EXISTING CONDUIT.
3. REPLACE THE EXISTING FLEXIBLE NONMETALLIC CONDUIT ROUTED FROM THE NEAREST EXISTING LB-TYPE CONDUIT BODY TO THE NEW LEVEL TRANSDUCER.
4. DISCONNECT AND LABEL AS SPARE THE EXISTING WIRE/CABLES ASSOCIATED WITH THE TWO FURTHEST STORAGE TANK LEVEL TRANSDUCERS.
5. EXTEND EXISTING ULTRASONIC LEVEL MEASUREMENT SYSTEM POWER CIRCUIT TO SUPPLY POWER TO THE NEW LEVEL INDICATING TRANSMITTERS.
6. FURNISH AND INSTALL NEW WIRE IN EXISTING SPARE CONDUIT. EXTEND EXISTING CONDUIT TO RTU 4A ENCLOSURE.
7. FURNISH AND INSTALL NEW MOLDED CASE CIRCUIT BREAKER AS INDICATED. CIRCUIT BREAKER SHALL BE 120VAC, 1-POLE, 1-PHASE, BOLT-ON TYPE WITH 10KA SHORT CIRCUIT RATING MATCHING THE EXISTING PANEL.
8. CABLE SHALL BE BELDEN 9934 OR EQUAL. MAXIMUM CABLE CAPACITANCE SHALL NOT EXCEED 2,500 pF.
9. REPLACE EXISTING OVERLOAD UNIT WITH ONE APPROPRIATELY SIZED FOR THE NEW MOTOR. NEW OVERLOAD UNIT SHALL HAVE A NORMALLY OPEN CONTACT FOR REMOTE INDICATION AS SHOWN ON DRAWING E202.
10. FURNISH AND INSTALL A 120VAC INTERPOSING RELAY IN THE EXISTING RTU 4A ENCLOSURE TO CONTROL THE SOLENOID VALVE.

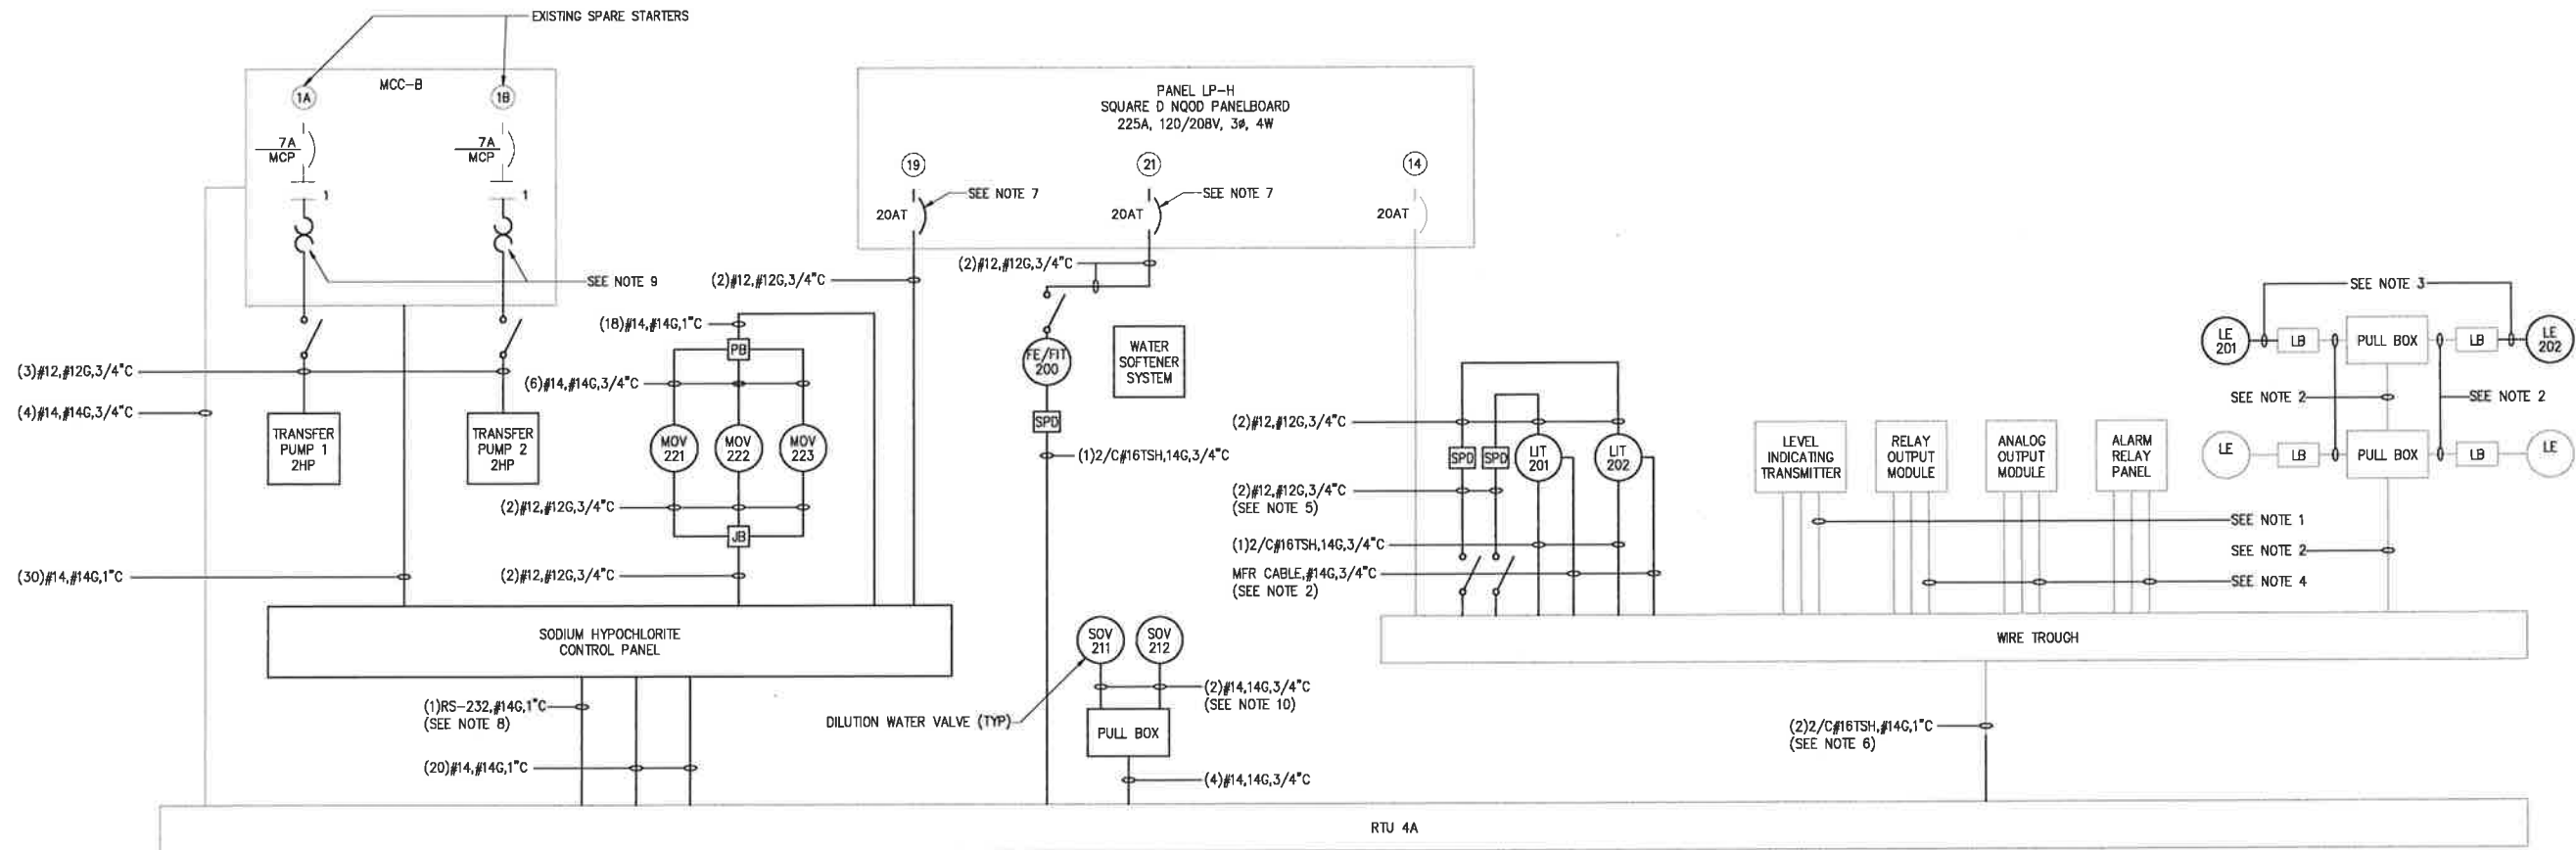

File: C:\Users\jstone\OneDrive\Documents\Hazen\Sawyer\Carvins Cove\Carvins Cove Water Treatment Facility\Carvins Cove Water Treatment Facility - 4/2/2015 3:14 AM  
2015-10-01 10:00 AM 10/1/2015 10:00 AM 10/1/2015 10:00 AM

DESIGNED	JAD
DRAWN	JAD
CHECKED	
PROJ. ENGR.	ALS
APPROVED	
NO.	2
ISSUED FOR	RECORD DRAWINGS
DATE	04/2015
BY	ALS
NO.	1
ISSUED FOR	FINAL DESIGN
DATE	09/2014
BY	ALS



RECORD DRAWING

THIS DRAWING HAS BEEN MODIFIED TO REFLECT FIELD CHANGES REPORTED BY THE CONTRACTOR OR ANOTHER PARTY, BUT NOT VERIFIED BY THE CERTIFYING ENGINEER

THIS DOCUMENT ORIGINALLY ISSUED FOR CONSTRUCTION AND SEALED BY JASON A. DAVIS, LIC NUMBER 052009

**HAZEN AND SAWYER**  
Environmental Engineers & Scientists  
4011 WestChase Boulevard, Suite 500  
Raleigh, North Carolina 27607  
License No.: C-0381

WESTERN VIRGINIA WATER AUTHORITY  
ROANOKE, VIRGINIA

CARVINS COVE WATER TREATMENT FACILITY  
DISINFECTION IMPROVEMENTS



ELECTRICAL  
CHEMICAL BUILDING 2 BLOCK DIAGRAM

THE SCALE BAR SHOWN BELOW MEASURES ONE INCH LONG ON THE ORIGINAL DRAWING.	DATE	OCTOBER 2014
	H&S JOB NUMBER	31197-000
	CONTRACT NUMBER	1
	DRAWING NUMBER	E201

RECORD DRAWINGS





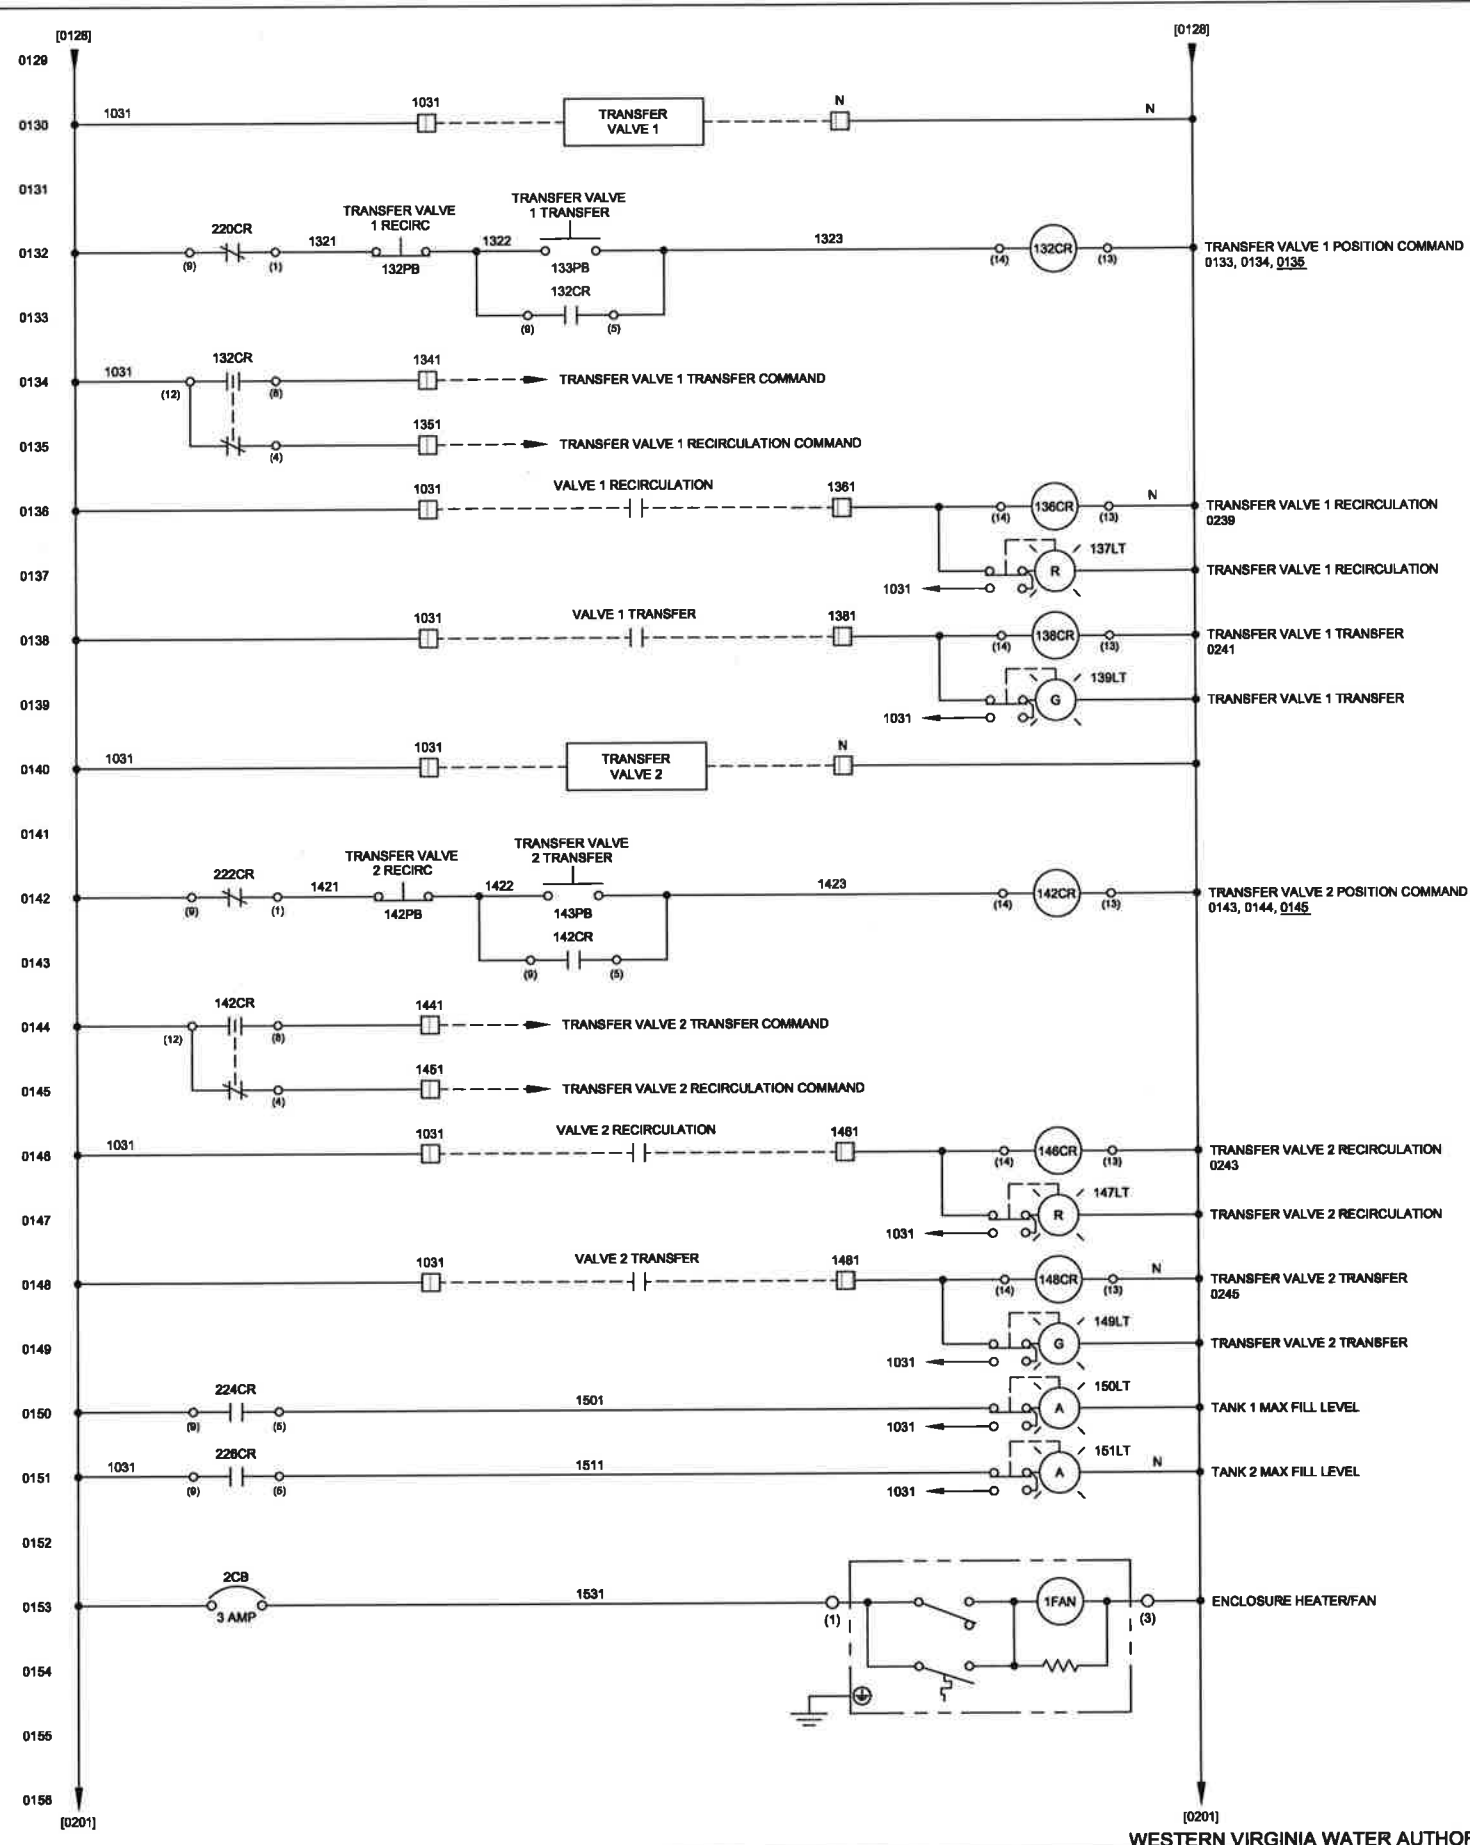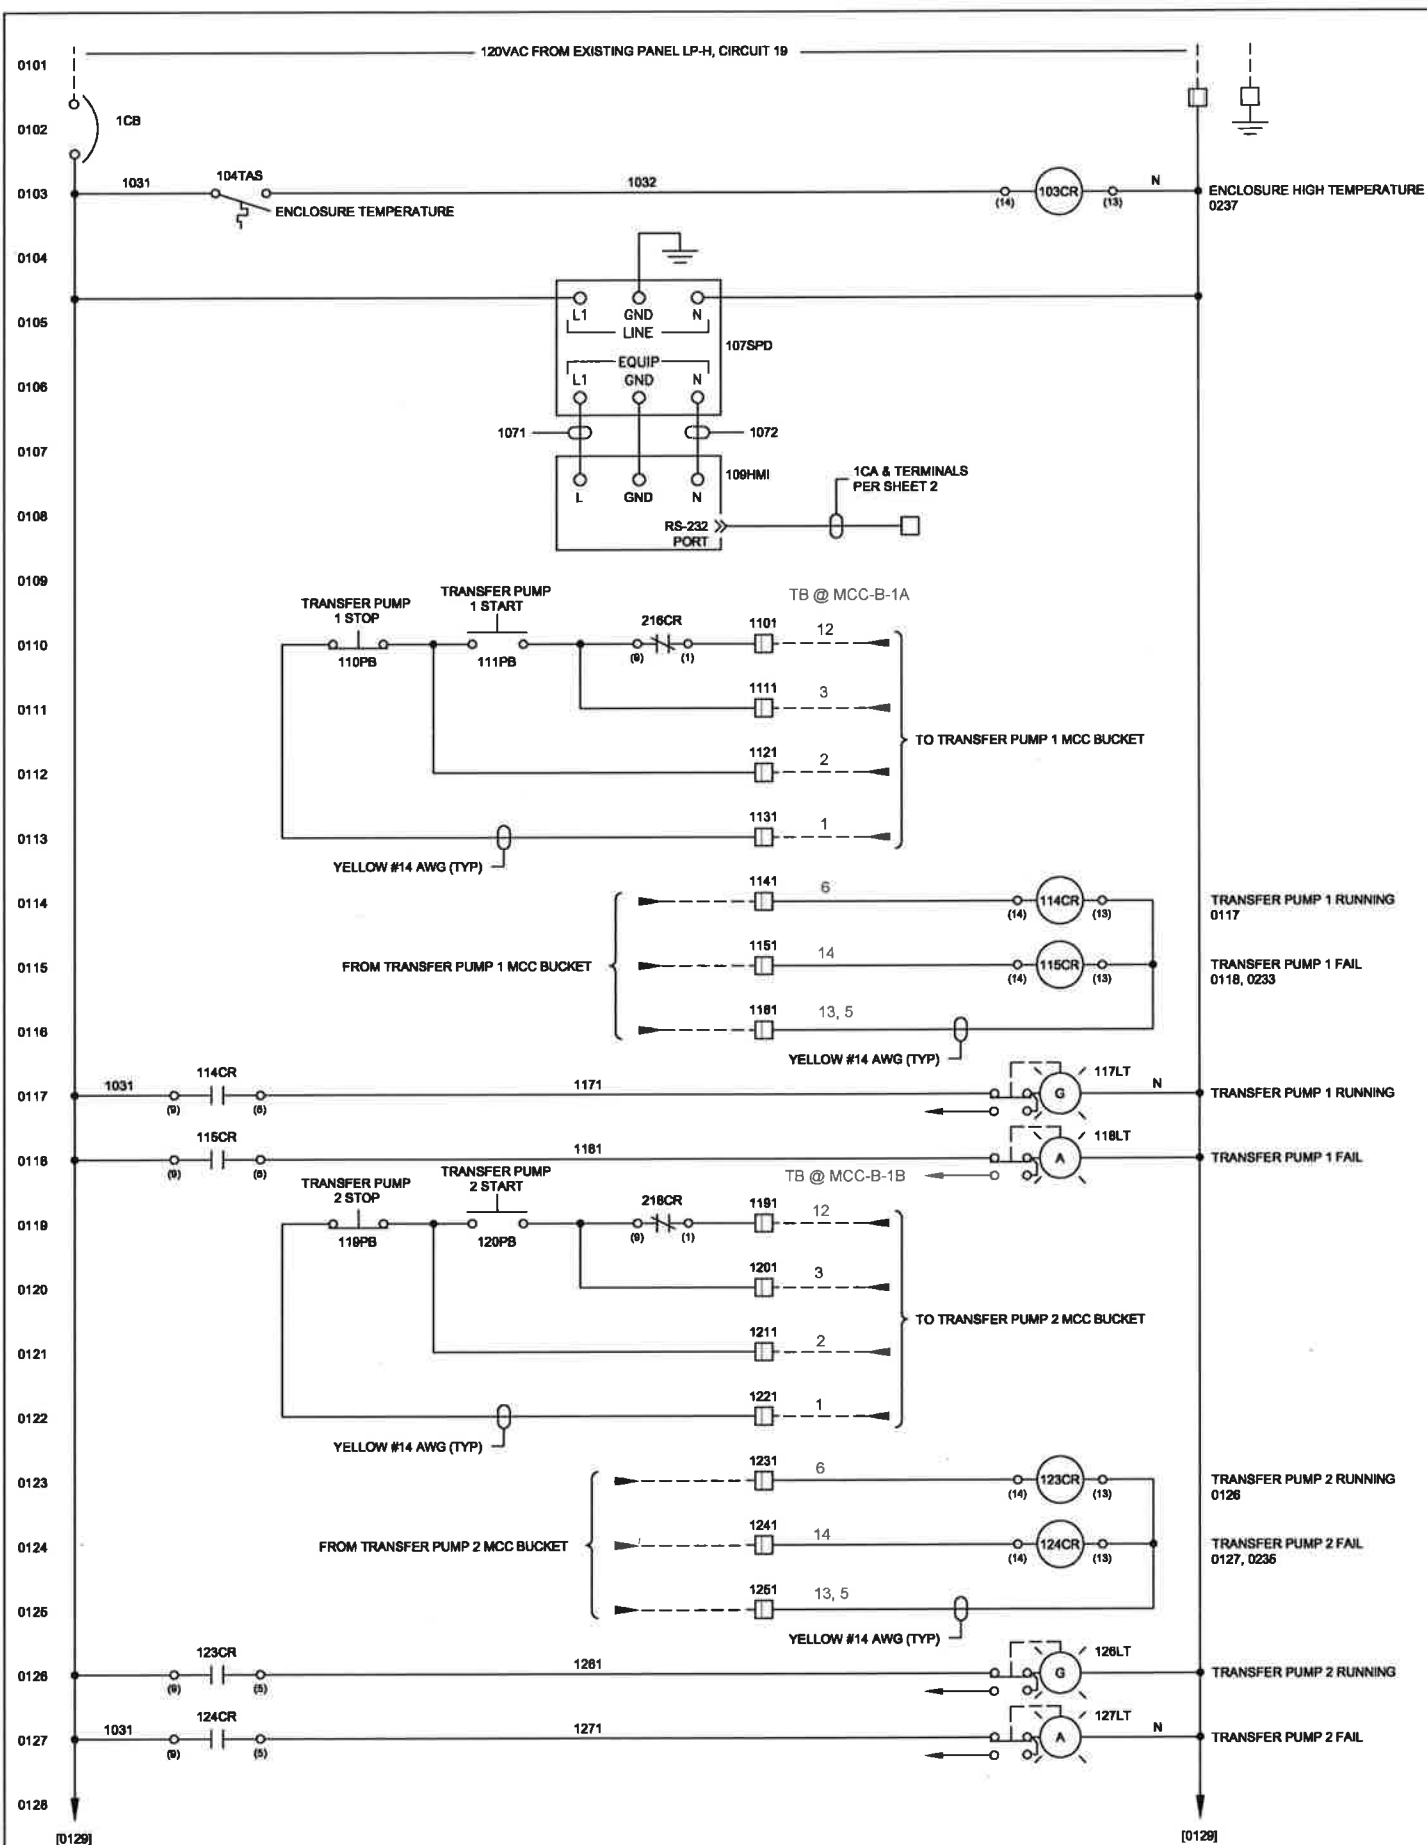

THIS DRAWING CONTAINS INFORMATION PROPRIETARY TO APEX AUTOMATION AND CONTROLS. IT IS SUBMITTED IN CONFIDENCE AND IS TO BE USED SOLELY FOR THE PURPOSE FOR WHICH IT IS FURNISHED AND RETURNED UPON REQUEST. THIS DRAWING AND SUCH INFORMATION IS NOT TO BE REPRODUCED, TRANSMITTED, DISCLOSED, OR USED OTHERWISE IN WHOLE OR IN PART WITHOUT THE WRITTEN AUTHORIZATION OF APEX AUTOMATION AND CONTROLS.

REV	REVISION DESCRIPTION	DRAWN	CHECKED	APP	DATE
0	ORIGINAL ISSUE	ADH	-	-	10/8/2014
A	REVISED PER CUSTOMERS COMMENTS	ADH	-	-	10/21/2014





REV	REVISION DESCRIPTION	DRAWN	CHECKED	APP	DATE



Apex Automation & Controls  
10991 Leadbetter Road Ashland, VA 23005  
(804) - 550 - 1814  
www.apex-automation.com

BY	DATE	WESTERN VIRGINIA WATER AUTHORITY	
DRAWN	ADH	CARVINS COVE WTF CHEMICAL BUILDING 2	
CHECKED	-	SODIUM HYPOCHLORITE CONTROL PANEL	
APP	-	CONTROL WIRING	
SCALE	N/A	SIZE	175-14-100
		SHEET	1 of 2
		REVISION	A



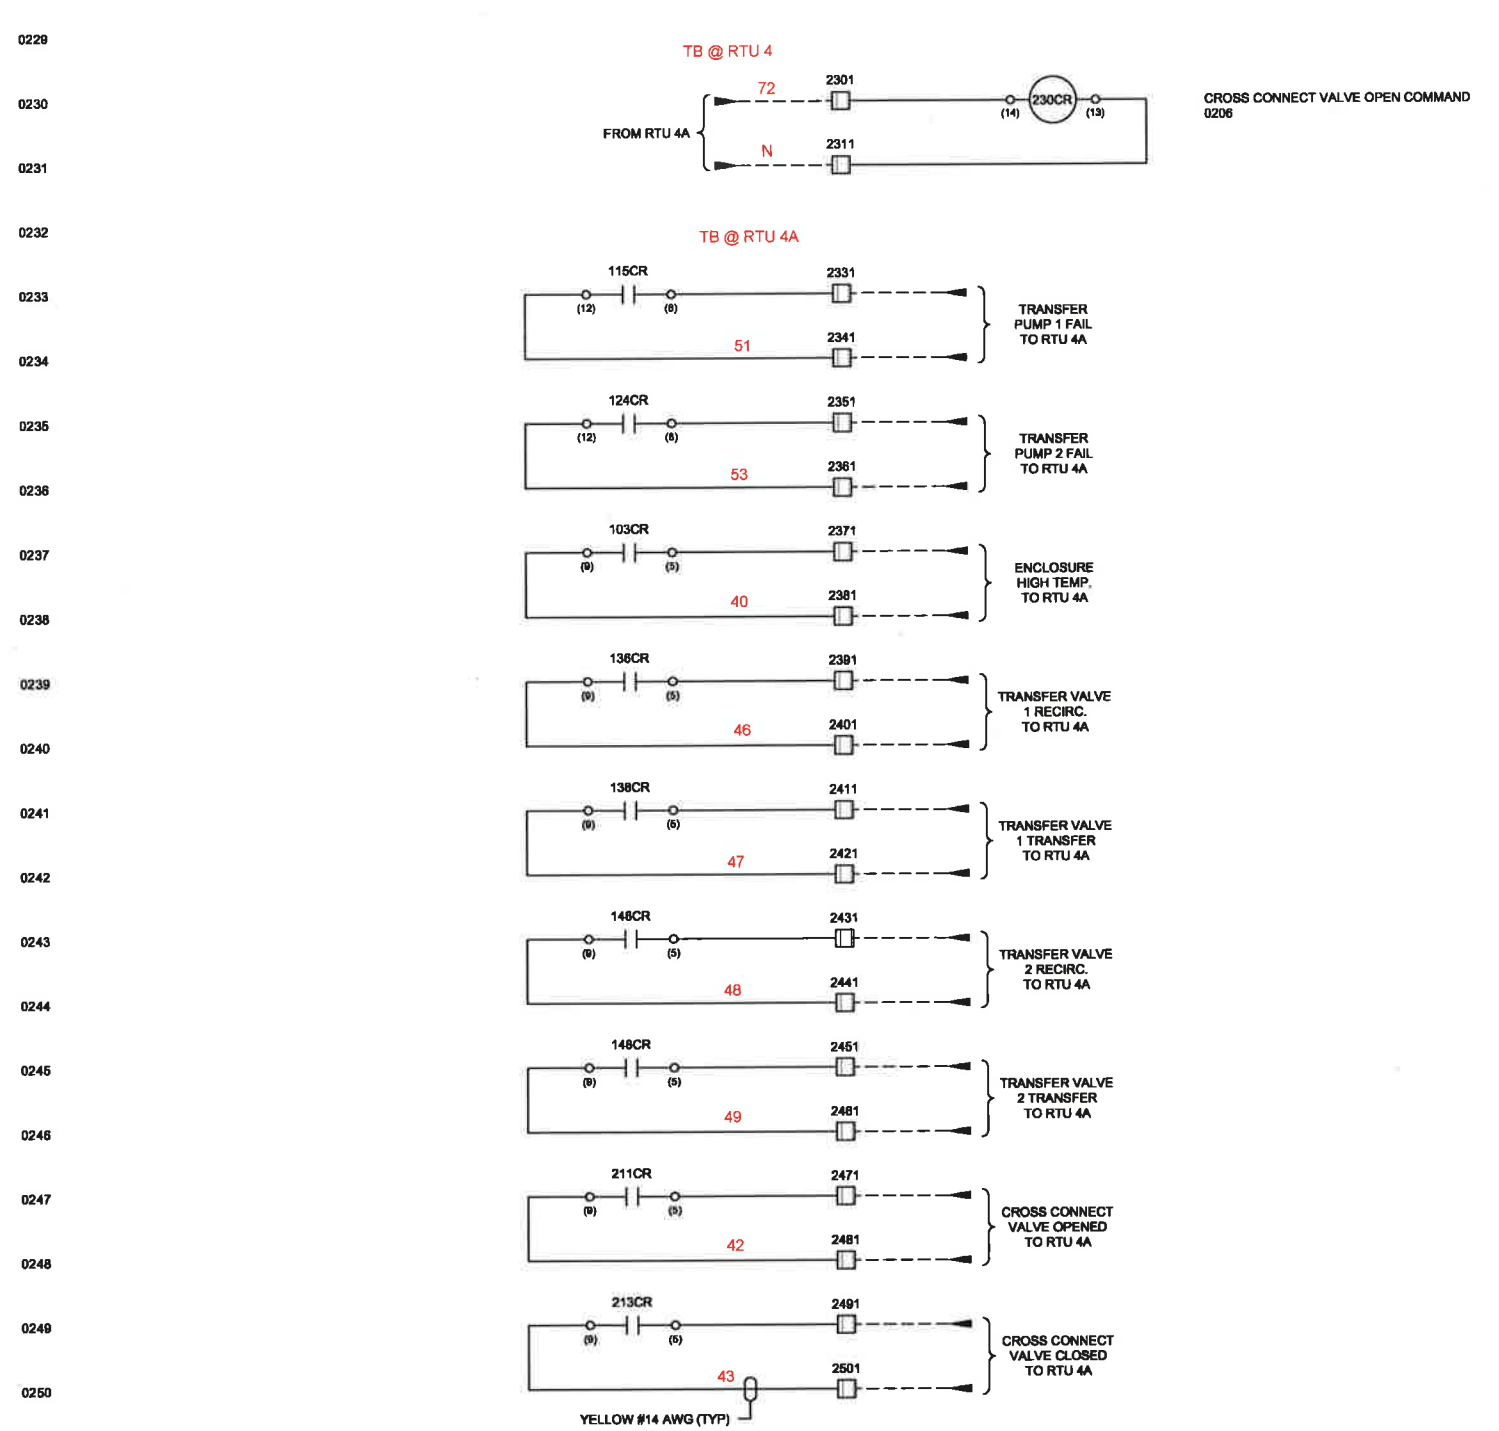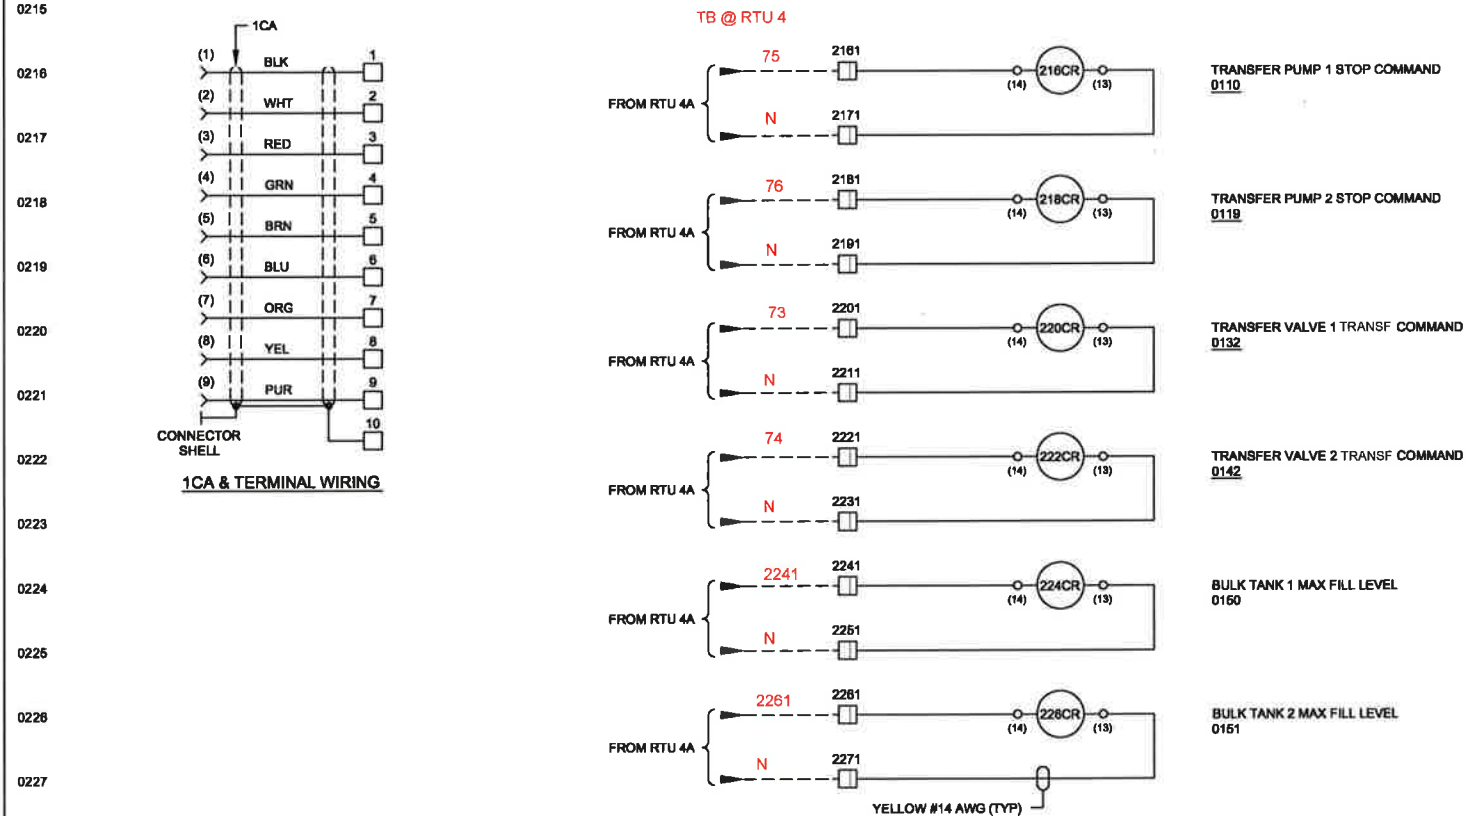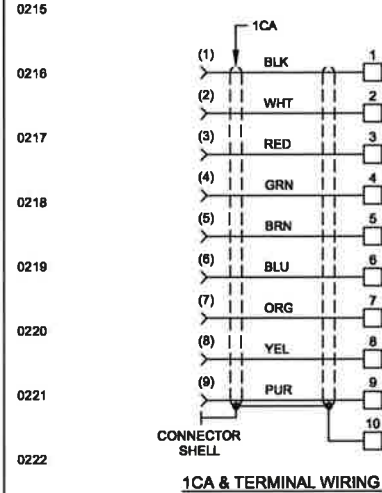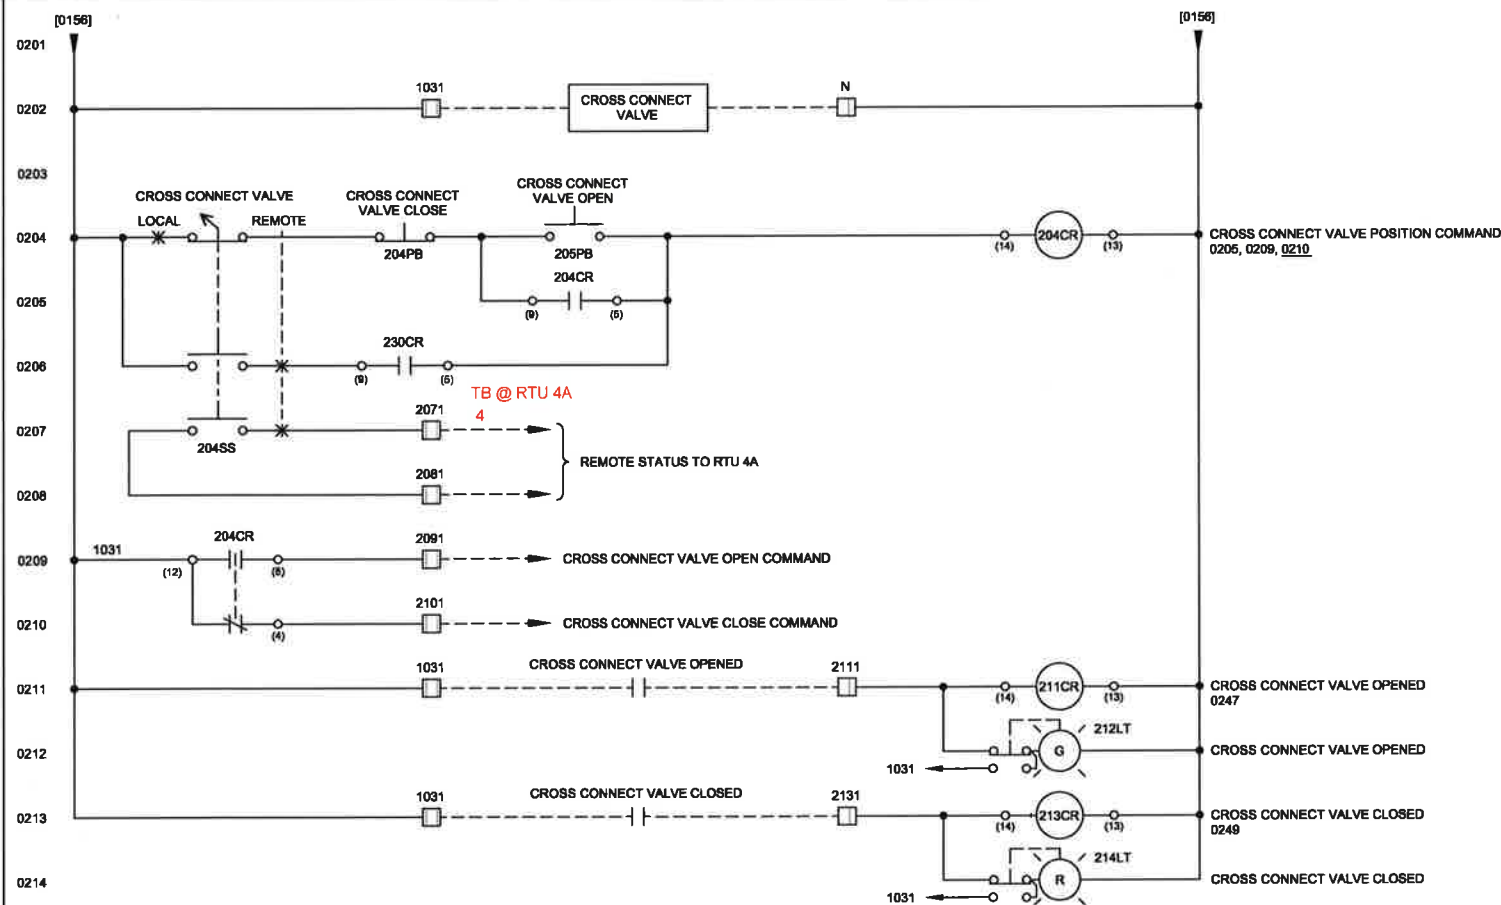

THIS DRAWING CONTAINS INFORMATION PROPRIETARY TO APEX AUTOMATION AND CONTROLS. IT IS SUBMITTED IN CONFIDENCE AND IS TO BE USED SOLELY FOR THE PURPOSE FOR WHICH IT IS FURNISHED AND RETURNED UPON REQUEST. THIS DRAWING AND SUCH INFORMATION IS NOT TO BE REPRODUCED, TRANSMITTED, DISCLOSED, OR USED OTHERWISE IN WHOLE OR IN PART WITHOUT THE WRITTEN AUTHORIZATION OF APEX AUTOMATION AND CONTROLS.

REV	REVISION DESCRIPTION	DRAWN	CHECKED	APP	DATE
0	ORIGINAL ISSUE	ADH			10/8/2014
A	REVISED PER CUSTOMERS COMMENTS	ADH			10/21/2014

REV	REVISION DESCRIPTION	DRAWN	CHECKED	APP	DATE



Apex Automation & Controls  
10991 Leadbetter Road Ashland, VA 23005  
(804) - 550 - 1814  
www.apex-automation.com

BY		DATE	SHEET		REVISION
DRAWN	ADH	10/8/14	1	2	A
CHECKED					
APP					
JOB NO. P14-2128			175-14-100		
REF.			2 of 2		
SCALE N/A			A		

Item	QTY	Symbol	Description	Mfg. & Part Number
1	1		Enclosure, 30 X 30 X 12, SS, NEMA 4X	Saginaw #SCE-30EL3012SS6LP
2	1		Sub-Panel	Saginaw #SCE-30P30
3	1		Dead Front Panel	Saginaw #SCE-DF30EL30LP
4	1		Mounting Foot Kit	Saginaw #SCE-ELMFK4SS
5	1	109HMI	PanelView Plus 6 700	Allen-Bradley #2711P-T7C4A8
6	1	107SPD	Surge Suppressor	Edco #HSP121BT-1RU
7	3	137LT, 147LT, 214LT	Pilot Light, Red LED, Push-to Test	Allen-Bradley #800H-QRTH10R
8	5	117LT, 126LT, 139LT, 149LT, 212LT	Pilot Light, Green LED, Push-to Test	Allen-Bradley #800H-QRTH10G
9	4	118LT, 127LT, 150LT, 151LT	Pilot Light, Amber LED, Push-to Test	Allen-Bradley #800H-QRTH10A
10	5	111PB, 120PB, 133PB, 143PB, 205PB	Pushbutton, Green Flush Head	Allen-Bradley #800H-AR1A
11	5	110PB, 119PB, 132PB, 142PB, 204PB	Pushbutton, Red Flush Head	Allen-Bradley #800H-AR6A
12	1	204SS	Selector Switch,2-Position	Allen-Bradley #800H-HR2B
13	23		Legend Plate, NEMA 4X (engraved as shown)	Allen-Bradley #800H-W500J
14	1	104TAS	Thermostat	Saginaw #SCE-TEMNO
15	1	1CB	Circuit Breaker, 15 AMP	AutomationDirect #WMZT1C15
16	21	All CR's	Relay, 2PDT	Idec #RH2B-ULCAC110-120V
17	21	(for above)	Relay Socket	Idec #SH2B-05
18	116		Terminal Block	Allen-Bradley #1492-J4
19	4		Terminal Block End Barrier	Allen-Bradley #1492-EBJ3
20	11		Terminal Block End Anchor	Allen-Bradley #1492-ERL35
21	2		Terminal Block, Grounding	Allen-Bradley #1492-JG4
22	A/R		DIN Rail, 35mm	Allen-Bradley #199-DR1
23	A/R		DIN Rail, 35mm, Raised	AutomationDirect #DN-R35SAL2-2
24	1		Ground Lug	Blackburn #L35 (or equal)
25	A/R		Wireway with Cover, 1" X 3"	Panduit (or equal)
26	1	1FAN	Fan Heater with Thermostat, 200 Watt	Saginaw #SCE-HF2001A
27	1	2CB	Circuit Breaker, 3 AMP	AutomationDirect #WMZT1C03
28	A/R	1CA	Shielded Cable, #24 AWG, 9-Conductor	Belden #9934 (or equal)
29	1		Connector, DB-9, Female	Purchase
30				

THIS DRAWING CONTAINS INFORMATION PROPRIETARY TO APEX AUTOMATION AND CONTROLS. IT IS SUBMITTED IN CONFIDENCE AND IS TO BE USED SOLELY FOR THE PURPOSE FOR WHICH IT IS FURNISHED AND RETURNED UPON REQUEST. THIS DRAWING AND SUCH INFORMATION IS NOT TO BE REPRODUCED, TRANSMITTED, DISCLOSED, OR USED OTHERWISE IN WHOLE OR IN PART WITHOUT THE WRITTEN AUTHORIZATION OF APEX AUTOMATION AND CONTROLS.

REV	REVISION DESCRIPTION	DRAWN	CHECKED	APP	DATE
0	ORIGINAL ISSUE	ADH	--	--	10/9/2014
A	REVISED PER CUSTOMERS COMMENTS	ADH	--	--	10/21/2014

REV	REVISION DESCRIPTION	DRAWN	CHECKED	APP	DATE




Apex Automation & Controls  
10991 Leadbetter Road Ashland, VA 23005  
(804) - 550 - 1814  
www.apex-automation.com


	BY	DATE
DRAWN	ADH	10/9/14
CHECKED	--	--
APP	--	--
JOB# JOB NO.	P14-2129	
REF.		
SCALE	N/A	

WESTERN VIRGINIA WATER AUTHORITY			
CARVINS COVE WTF CHEMICAL BUILDING 2			
SODIUM HYPOCHLORITE CONTROL PANEL			
MATERIALS LIST			
SIZE	D	DWG. NO.	175-14-200
SHEET	1	of	1
REVISION	A		



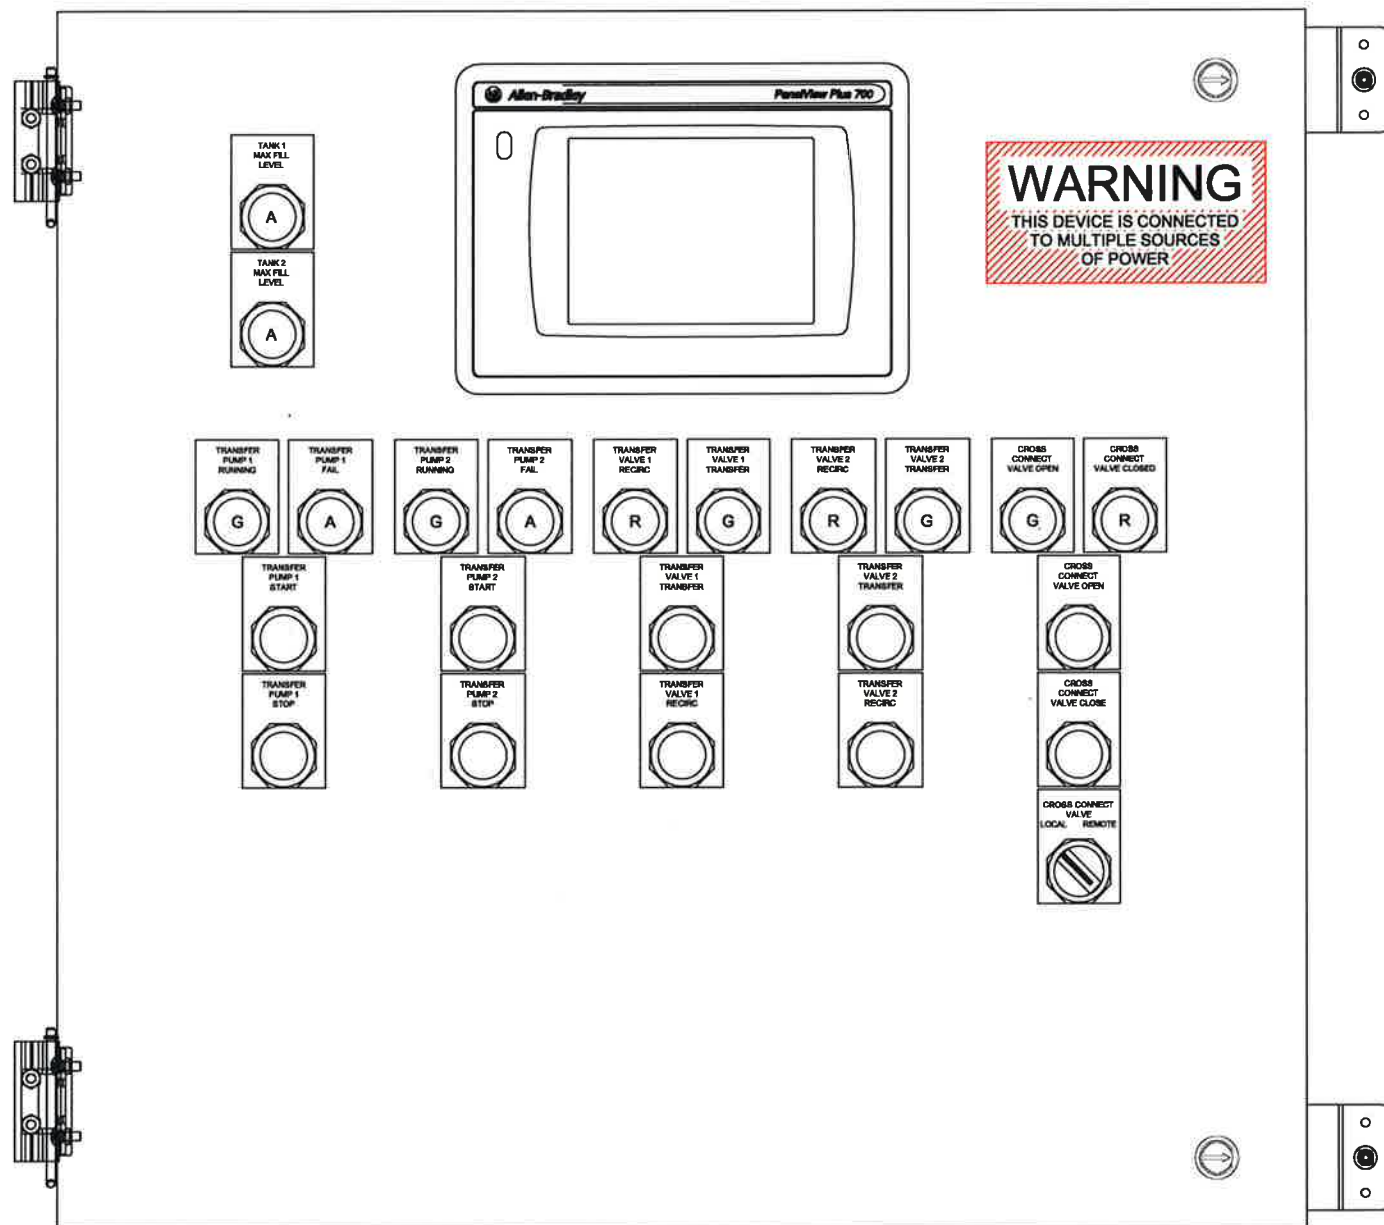

DEAD FRONT PANEL LAYOUT

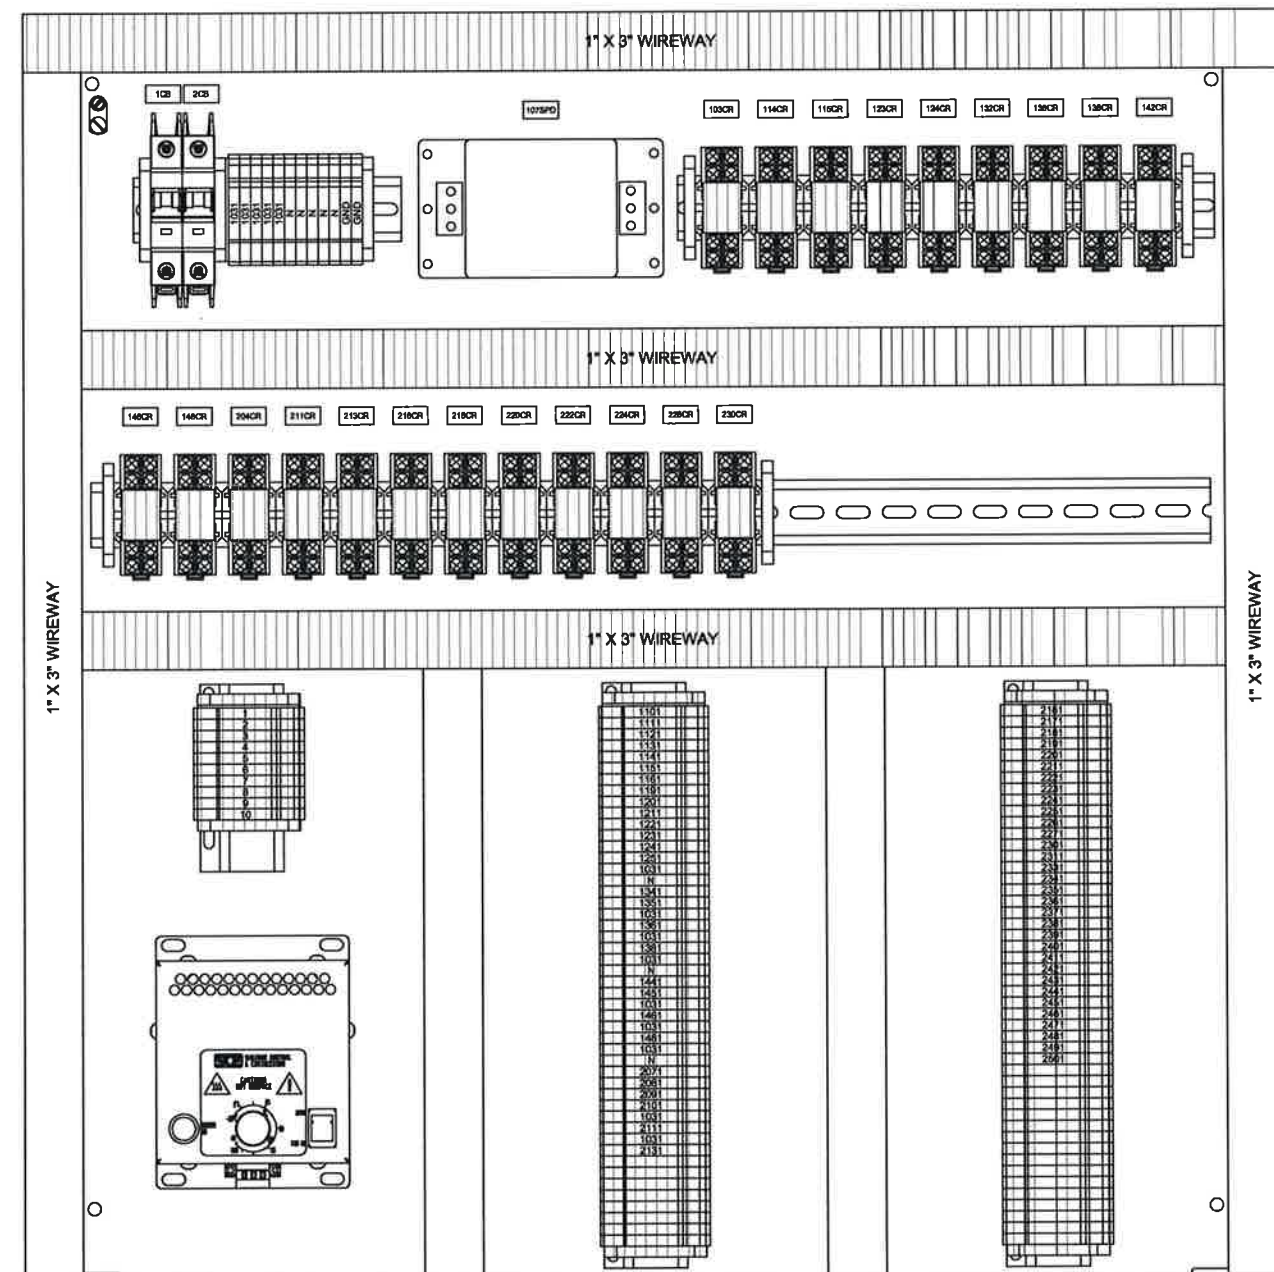

SUB-PANEL LAYOUT

THIS DRAWING CONTAINS INFORMATION PROPRIETARY TO APEX AUTOMATION AND CONTROLS. IT IS SUBMITTED IN CONFIDENCE AND IS TO BE USED SOLELY FOR THE PURPOSE FOR WHICH IT IS FURNISHED AND RETURNED UPON REQUEST. THIS DRAWING AND SUCH INFORMATION IS NOT TO BE REPRODUCED, TRANSMITTED, DISCLOSED, OR USED OTHERWISE IN WHOLE OR IN PART WITHOUT THE WRITTEN AUTHORIZATION OF APEX AUTOMATION AND CONTROLS.

REV	REVISION DESCRIPTION	DRAWN	CHECKED	APP	DATE
0	ORIGINAL ISSUE	ADH	--	--	10/8/2014
A	REVISED PER CUSTOMERS COMMENTS	ADH	--	--	10/21/2014

REV	REVISION DESCRIPTION	DRAWN	CHECKED	APP	DATE



Apex Automation & Controls  
10991 Leadbetter Road Ashland, VA 23005  
(804) - 550 - 1814  
www.apex-automation.com

BY	DATE
ADH	10/8/14
CHECKED	--
APP	--
JOB NO.	P14-2129
REF.	
SCALE	N/A

WESTERN VIRGINIA WATER AUTHORITY			
CARVINS COVE WTF CHEMICAL BUILDING 2			
SODIUM HYPOCHLORITE CONTROL PANEL			
DEAD FRONT & SUB-PANEL LAYOUTS			
SIZE	D	175-14-201	SHEET
DWG. NO.			2 of 2
REVISION			A