


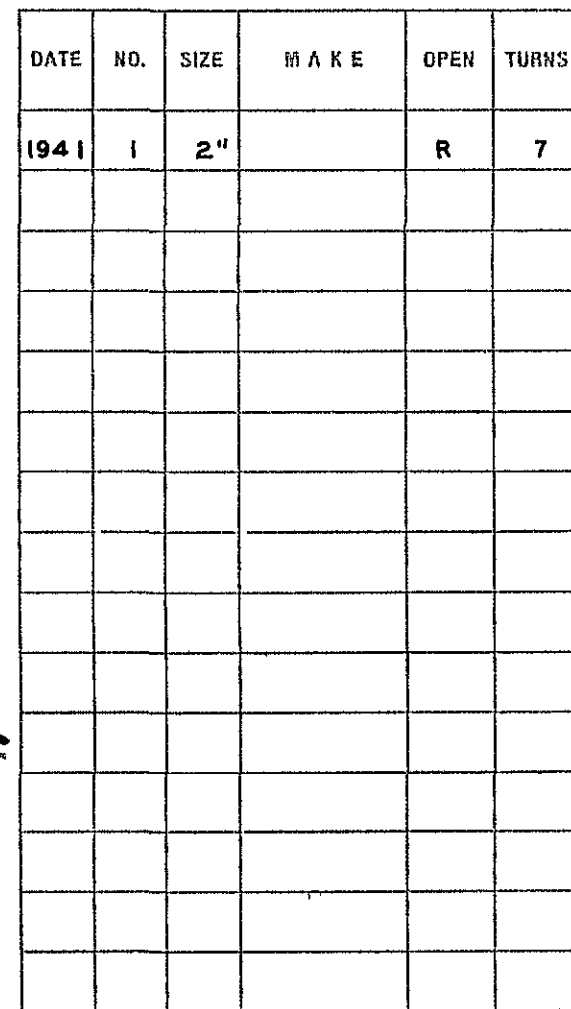

CITY OF ROANOKE—WATER DEP'T	
VALVE DIAGRAM	
CAROLINA AVE. &	
CASSELL LANE	
S. W.	
SEC. MAP	108
DATE	PAGE NO S.W.257

10/7/42 - J.H.V.
12/29/42 C.E.H