


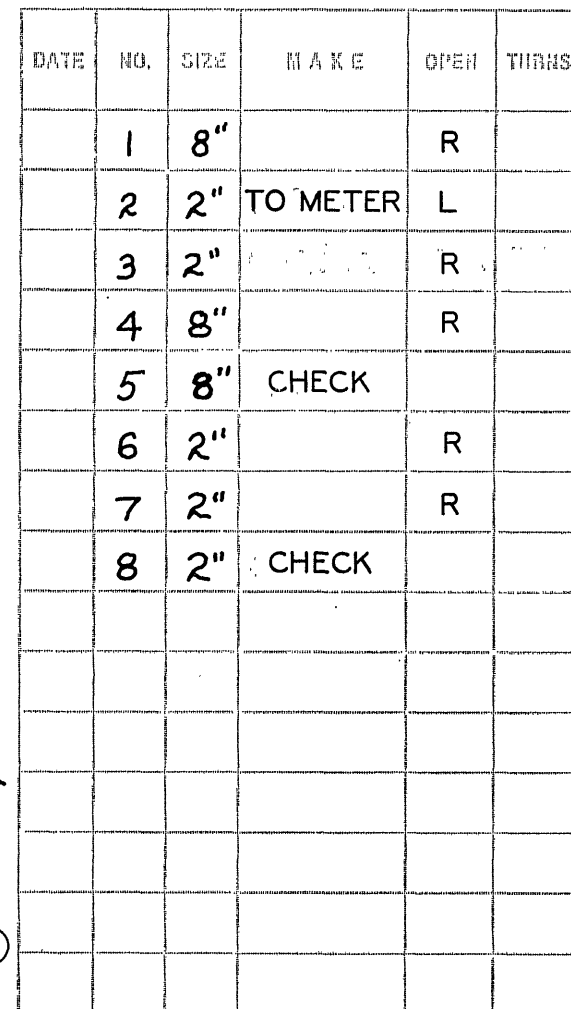

updated info 6/2005:
pump pressure tank in place
still in good condition
but out of service (abandoned)

Page

Account