
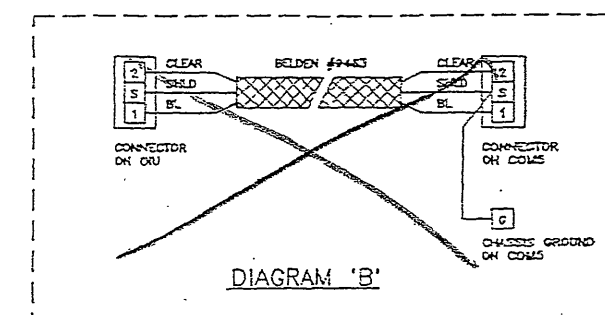
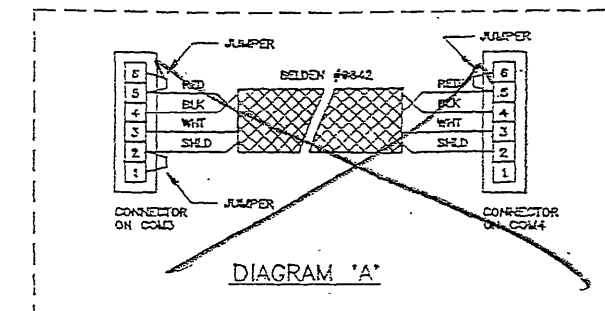
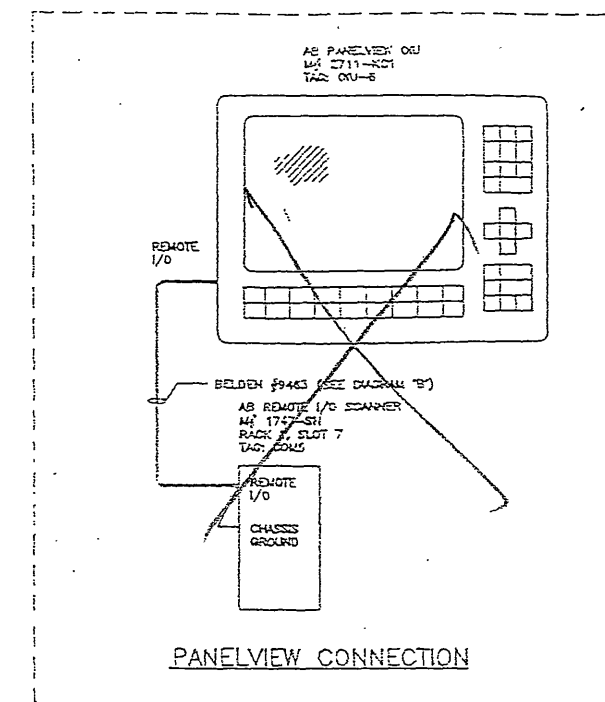


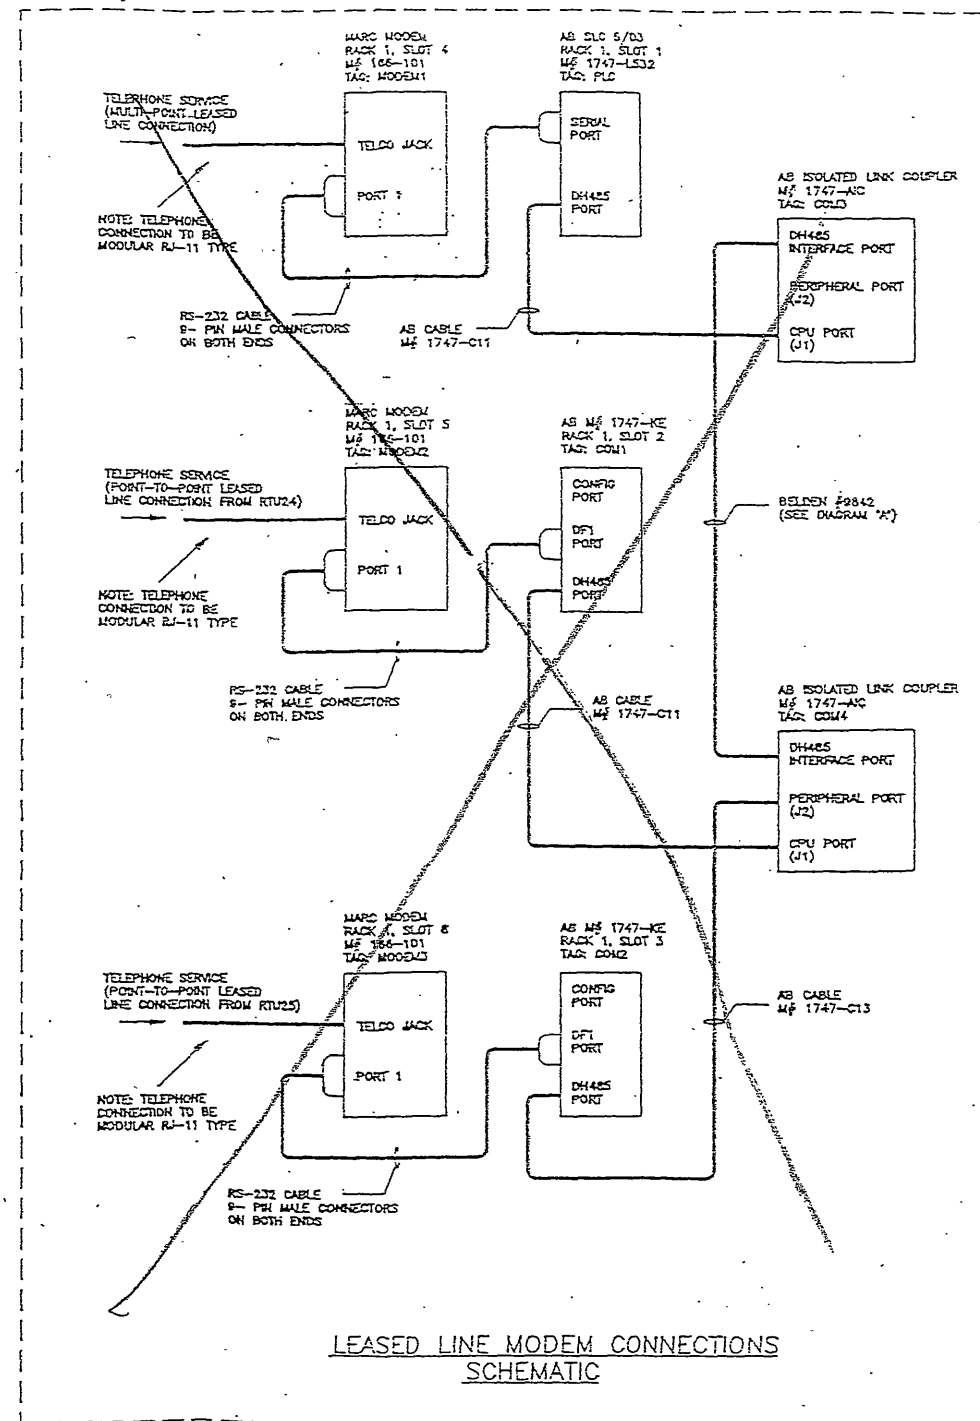

AS BUILT

DRAWINGS

REVISION NOTE
1) REVISED PER MEETING OF 1/16/94.

TO: [redacted]	FROM: [redacted]	CITY OF ROANOKE, VA - CARYS COVE PH 1		
DATE: [redacted]	TIME: [redacted]	RTN 7 WOOD DUCK CRYSTAL SPRING PUMP		
[redacted]		[redacted]		
TO: [redacted]	FROM: [redacted]	DATE: 12/15/94	TIME: [redacted]	[redacted]
TO: [redacted]	FROM: [redacted]	DATE: [redacted]	TIME: [redacted]	[redacted]
TO: [redacted]	FROM: [redacted]	DATE: 10/15/94	TIME: [redacted]	[redacted]
TO: [redacted]	FROM: [redacted]	DATE: [redacted]	TIME: [redacted]	[redacted]
TO: [redacted]	FROM: [redacted]	DATE: 4/26/1993	TIME: [redacted]	[redacted]
TO: [redacted]	FROM: [redacted]	DATE: [redacted]	TIME: [redacted]	[redacted]