
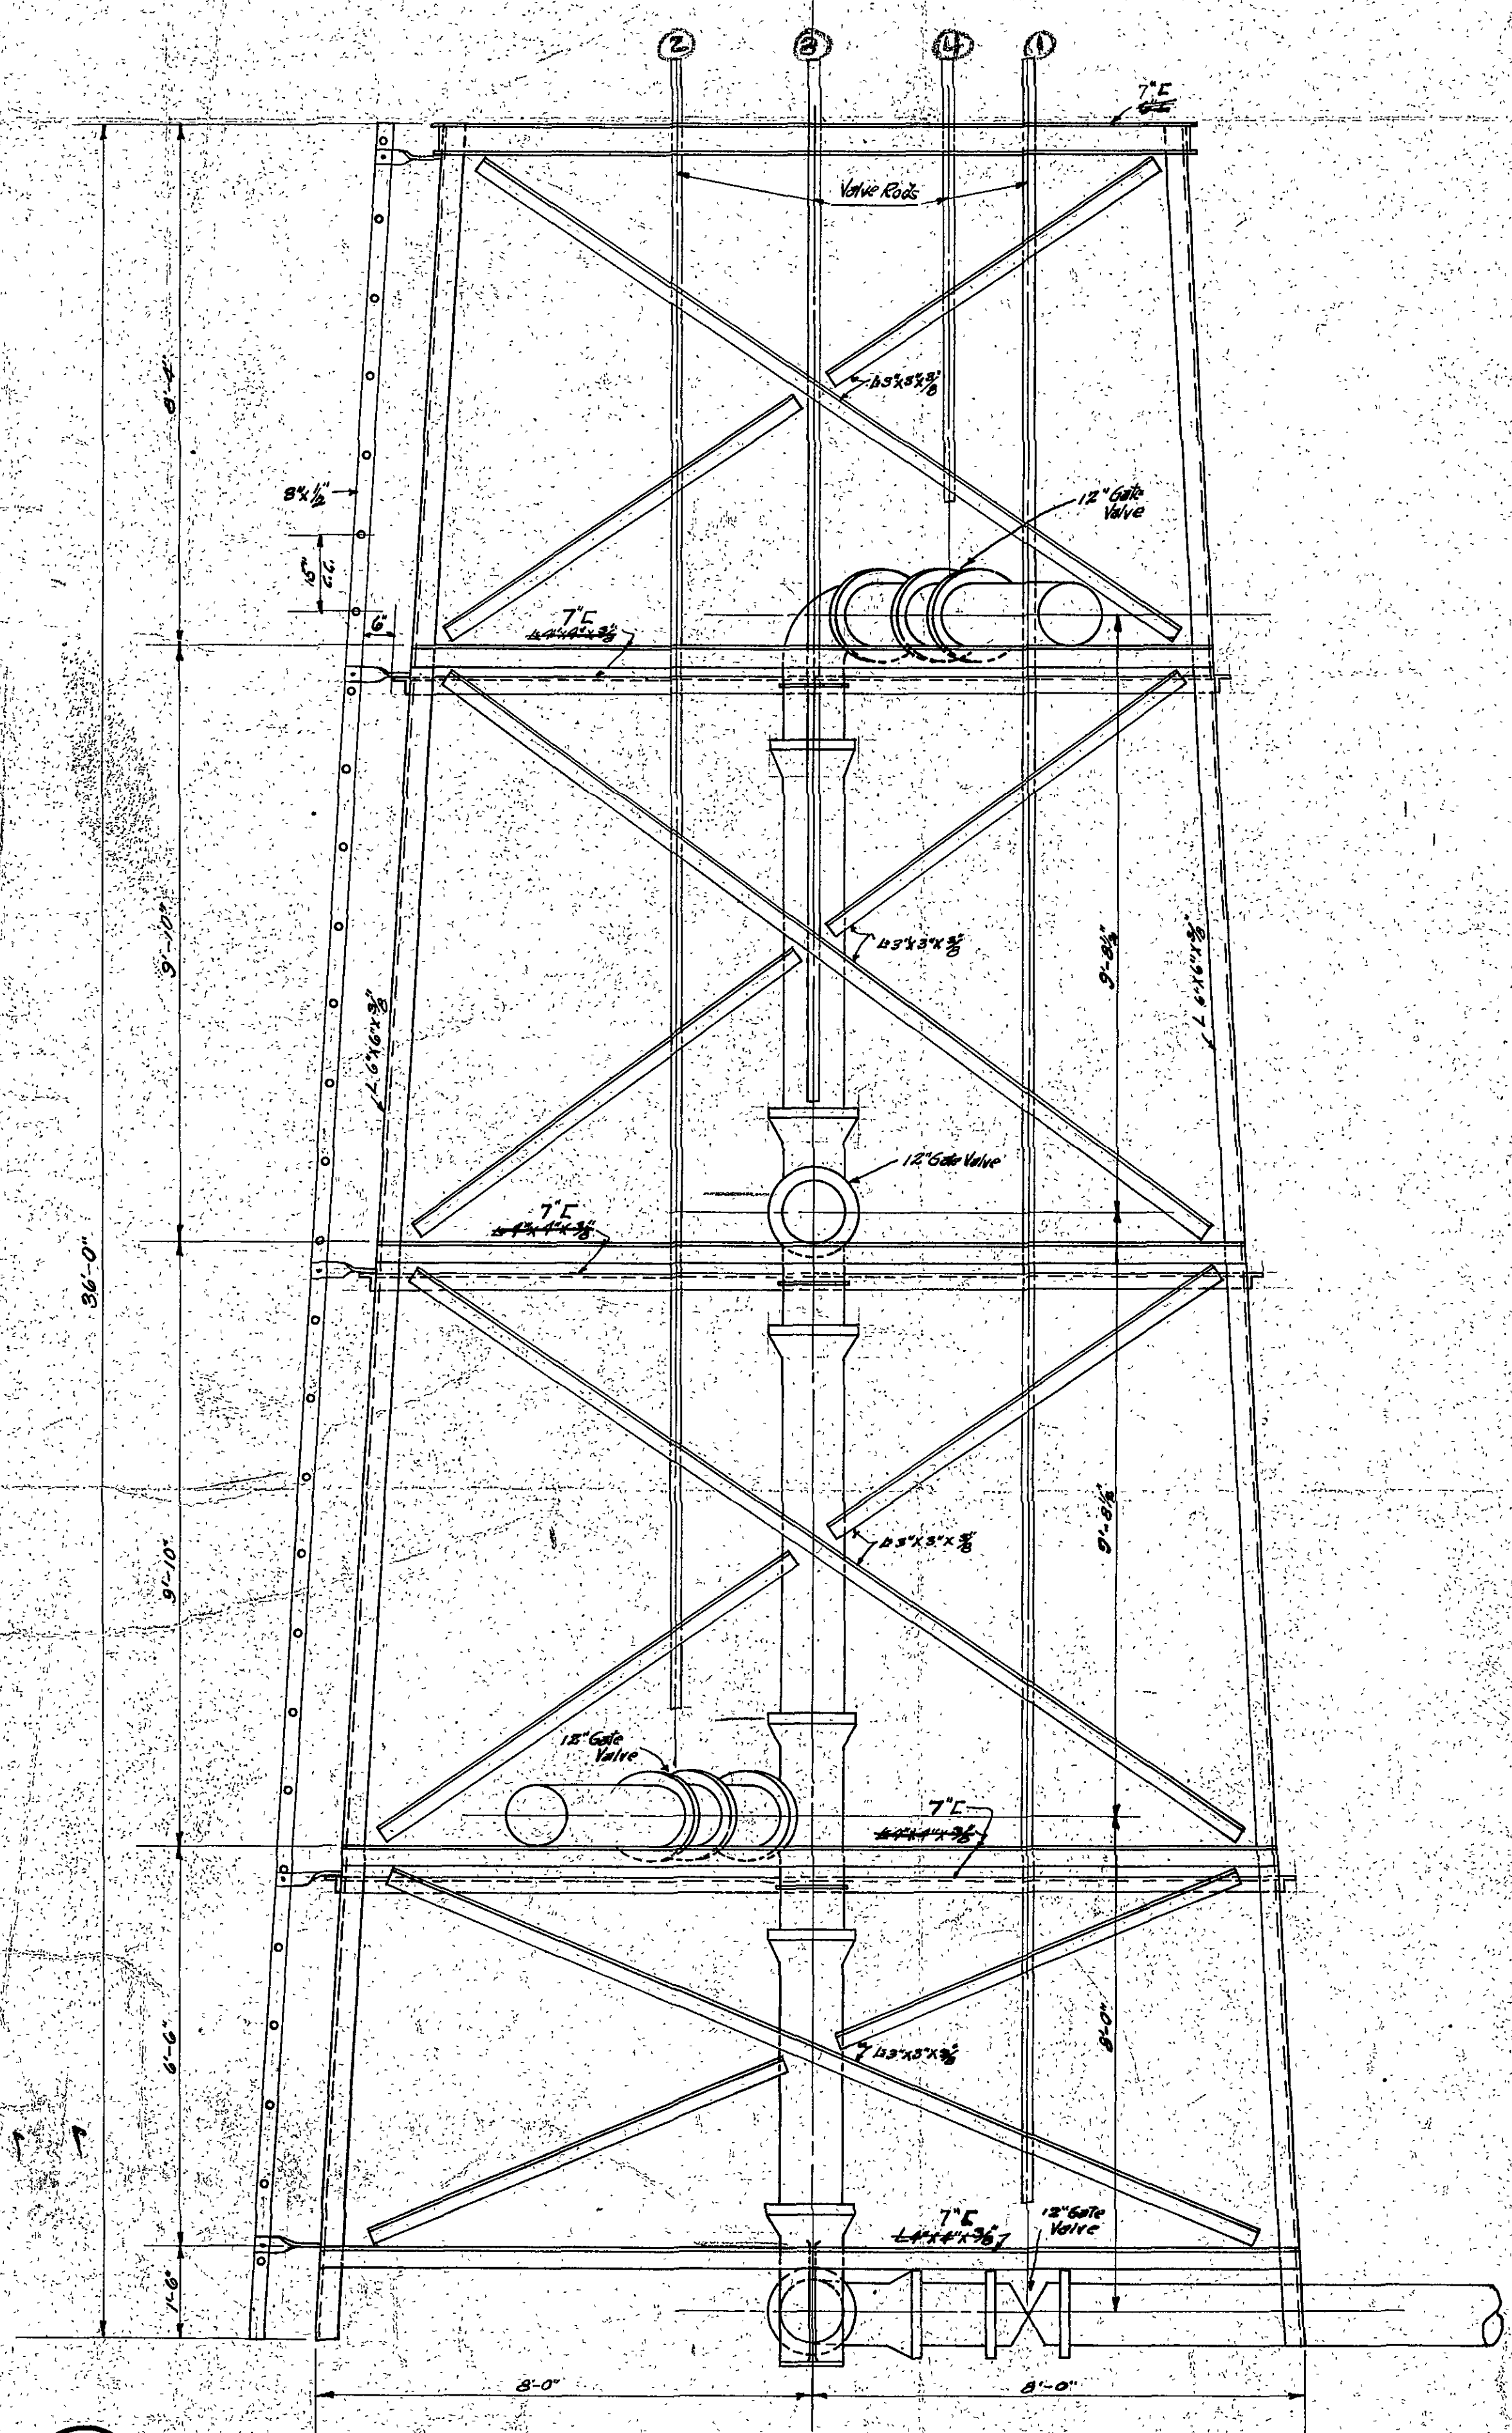


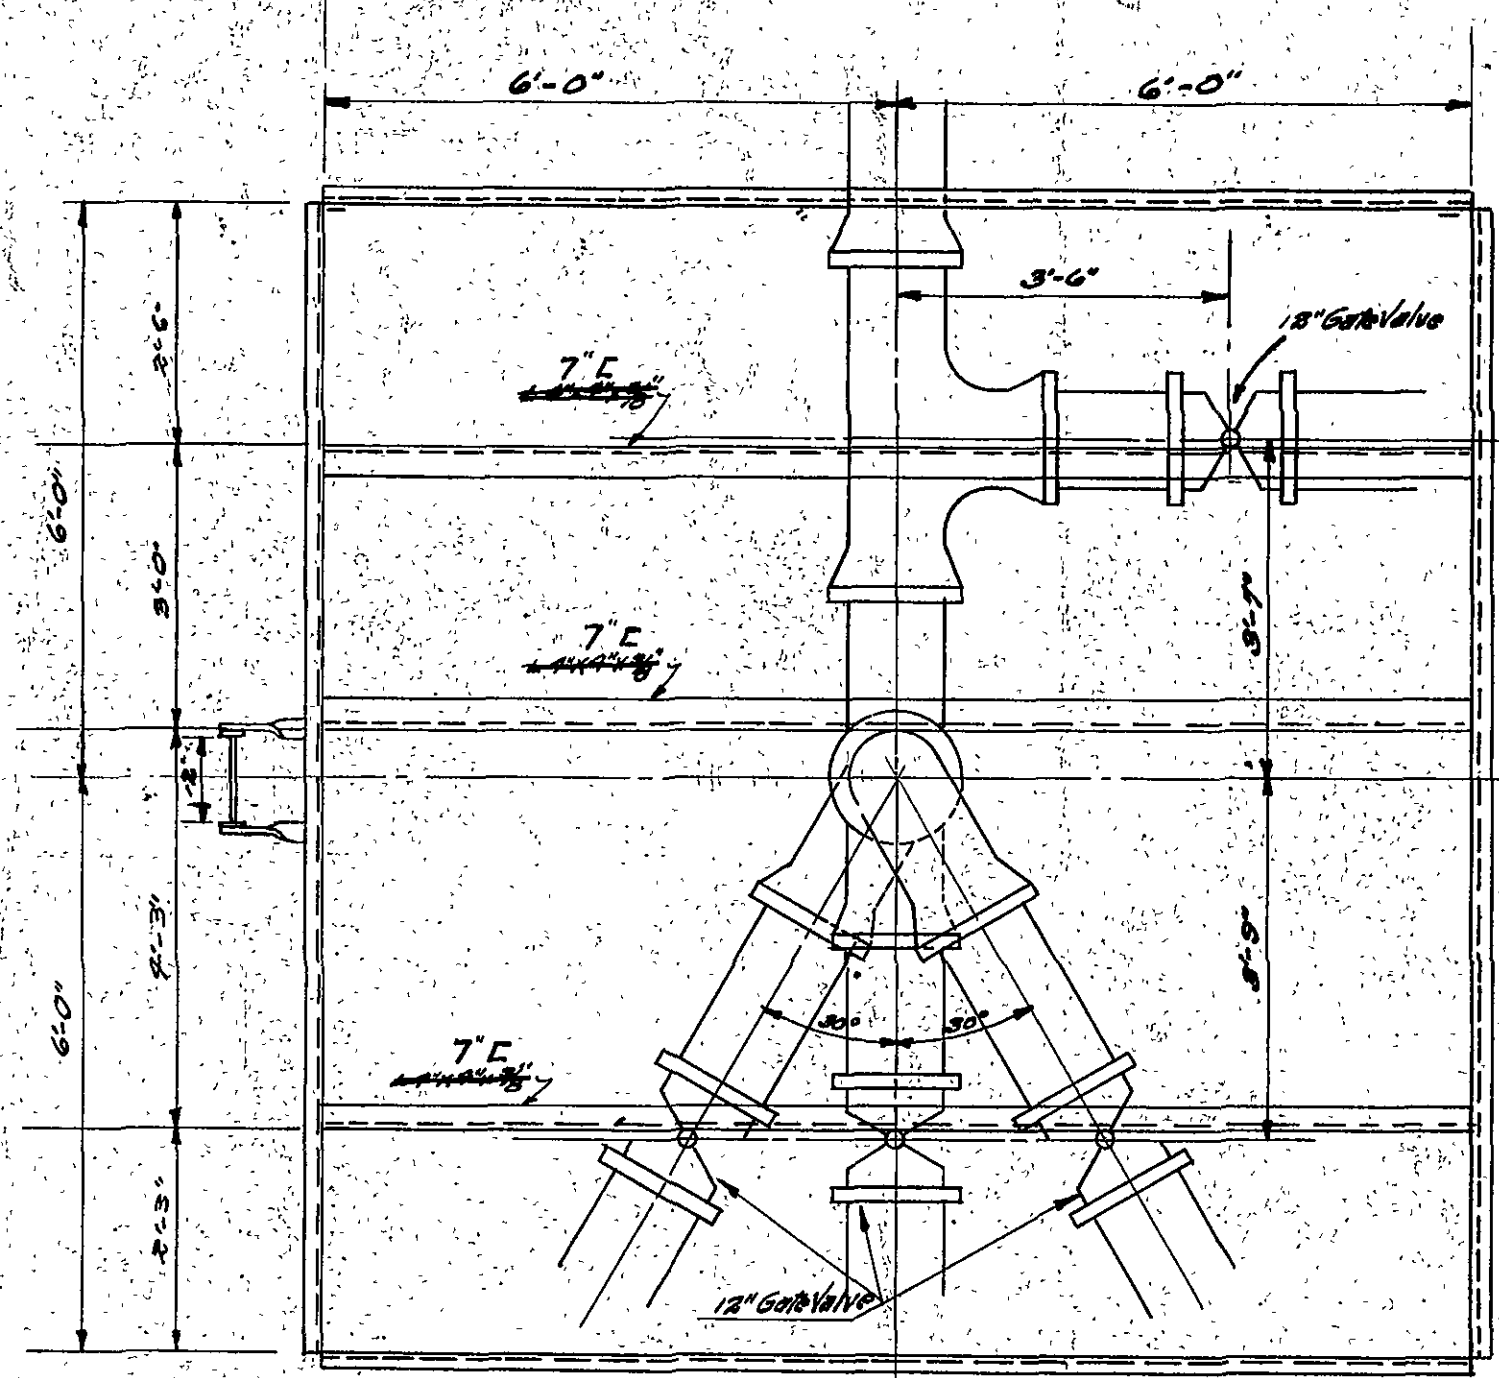

18' level @ x-
 10' level @ x-
 1.6' level @ x-
 12" Riser Pipe in
 27' Tower Supplying Tunnel
 as built

**PROPOSED INTAKE TOWER
 AT TUNNEL**
 (at Beaver Dam to go to Falling Creek)

ROANOKE WATER WORKS CO.
 ROANOKE, VIRGINIA,
 SCALE 1/2" = 1'
 DRAWN BY
 TRACED BY
 Revised 8/10/55 R.H.R.
 Approved