



Intake Stack
at Felling Creek
Dam was built.
(from Vinton Co.)

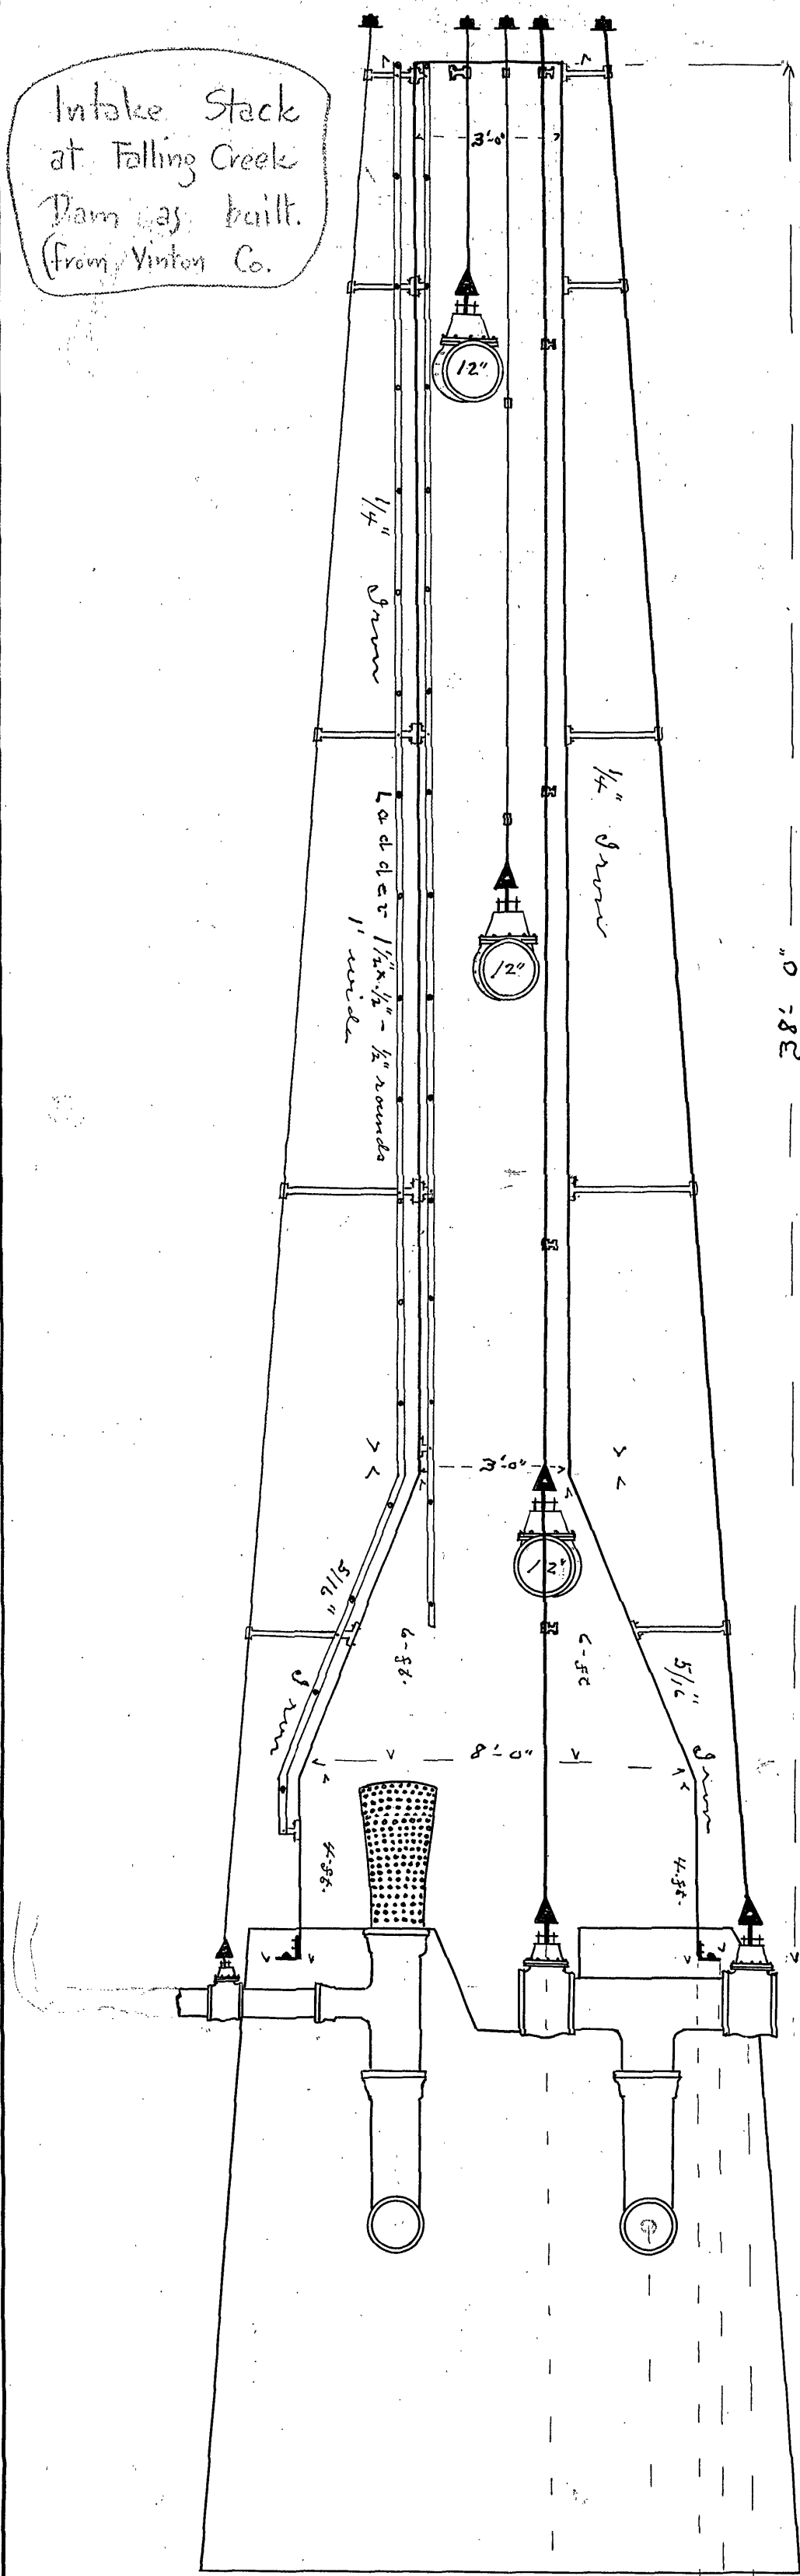

Projection of Middle Section
— On Vertical Plane —

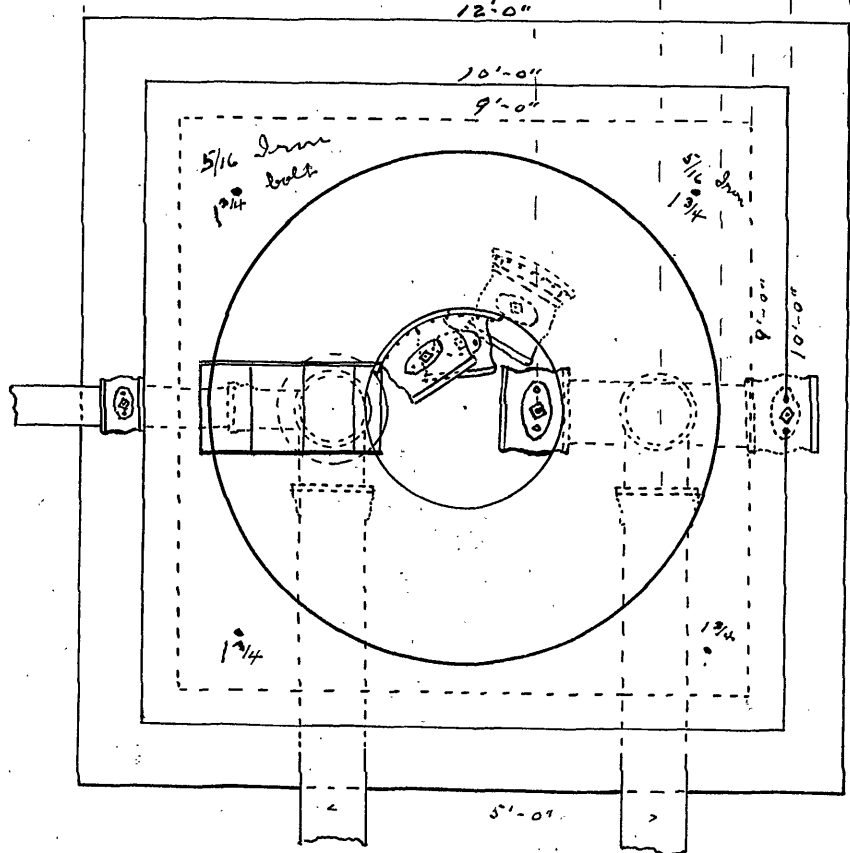

Projection On Horizontal Plane

Note: This tracing secured from Mr. C.S.
Markley of Salem Va. (Son of C. M. Markley) May 10, 1934.
By Mr. H. J. Adams of Whitman Requa & Smith of
Baltimore Md. H. M. Harris 5-16-34.

PROPOSED INTAKE
V-RWCO

F3-D6-S2
68

Scale 1"=3'

B.R.W.