
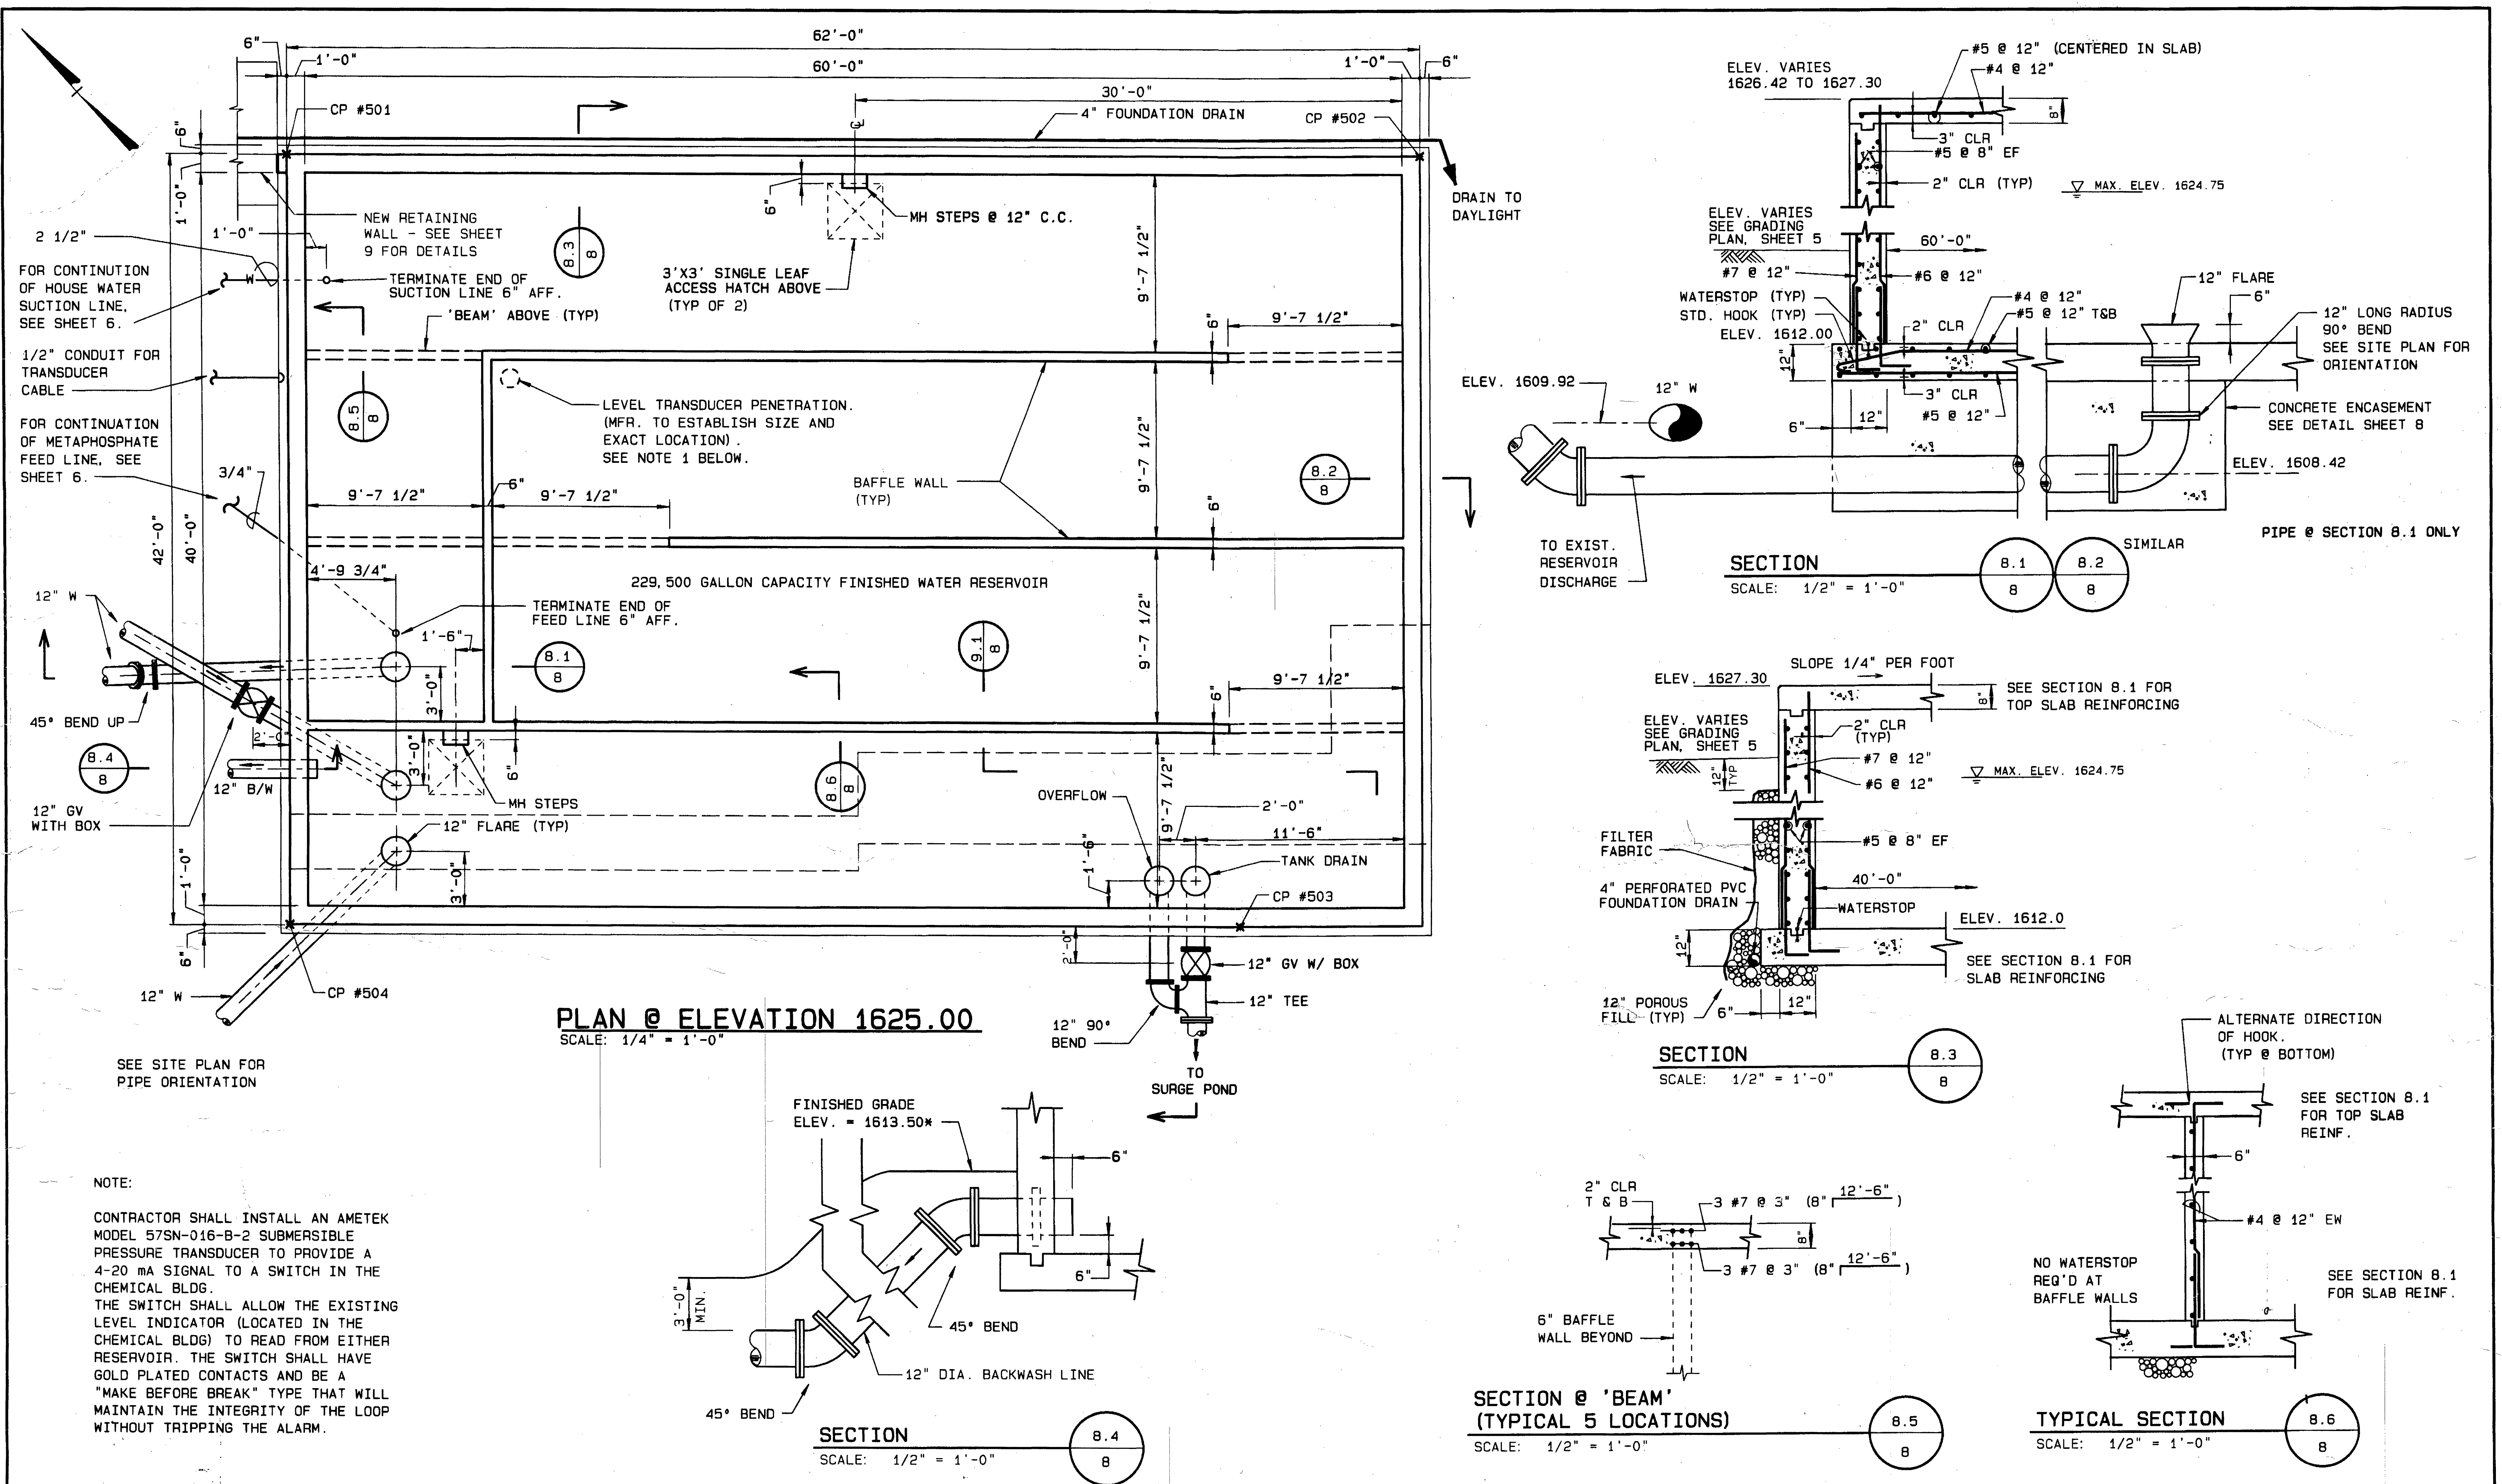


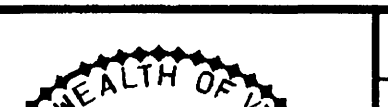

 Mattern & Craig CONSULTING ENGINEERS - SURVEYORS	DESIGNED: RWB		REV.	DATE	DESCRIPTION	BY	APP.	DATE	FALLING CREEK FINISHED WATER RESERVOIR CITY OF ROANOKE, VIRGINIA NEW RESERVOIR - PLAN AND SECTIONS	SHEET 8
	DRAWN: FMP			8-9-94	RECORD DRAWING	ASB	SwH	MAY 1993 COMM. 1249		
	CHECKED: SAC									