



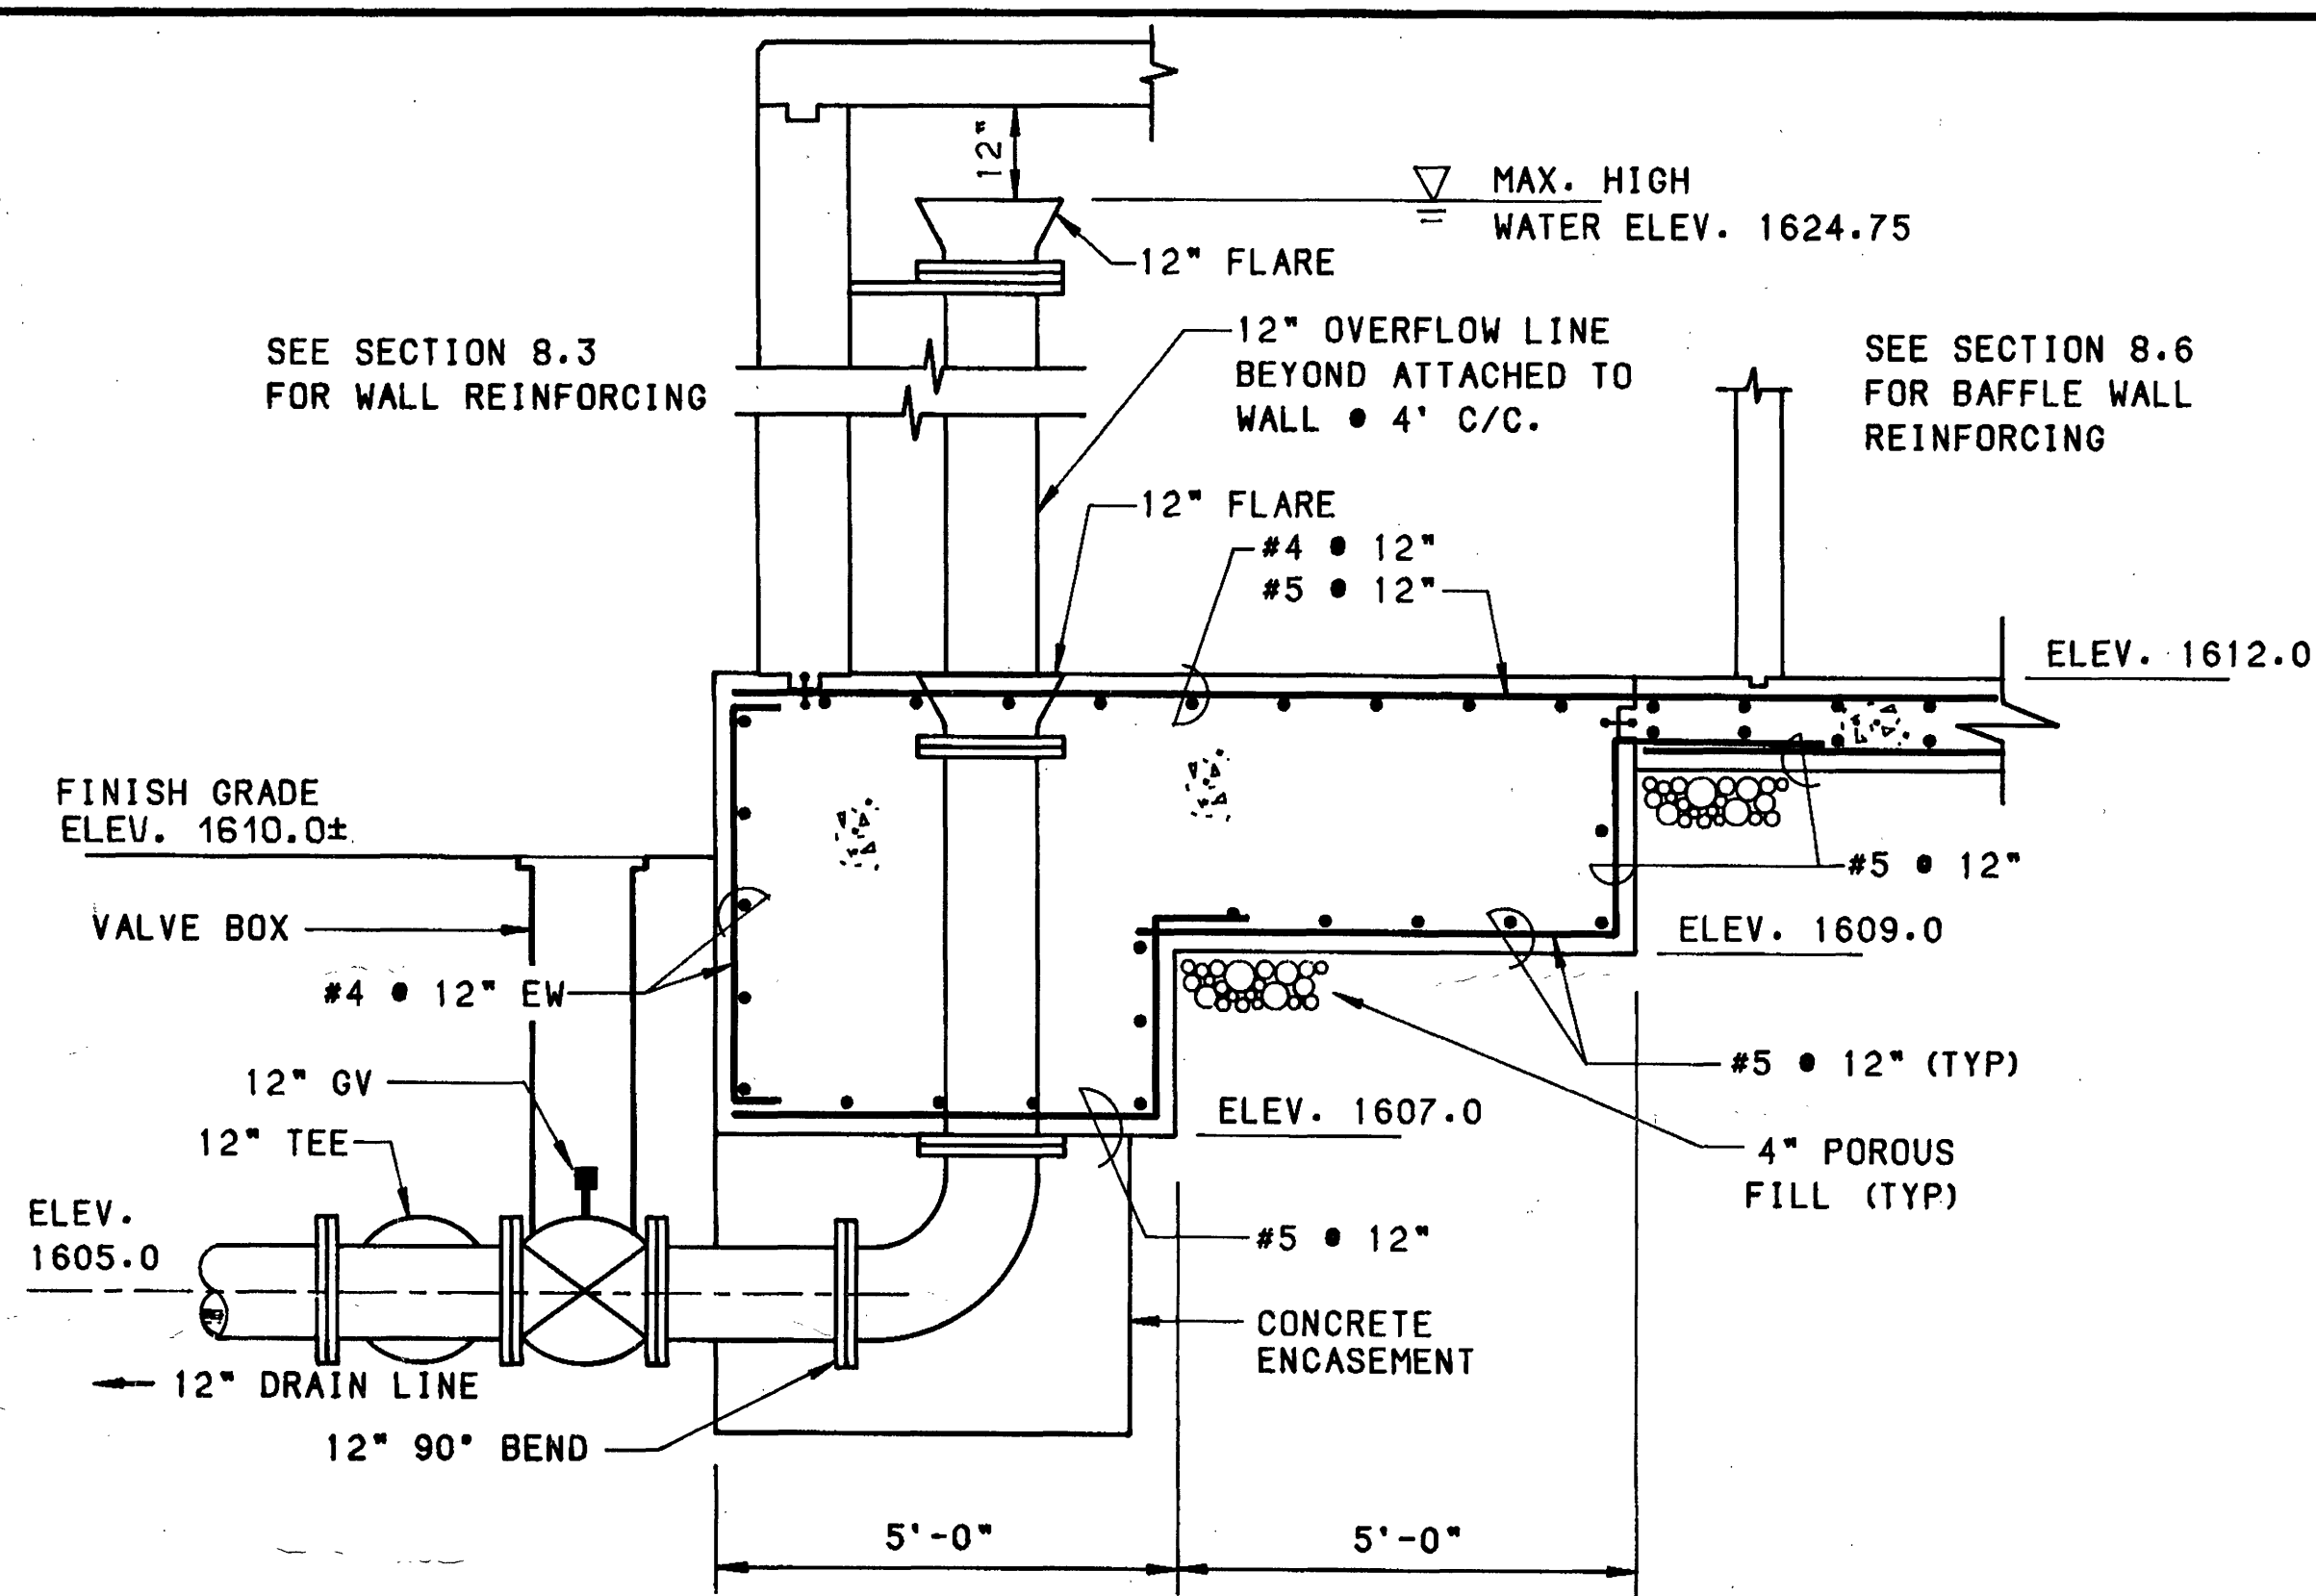


SECTION 9.1
SCALE: 1/2" = 1'-0"

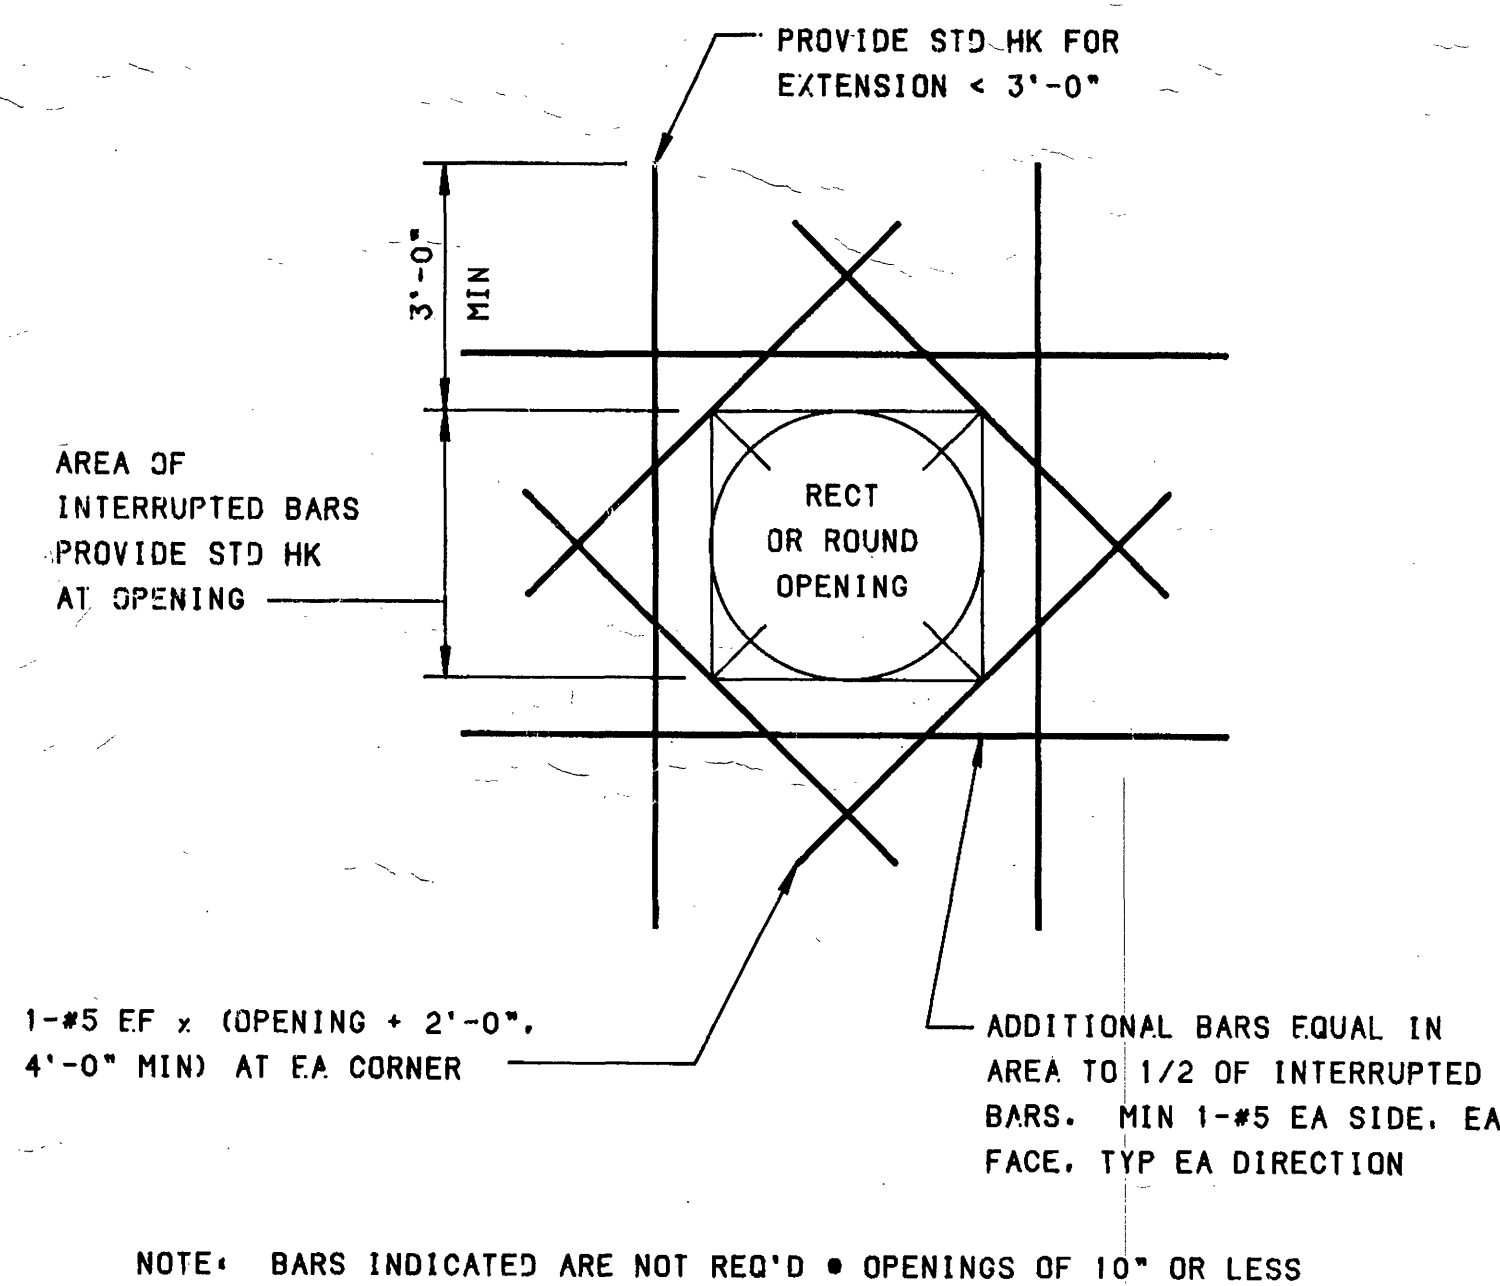


TYPICAL WALL AND SLAB
OPENING DETAIL

NOT TO SCALE

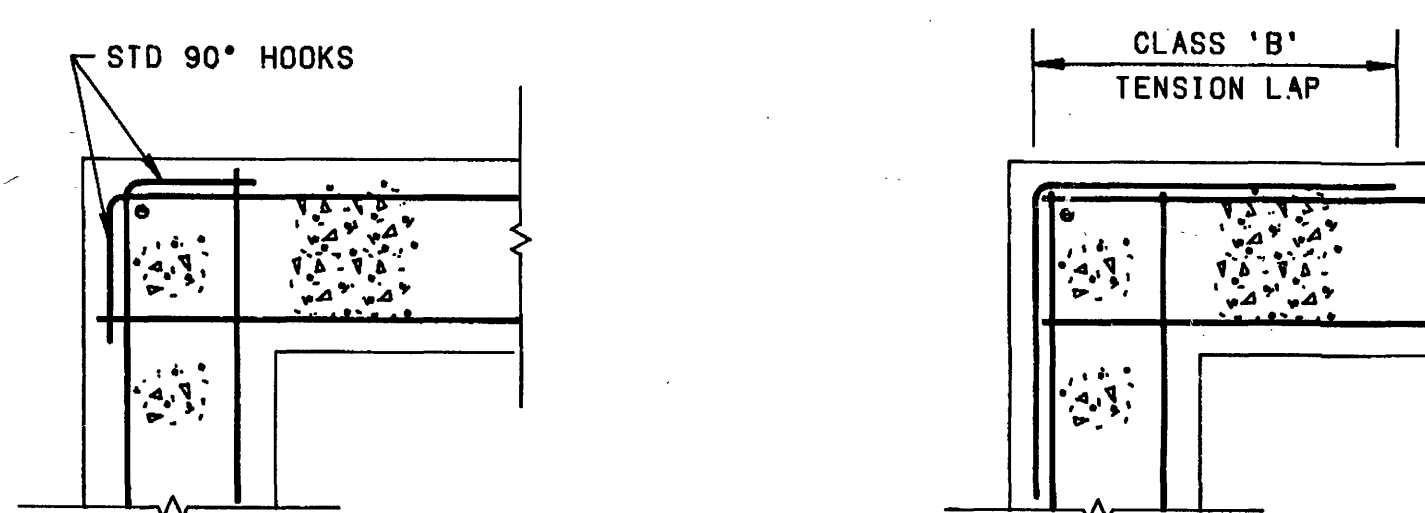


DOUBLE CURTAIN CORNER DETAIL
SCALE: 1" = 1'-0"

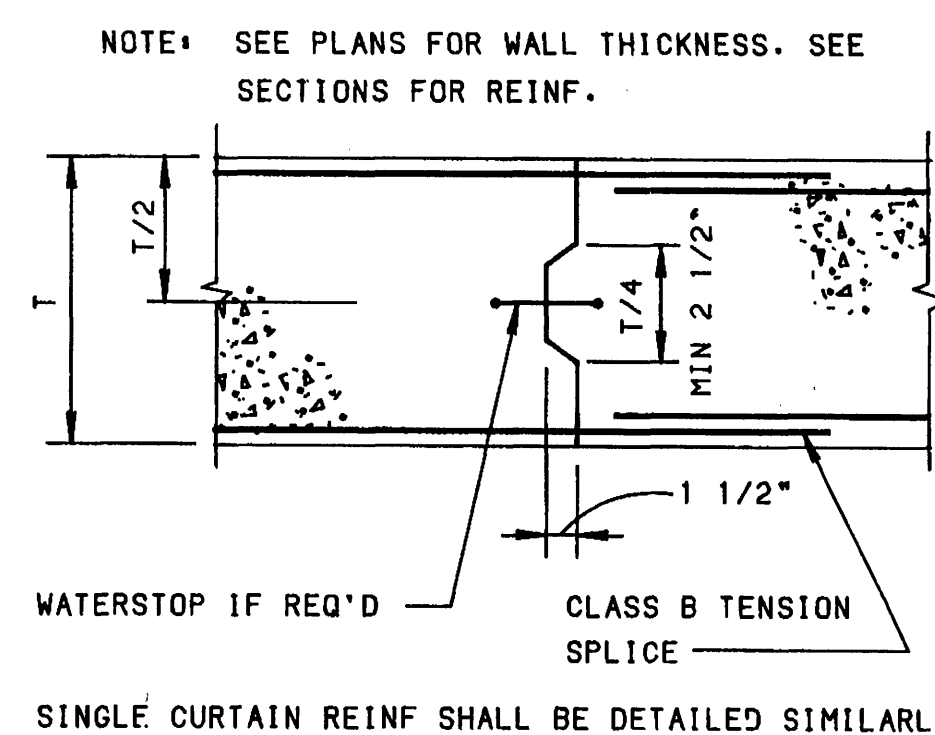


TYPICAL WALL CONSTRUCTION JOINT


NOT TO SCALE

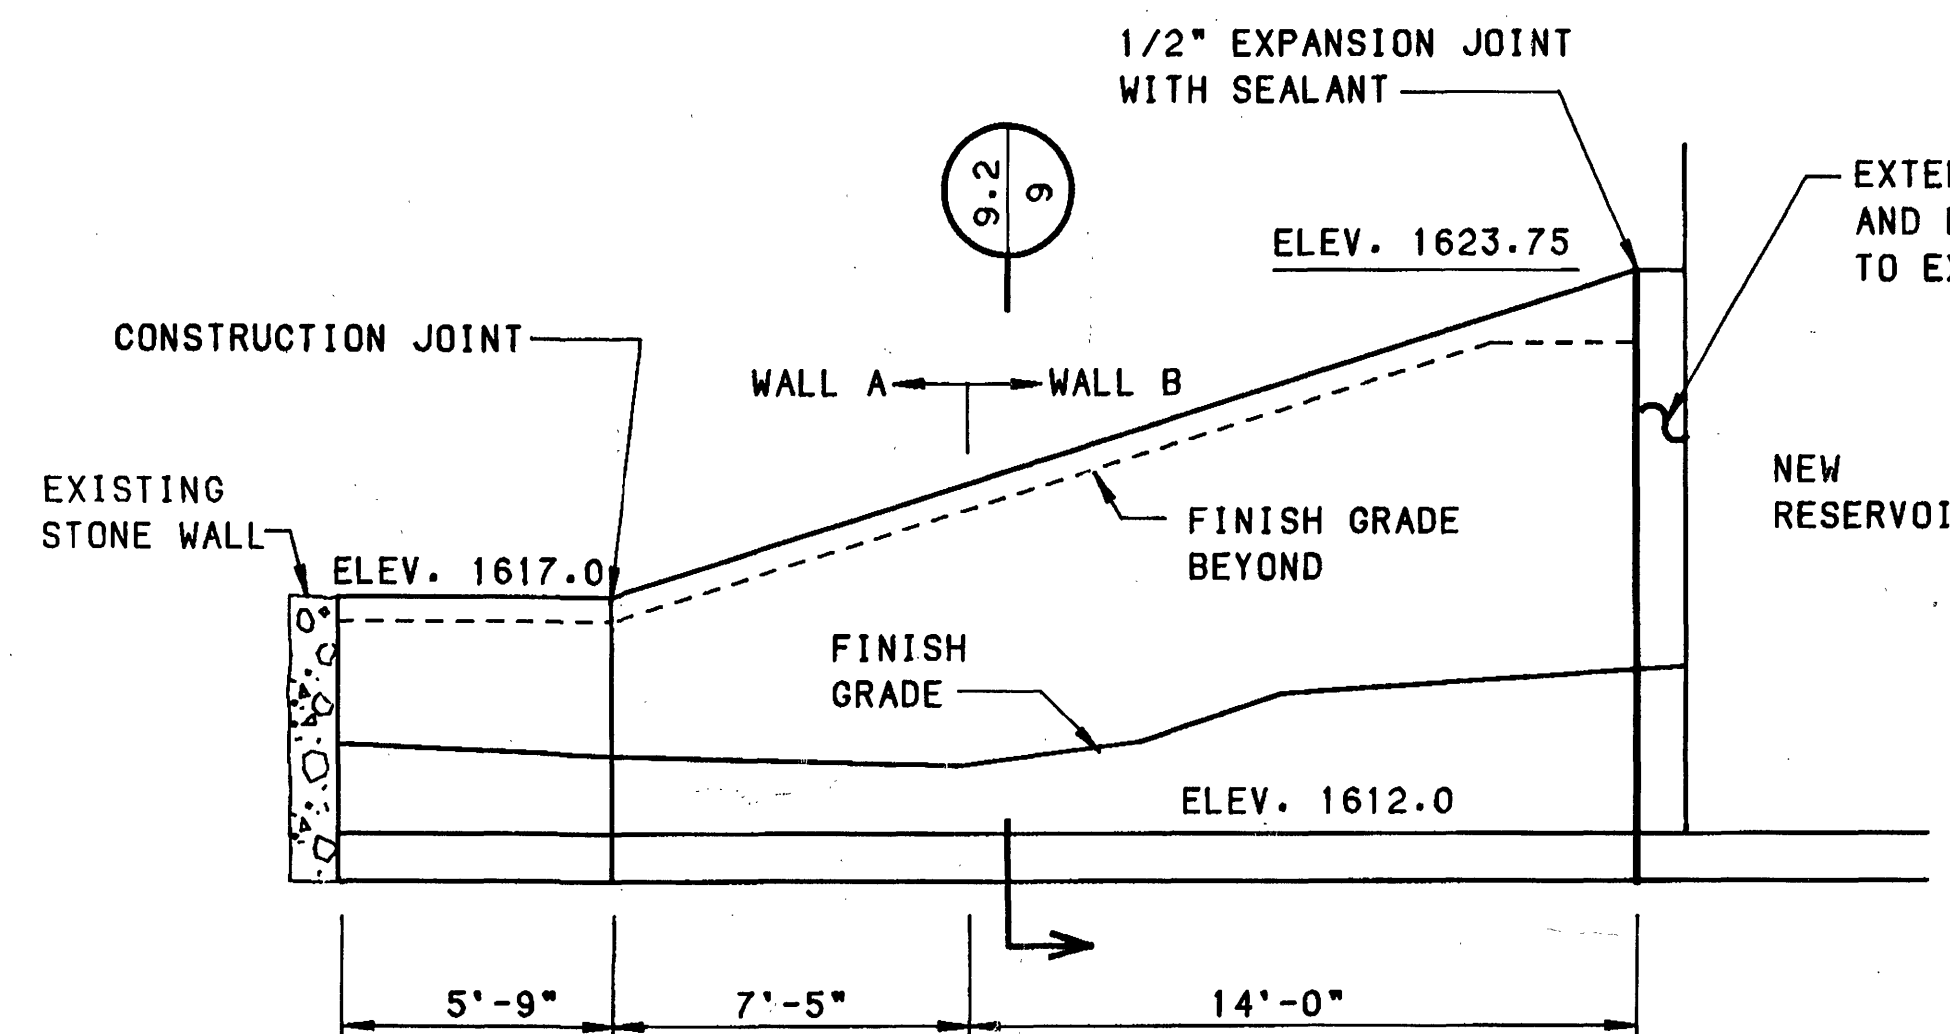


RETAINING WALL - ELEVATION
SCALE: 1/4" = 1'-0"

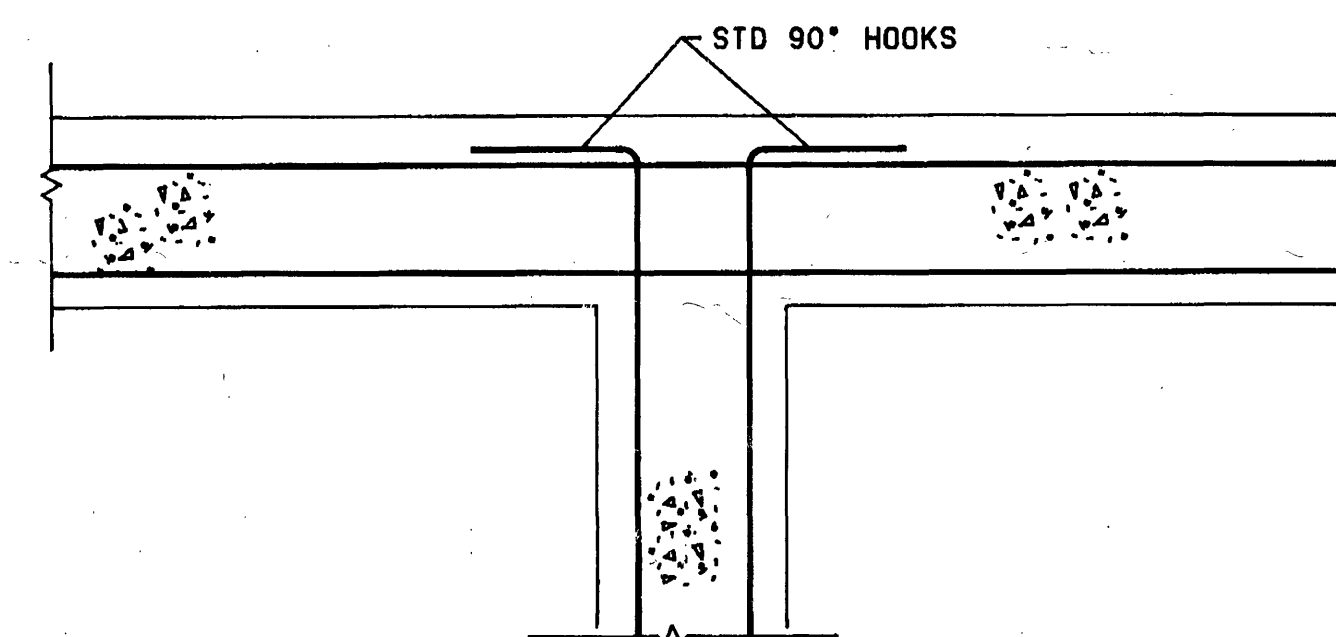


INTERSECTION DETAIL
SCALE: 1" = 1'-0"

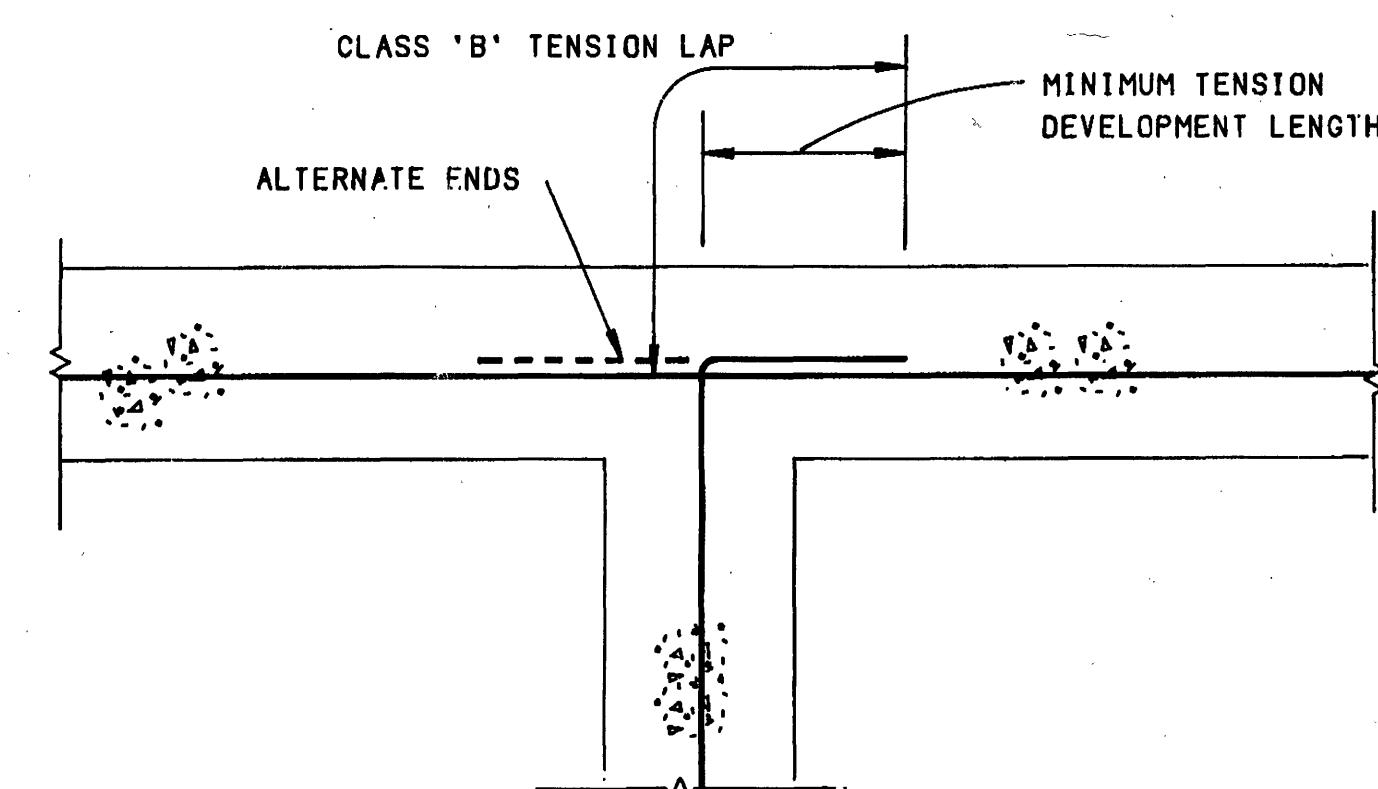


INTERSECTION DETAIL
SCALE: 1" = 1'-0"

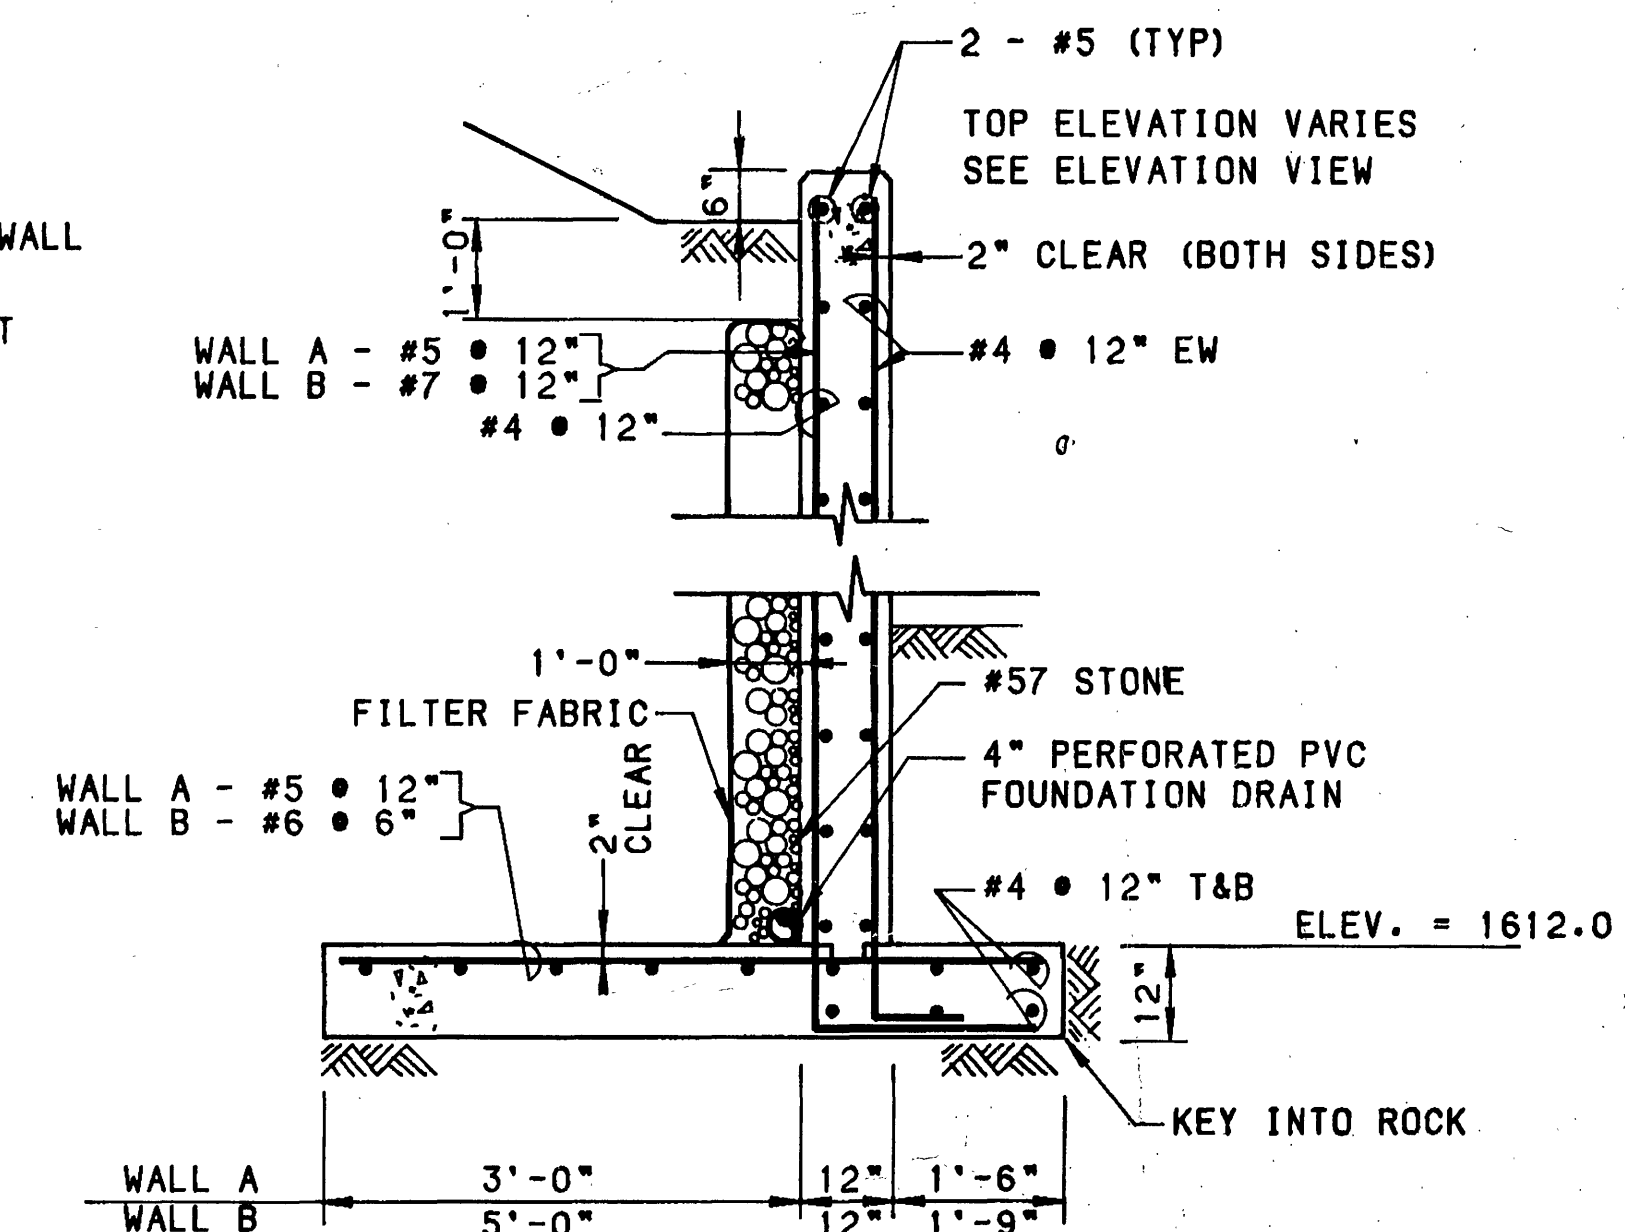

TYPICAL SECTION 9.2
SCALE: 1/2" = 1'-0"

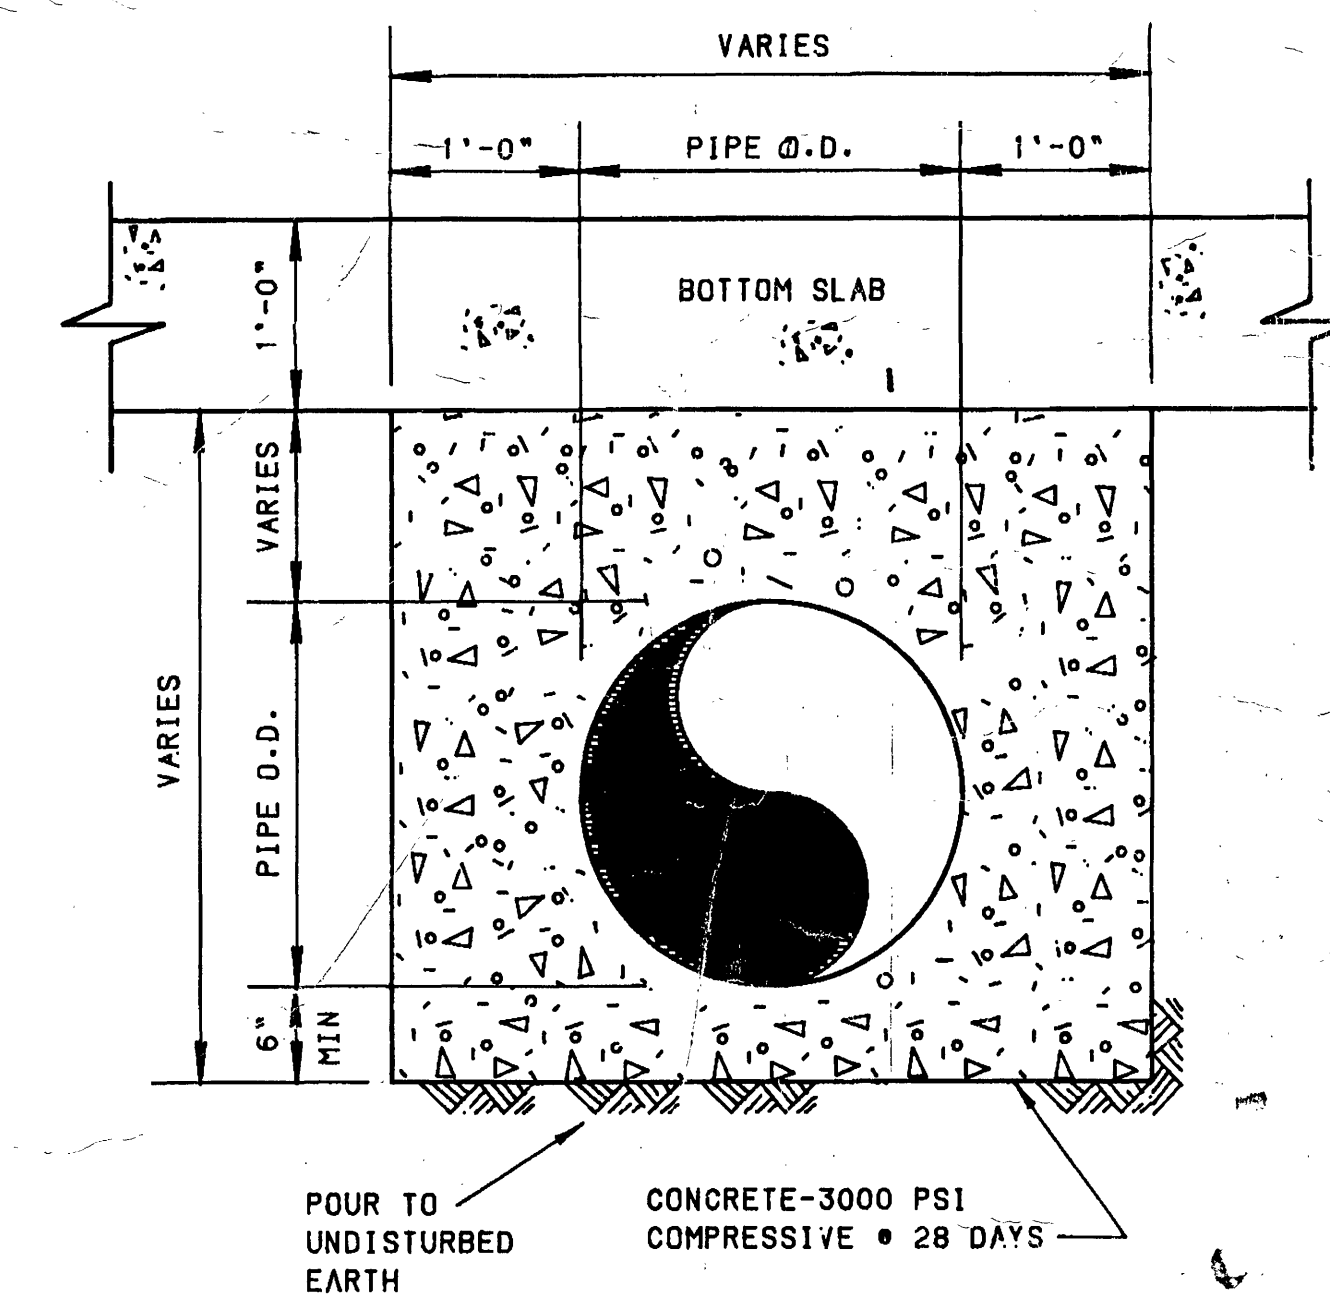


PIPE ENCASEMENT DETAIL
SCALE: NONE

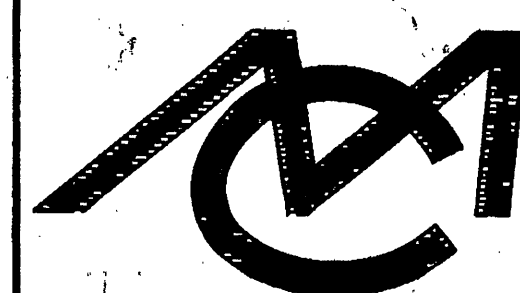

Mattern & Craig
CONSULTING ENGINEERS - SURVEYORS

DESIGNED: RWB
DRAWN: FMP
CHECKED: SAC

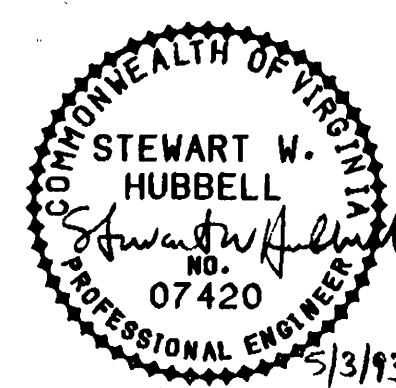

REV.	DATE	DESCRIPTION	BY	APP.
1	8-9-94	RECORD DRAWING	AGB	

DATE
MAY
1993
COMM.
1249

FALLING CREEK FINISHED WATER RESERVOIR
CITY OF ROANOKE, VIRGINIA

MISCELLANEOUS DETAILS AND SECTIONS

SHEET
9