




05089 REV. B DRAW 1 4X JBB 4296 FALL CREEK S2

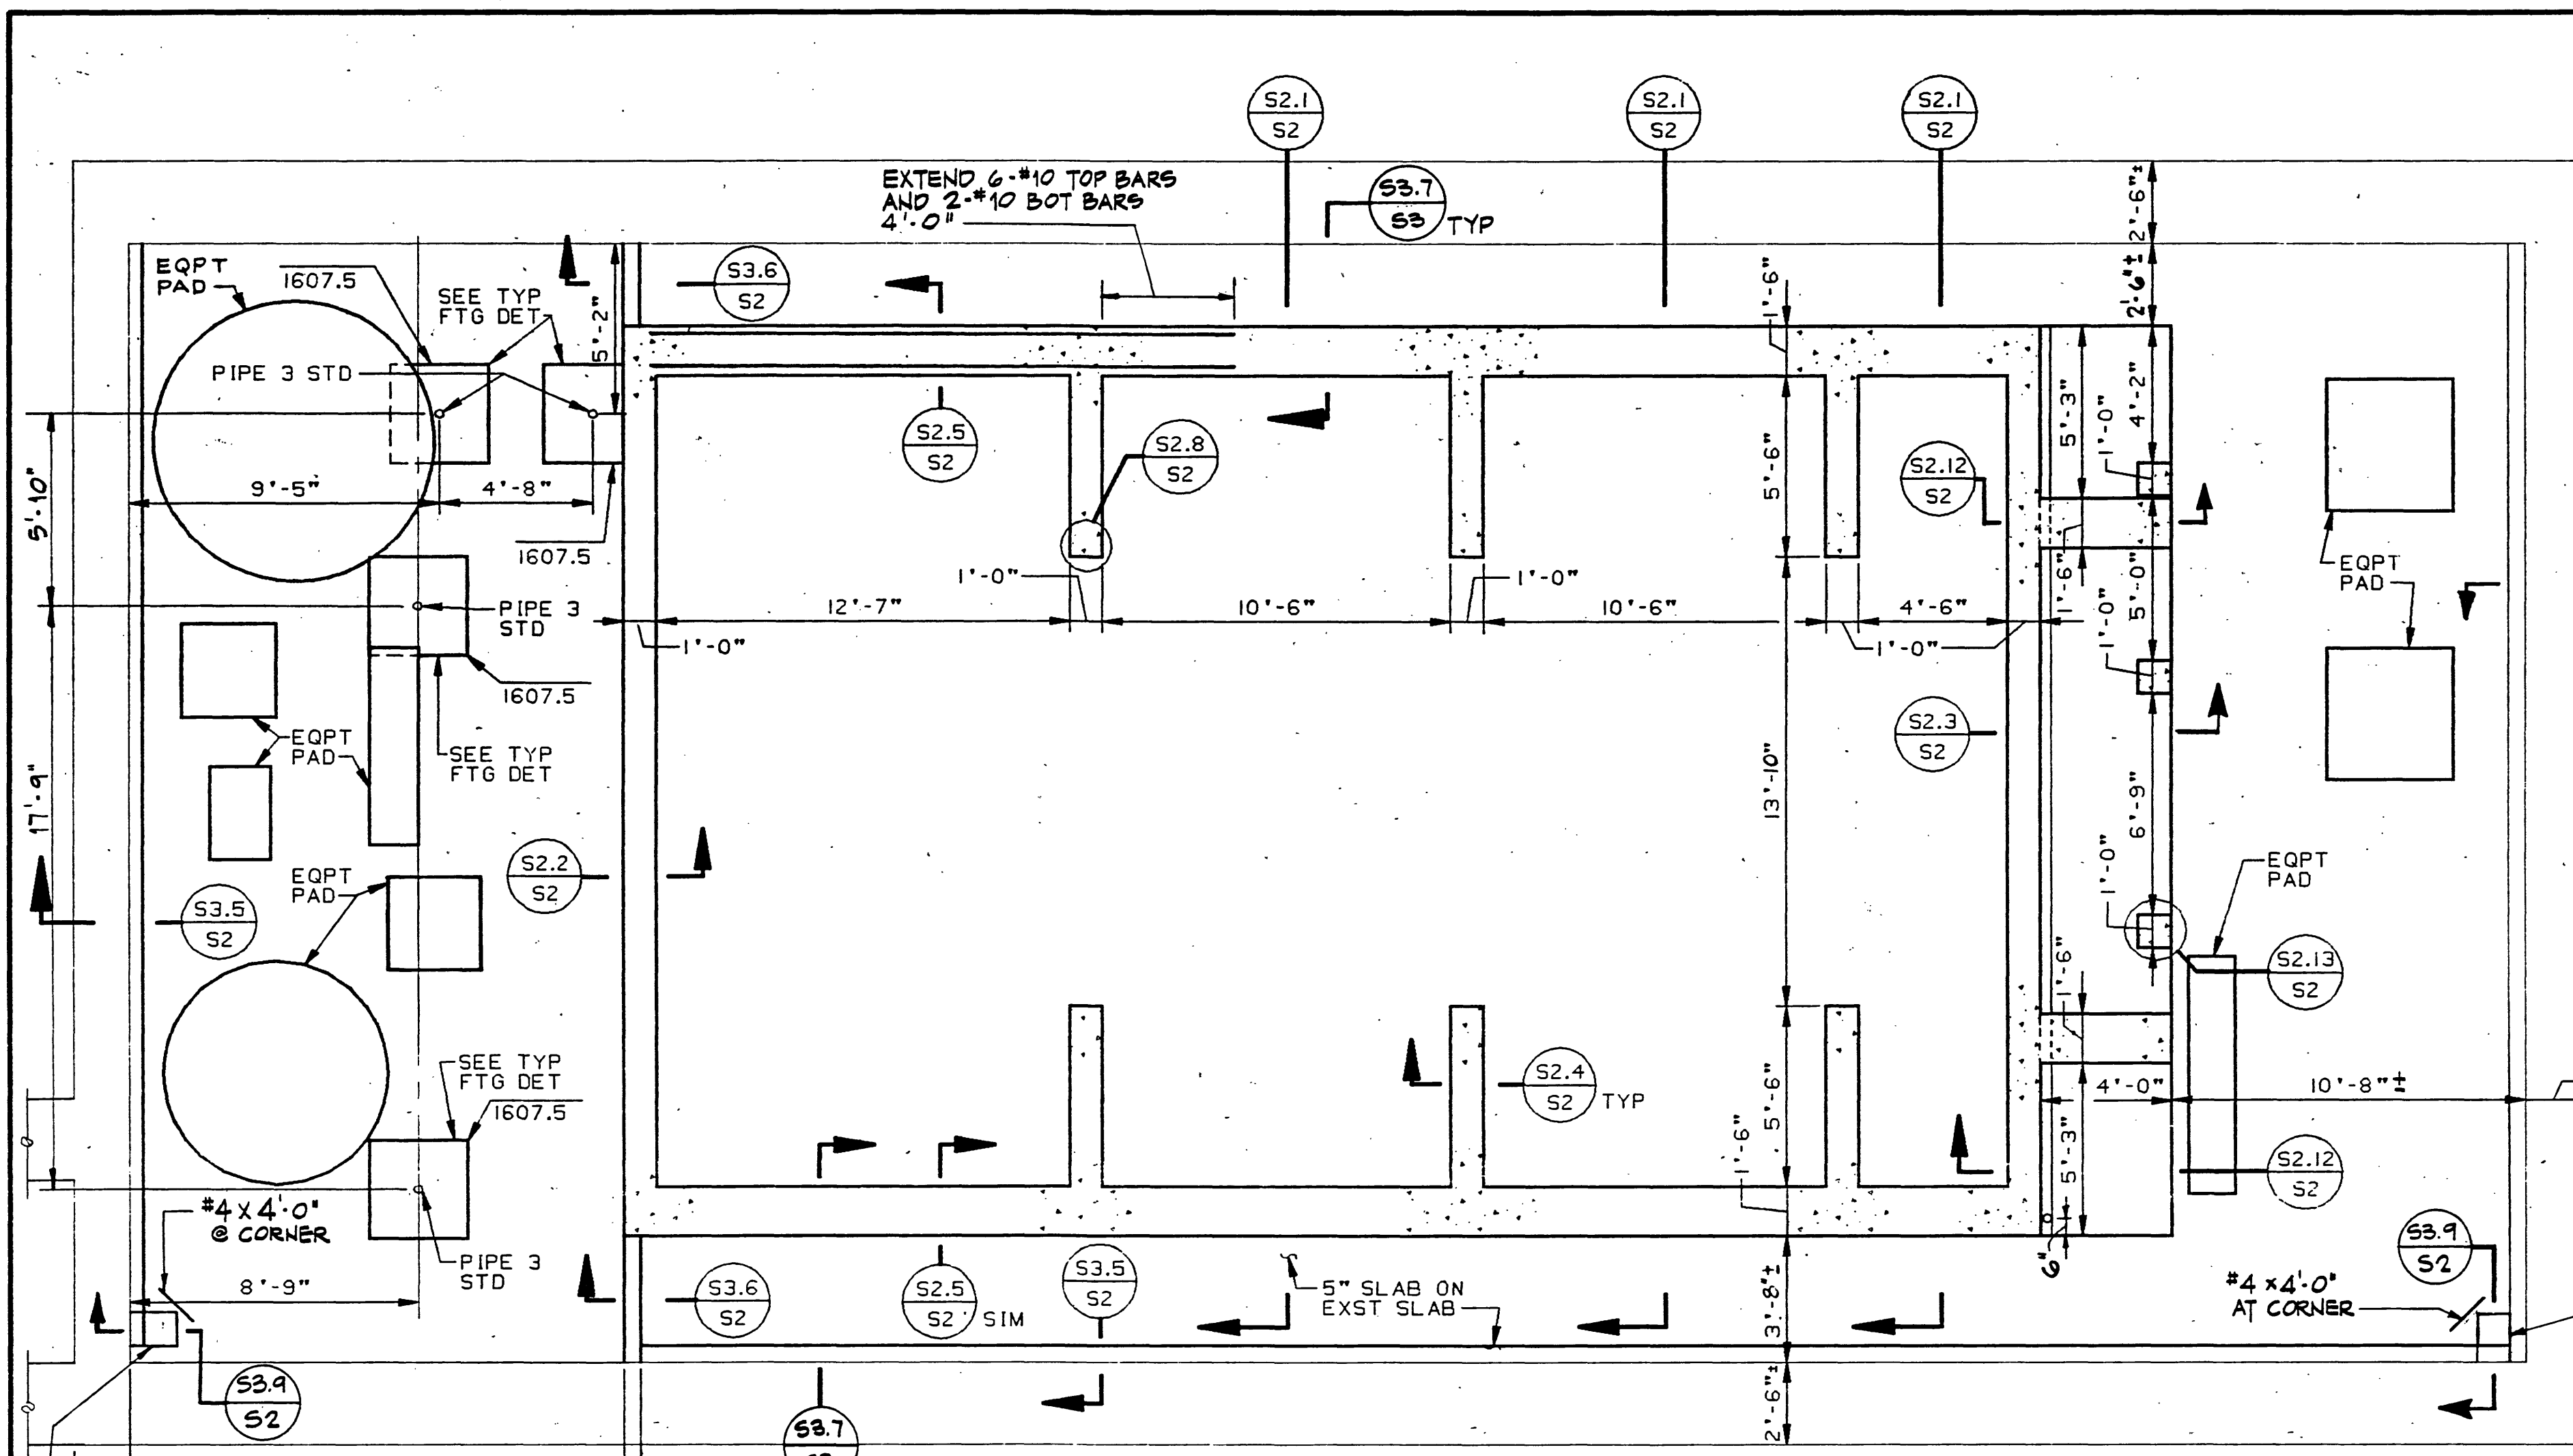


FILTER BUILDING PLAN
SCALE: 1/4"=1'-0"

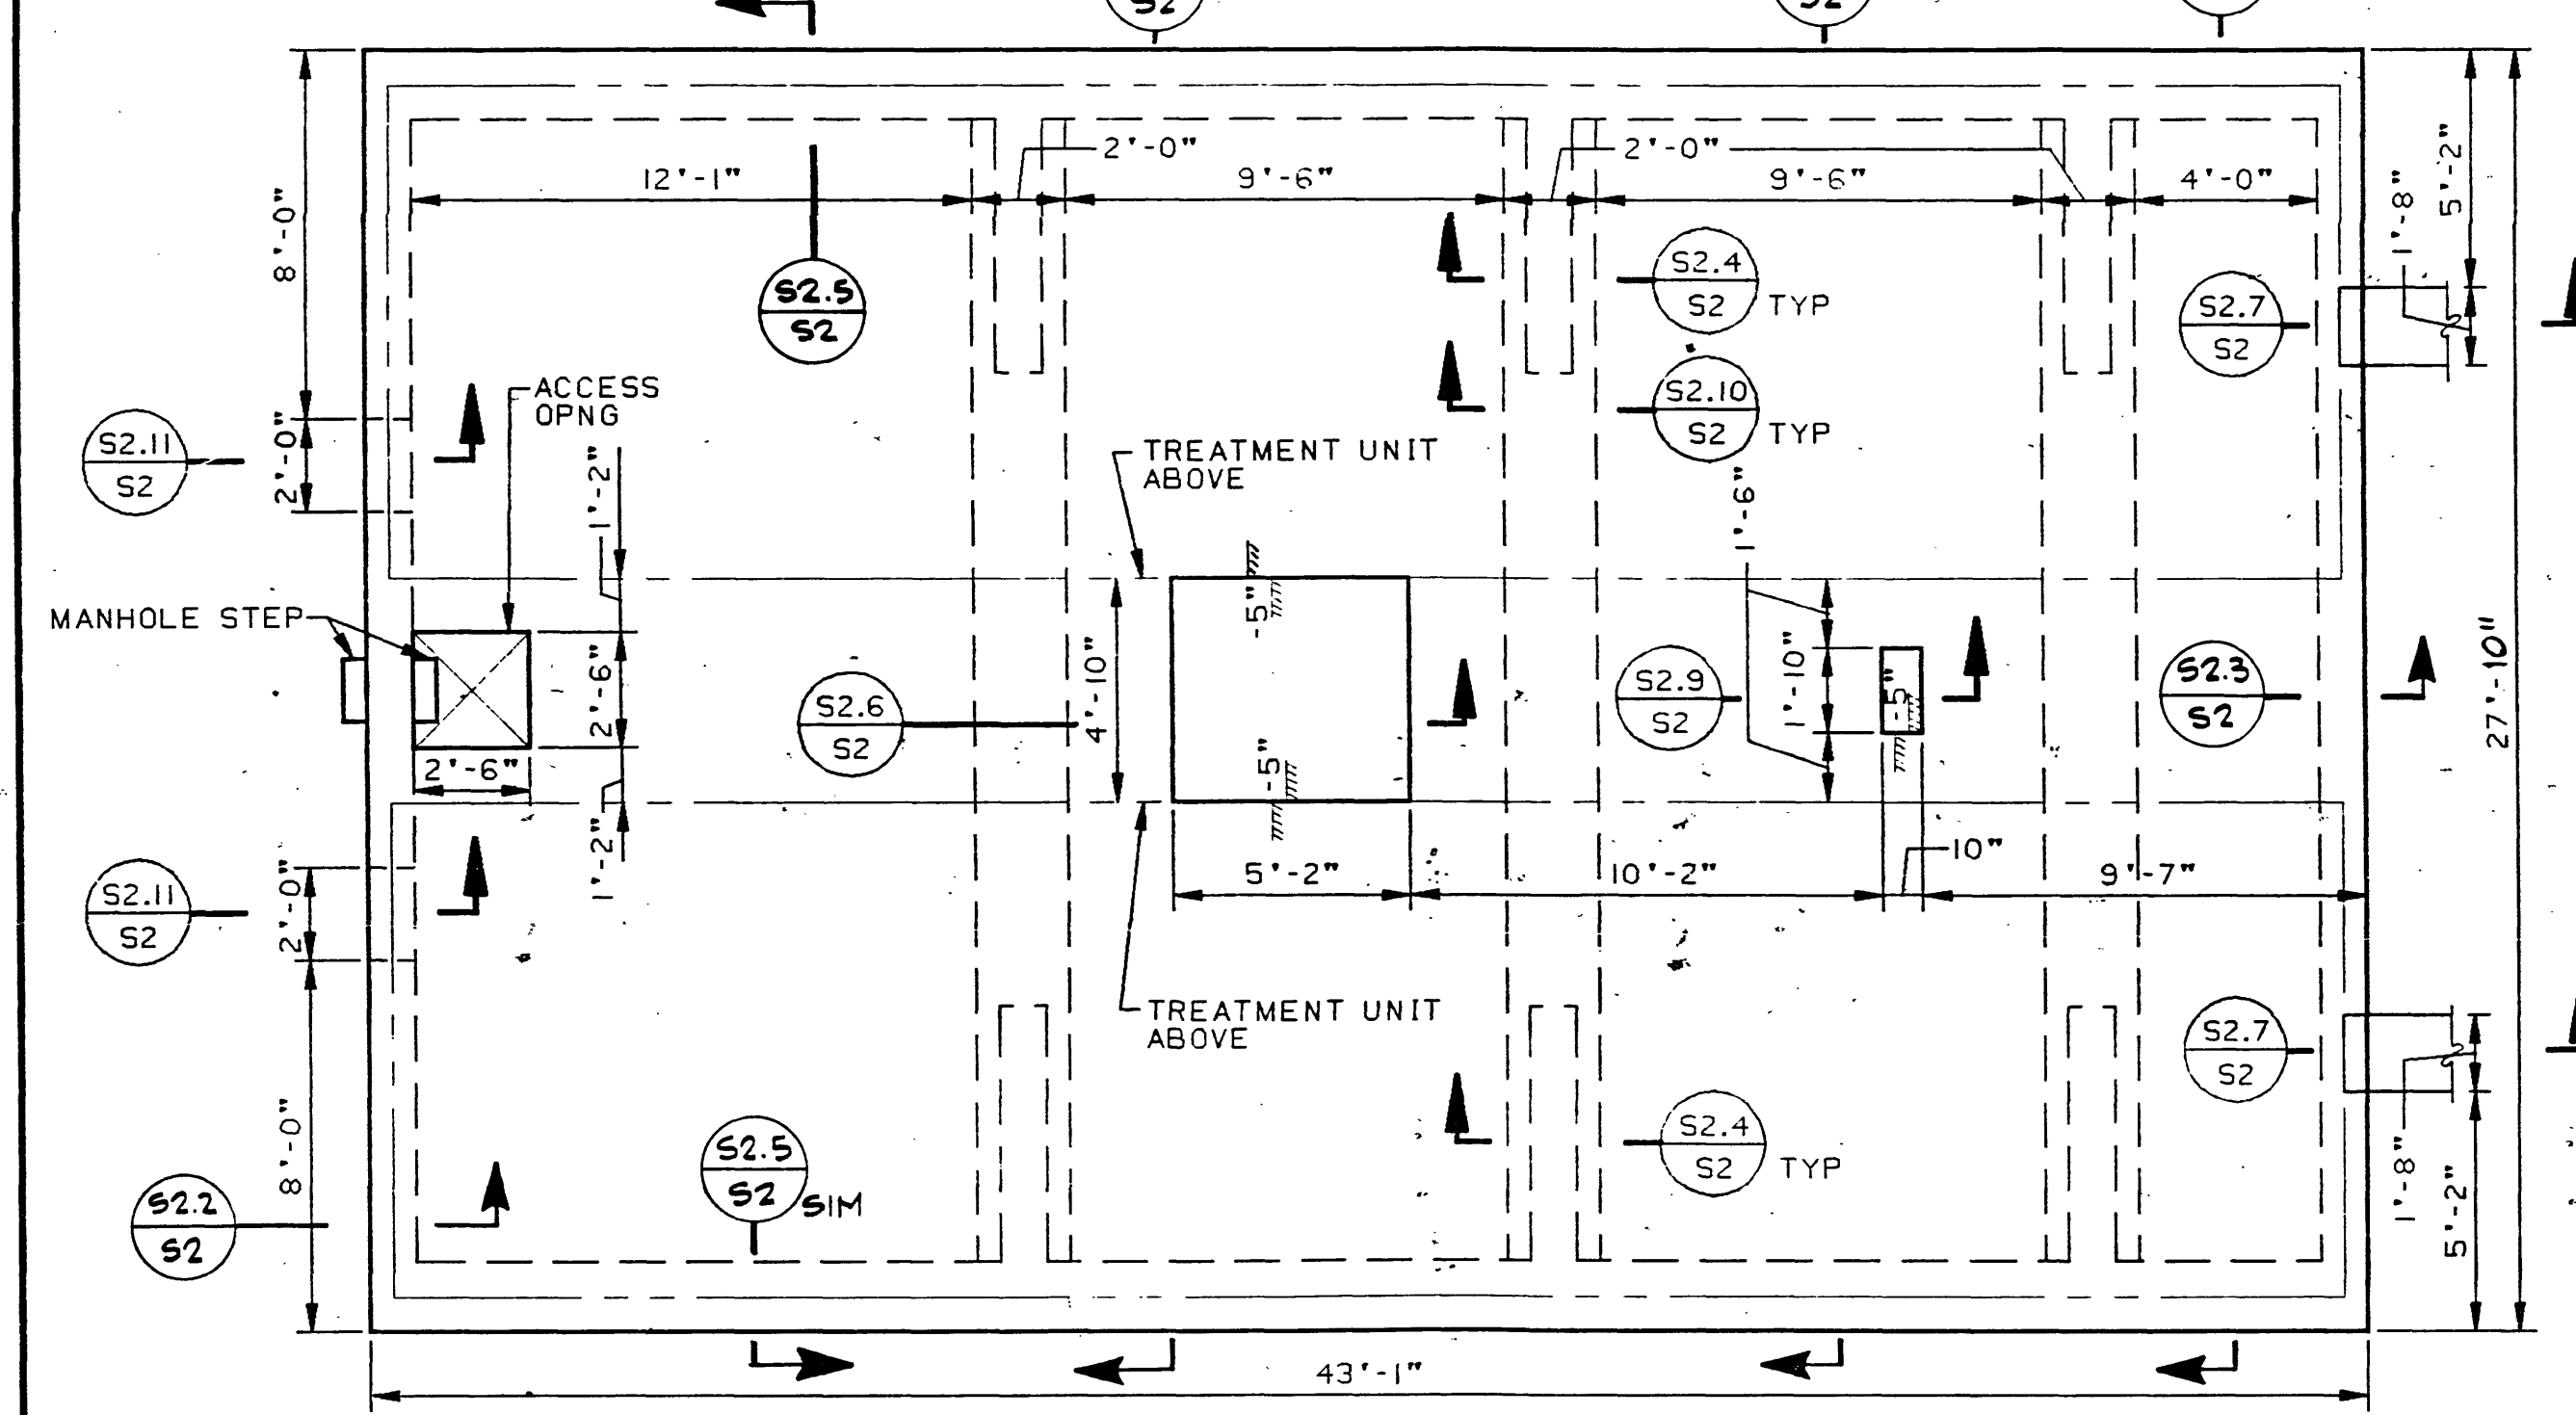

WET WELL PLAN
SCALE: 1/4"=1'-0"

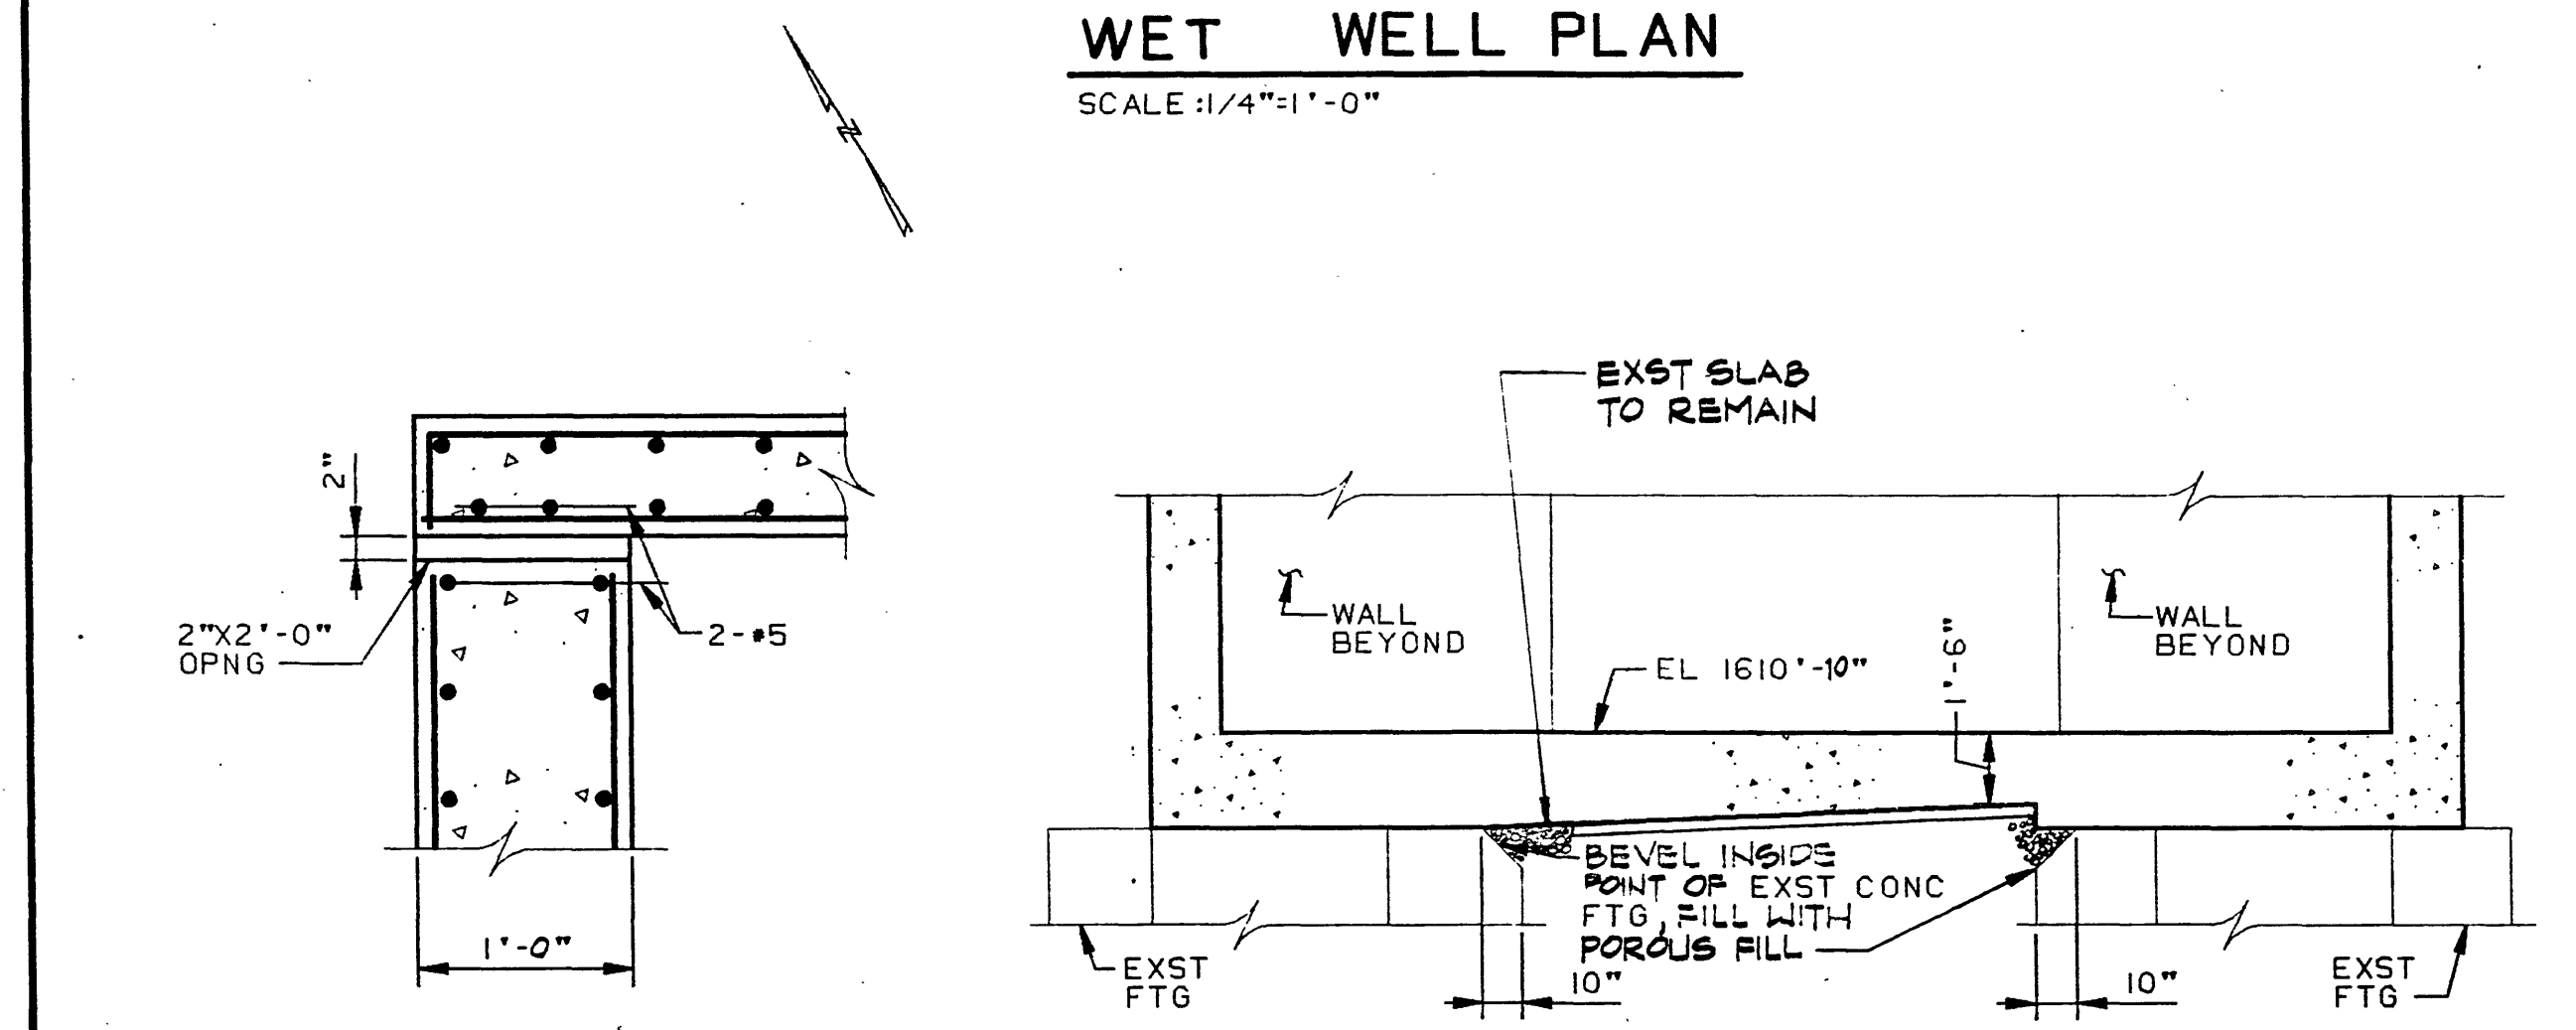


TYPICAL WET WELL BASE SLAB
NO SCALE

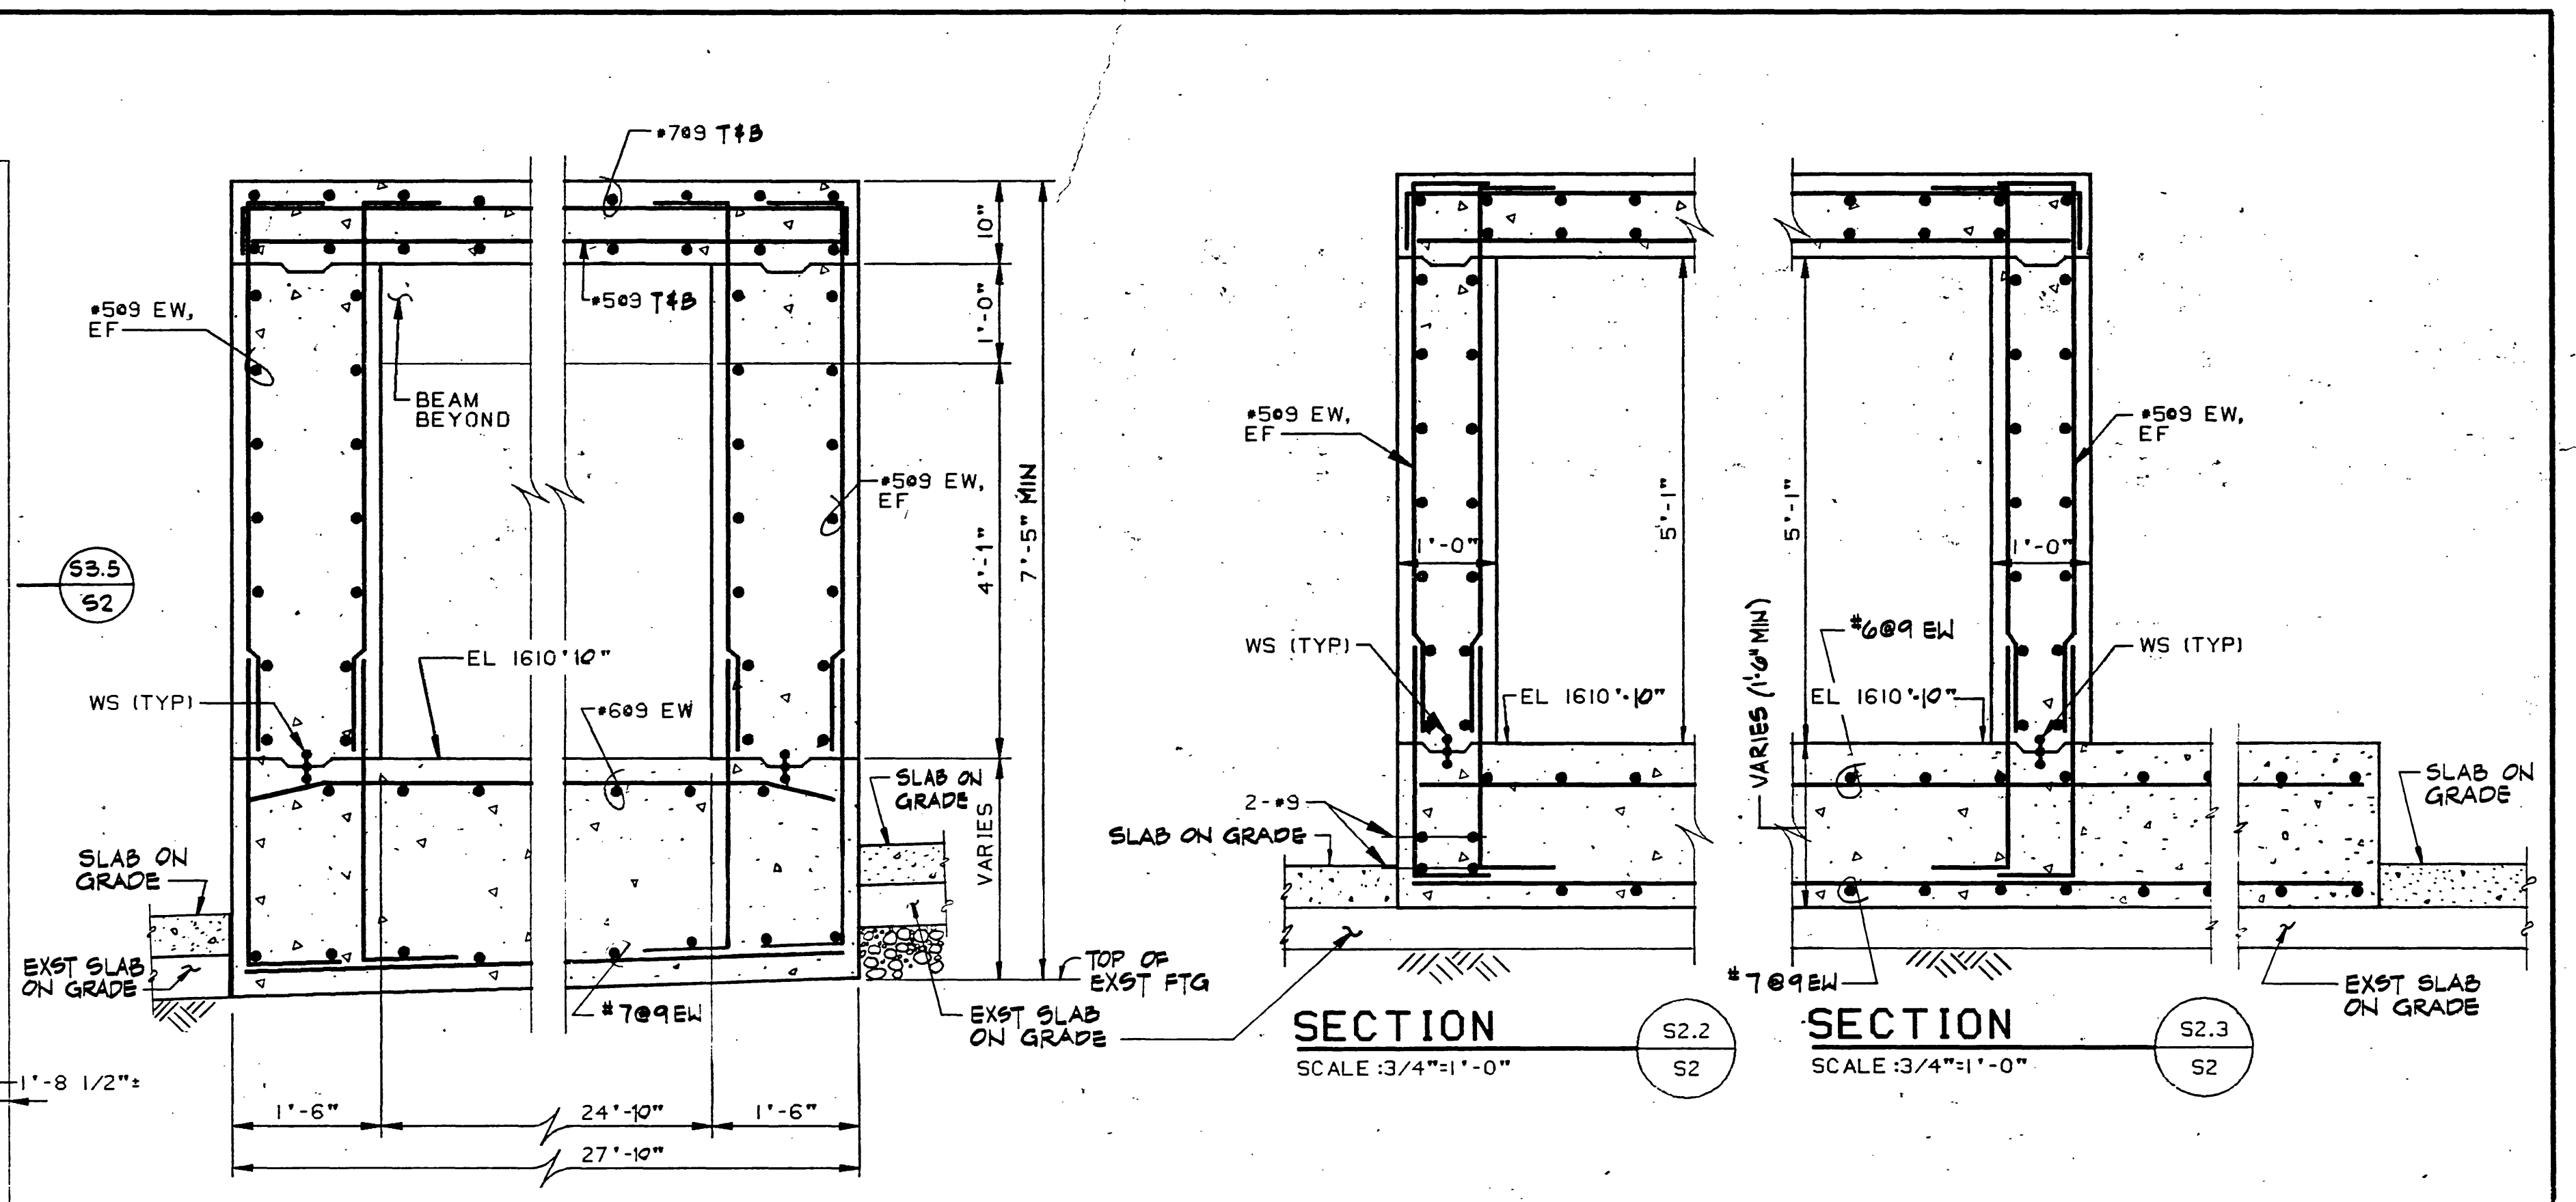


SECTION S2.1
SCALE: 3/4"=1'-0"

SECTION S2.2
SCALE: 3/4"=1'-0"


SECTION S2.3
SCALE: 3/4"=1'-0"

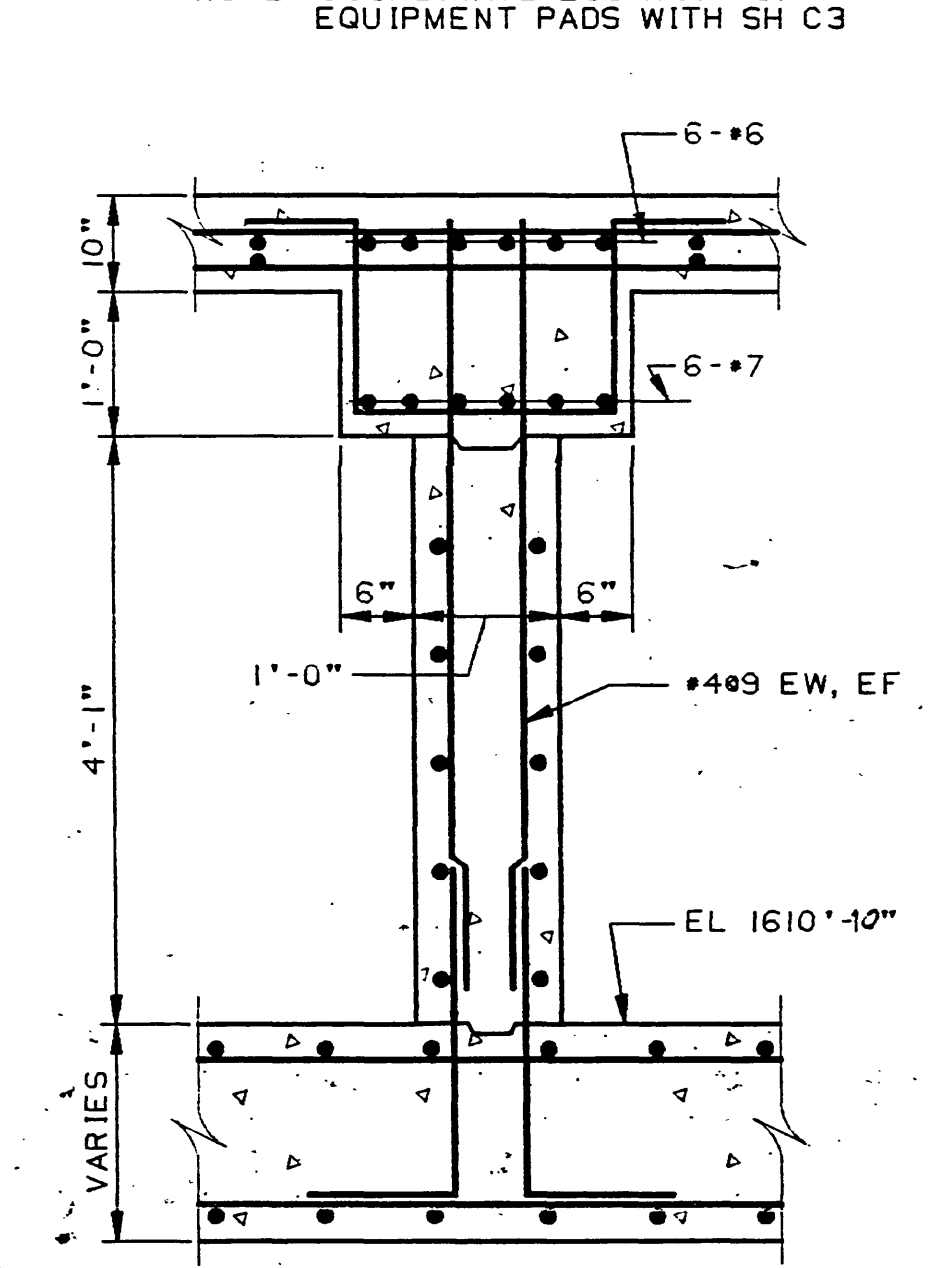


SECTION S2.4
SCALE: 3/4"=1'-0"

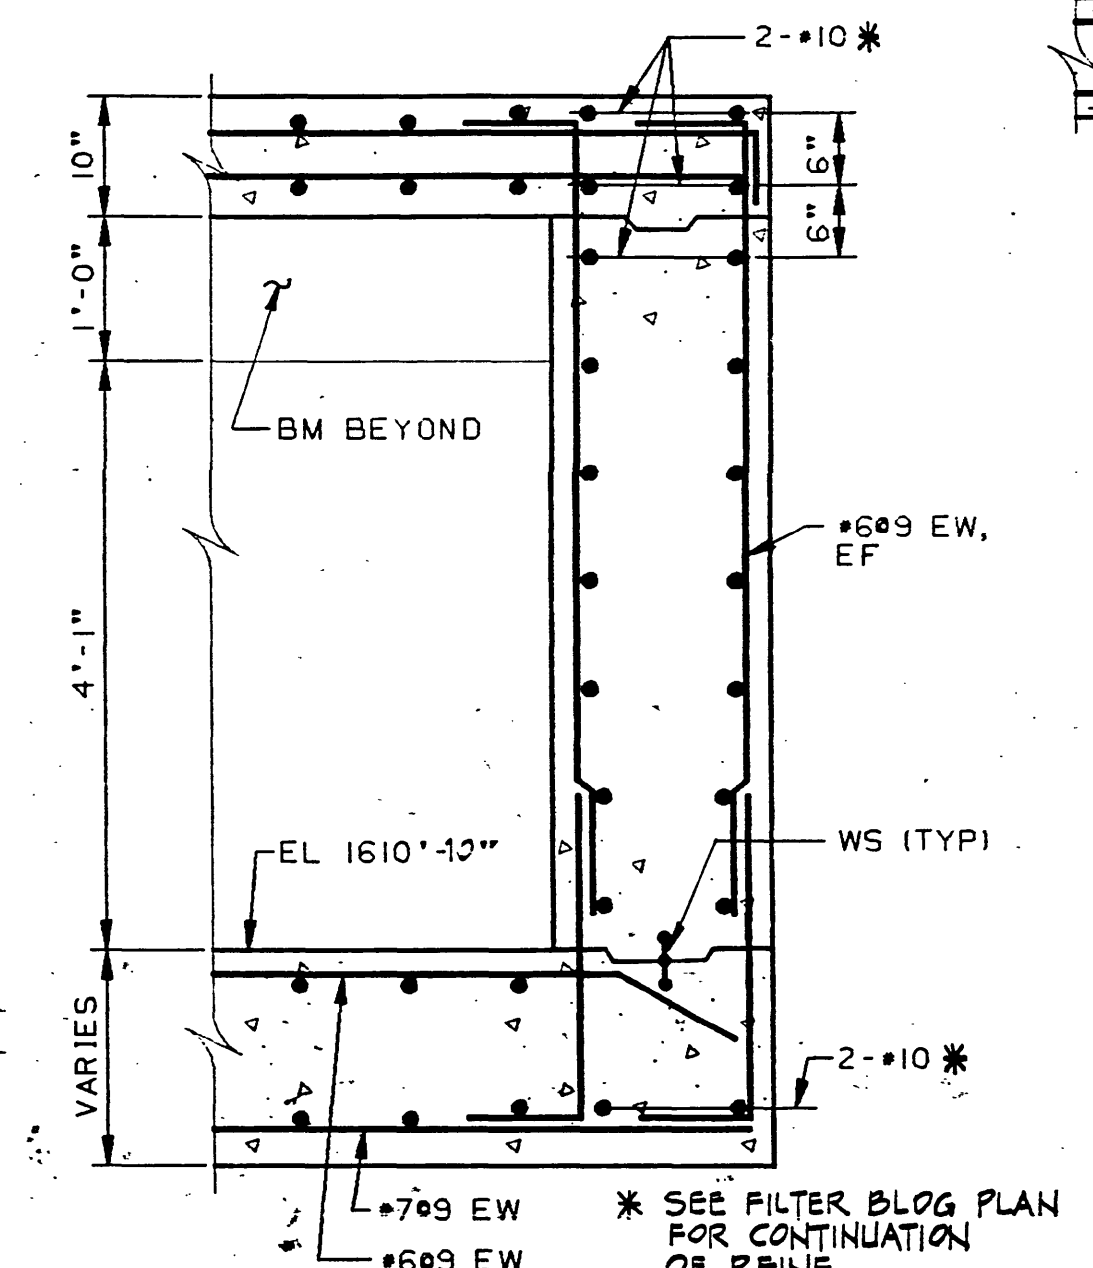


SECTION S2.5
SCALE: 3/4"=1'-0"

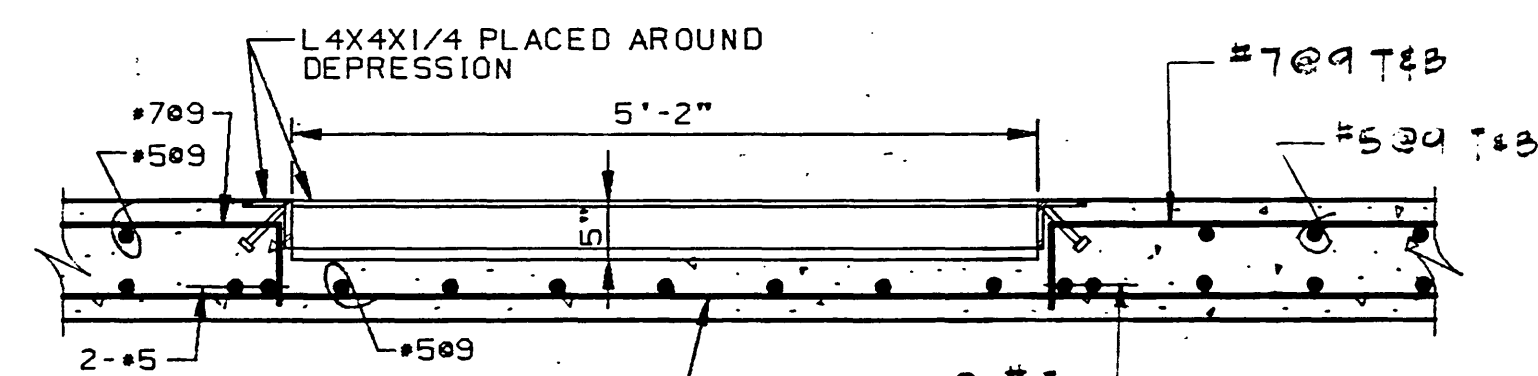


SECTION S2.6
SCALE: 3/4"=1'-0"

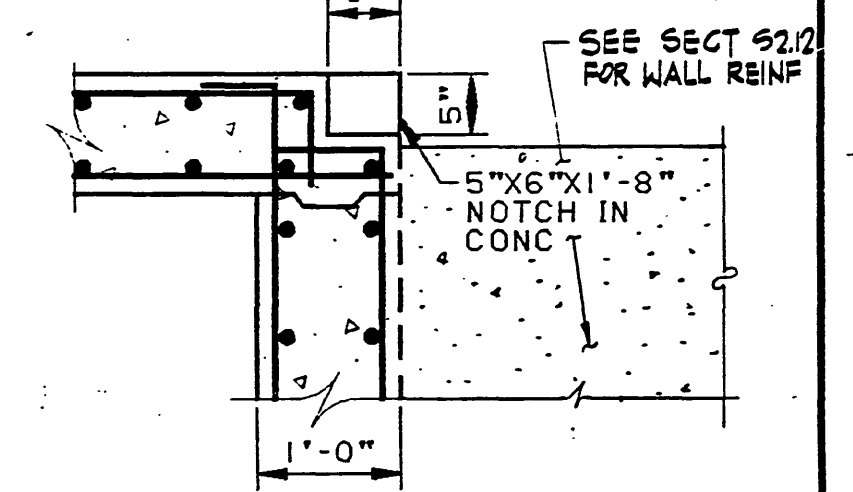


SECTION S2.7
SCALE: 3/4"=1'-0"

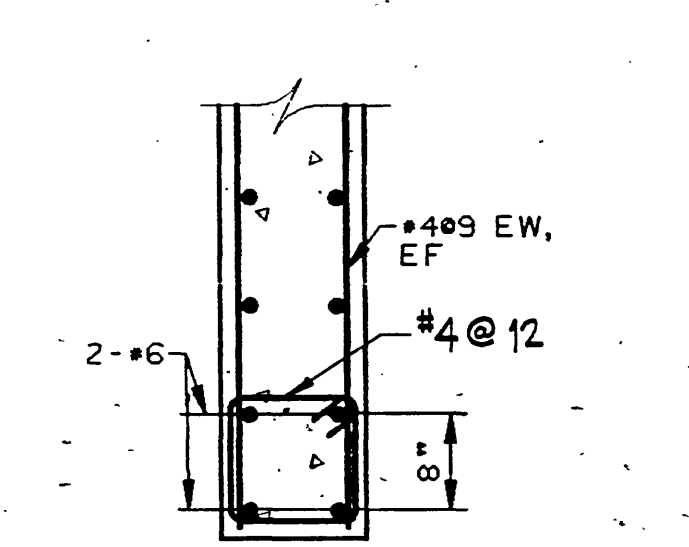


SECTION S2.8
SCALE: 3/4"=1'-0"

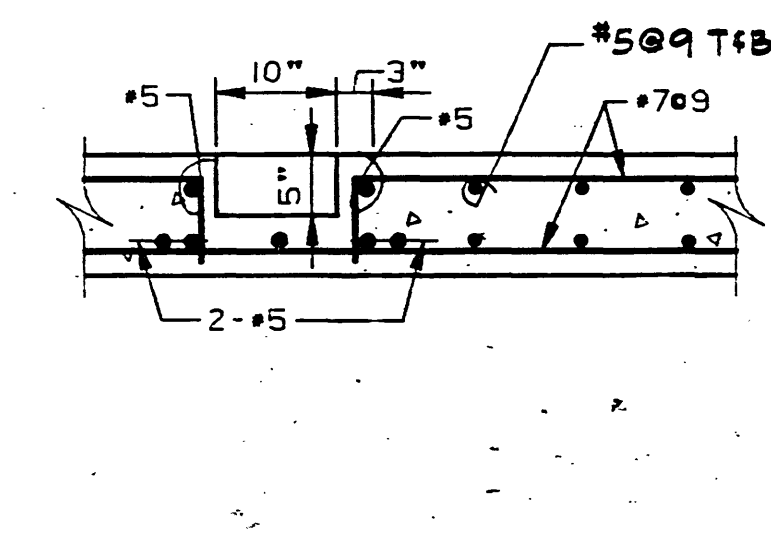


SECTION S2.9
SCALE: 3/4"=1'-0"

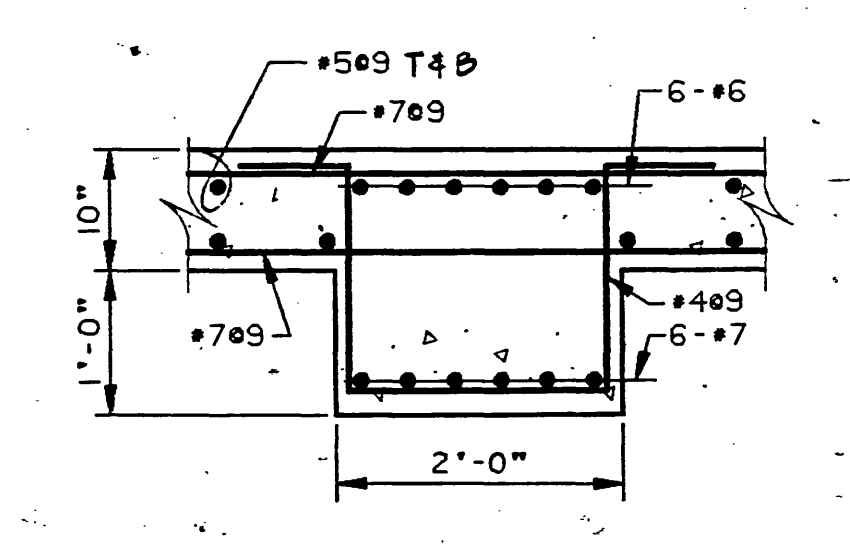


SECTION S2.10
SCALE: 3/4"=1'-0"

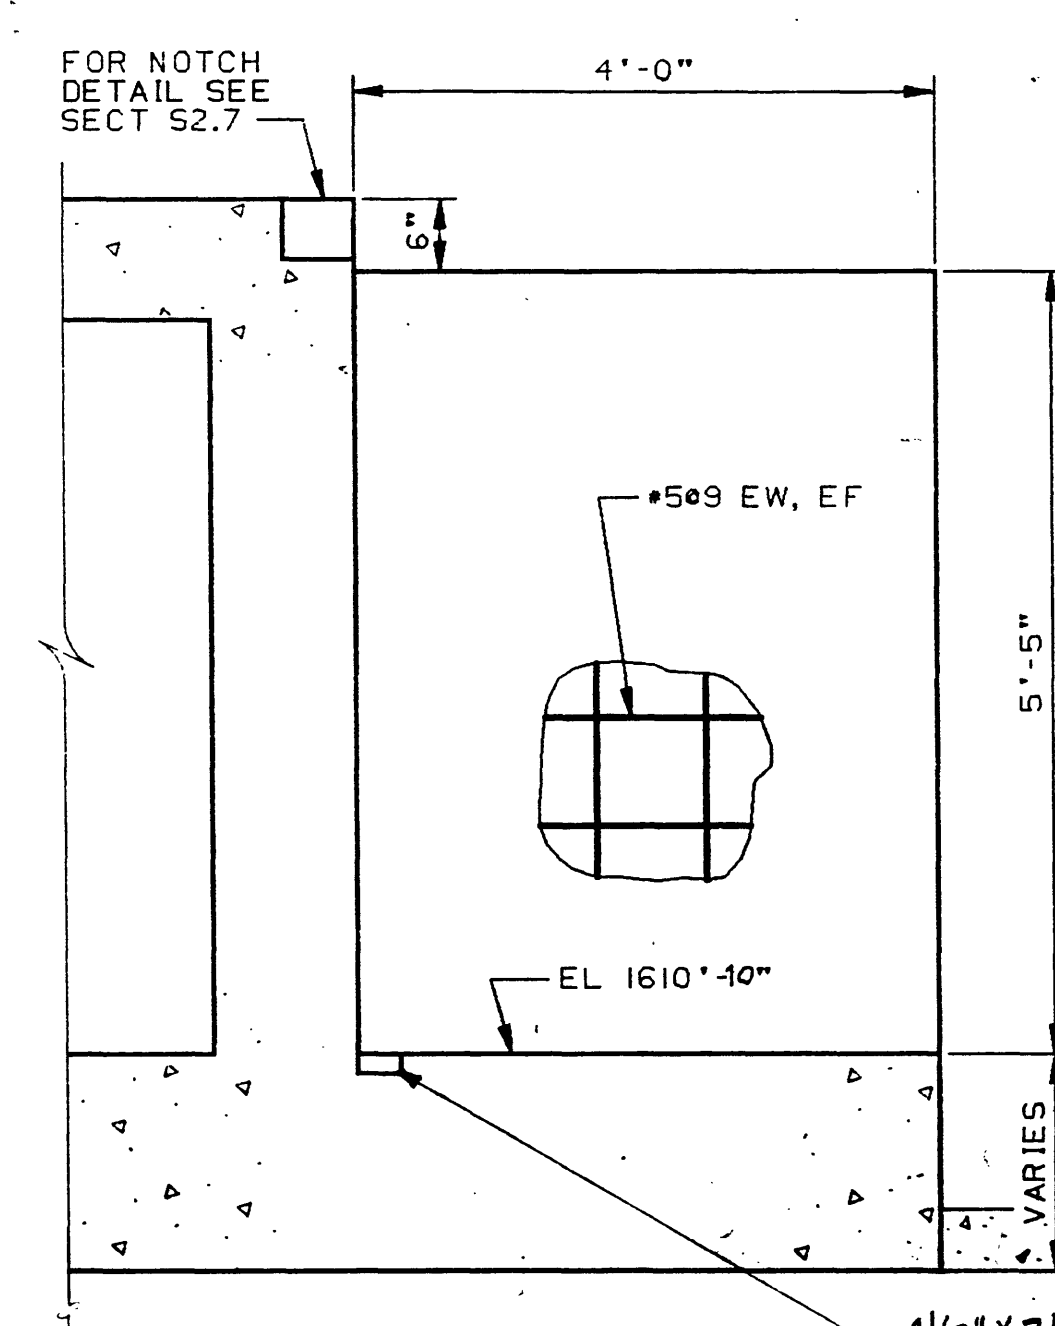


SECTION S2.12
SCALE: 3/4"=1'-0"

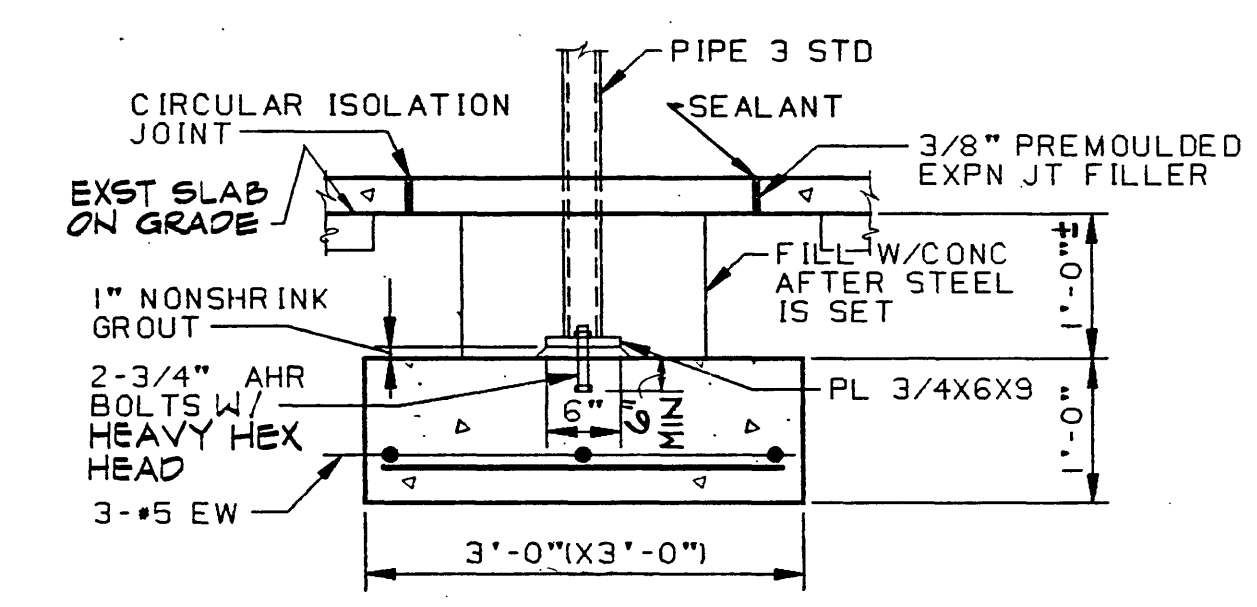

INTERIOR STEEL COLUMN & FOOTING DETAIL
NO SCALE

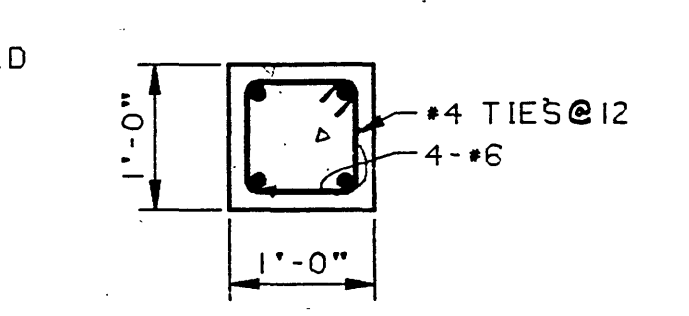

DETAIL S2.13
SCALE: 3/4"=1'-0"

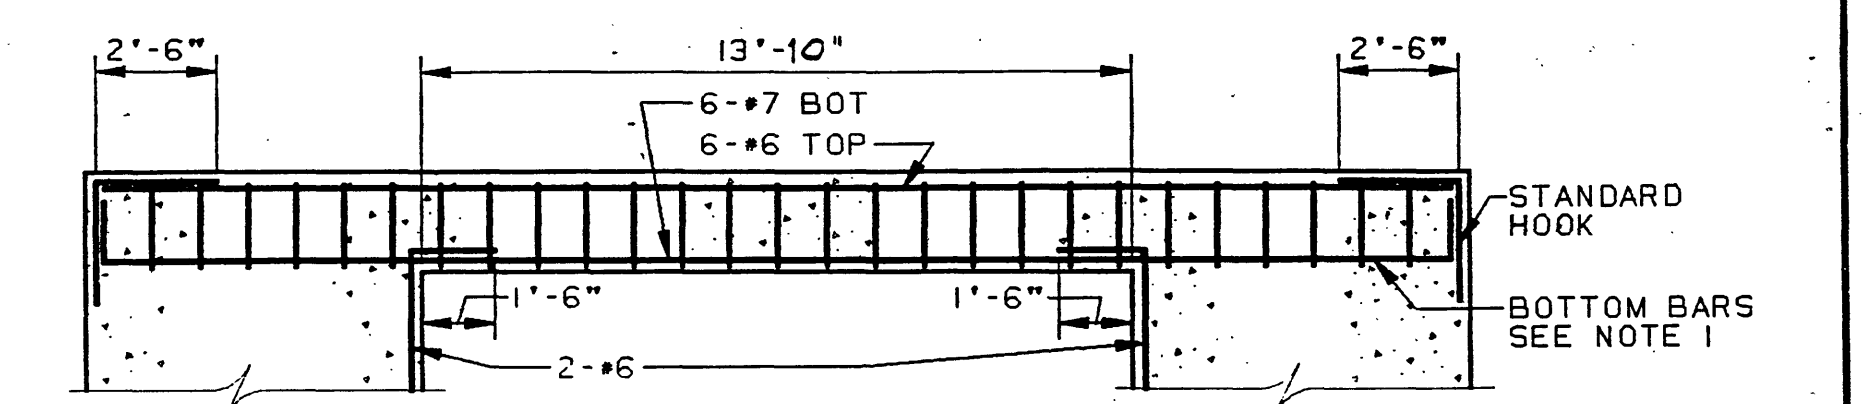

TYPICAL BEAM DETAIL
NO SCALE

- NOTES:
1. EXTEND 2-#7 BARS INTO WALL WITH STD HOOK.
2. SEE SECTIONS S2.10 AND S2.4 FOR DETAILS OF REINF.

8/93 RECORD DRAWING			
REVISION	DATE	DESCRIPTION	BY APP
DESIGNED	MM	FALLING CREEK WATER PLANT CITY OF ROANOKE, VIRGINIA	
DRAWN	CADD	FILTER BUILDING - PLANS & DETAILS	
CHECKED	MM	HAYES, SEAY, MATTERN & MATTERN ARCHITECTS - ENGINEERS - PLANNERS ROANOKE, VIRGINIA	
APPROVED	MM	SCALE AS NOTED	CONV. NO. 4296
SUBMITTED	MM	DATE 30 MAY 1999	SHEET S2

