

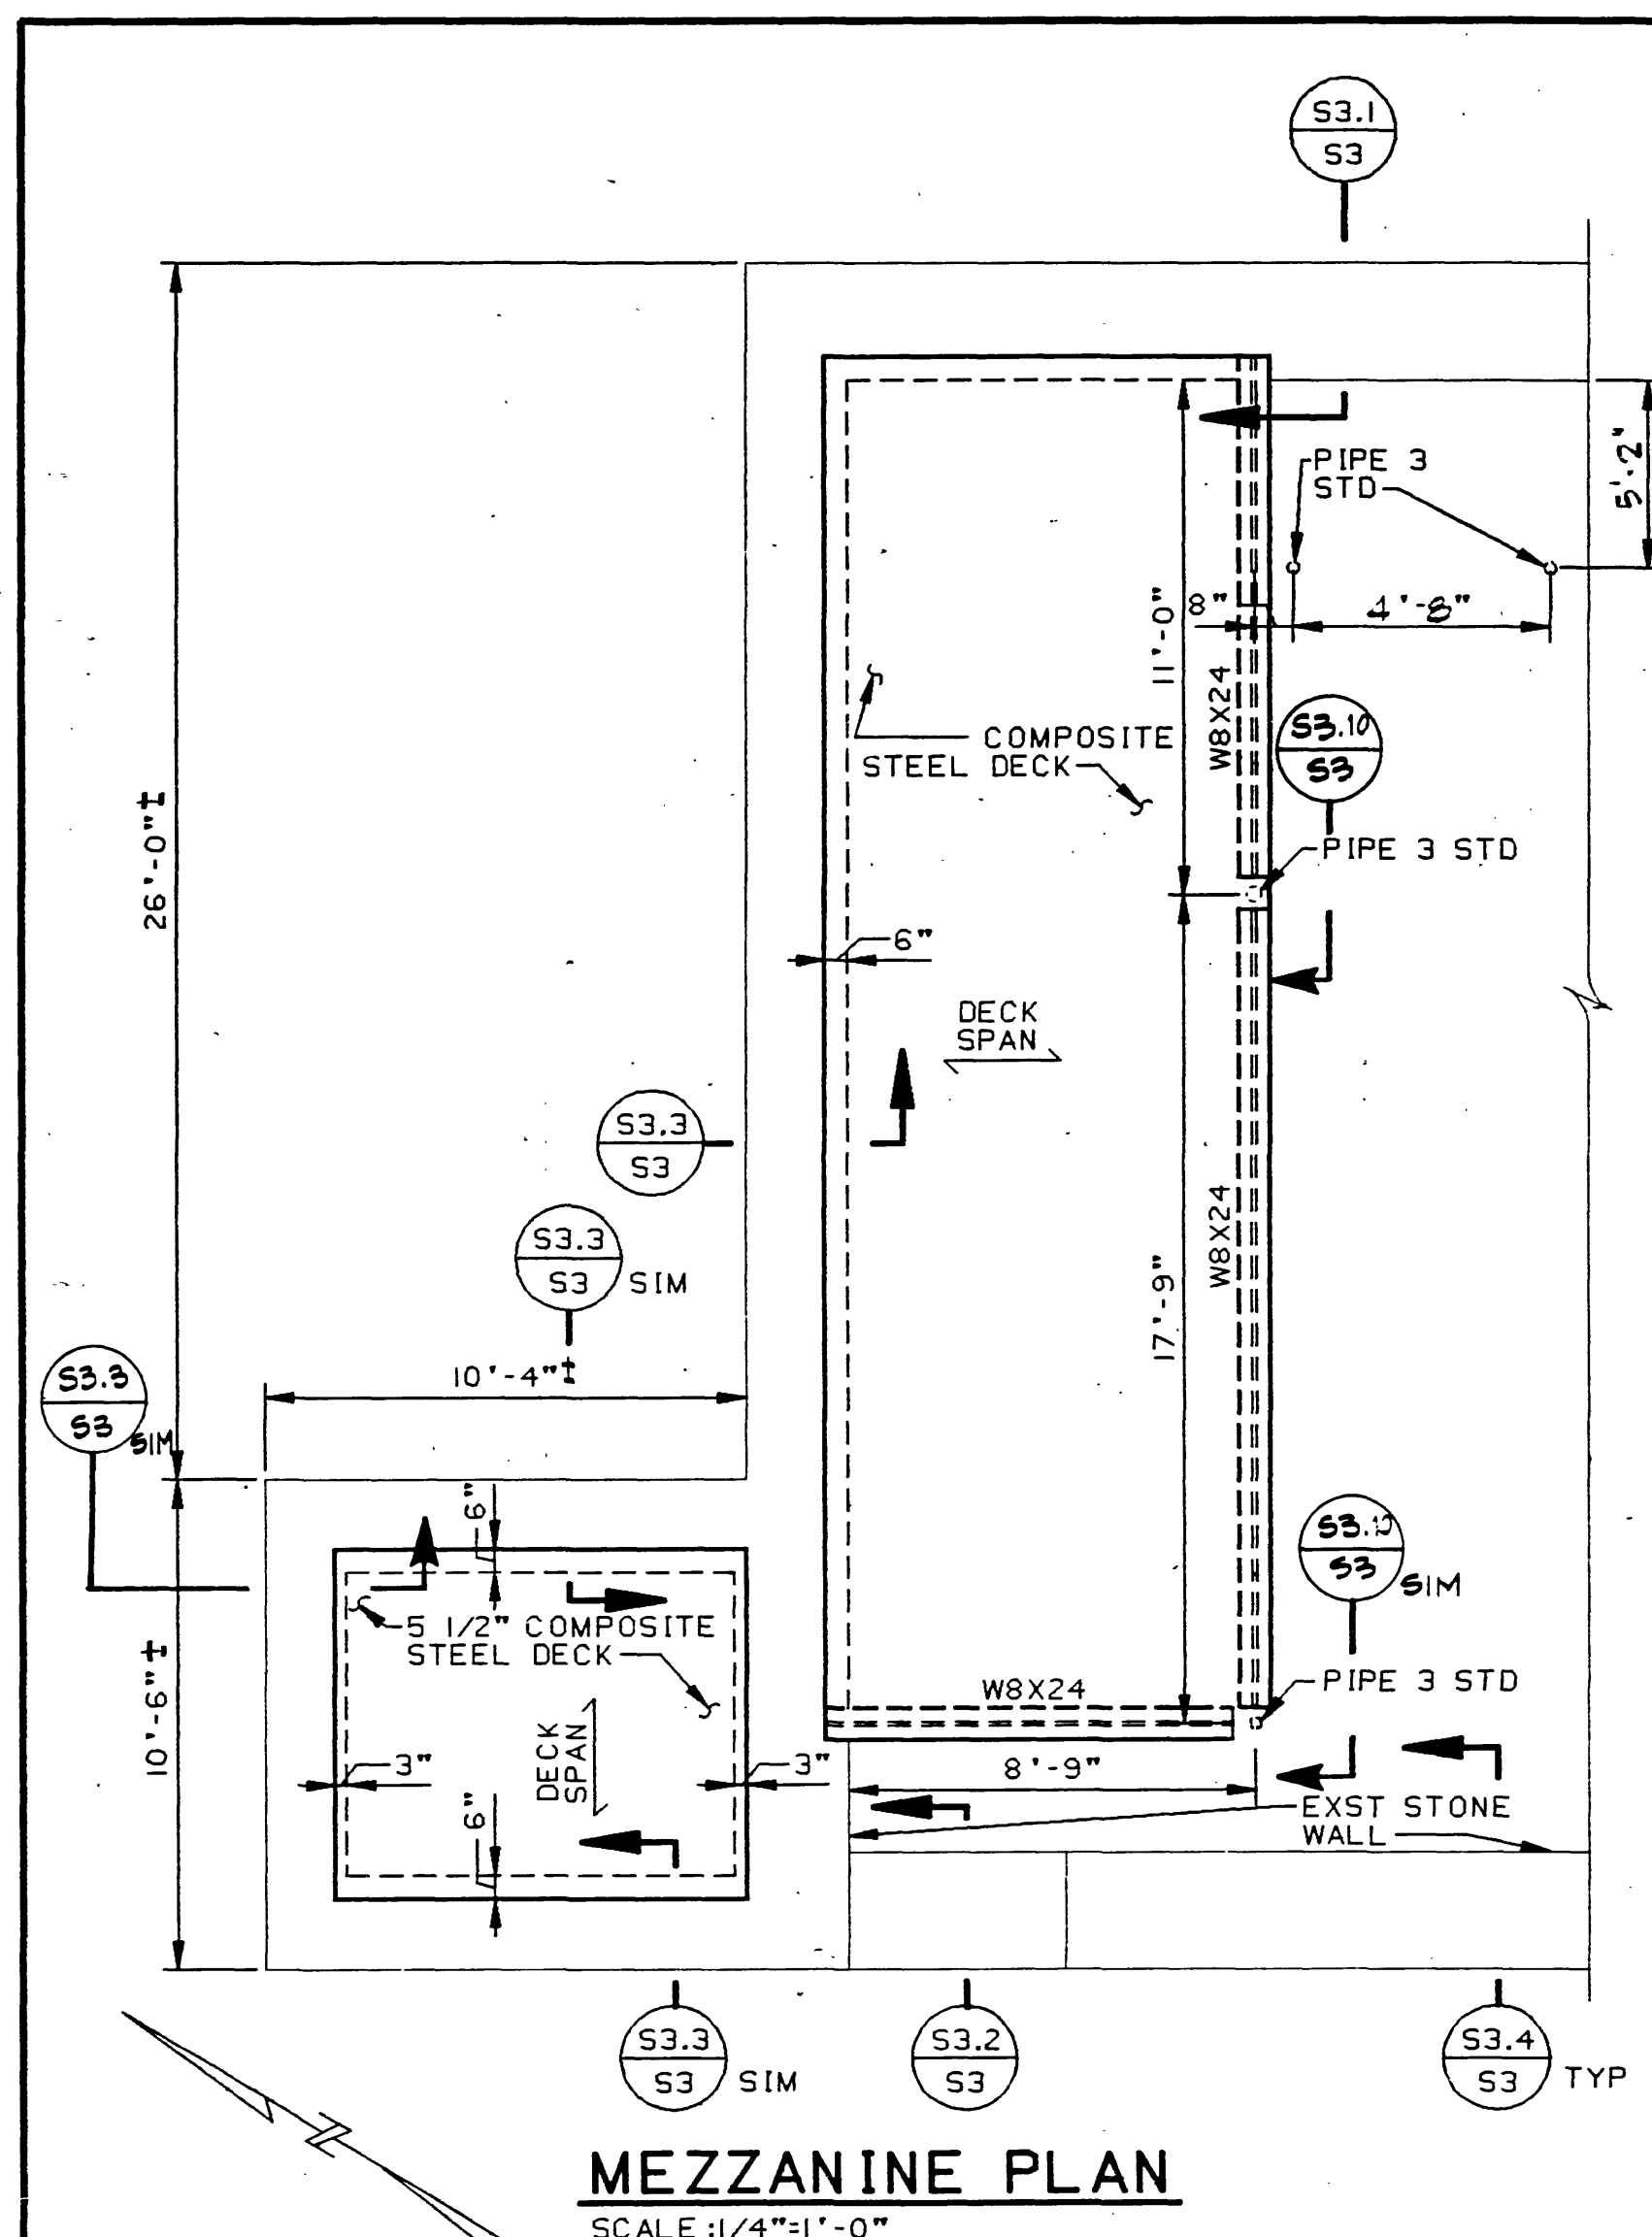
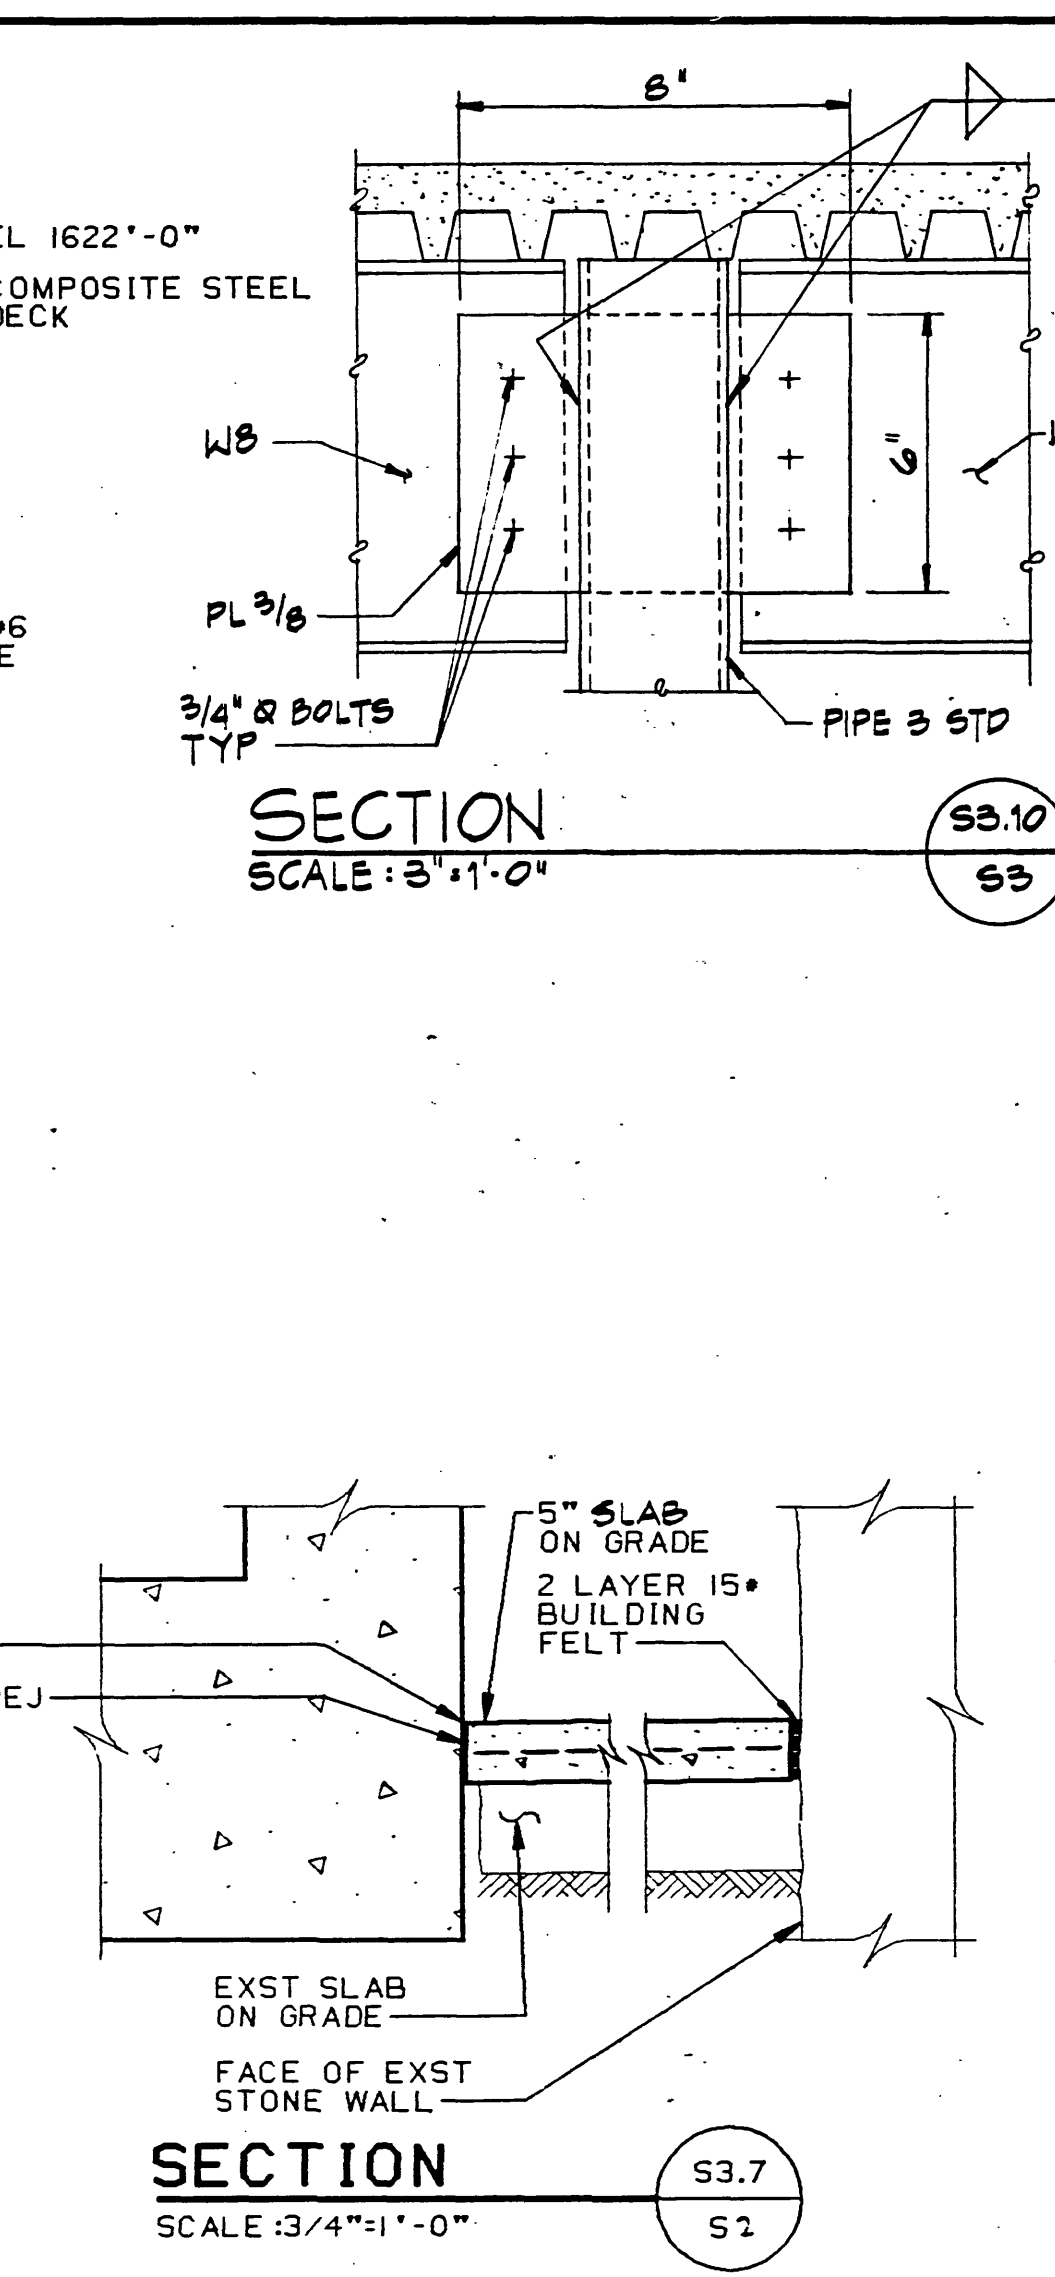
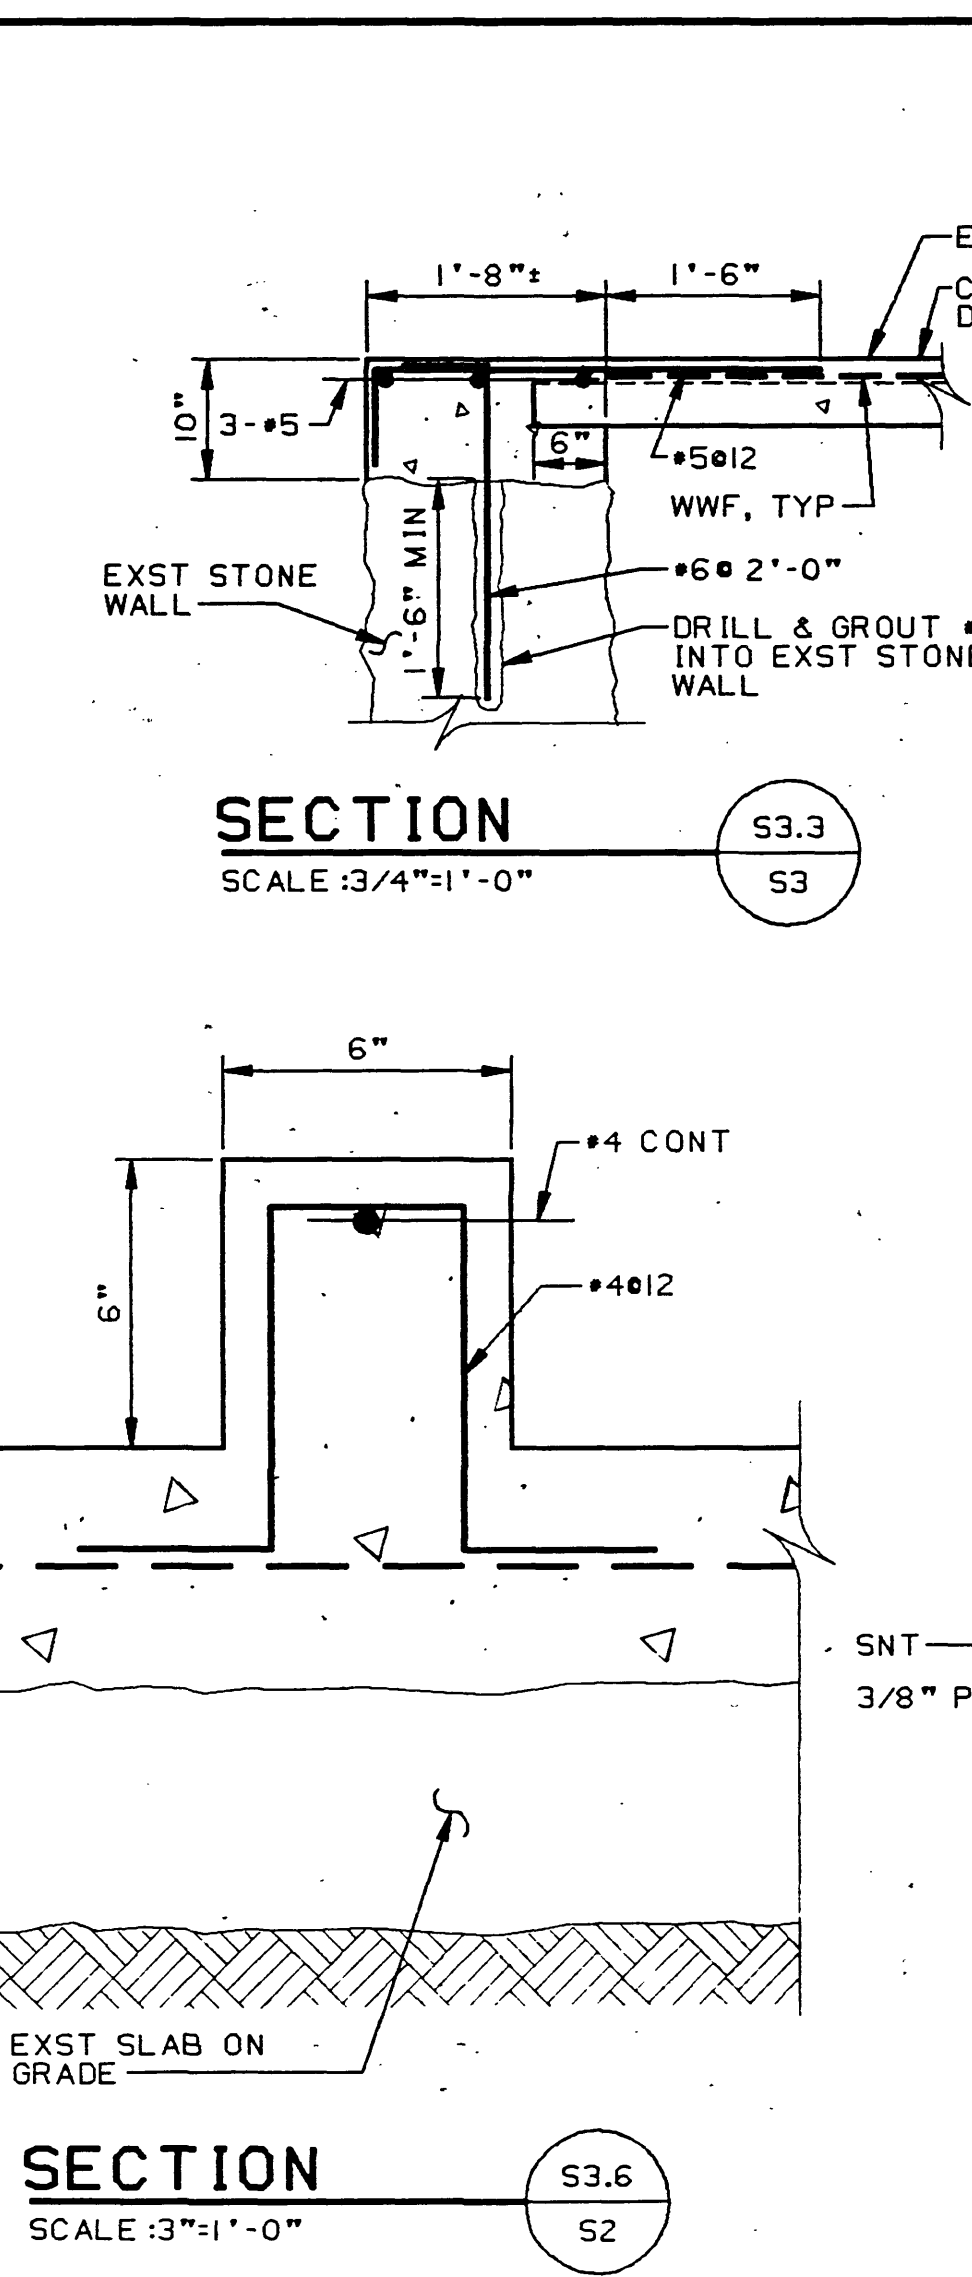



051889 REV. C DRAW 1 4X JBB 4296.FALLCREEK.S3

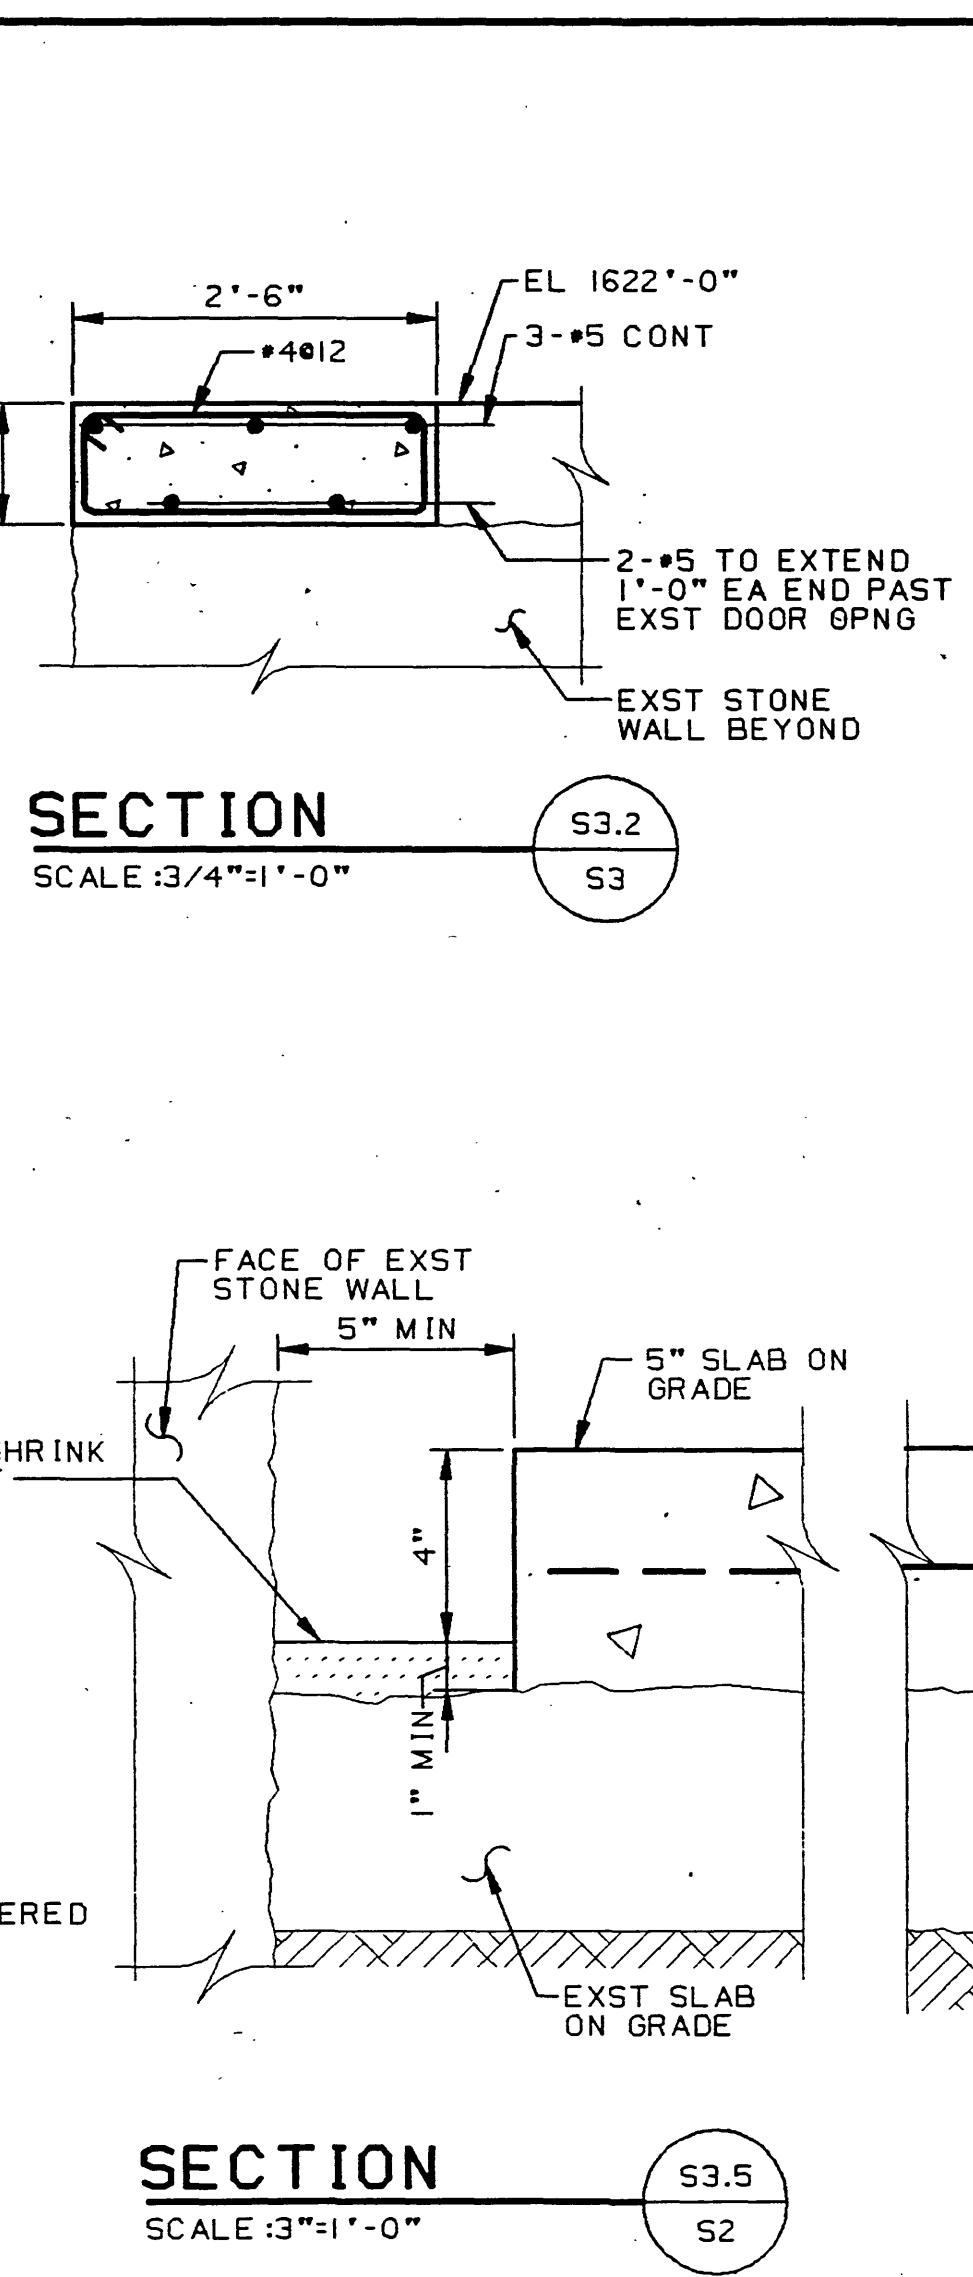



MEZZANINE PLAN

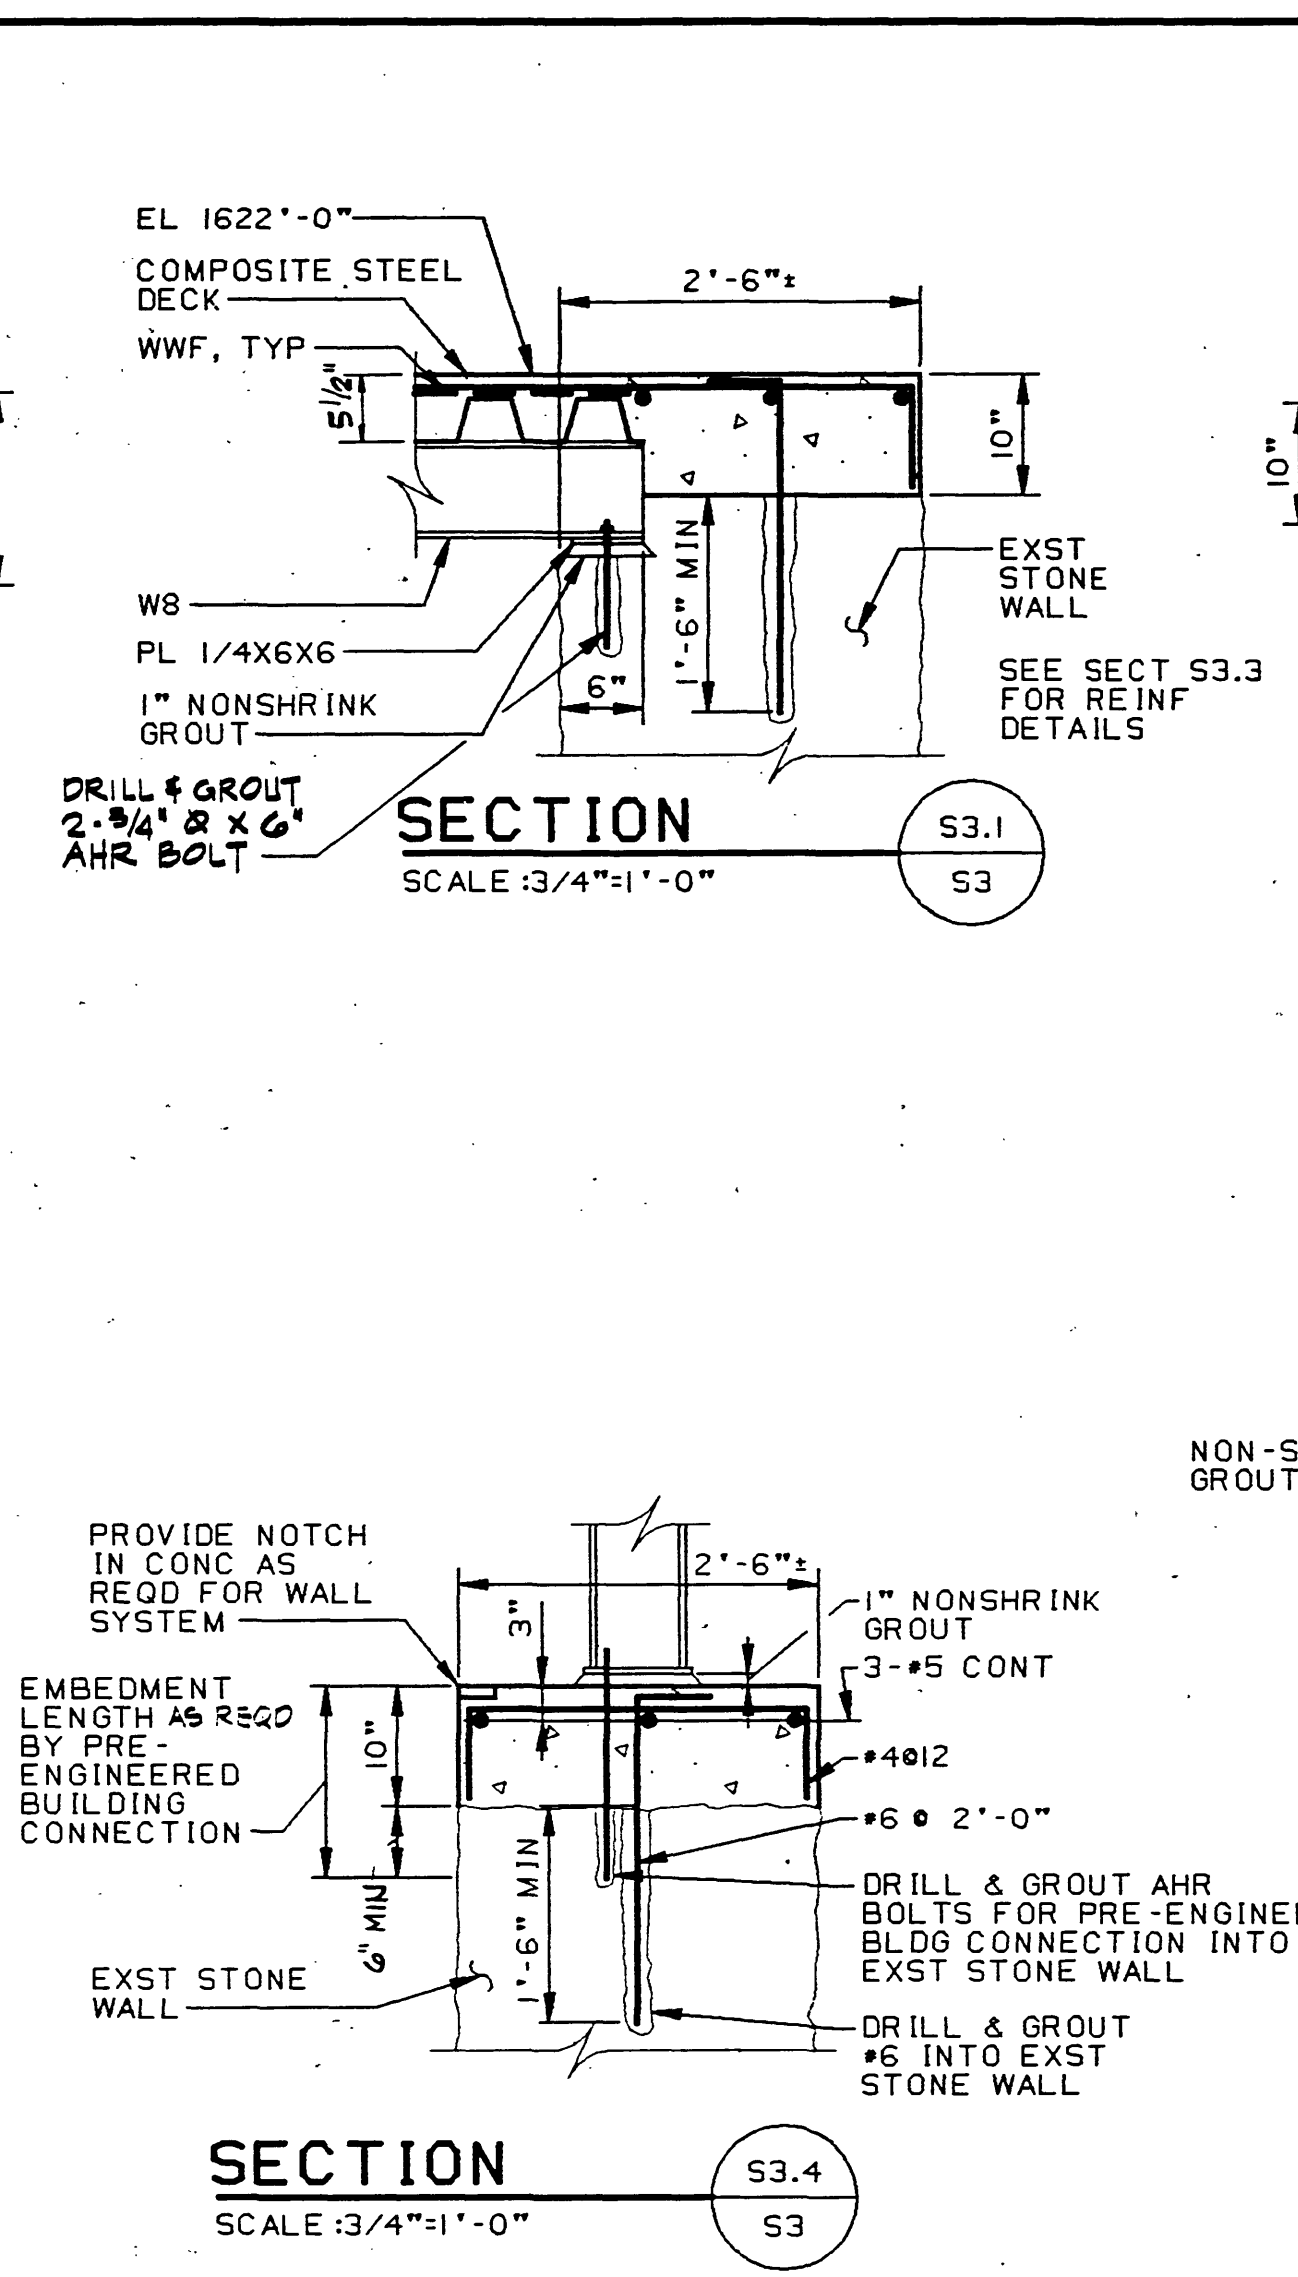


- GENERAL NOTES**
1. CLASSIFICATION OF CONSTRUCTION - TYPE - 2C UNPROTECTED NONCOMBUSTIBLE, IN ACCORDANCE WITH THE VIRGINIA UNIFORM STATEWIDE BUILDING CODE (SECTION 401.0/BOCA 1987).
 2. DESIGN LOADS
FILTER BUILDING:
ROOF LIVE LOAD 25 PSF
COLLATERAL LOAD 5 PSF
MEZZANINE:
LIVE LOAD 100 PSF
SUPERIMPOSED DEAD LOAD 5 PSF
INTAKE TOWER BRIDGE:
UNIFORM DISTRIB LL 60 PSF
SUPERIMPOSED DL 5 PSF
 3. WIND LOADS ARE BASED ON A BASIC WIND SPEED OF 80 MPH, EXPOSURE B, IN ACCORDANCE WITH THE VIRGINIA UNIFORM STATEWIDE BUILDING CODE (SECTION 1112.0/BOCA 1987).
 4. MATERIALS
CONCRETE CLASS A FOR ALL CONCRETE
REINFORCING BARS ASTM A 615 GRADE 60, DEFORMED $F_y = 60$ KSI
STRUCTURAL STEEL
STEEL PIPE ASTM A 53 GRADE B $F_y = 35$ KSI
ASTM A 501
ALL OTHER STRUCTURAL STEEL ASTM A 36 $F_y = 36$ KSI
FOUNDATION BEARING CAPACITY 2000 PSF
 5. **1622'** INDICATES ELEVATION OF TOP OF FOOTING. FOOTING ELEVATIONS SHOWN REPRESENT THE MINIMUM DEPTH TO WHICH FOOTINGS SHALL BE CARRIED. FOOTING SHALL BE LOWERED AS REQUIRED TO OBTAIN SUITABLE BEARING. ALL UNSUITABLE FOUNDATION MATERIAL SHALL BE REMOVED WITH FOOTINGS RESTING ON UNDISTURBED SOIL WITH A MINIMUM BEARING CAPACITY OF 2000 PSF UNLESS OTHERWISE SHOWN OR INDICATED.
 6. WHERE ROCK IS ENCOUNTERED IN ANY FOOTING EXCAVATION, UNDERCUT TO A DEPTH OF NOT LESS THAN 6 INCHES BELOW ELEVATION OF BOTTOM OF FOOTING AND BACKFILL WITH THOROUGHLY COMPACTED #10 FINES.
 7. NO FOUNDATION CONCRETE SHALL BE INSTALLED UNTIL ALL FOUNDATION WORK HAS BEEN COORDINATED WITH UNDERGROUND UTILITIES. FOOTINGS SHALL BE LOWERED WHERE REQUIRED TO AVOID UTILITIES.
 8. ALL REINFORCEMENT SHALL BE DETAILED, FABRICATED AND PLACED IN ACCORDANCE WITH ACI 318-80 UNLESS OTHERWISE SHOWN. MINIMUM SPLICE LENGTHS AND EMBEDMENT LENGTHS SHALL BE AS TABULATED THEREIN.
 9. UNLESS OTHERWISE SHOWN, REINFORCEMENT AT WALL CORNERS AND INTERSECTIONS SHALL BE DETAILED AS SHOWN ON FIGURE 11 OF ACI 318-80. REINFORCEMENT SHALL BE DETAILED AS SHOWN FOR INSIDE AND OUTSIDE LOADED CORNERS. INTERSECTIONS AND CORNERS SHALL BE DETAILED WITHOUT DIAGONAL REINFORCEMENT. ALL LAP SPLICES SHALL BE CLASS C.
 10. MAJOR CONSTRUCTION JOINTS ARE SHOWN ON THE DRAWINGS. INTERMEDIATE JOINTS IN WALLS, SLABS, AND FLOOR FRAMING ARE NOT SHOWN. CONSTRUCTION JOINTS MAY BE ADDED, Omitted IF PROPERLY DETAILED ON SHOP DRAWINGS AND APPROVED BY THE ARCHITECT-ENGINEER.
 11. CONTINUOUS REINFORCING IN WALLS AND SLABS MAY BE SPLICED, AS REQUIRED, PROVIDING BARS ARE OF THE LONGEST PRACTICABLE LENGTH AND ALL SPLICES ARE SHOWN ON REINFORCING SHOP DRAWINGS. WHERE POSSIBLE, SPLICES SHALL BE STAGGERED. FIELD CUTTING OF REINFORCEMENT WILL NOT BE PERMITTED.
 12. UNLESS OTHERWISE NOTED, PROVIDE CONCRETE PROTECTION FOR ALL REINFORCING IN ACCORDANCE WITH PARAGRAPH 7.7 OF BUILDING CODE REQUIREMENTS FOR REINFORCED CONCRETE (ACI 318-80). CONCRETE PROTECTION FOR CONCRETE SHALL BE 3/4" MIN. CONCRETE "EXPOSURE TO WEATHER".
 13. PROVIDE DOWELS TO MATCH REINFORCEMENT IN ALL FOOTINGS, WALLS, AND SLABS.
 14. SPREAD REINFORCEMENT AT OPENINGS AND SLEEVES UNLESS OTHERWISE SHOWN. DO NOT CUT REINFORCEMENT.
 15. SLABS AND BEAMS SHALL BE CAST MONOLITHICALLY.
 16. PROVIDE ADEQUATE INSPECTION PANELS IN WALL FORMING TO FACILITATE CONCRETE PLACEMENT TO ENSURE THAT ADEQUATE COMPACTION IS OBTAINED AND NO VOIDING OCCURS.
 17. PROVIDE WATERSTOPS IN CONSTRUCTION JOINTS IN WALLS AND BEAMS TO PREVENT LEAKAGE OF LIQUID-CONTAINING SLABS.
 18. REINFORCE ALL FLOOR SLABS ON GRADE IN ACCORDANCE WITH THE FOLLOWING SCHEDULE, UNLESS OTHERWISE NOTED ON CENTER REINFORCEMENT IN SLAB UNLESS OTHERWISE NOTED.
- | SLAB THICKNESS | REINFORCEMENT |
|----------------|-------------------|
| 5" | 6X6-W2.9XW2.9 WWF |
19. UNLESS OTHERWISE NOTED, PROVIDE 2-#5X4'-0" DIAGONAL BARS IN THE MIDDLE OF THE SLAB AT EACH CORNER OF ALL OPENINGS IN THE SLAB OVER 1'-0" SQUARE.
 20. THE CENTERLINES OF ALL COLUMNS AND BEAMS SHALL BE LOCATED ON COLUMN LINES UNLESS OTHERWISE SHOWN.
 21. ALL BOLTS SHALL BE 3/4" DIAMETER UNLESS OTHERWISE SHOWN OR NOTED. ALL MAJOR FRAMING CONNECTIONS SHALL BE MADE WITH ASTM A 325 BOLTS. CONNECTIONS FOR SECONDARY FRAMING SHALL BE MADE WITH ASTM A 307 BOLTS.
 22. WELDING ELECTRODES SHALL CONFORM TO REQUIREMENTS SHOWN IN TABLE 4.11 OF AWS D1.1-88, AND FILLER METAL SHALL HAVE A MINIMUM YIELD STRENGTH OF 55 KSI.
 23. SHEAR CONNECTIONS SHALL BE DESIGNED FOR REACTIONS INDICATED ON THE FRAMING PLANS. WHERE NONE ARE INDICATED, SIMPLY SUPPORTED BEAMS SHALL BE DESIGNED FOR AN END REACTION EQUAL TO $W/2L$ AS TABULATED IN THE BEAM TABLES OF THE AISC MANUAL, EIGHTH EDITION, PLUS 2% KIPS.
 24. WHERE THE WORK OF OTHER TRADES REQUIRES CUTS, HOLES, ETC. IN STRUCTURAL STEEL MEMBERS, CUTS, HOLES, ETC. SHALL BE MADE IN THE SHOP AND SHALL BE SHOWN ON THE SHOP DRAWINGS. MAKING HOLES OR CUTS IN STRUCTURAL STEEL MEMBERS IN THE FIELD WILL NOT BE PERMITTED WITHOUT SPECIFIC APPROVAL OF THE ARCHITECT-ENGINEER.
 25. THE CONTRACTOR SHALL VERIFY THE SIZE AND LOCATION OF ALL OPENINGS, SLEEVES, INSERTS, ETC., WITH SHOP DRAWINGS OF THE EQUIPMENT TO BE INSTALLED.
 26. THE CONTRACTOR SHALL VERIFY ALL DIMENSIONS, ELEVATIONS, ETC. NECESSARY FOR THE PROPER CONSTRUCTION AND ALIGNMENT OF THE NEW PORTIONS OF THE STRUCTURE TO THE EXISTING STRUCTURE. THE CONTRACTOR SHALL VERIFY ALL MEASUREMENTS NECESSARY FOR PROPER FABRICATION AND ERECTION OF ALL STRUCTURAL MEMBERS.

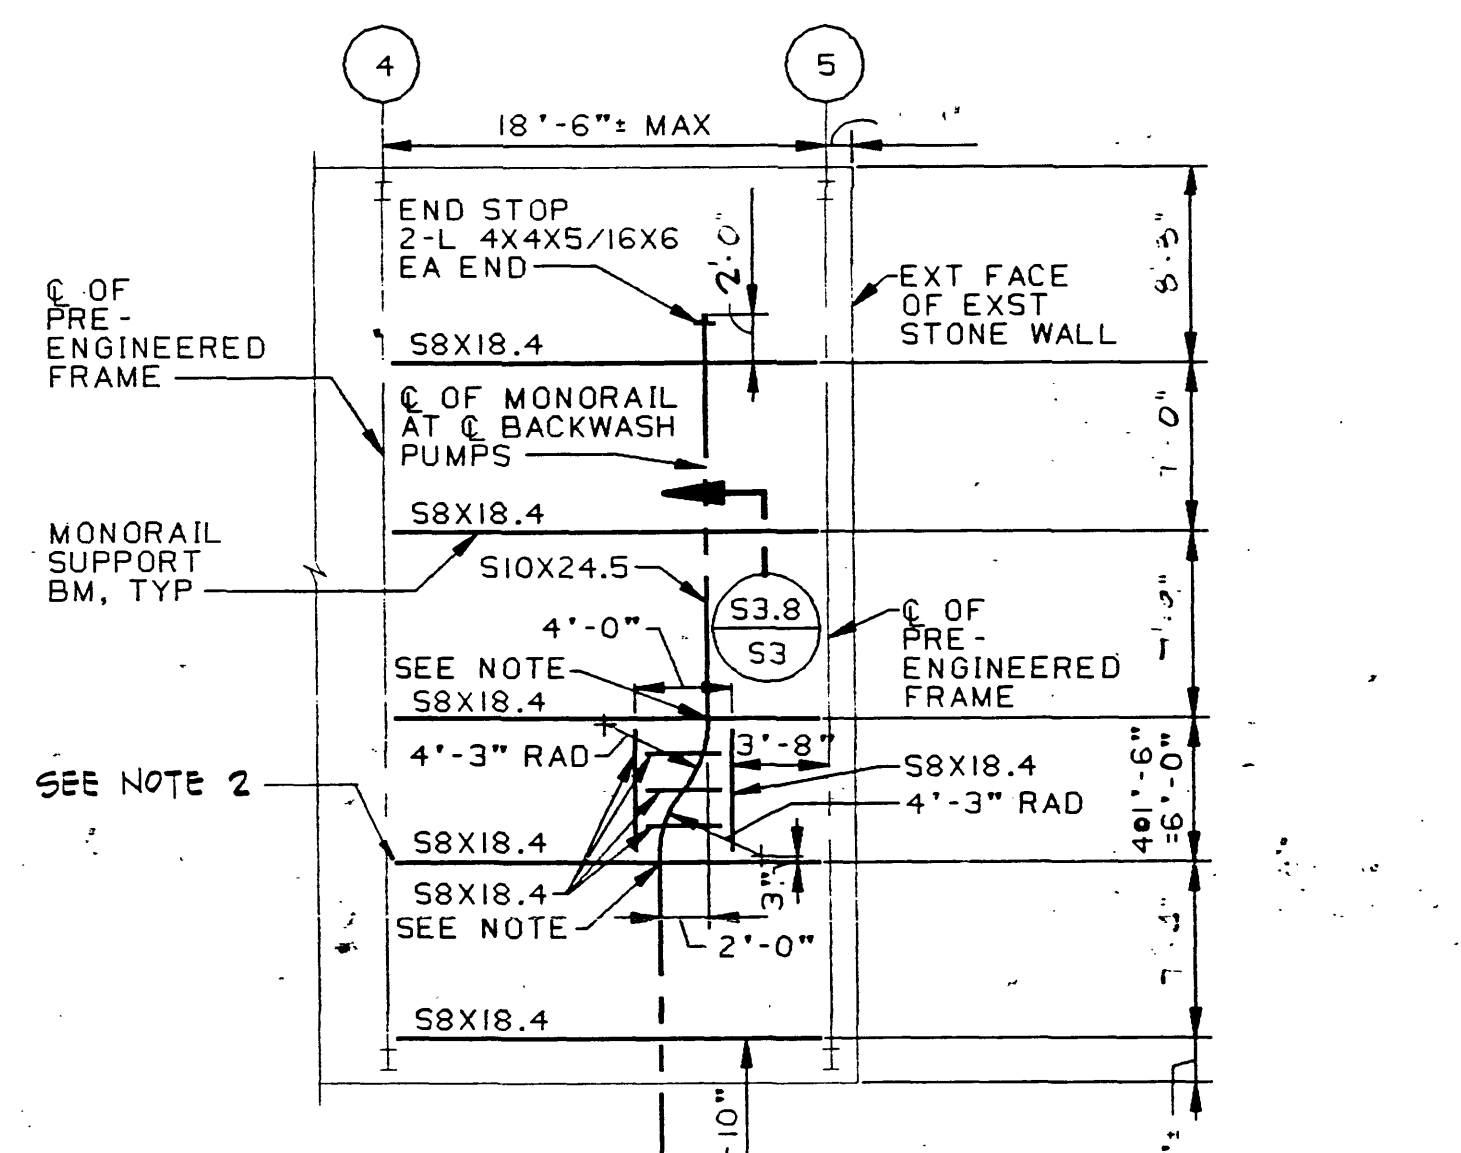


MONORAIL PLAN

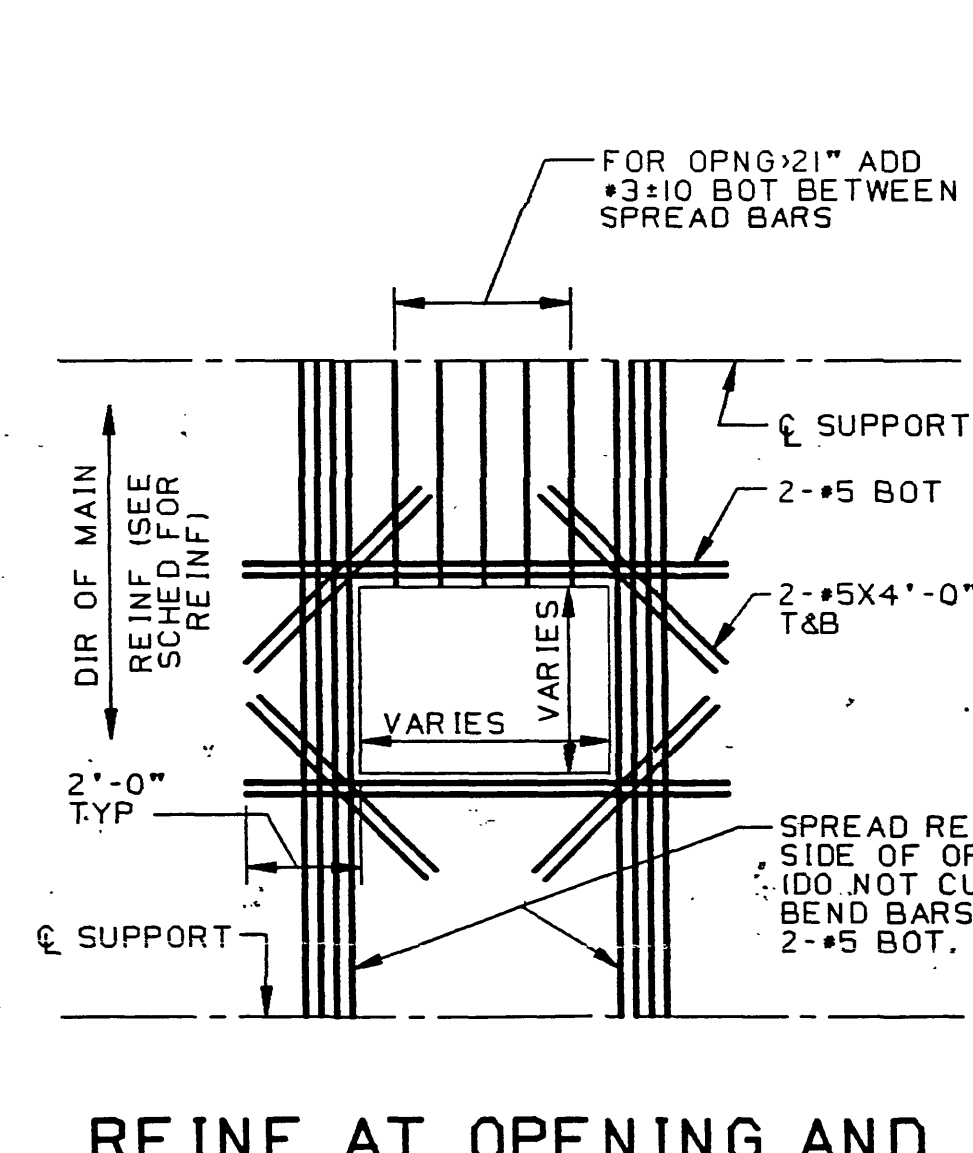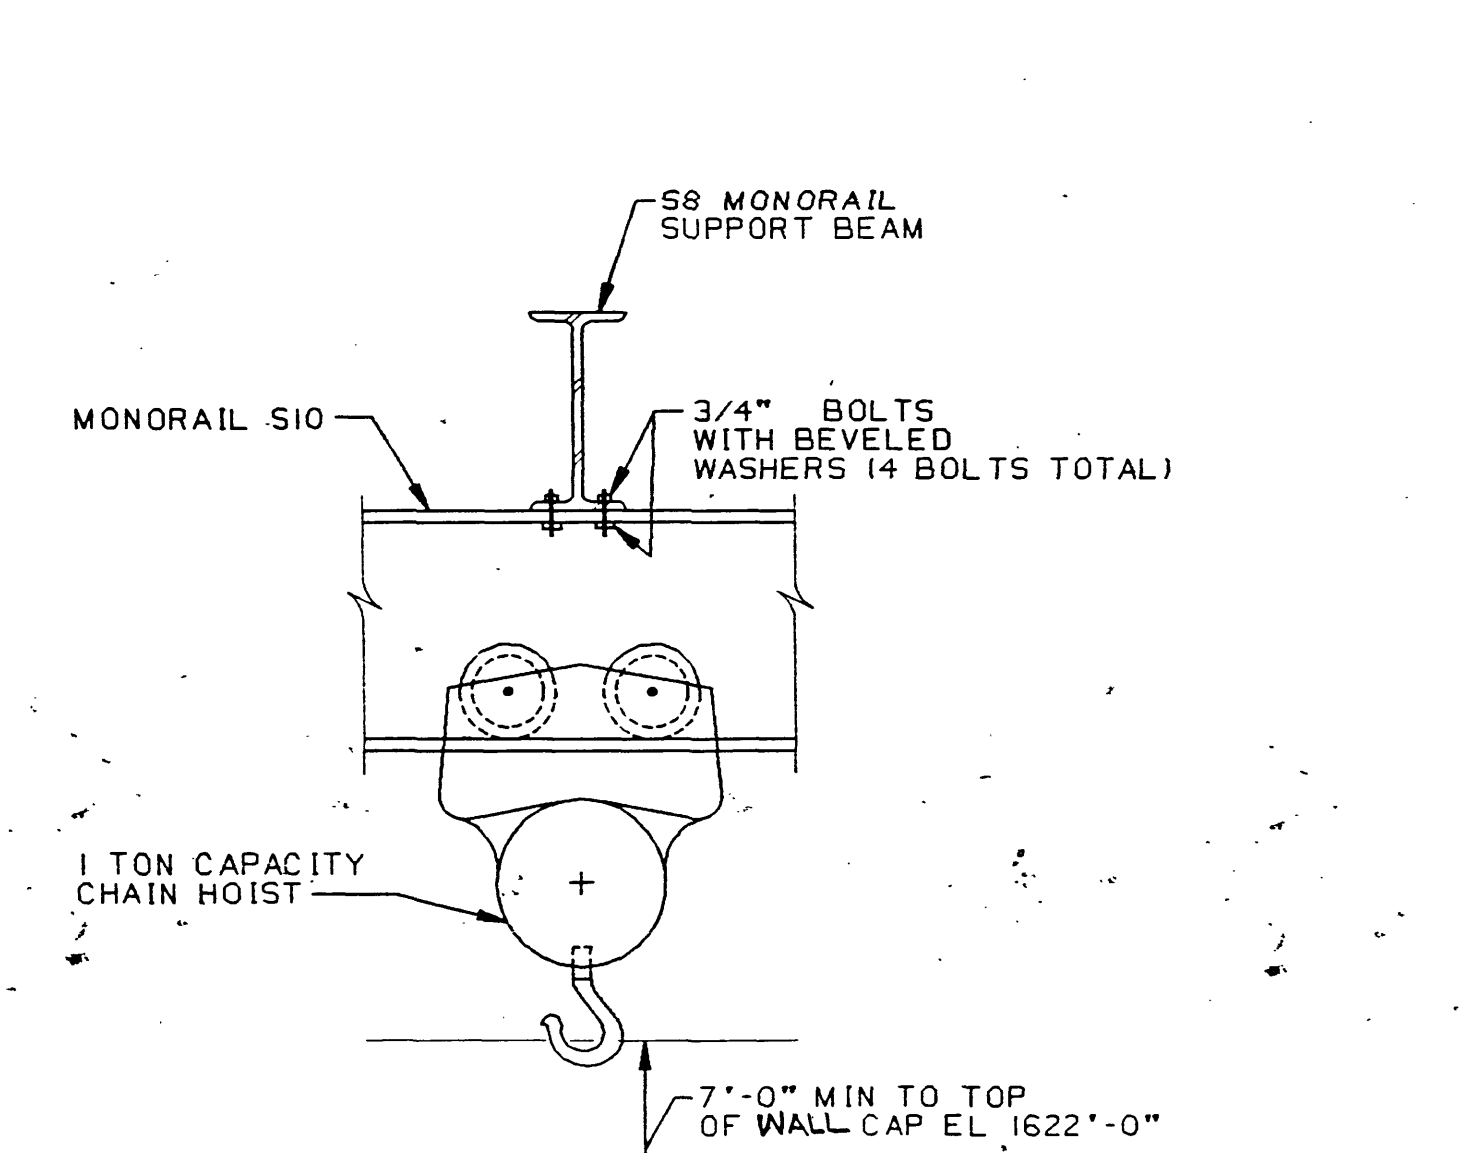


REINF AT OPENING AND DEPRESSIONS IN SLAB

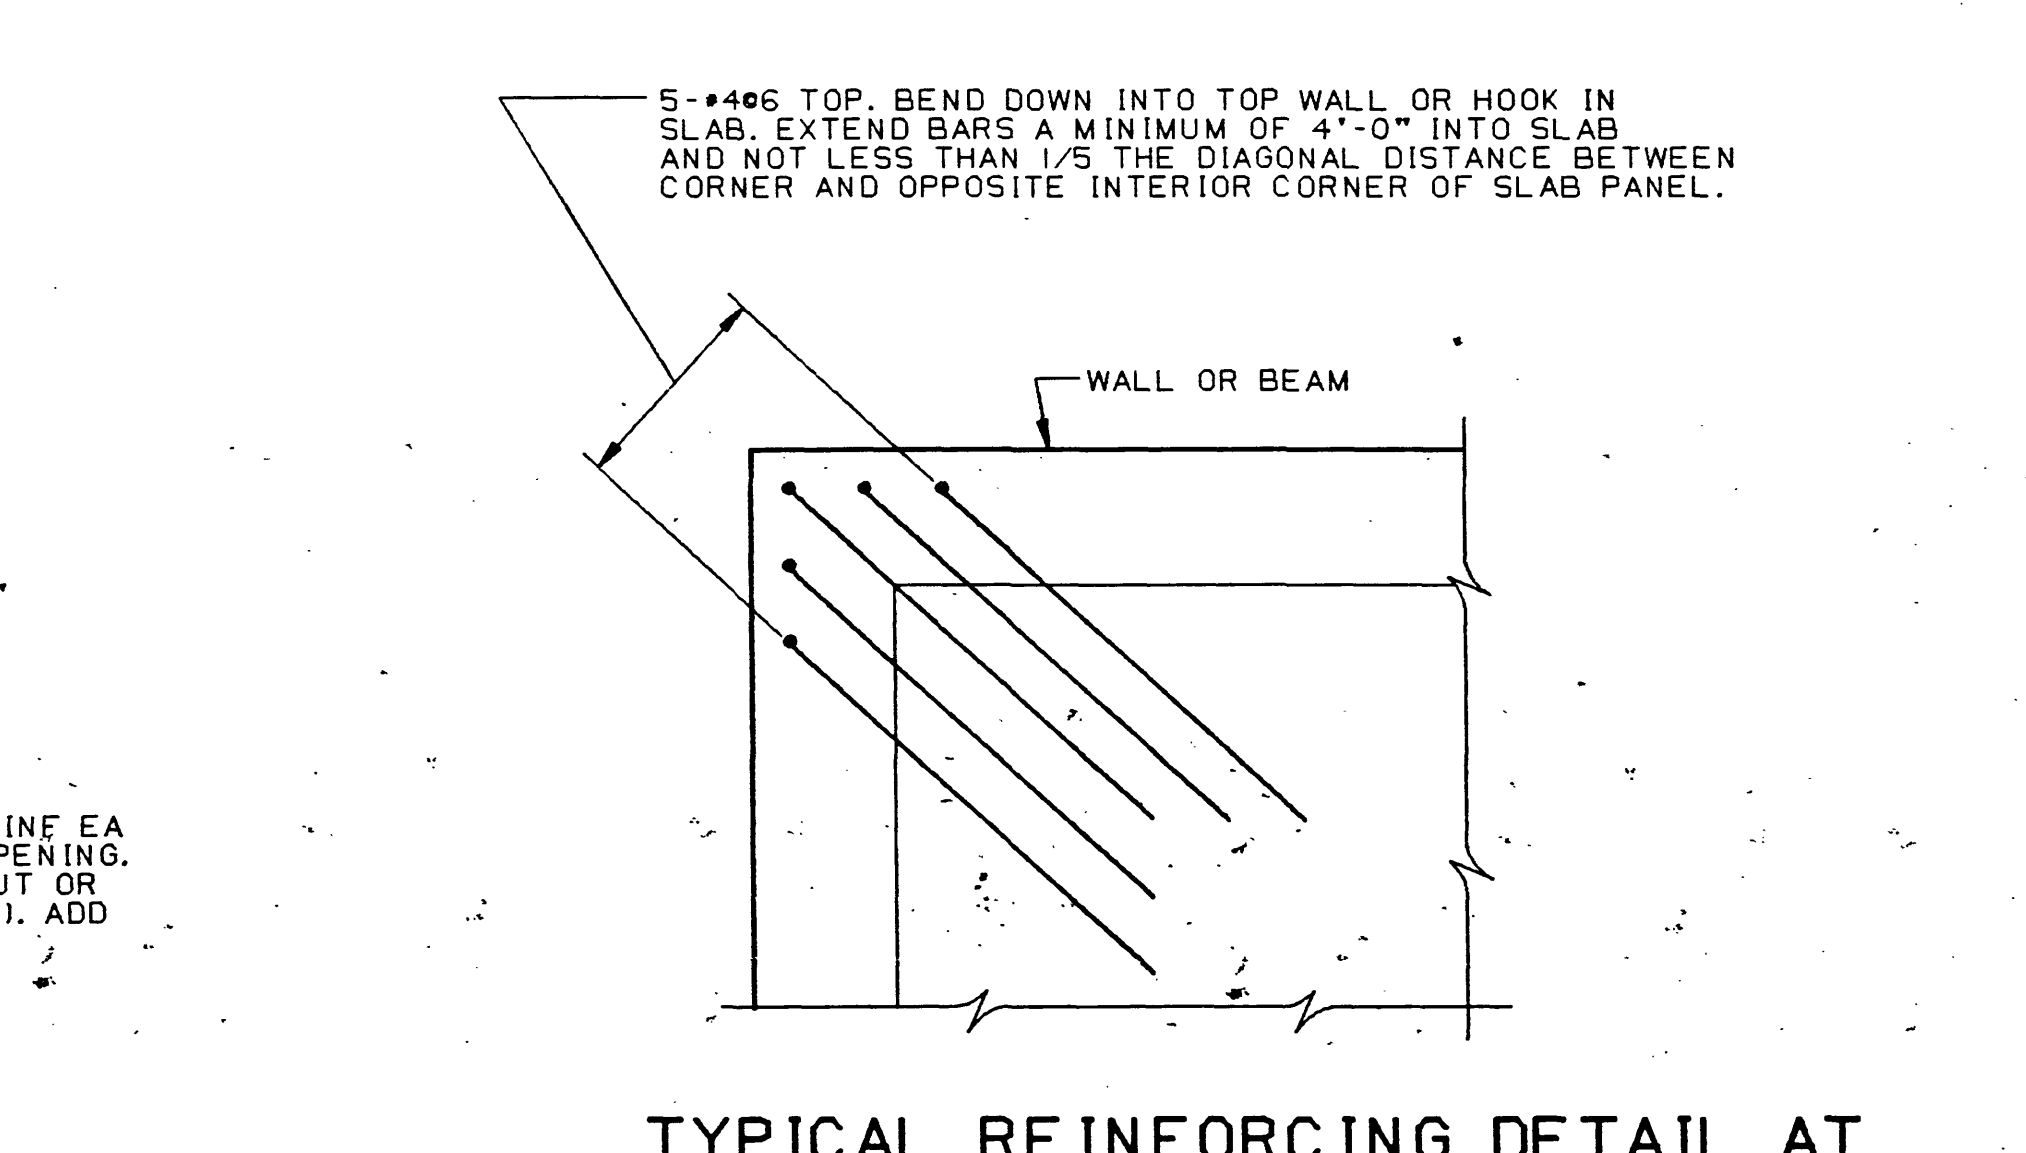


TYPICAL REINFORCING DETAIL AT EXTERIOR CORNER OF CONCRETE SLAB

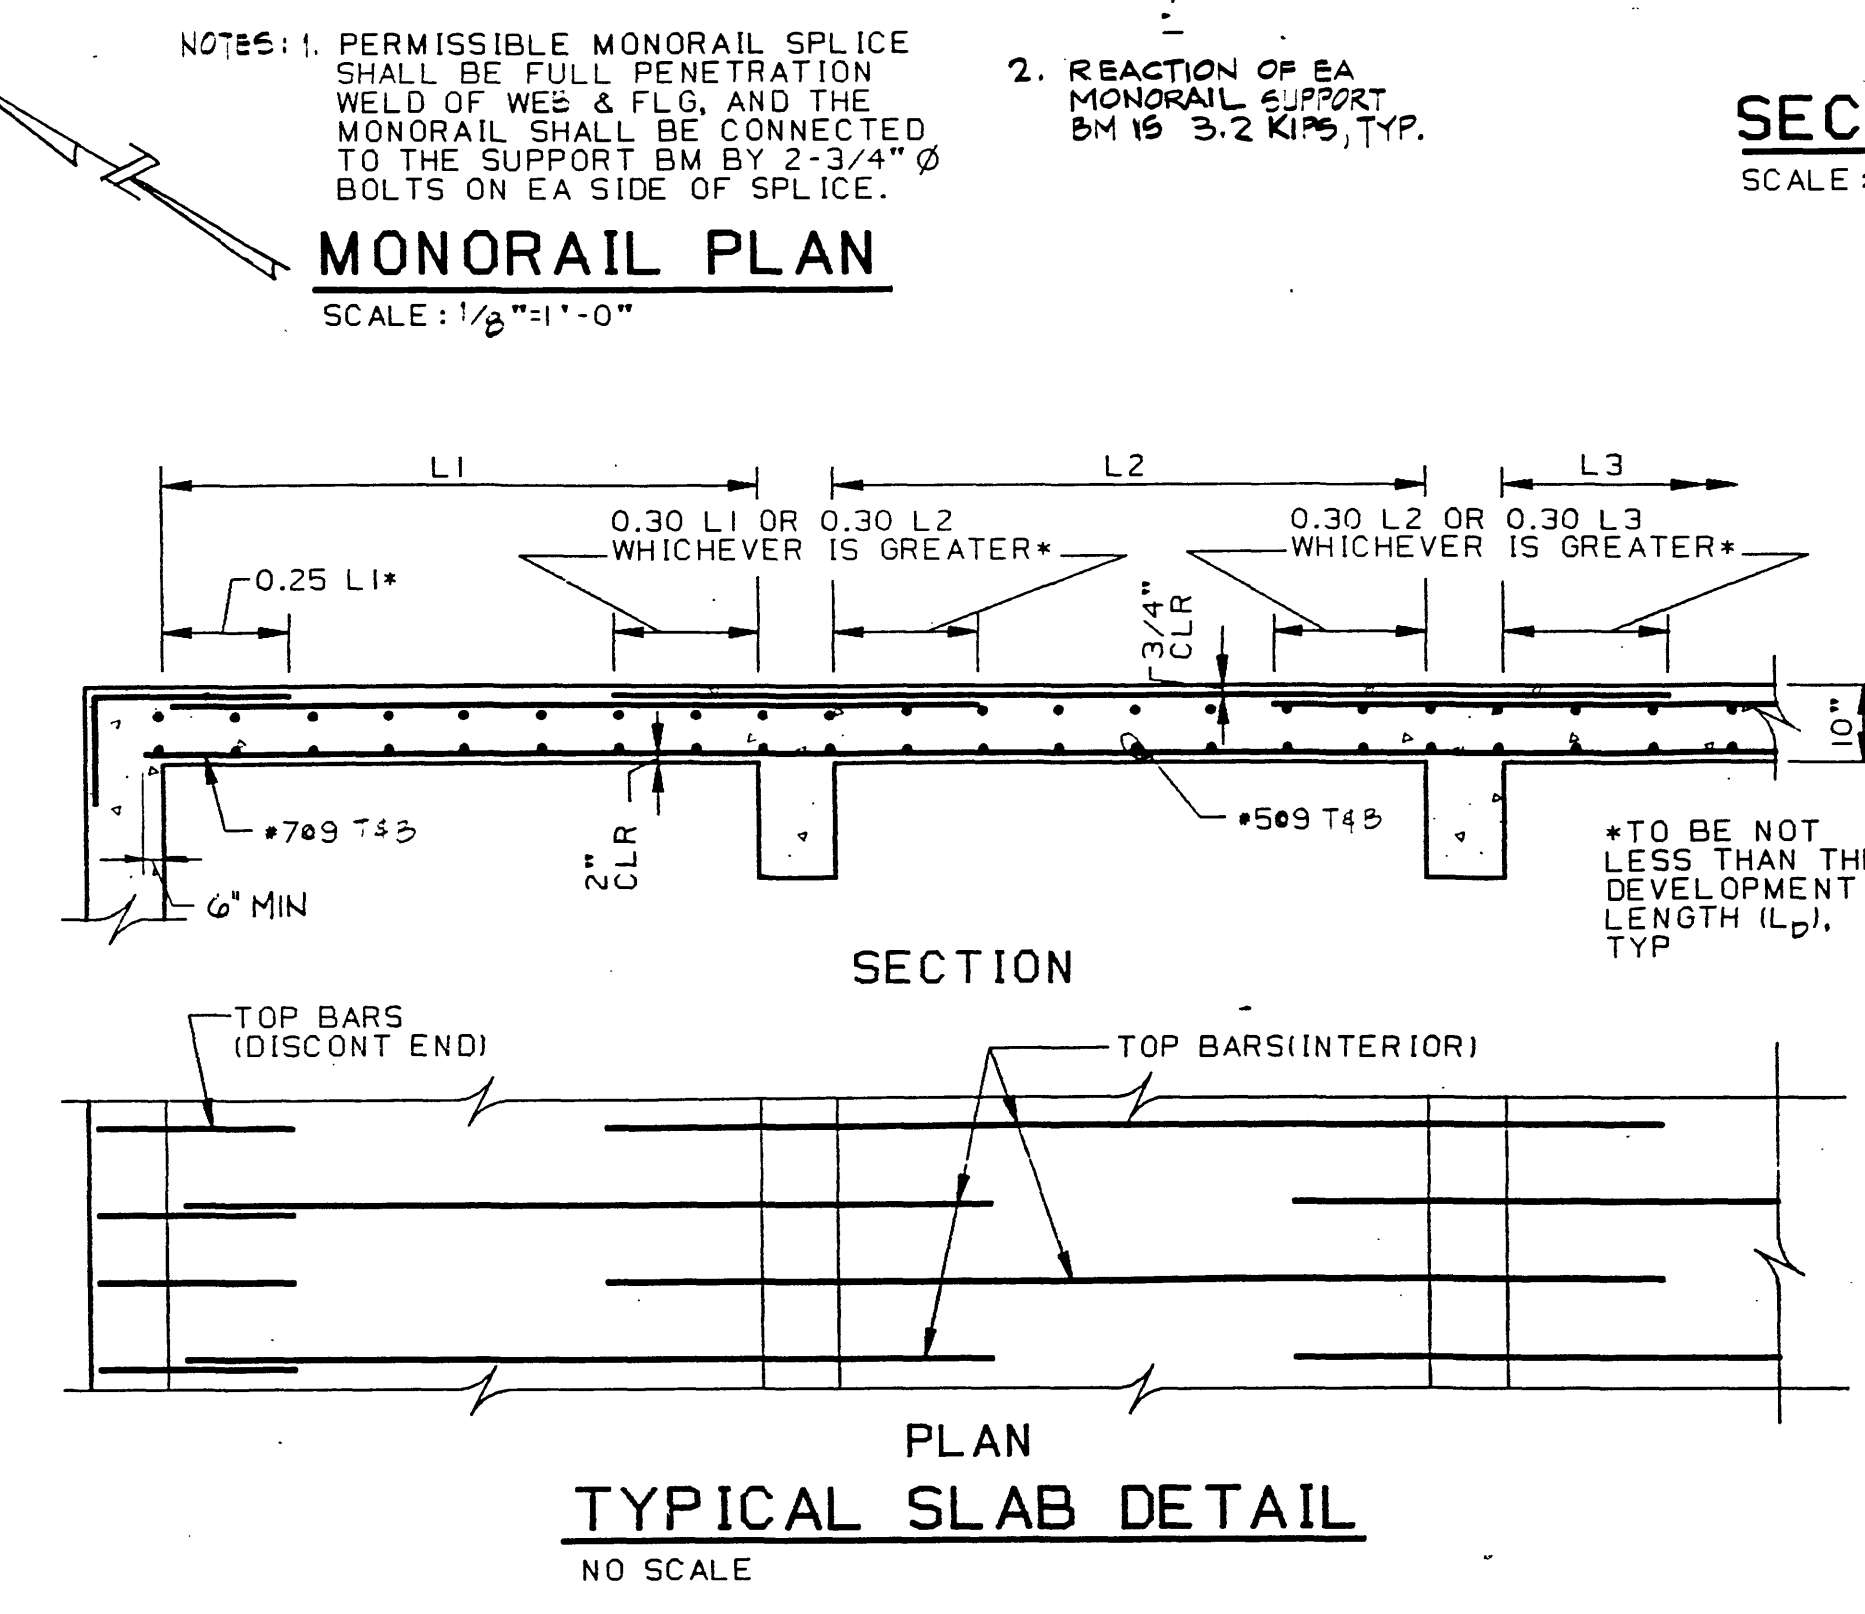


TYPICAL SLAB DETAIL

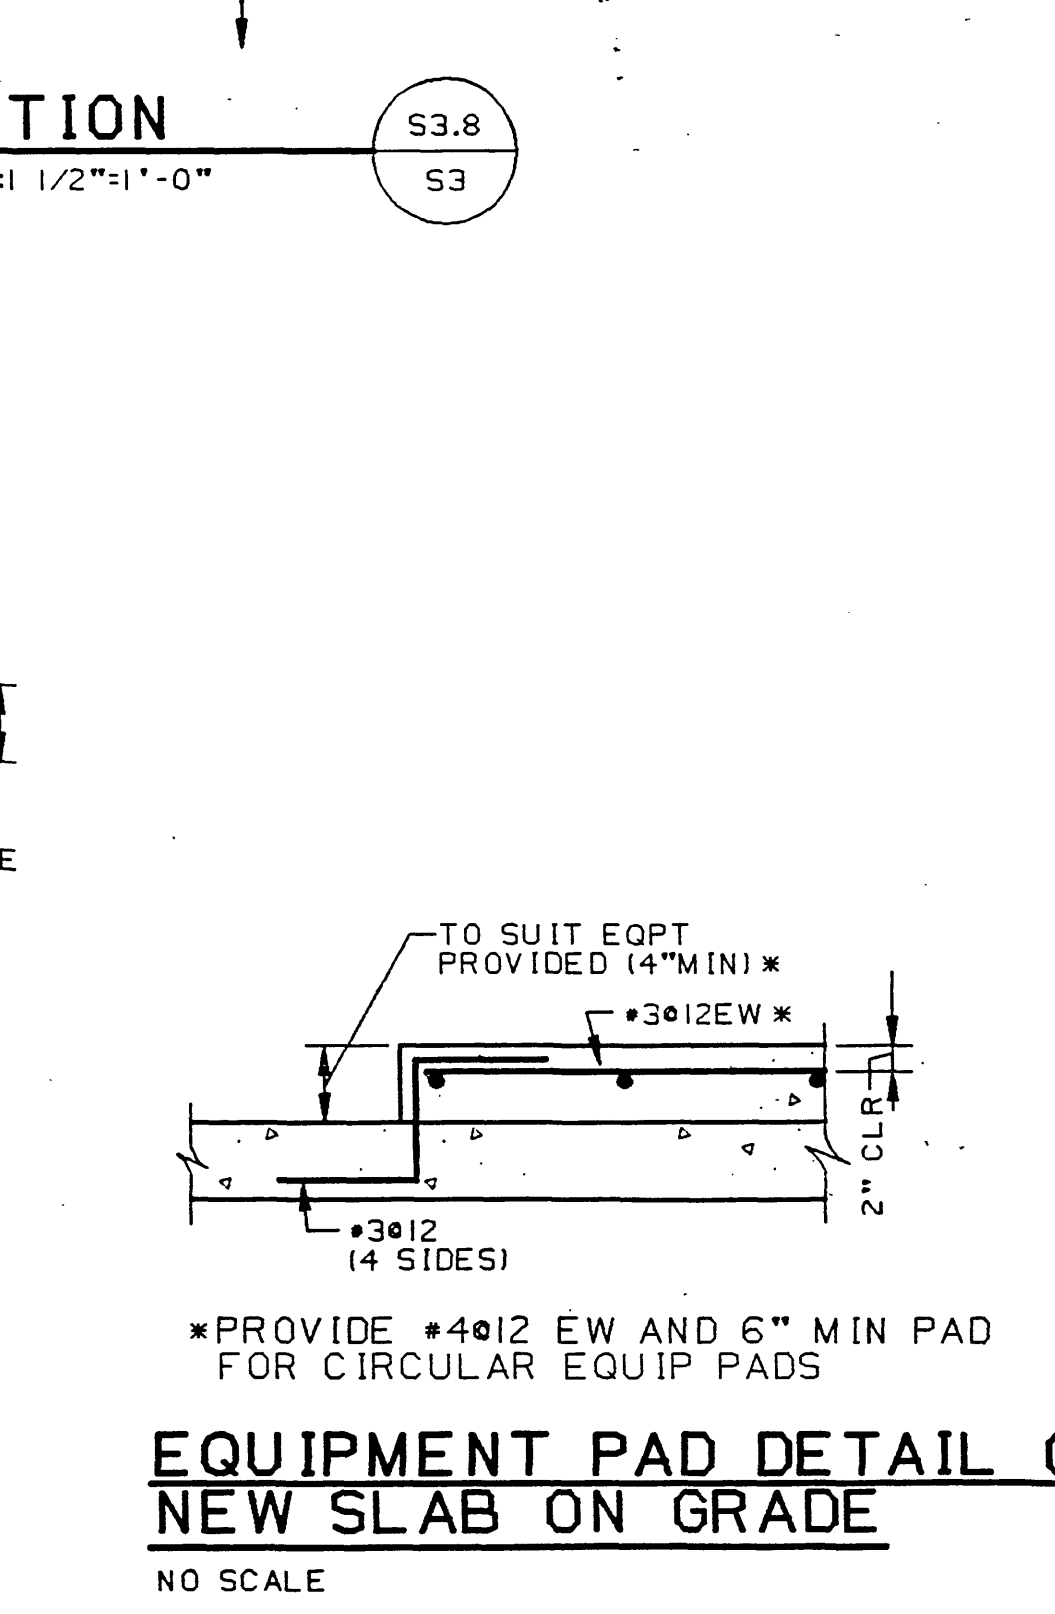

EQUIPMENT PAD DETAIL ON NEW SLAB ON GRADE

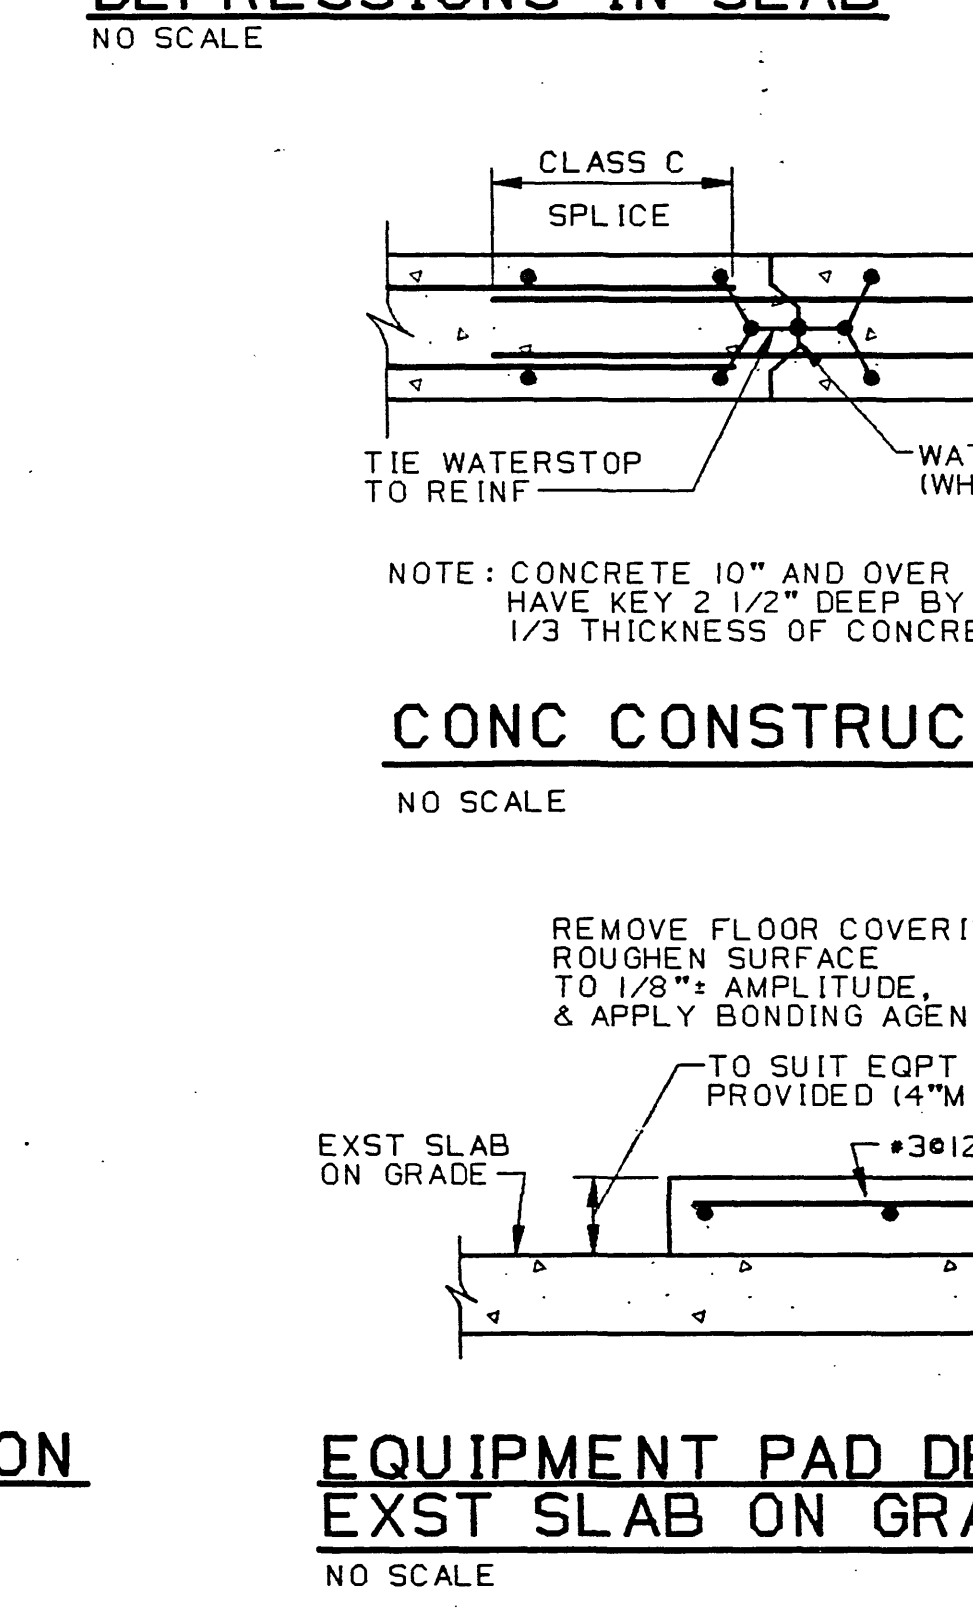

EQUIPMENT PAD DETAIL ON EXIST SLAB ON GRADE

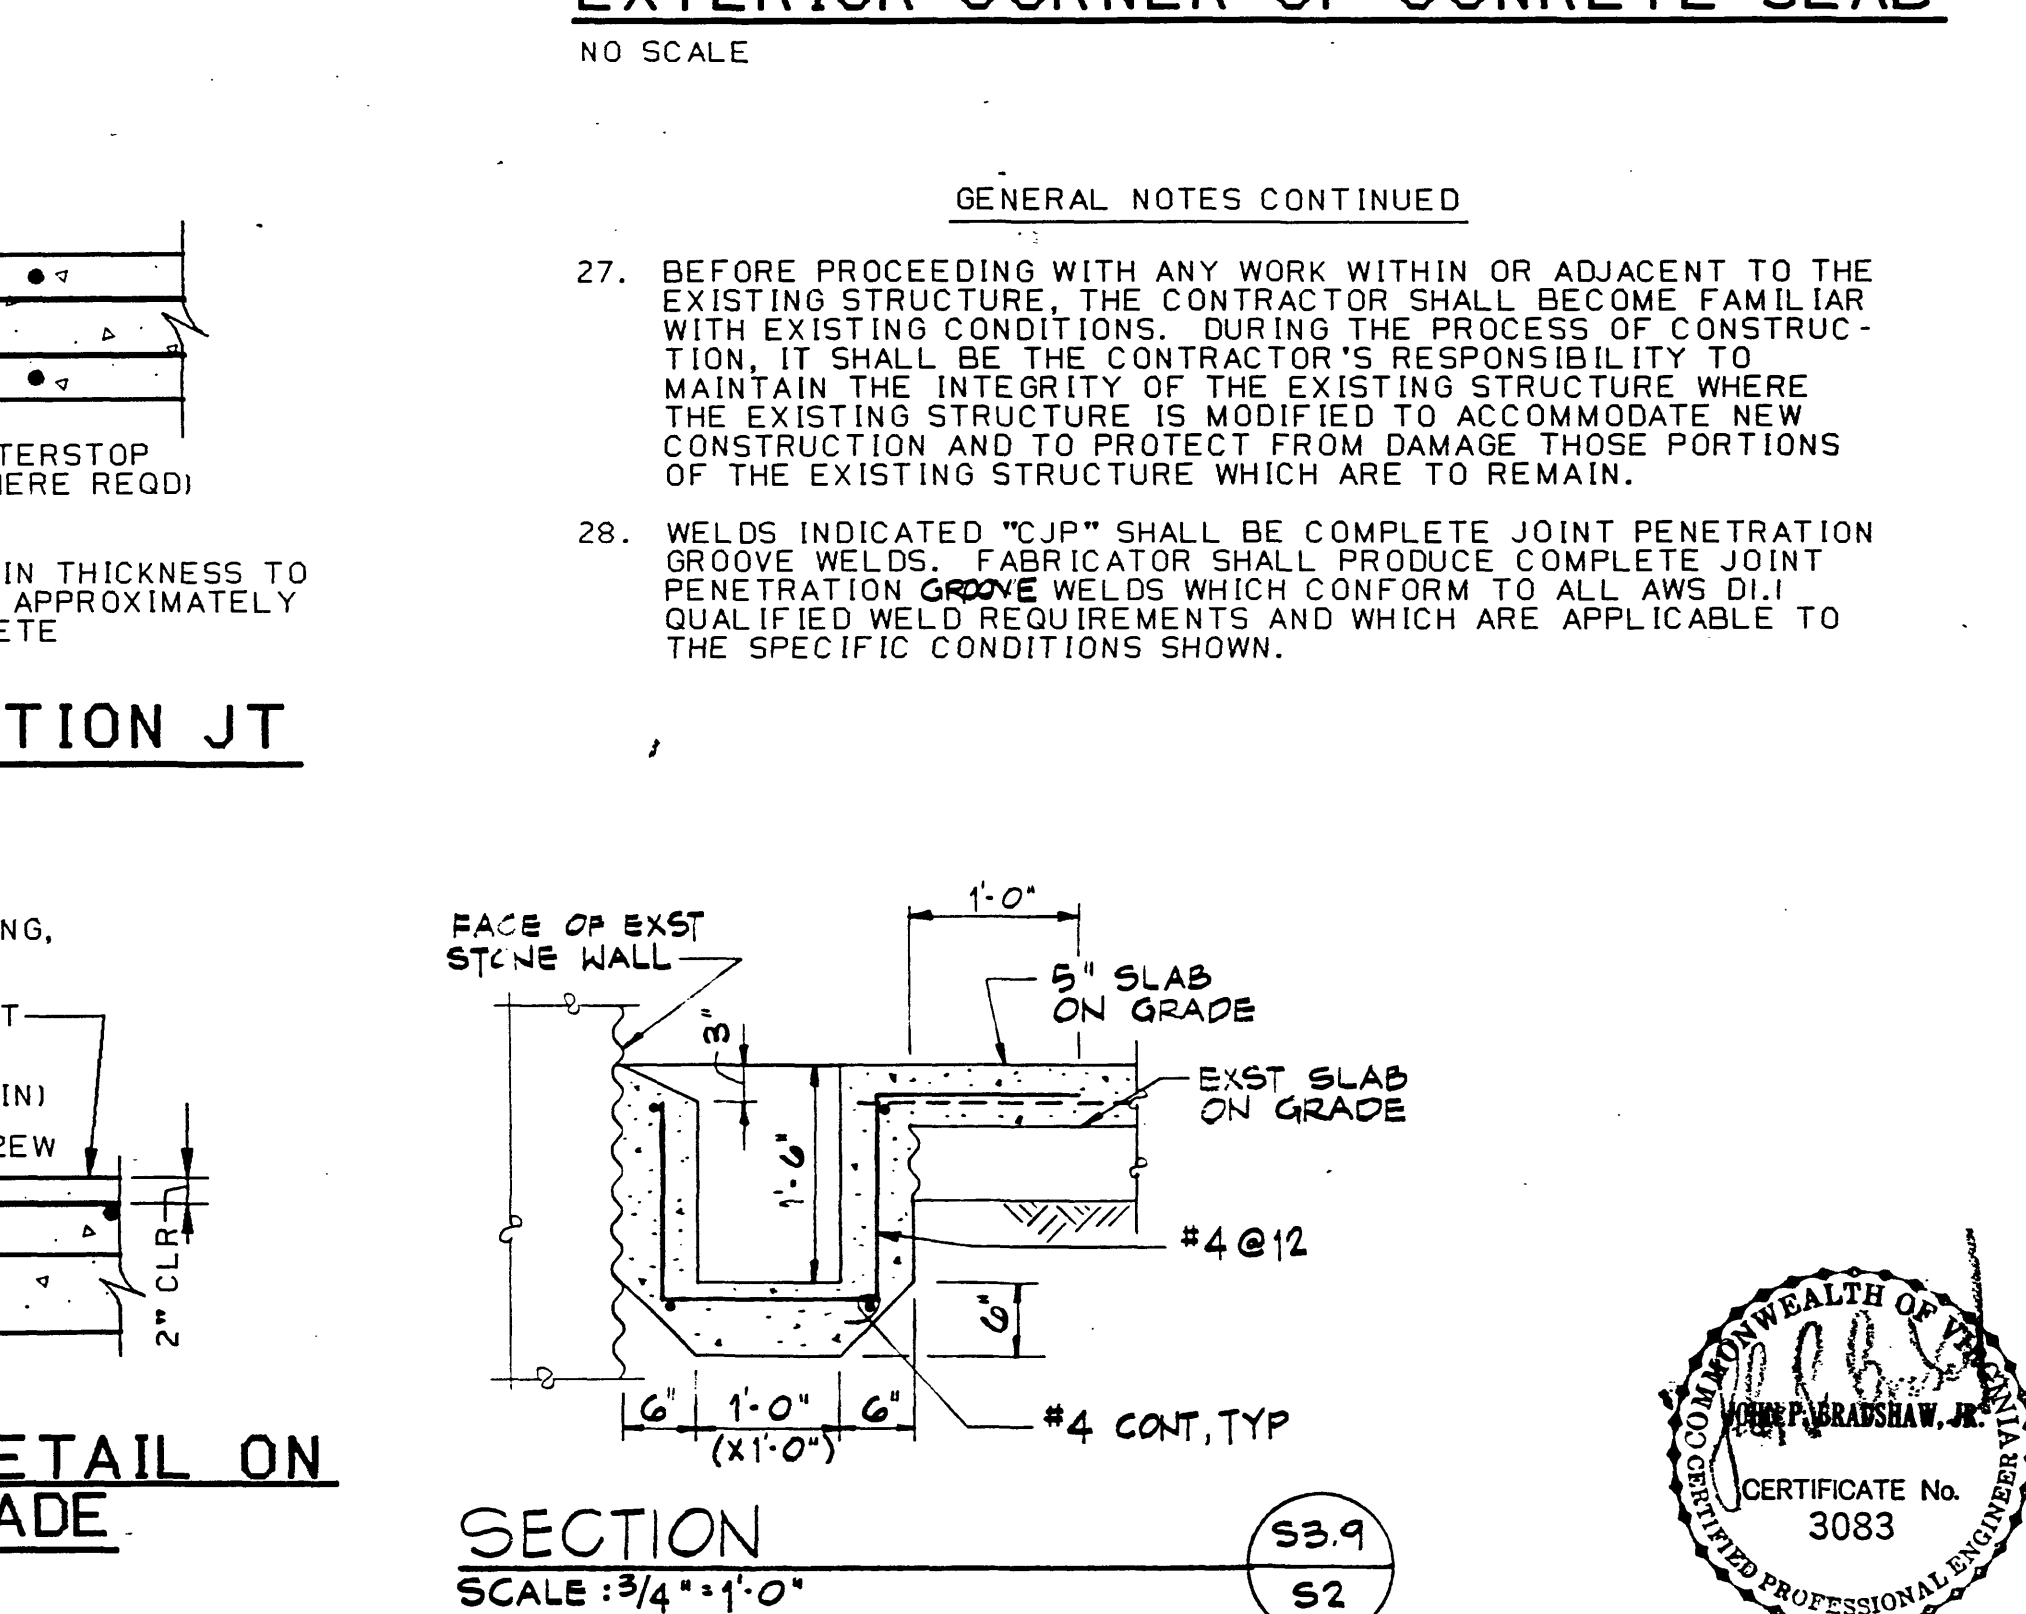

CONC CONSTRUCTION JT

GENERAL NOTES CONTINUED

27. BEFORE PROCEEDING WITH ANY WORK WITHIN OR ADJACENT TO THE EXISTING STRUCTURE, THE CONTRACTOR SHALL BECOME FAMILIAR WITH EXISTING CONDITIONS. DURING THE PROCESS OF CONSTRUCTION, IT SHALL BE THE CONTRACTOR'S RESPONSIBILITY TO MAINTAIN THE INTEGRITY OF THE EXISTING STRUCTURE WHERE THE EXISTING STRUCTURE IS MODIFIED TO ACCOMMODATE NEW CONSTRUCTION AND TO PROTECT FROM DAMAGE THOSE PORTIONS OF THE EXISTING STRUCTURE WHICH ARE TO REMAIN.
28. WELDS INDICATED "UP" SHALL BE COMPLETE JOINT PENETRATION GROOVE WELDS. FABRICATOR SHALL PRODUCE COMPLETE JOINT PENETRATION GROOVE WELDS WHICH CONFORM TO ALL AWS D1.1 QUALIFIED WELD REQUIREMENTS AND WHICH ARE APPLICABLE TO THE SPECIFIC CONDITIONS SHOWN.

REVISION	DATE	DESCRIPTION	BY	APP
8/13		RECORD DRAWING		

DESIGNED	MJM	DATE	8/13
DRAWN	CADD		
CHECKED			
APPROVED			
SUBMITTED			

FALLING CREEK WATER PLANT
CITY OF ROANOKE, VIRGINIA

GENERAL NOTES AND MISCELLANEOUS DETAILS

HAYES, SEAY, MATTERN & MATTERN
ARCHITECTS - ENGINEERS - PLANNERS
ROANOKE, VIRGINIA

SCALE AS NOTED
DATE 30 MAY 1989
COMM. NO. 4296
SHEET S3