
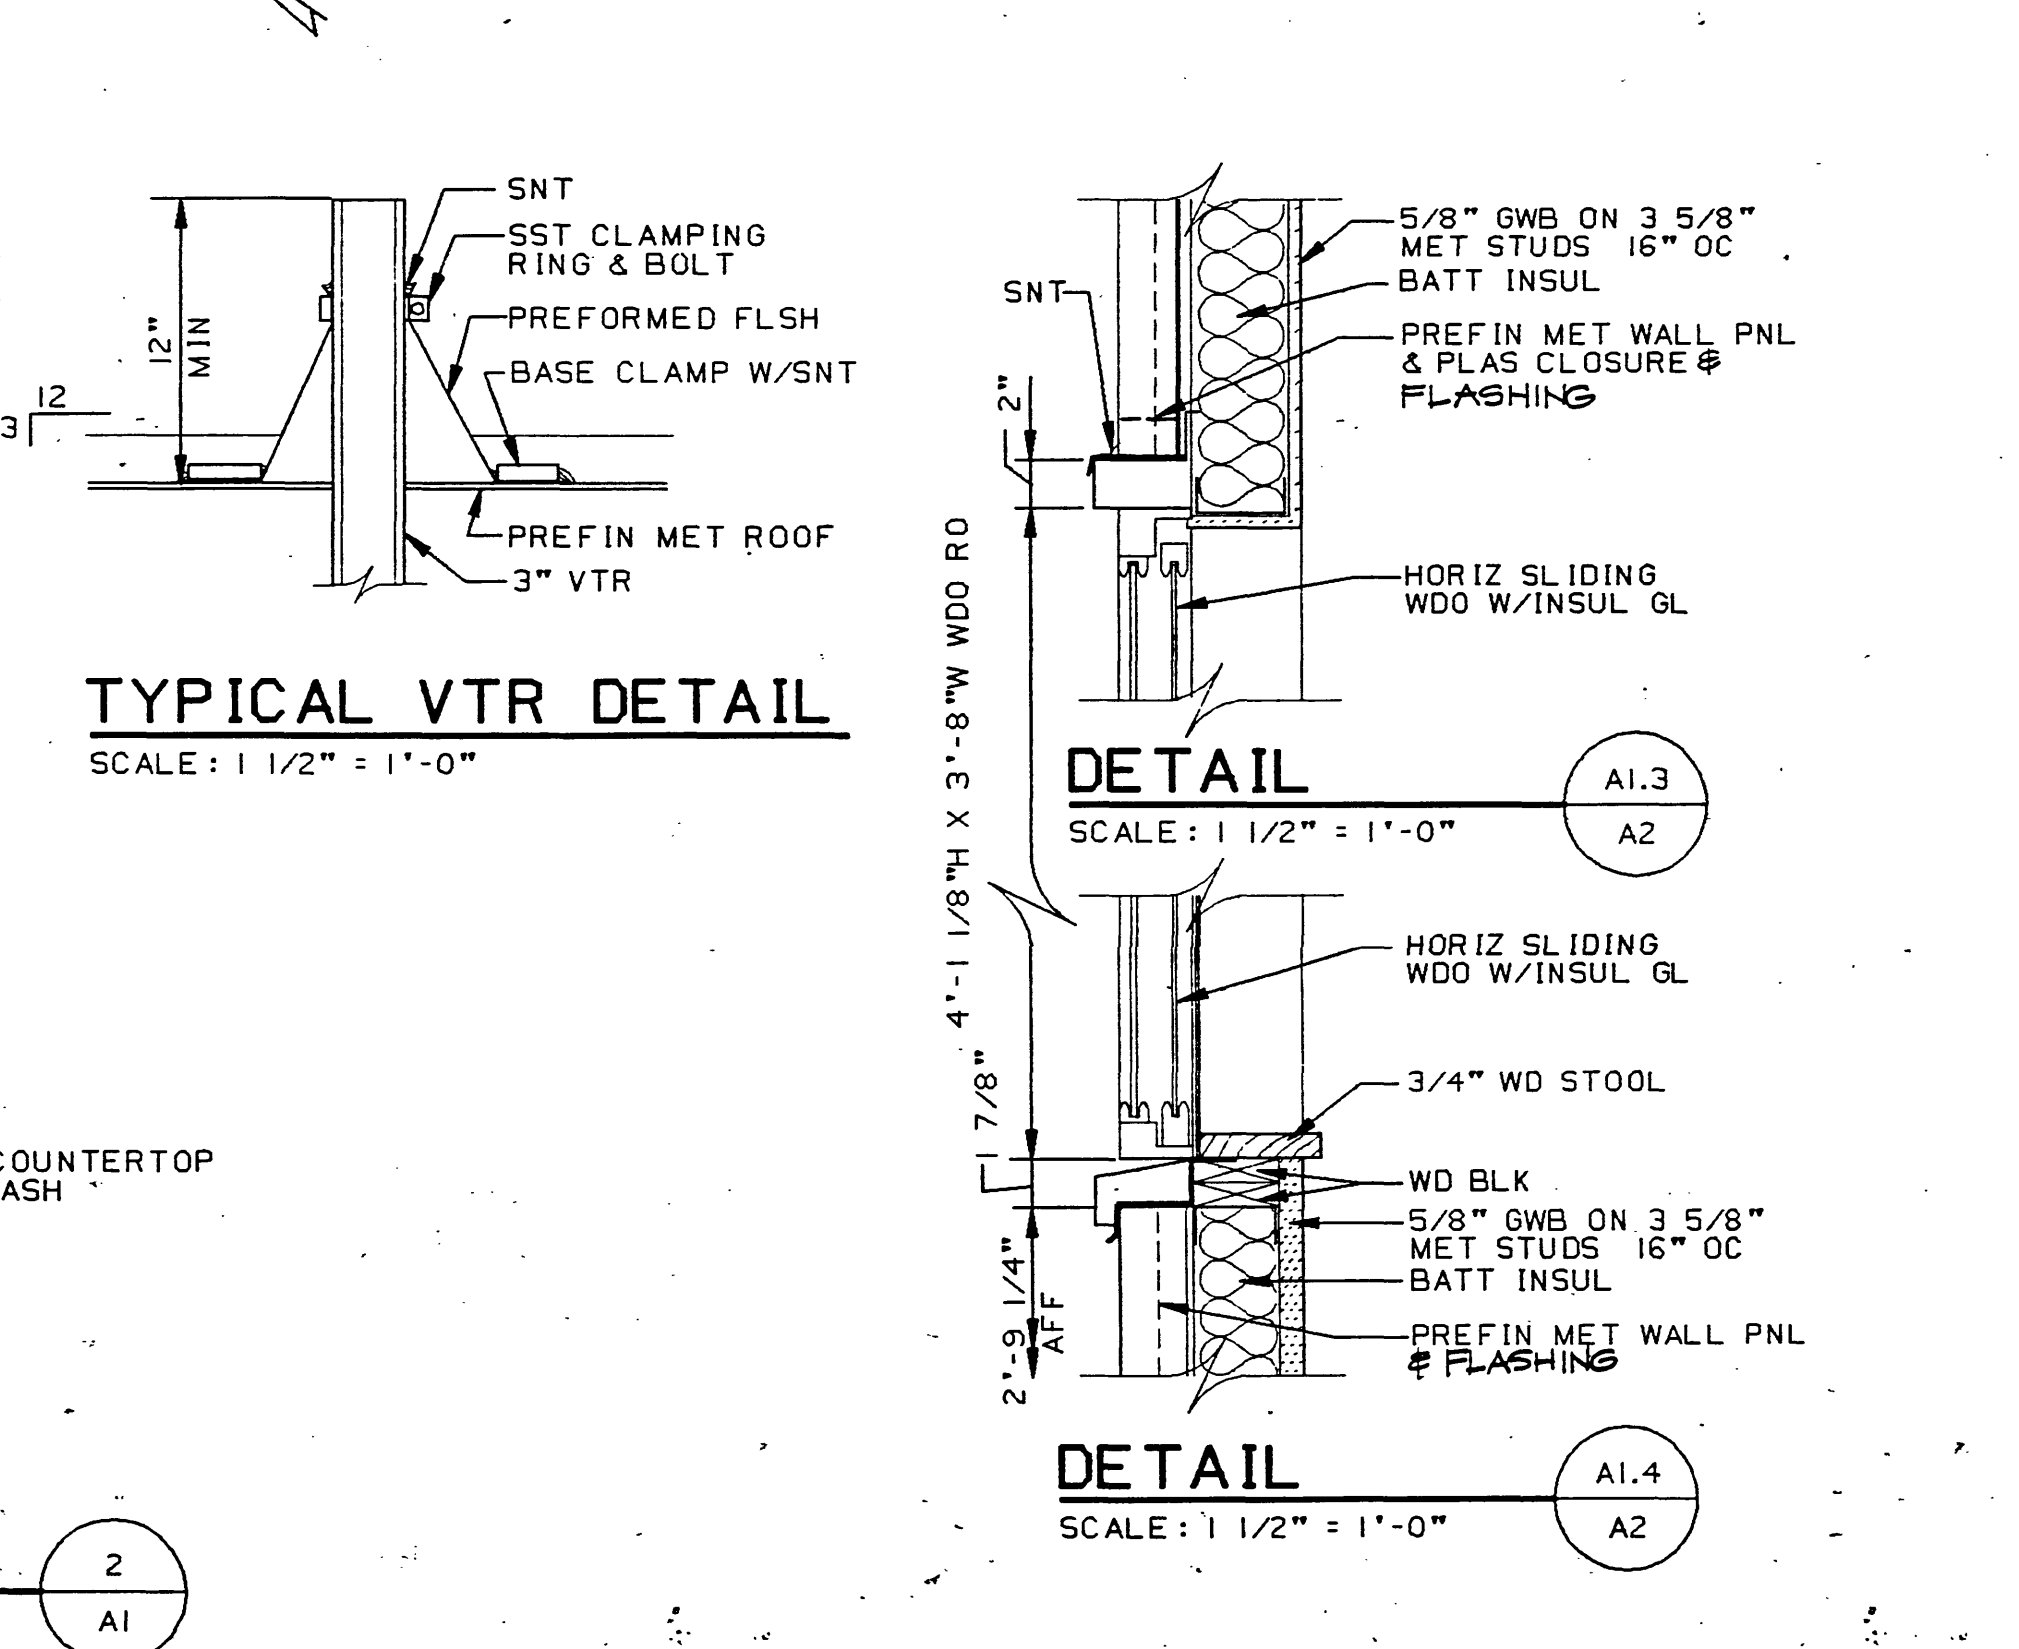
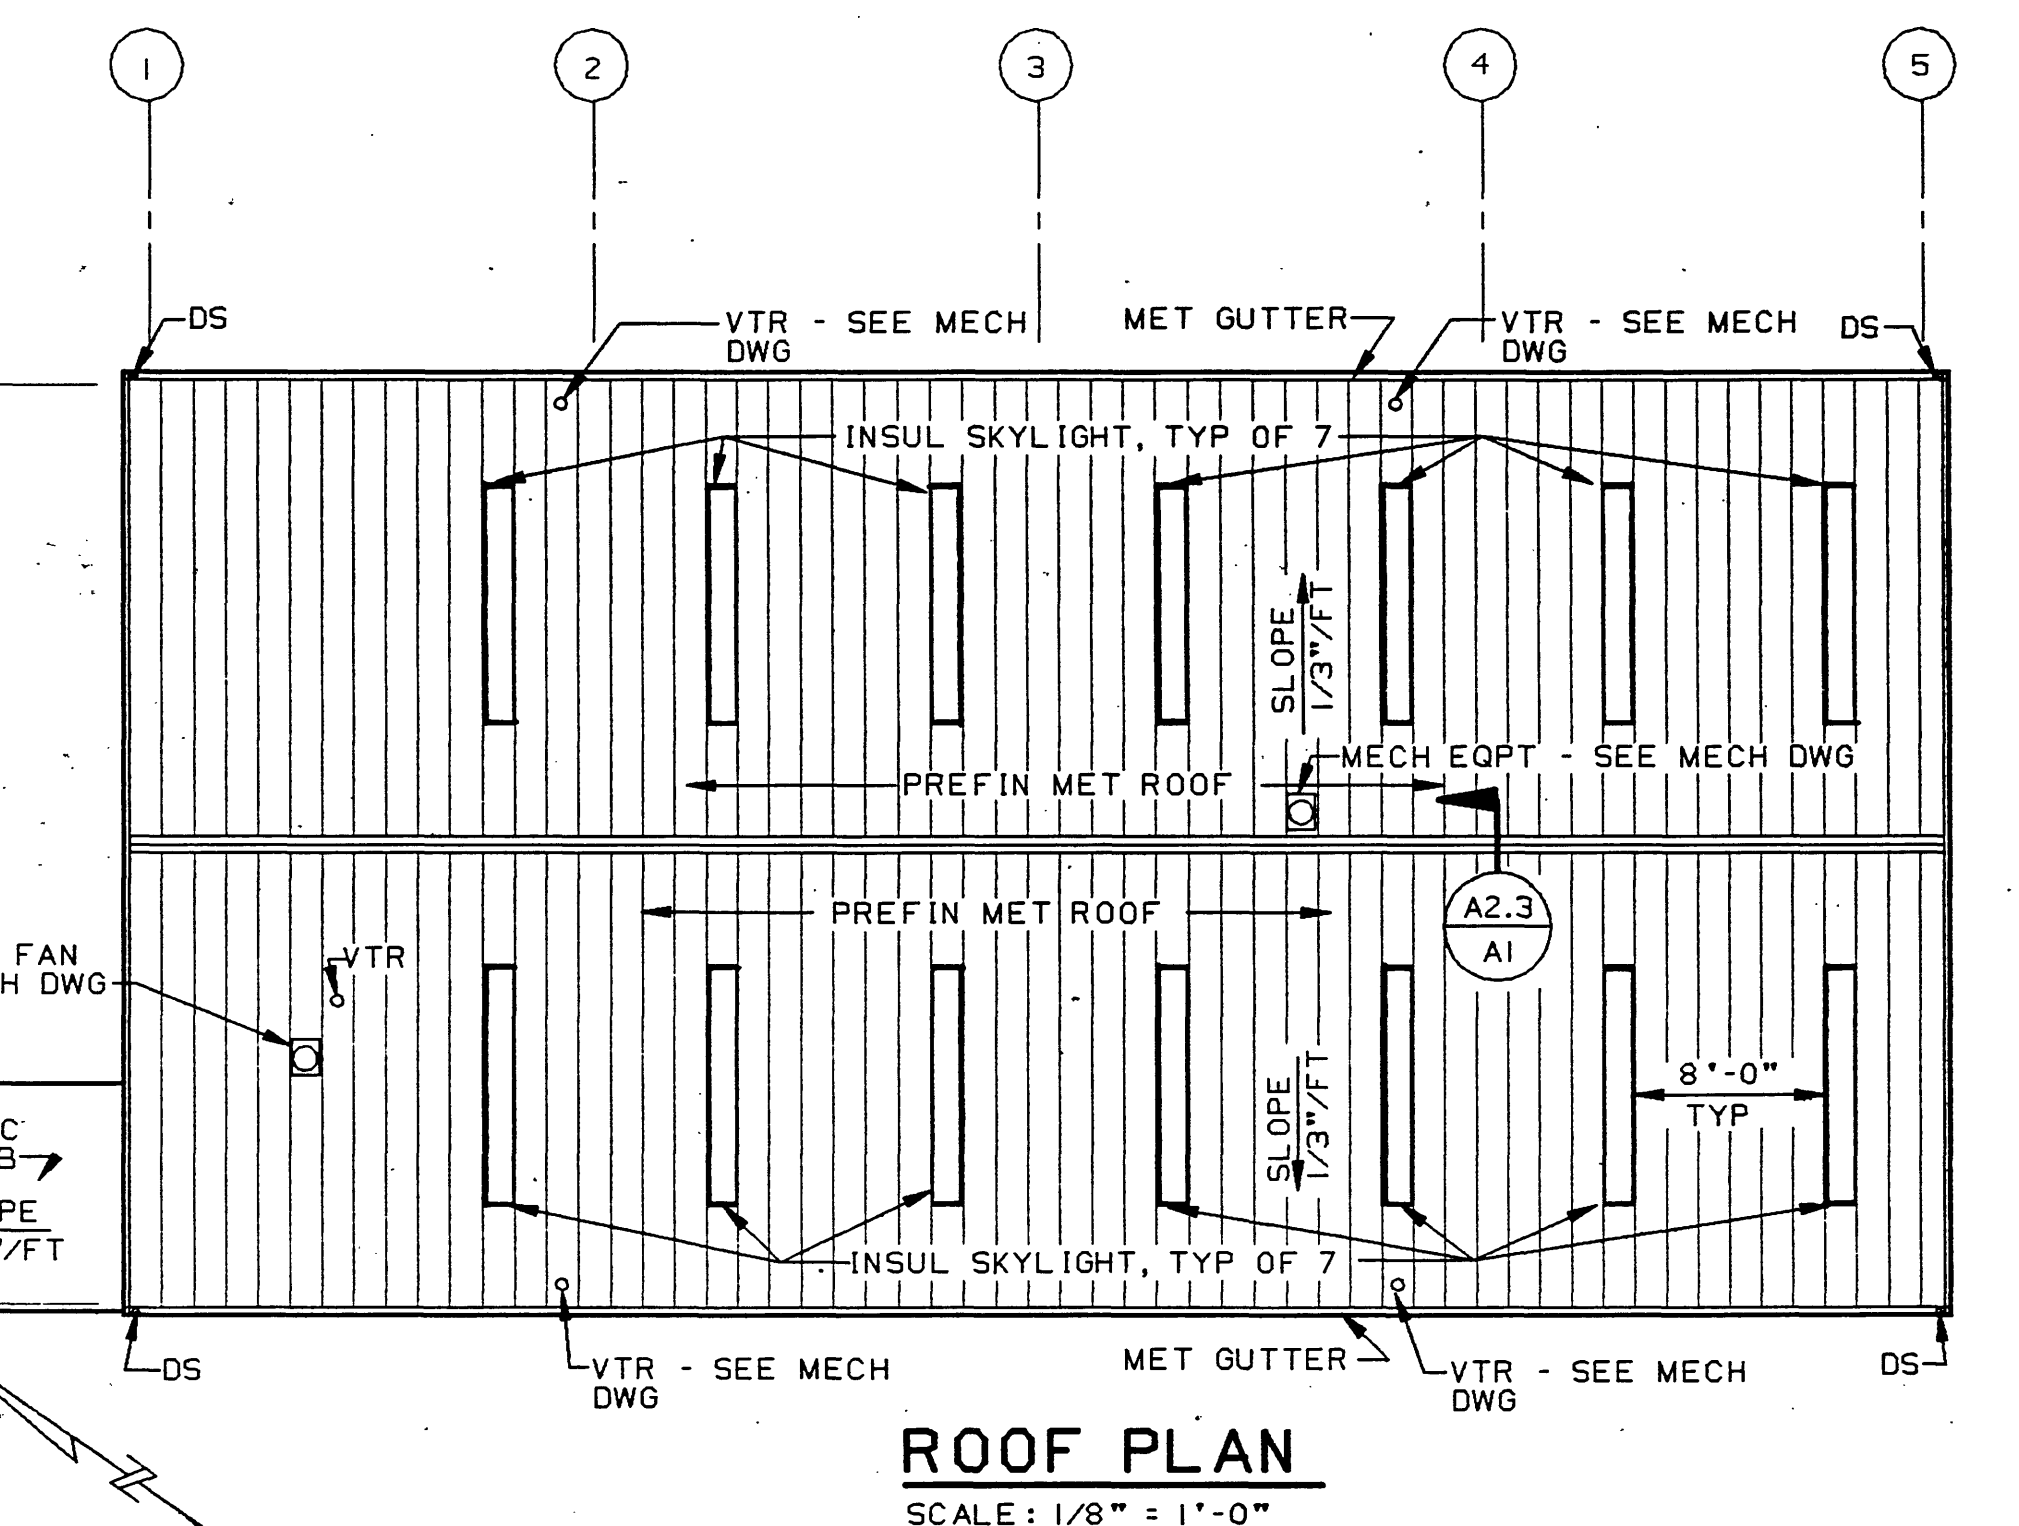
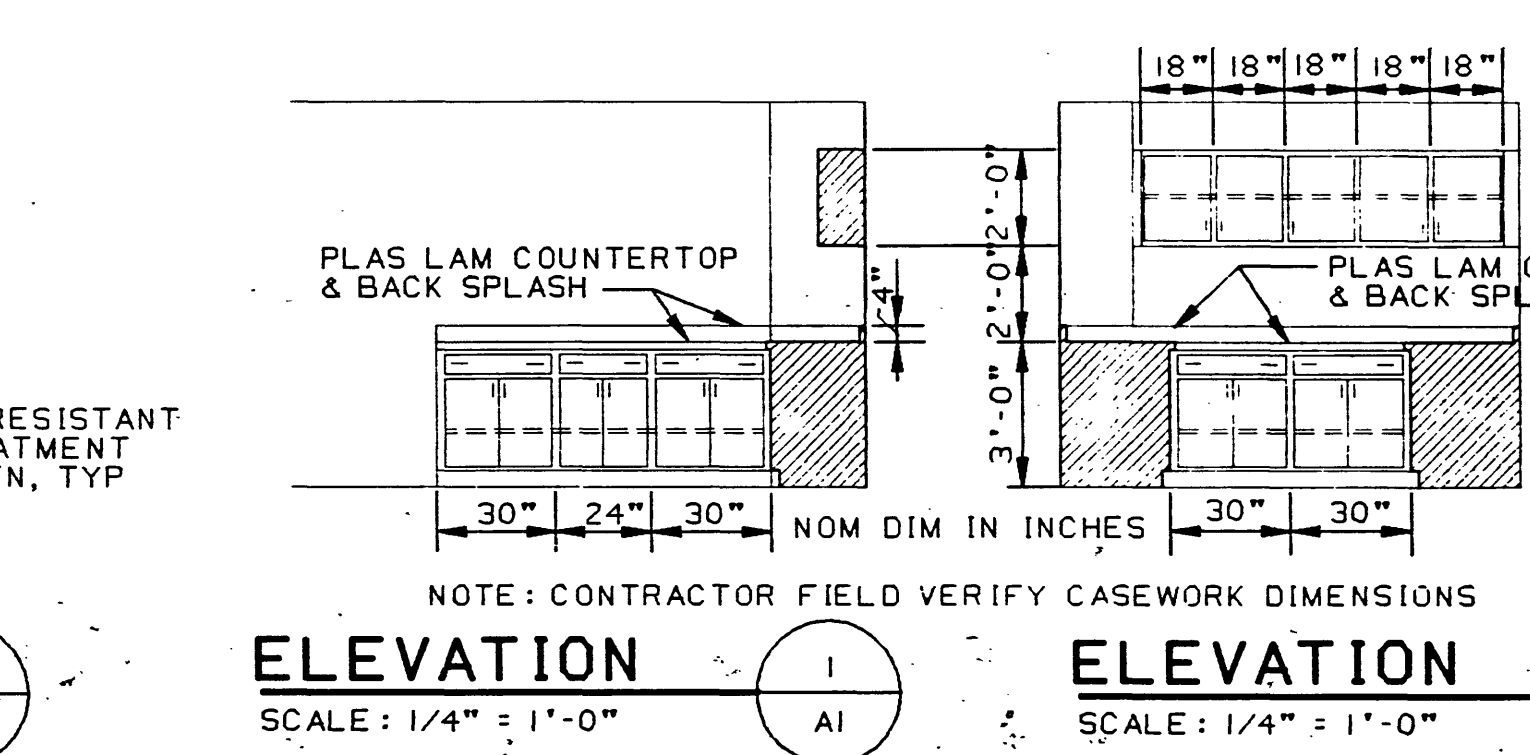
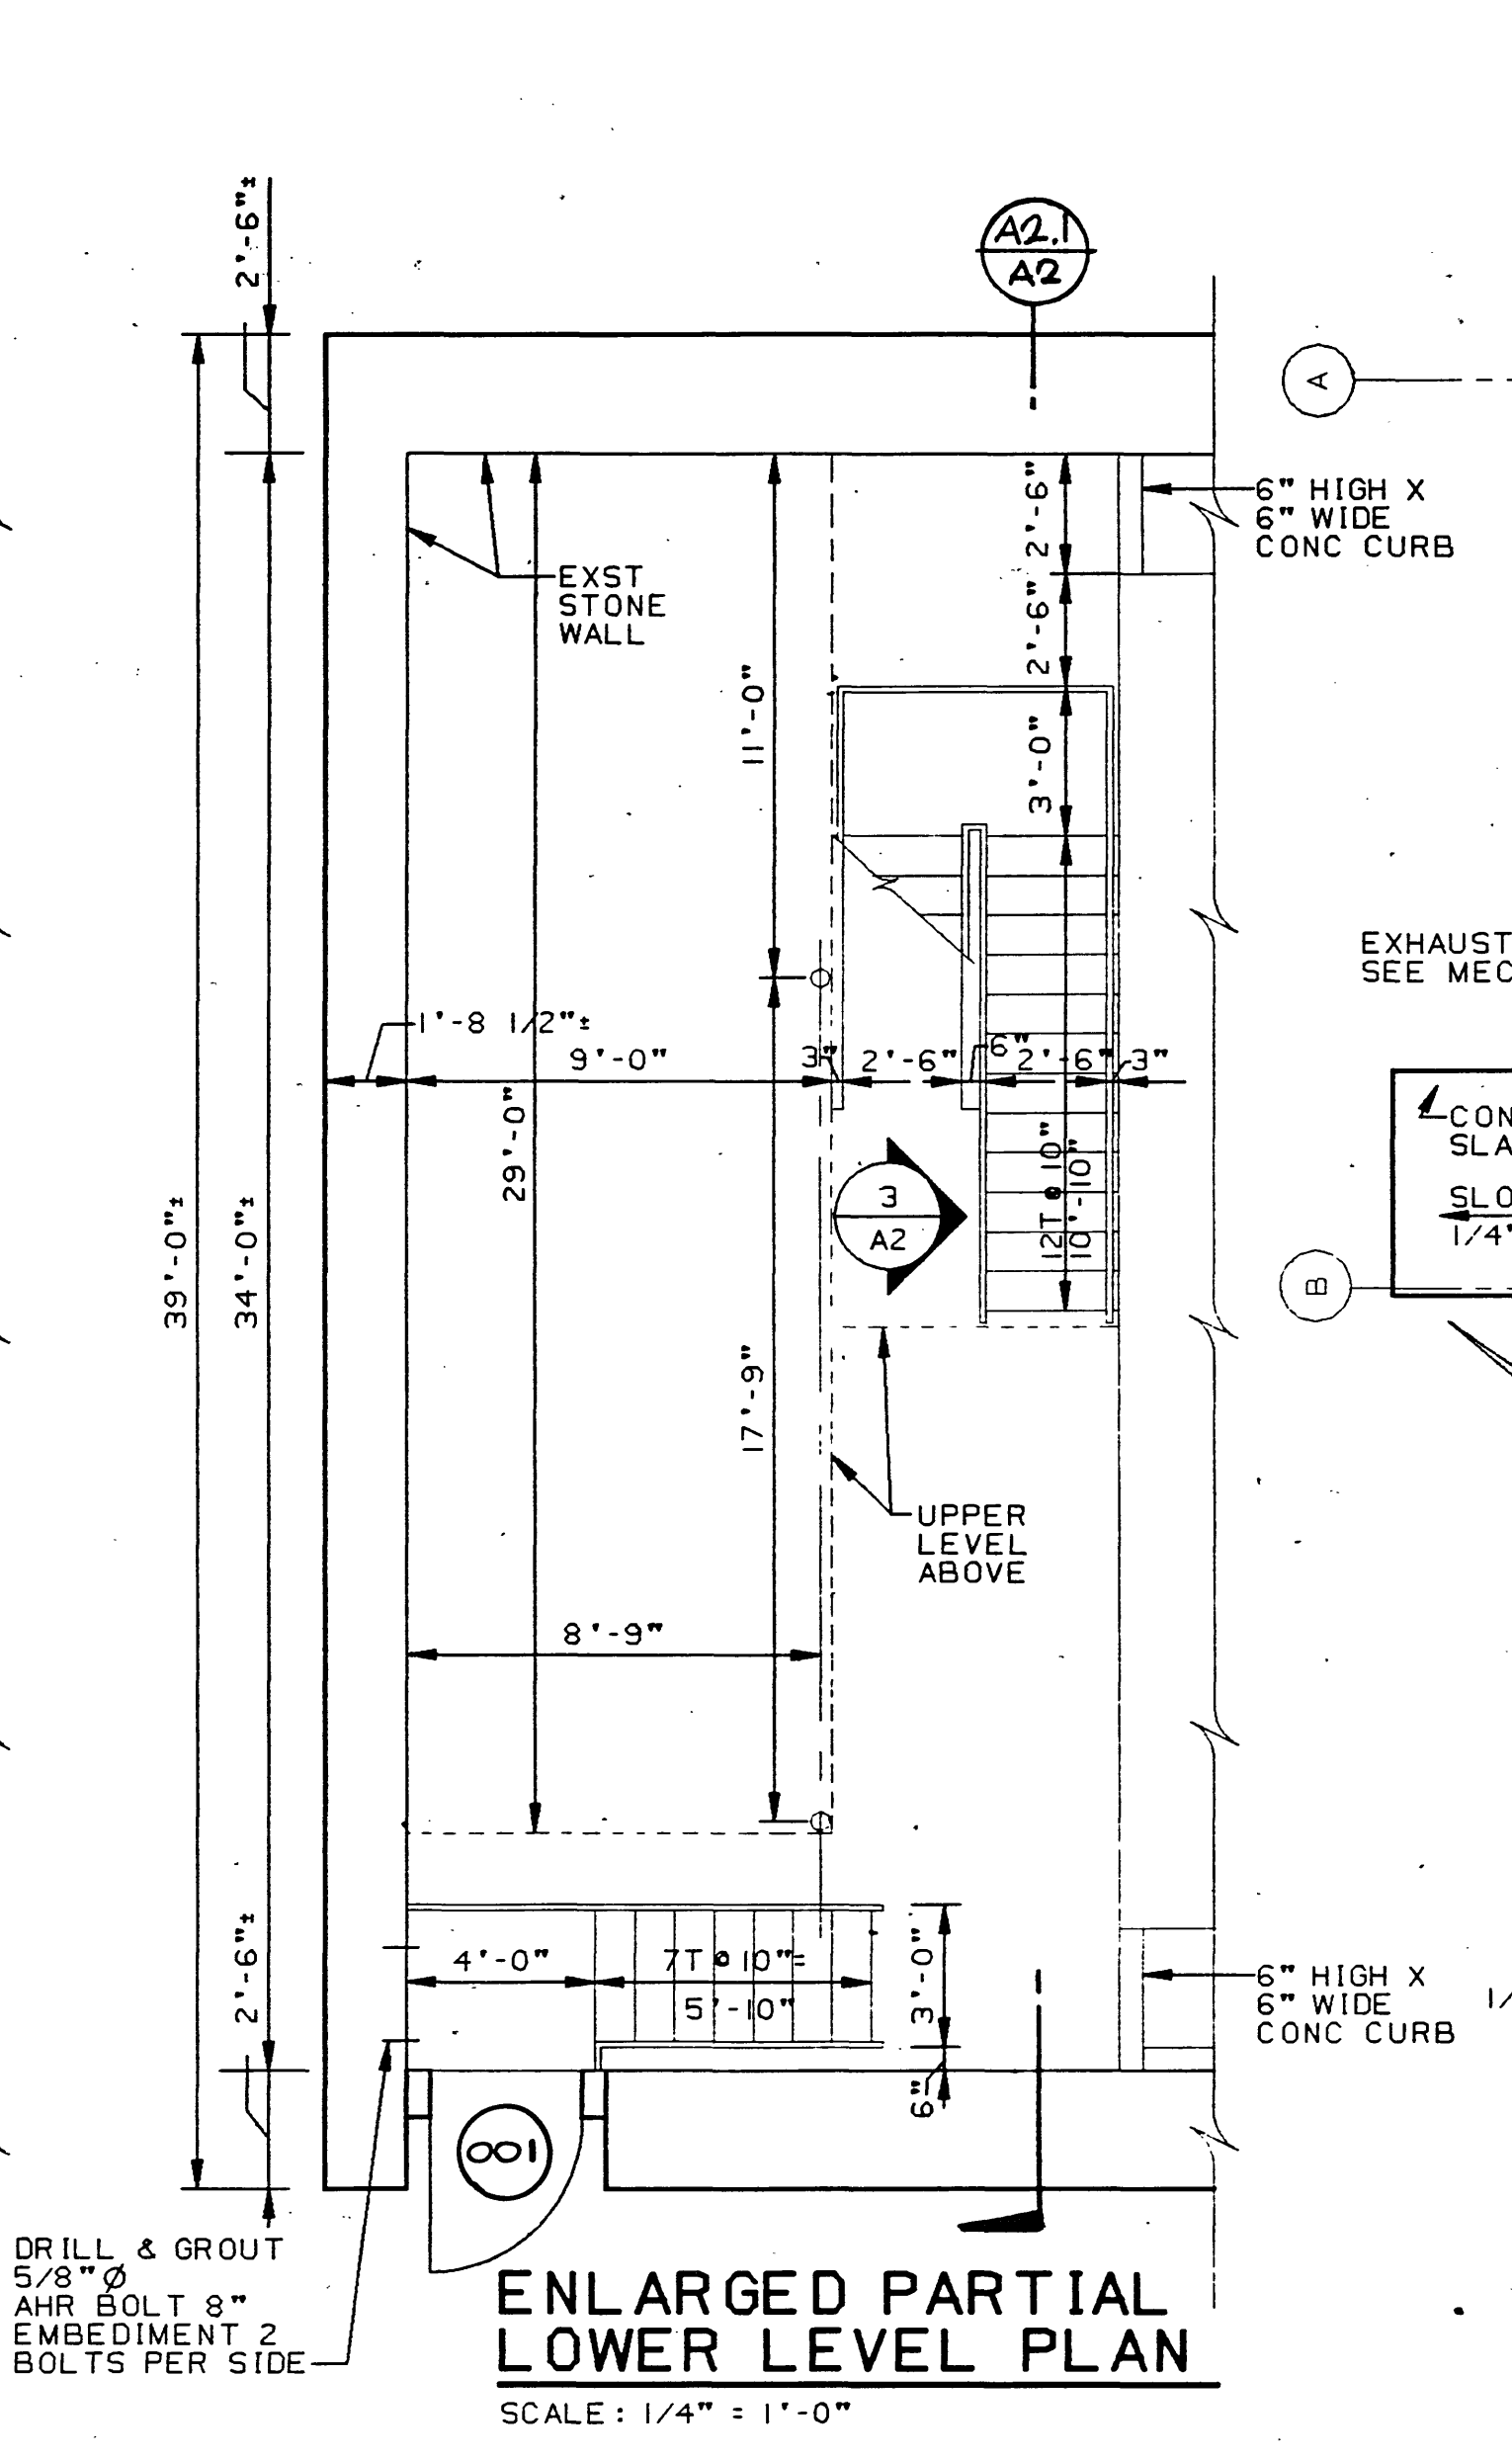
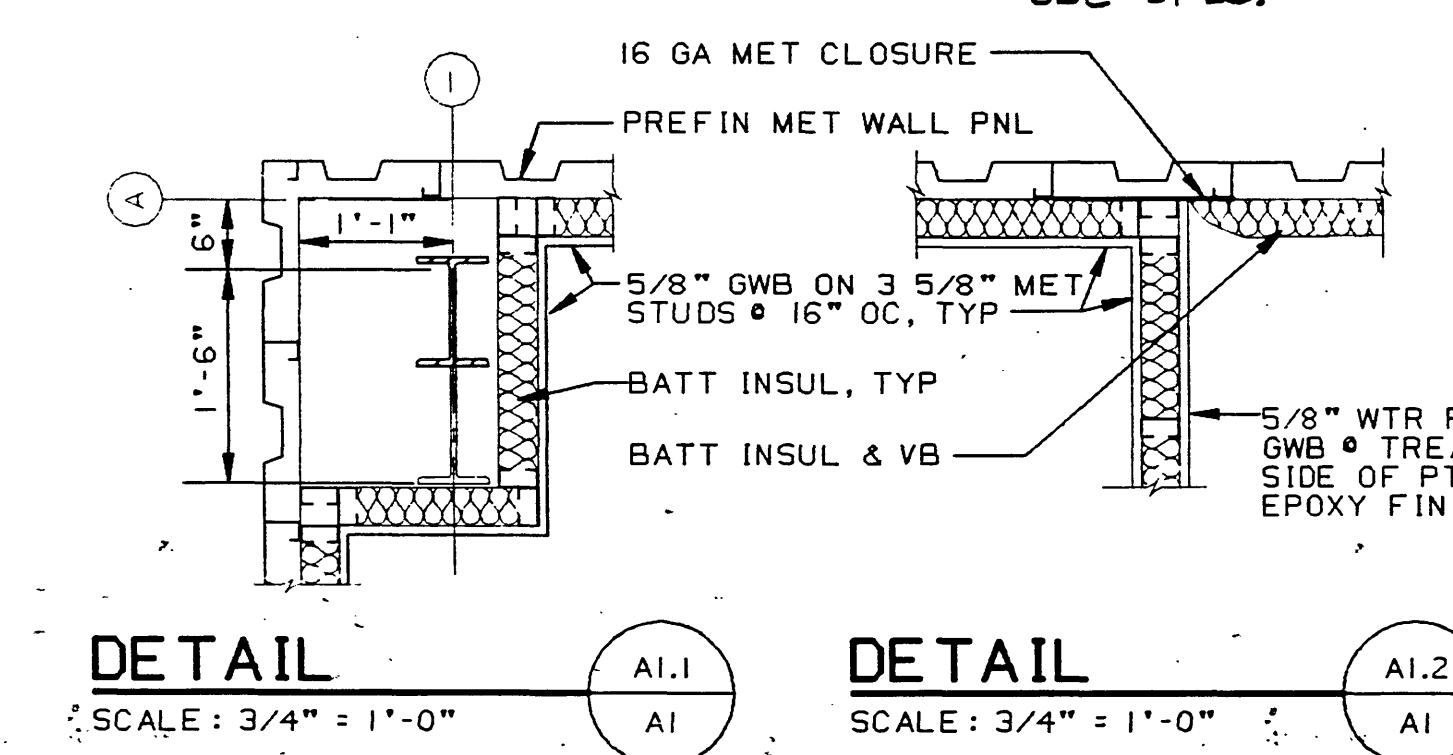
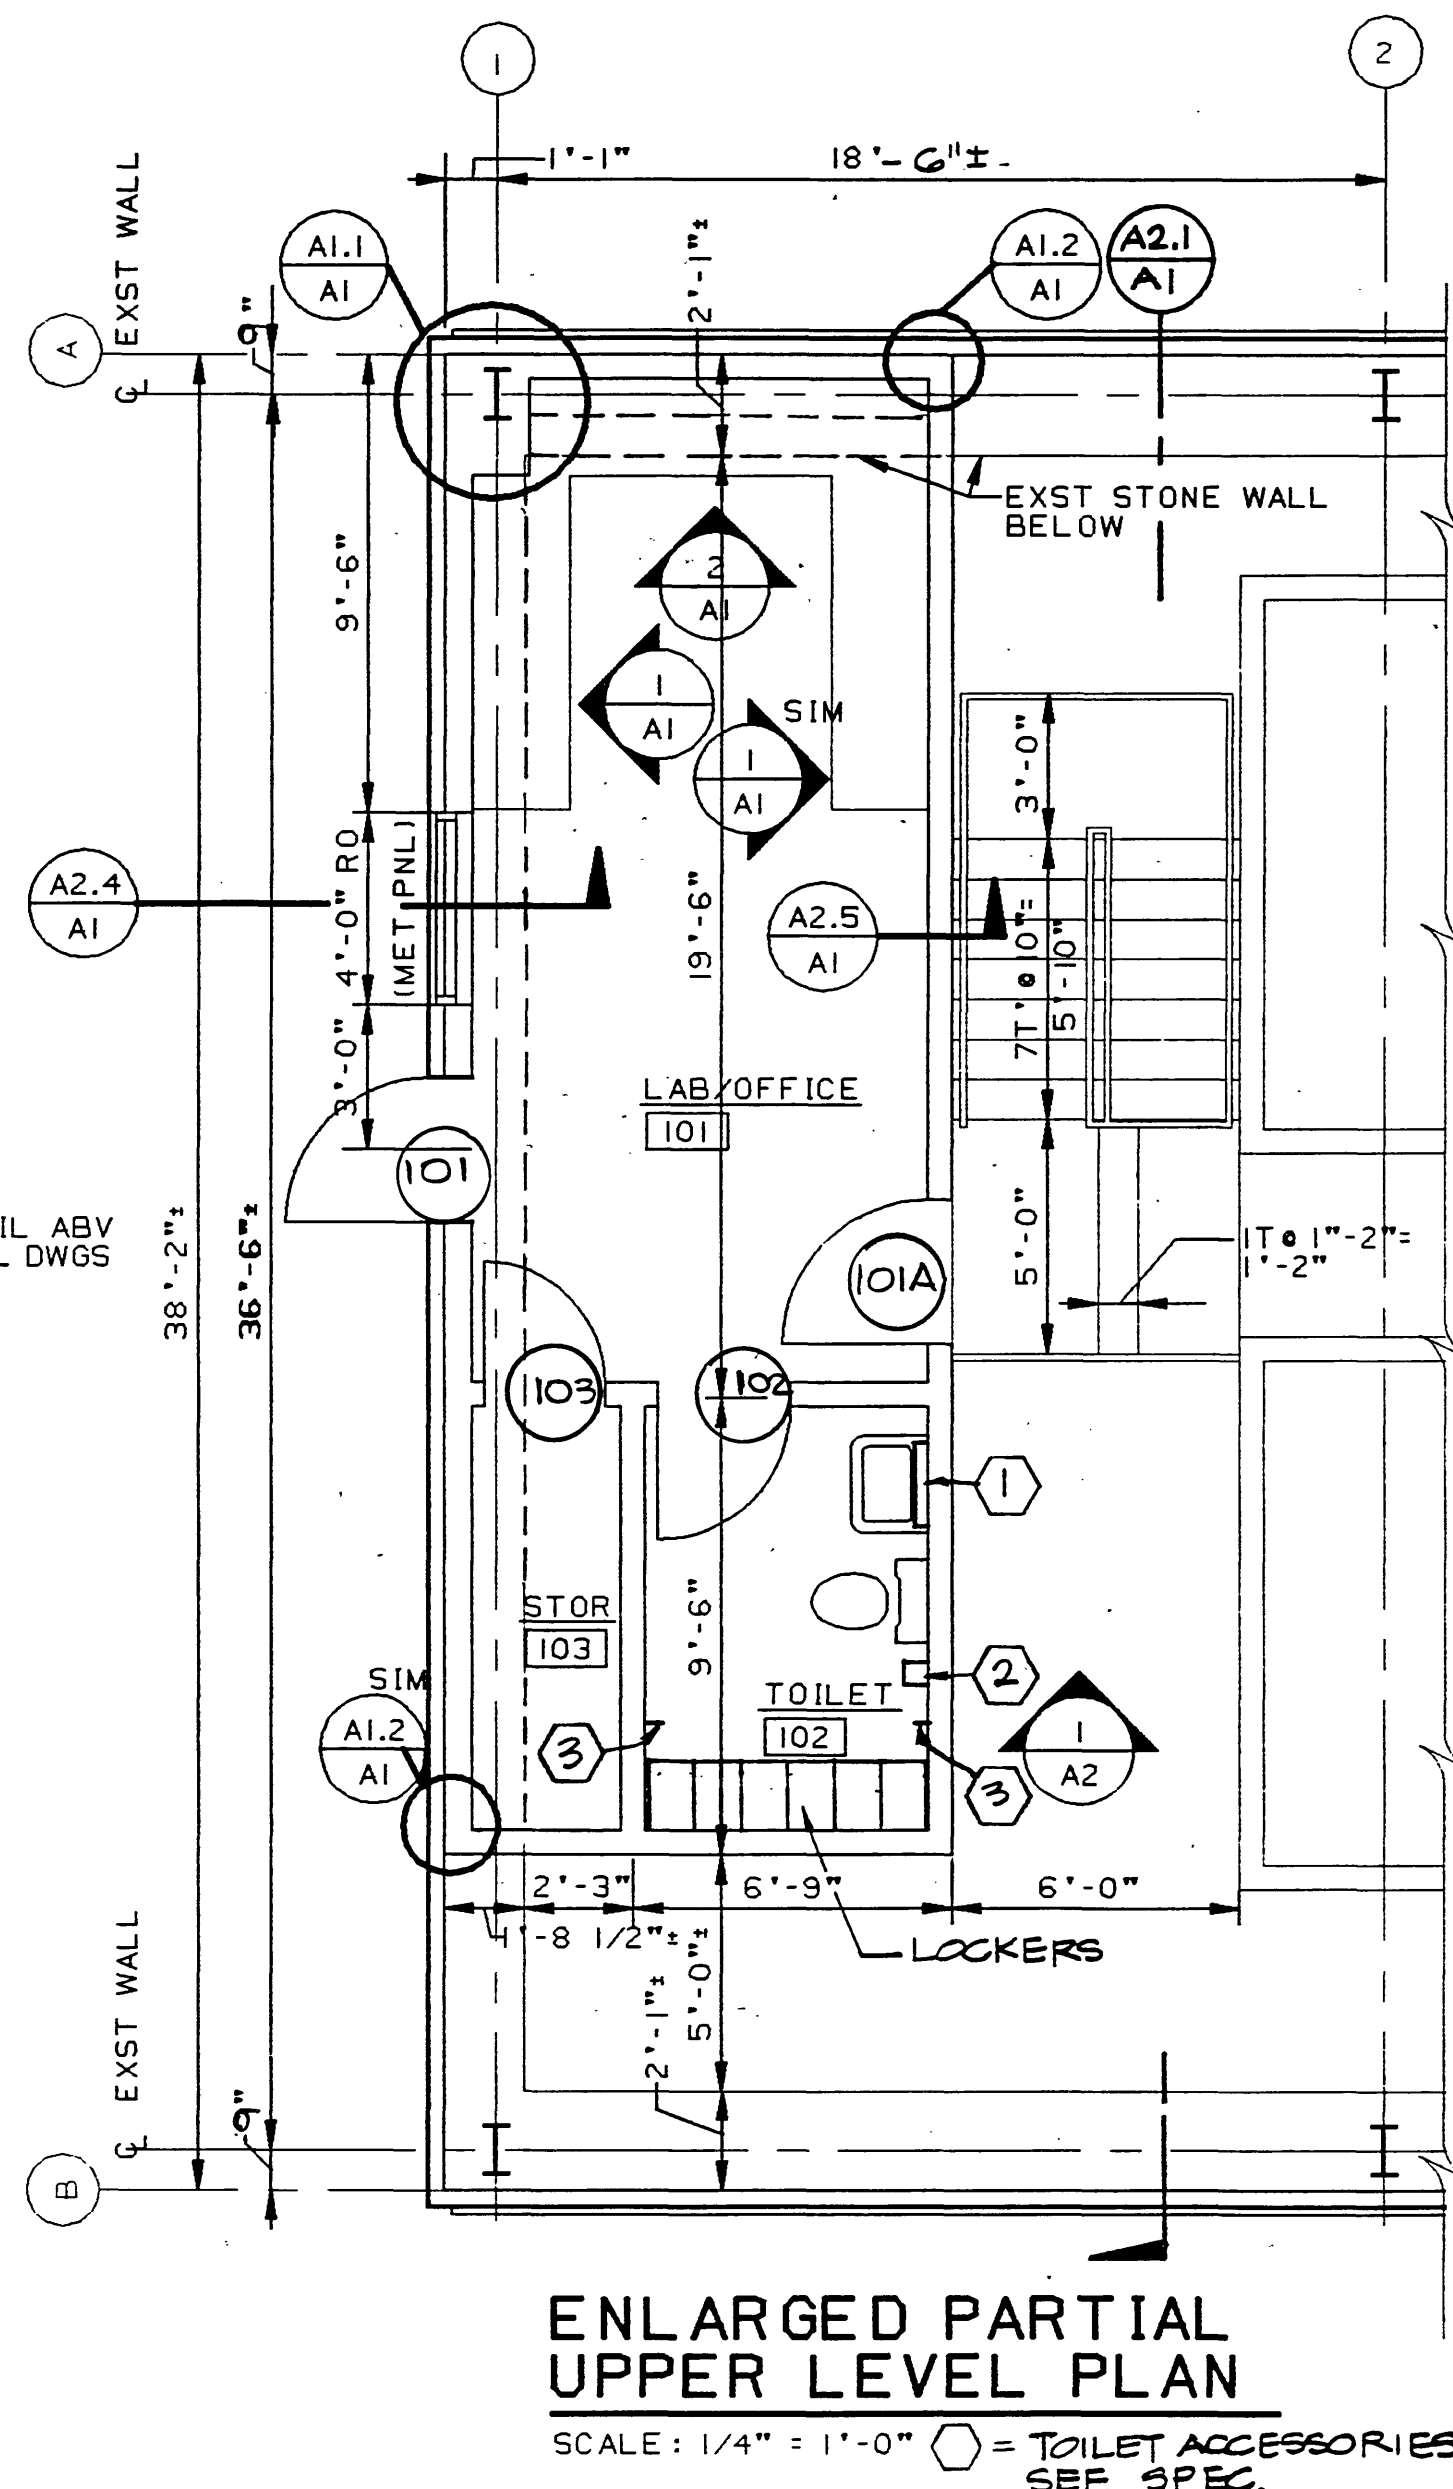
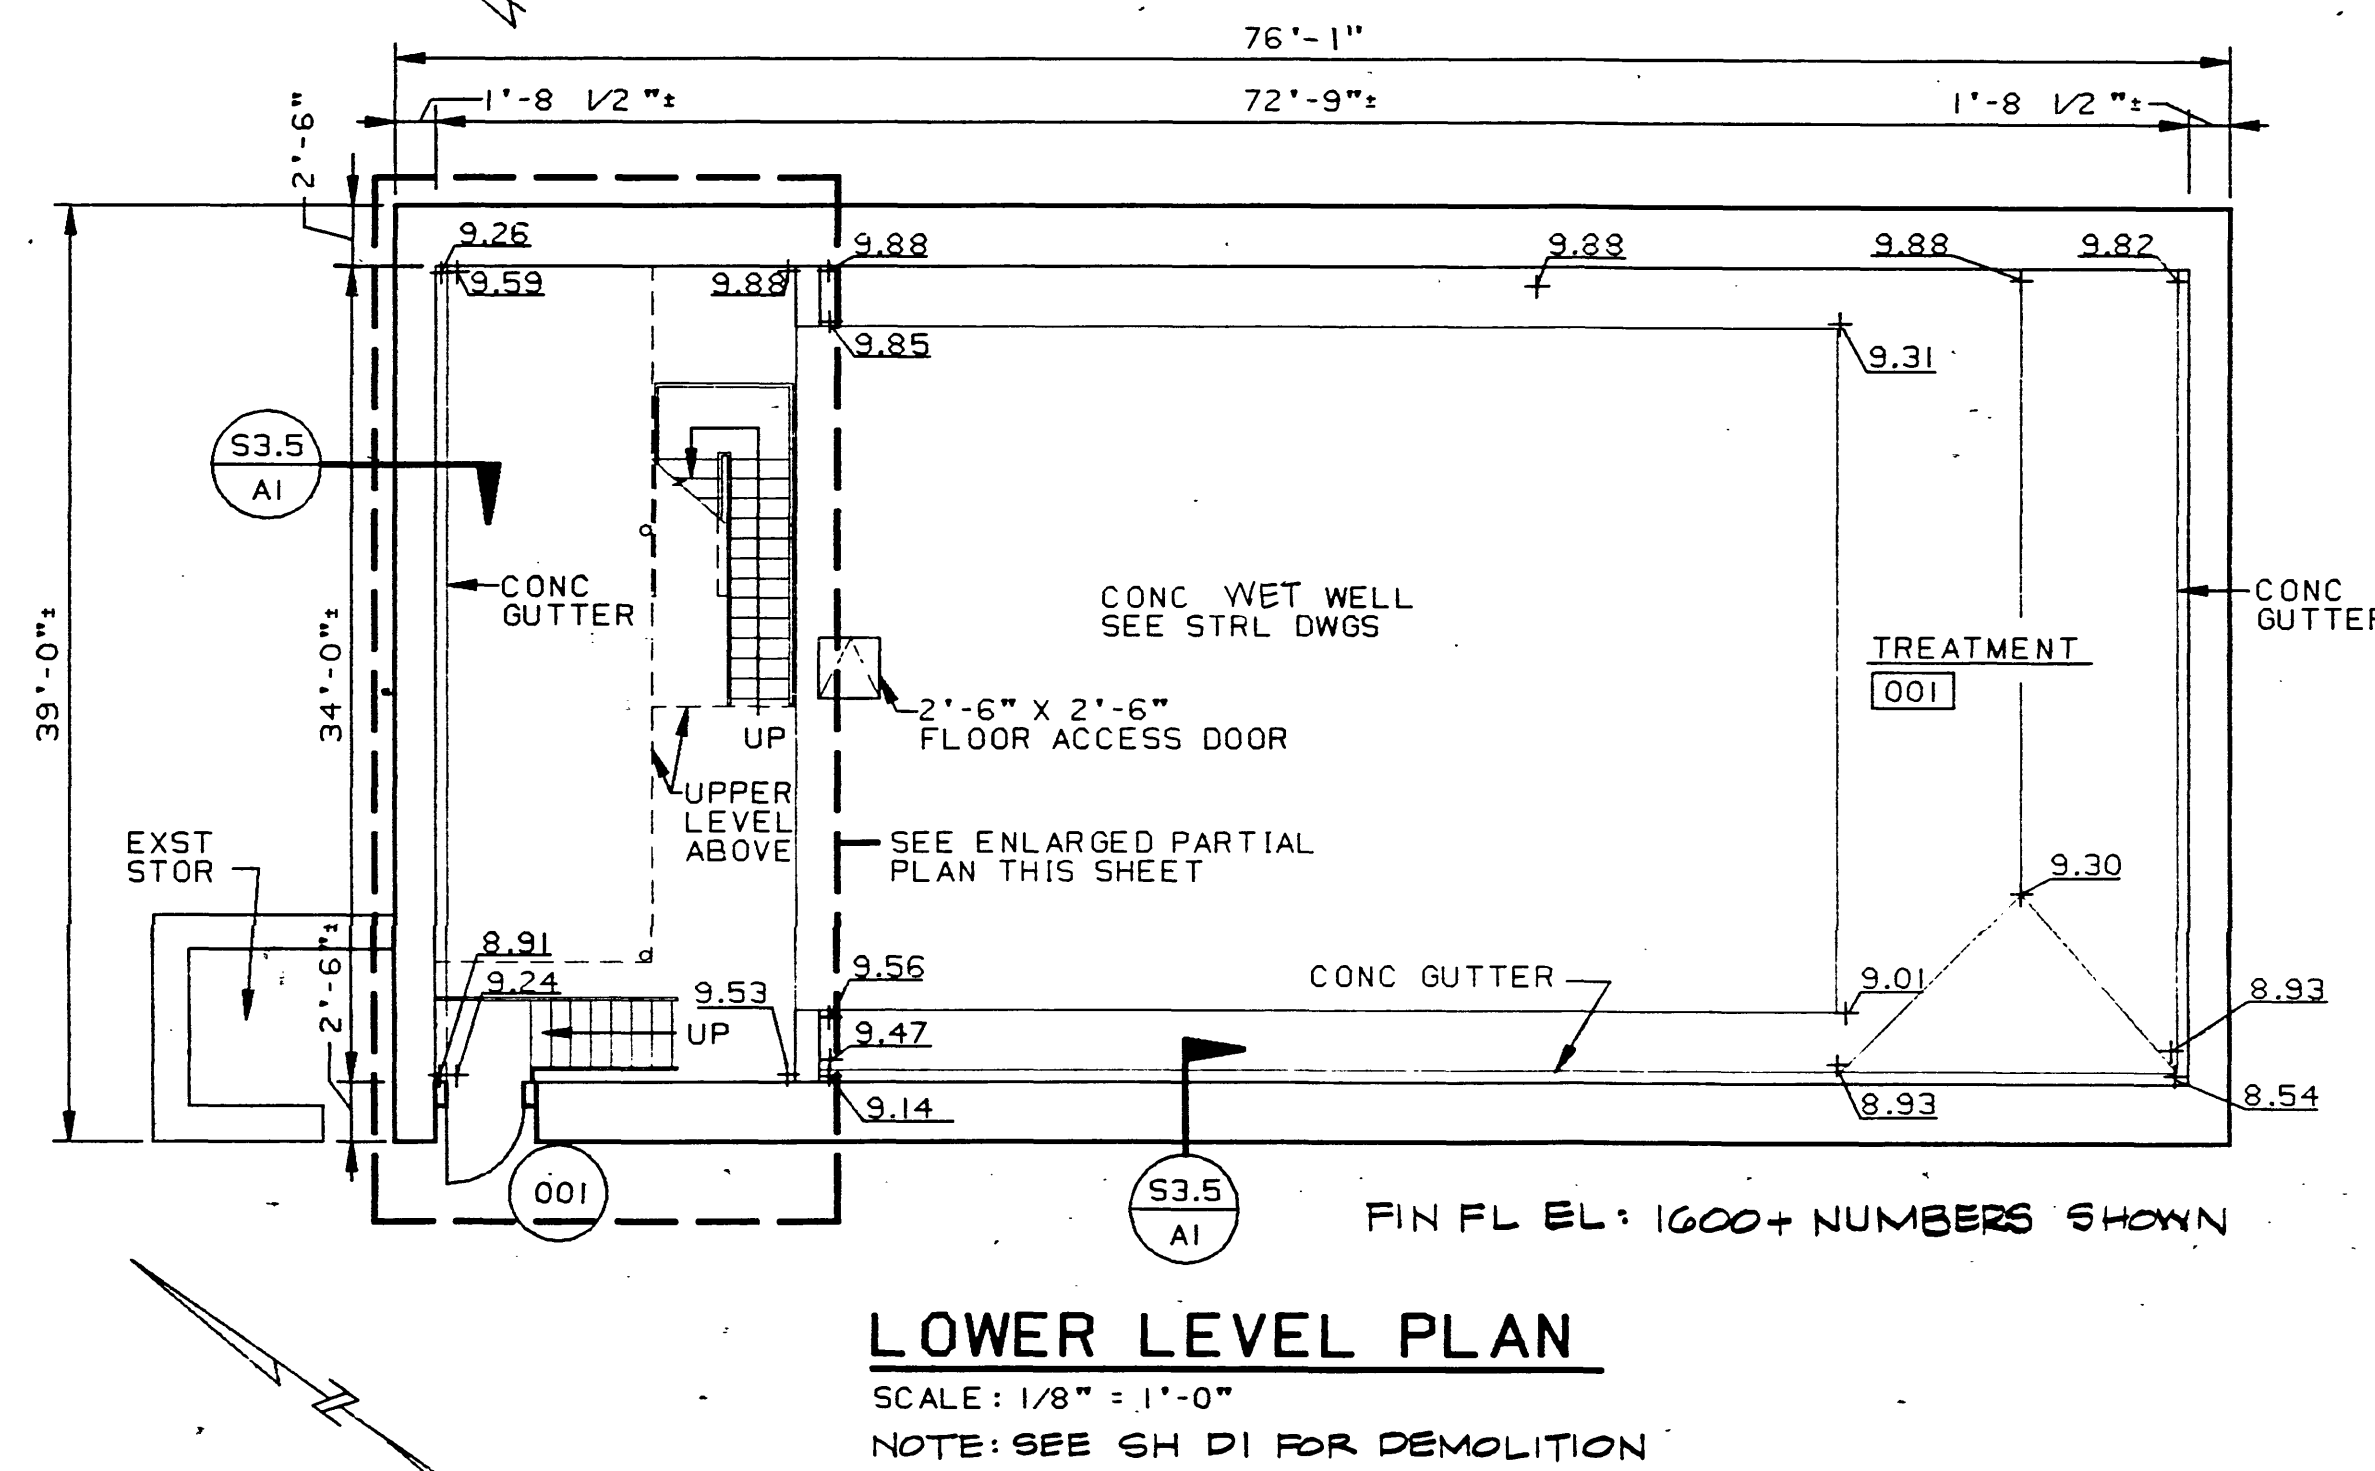


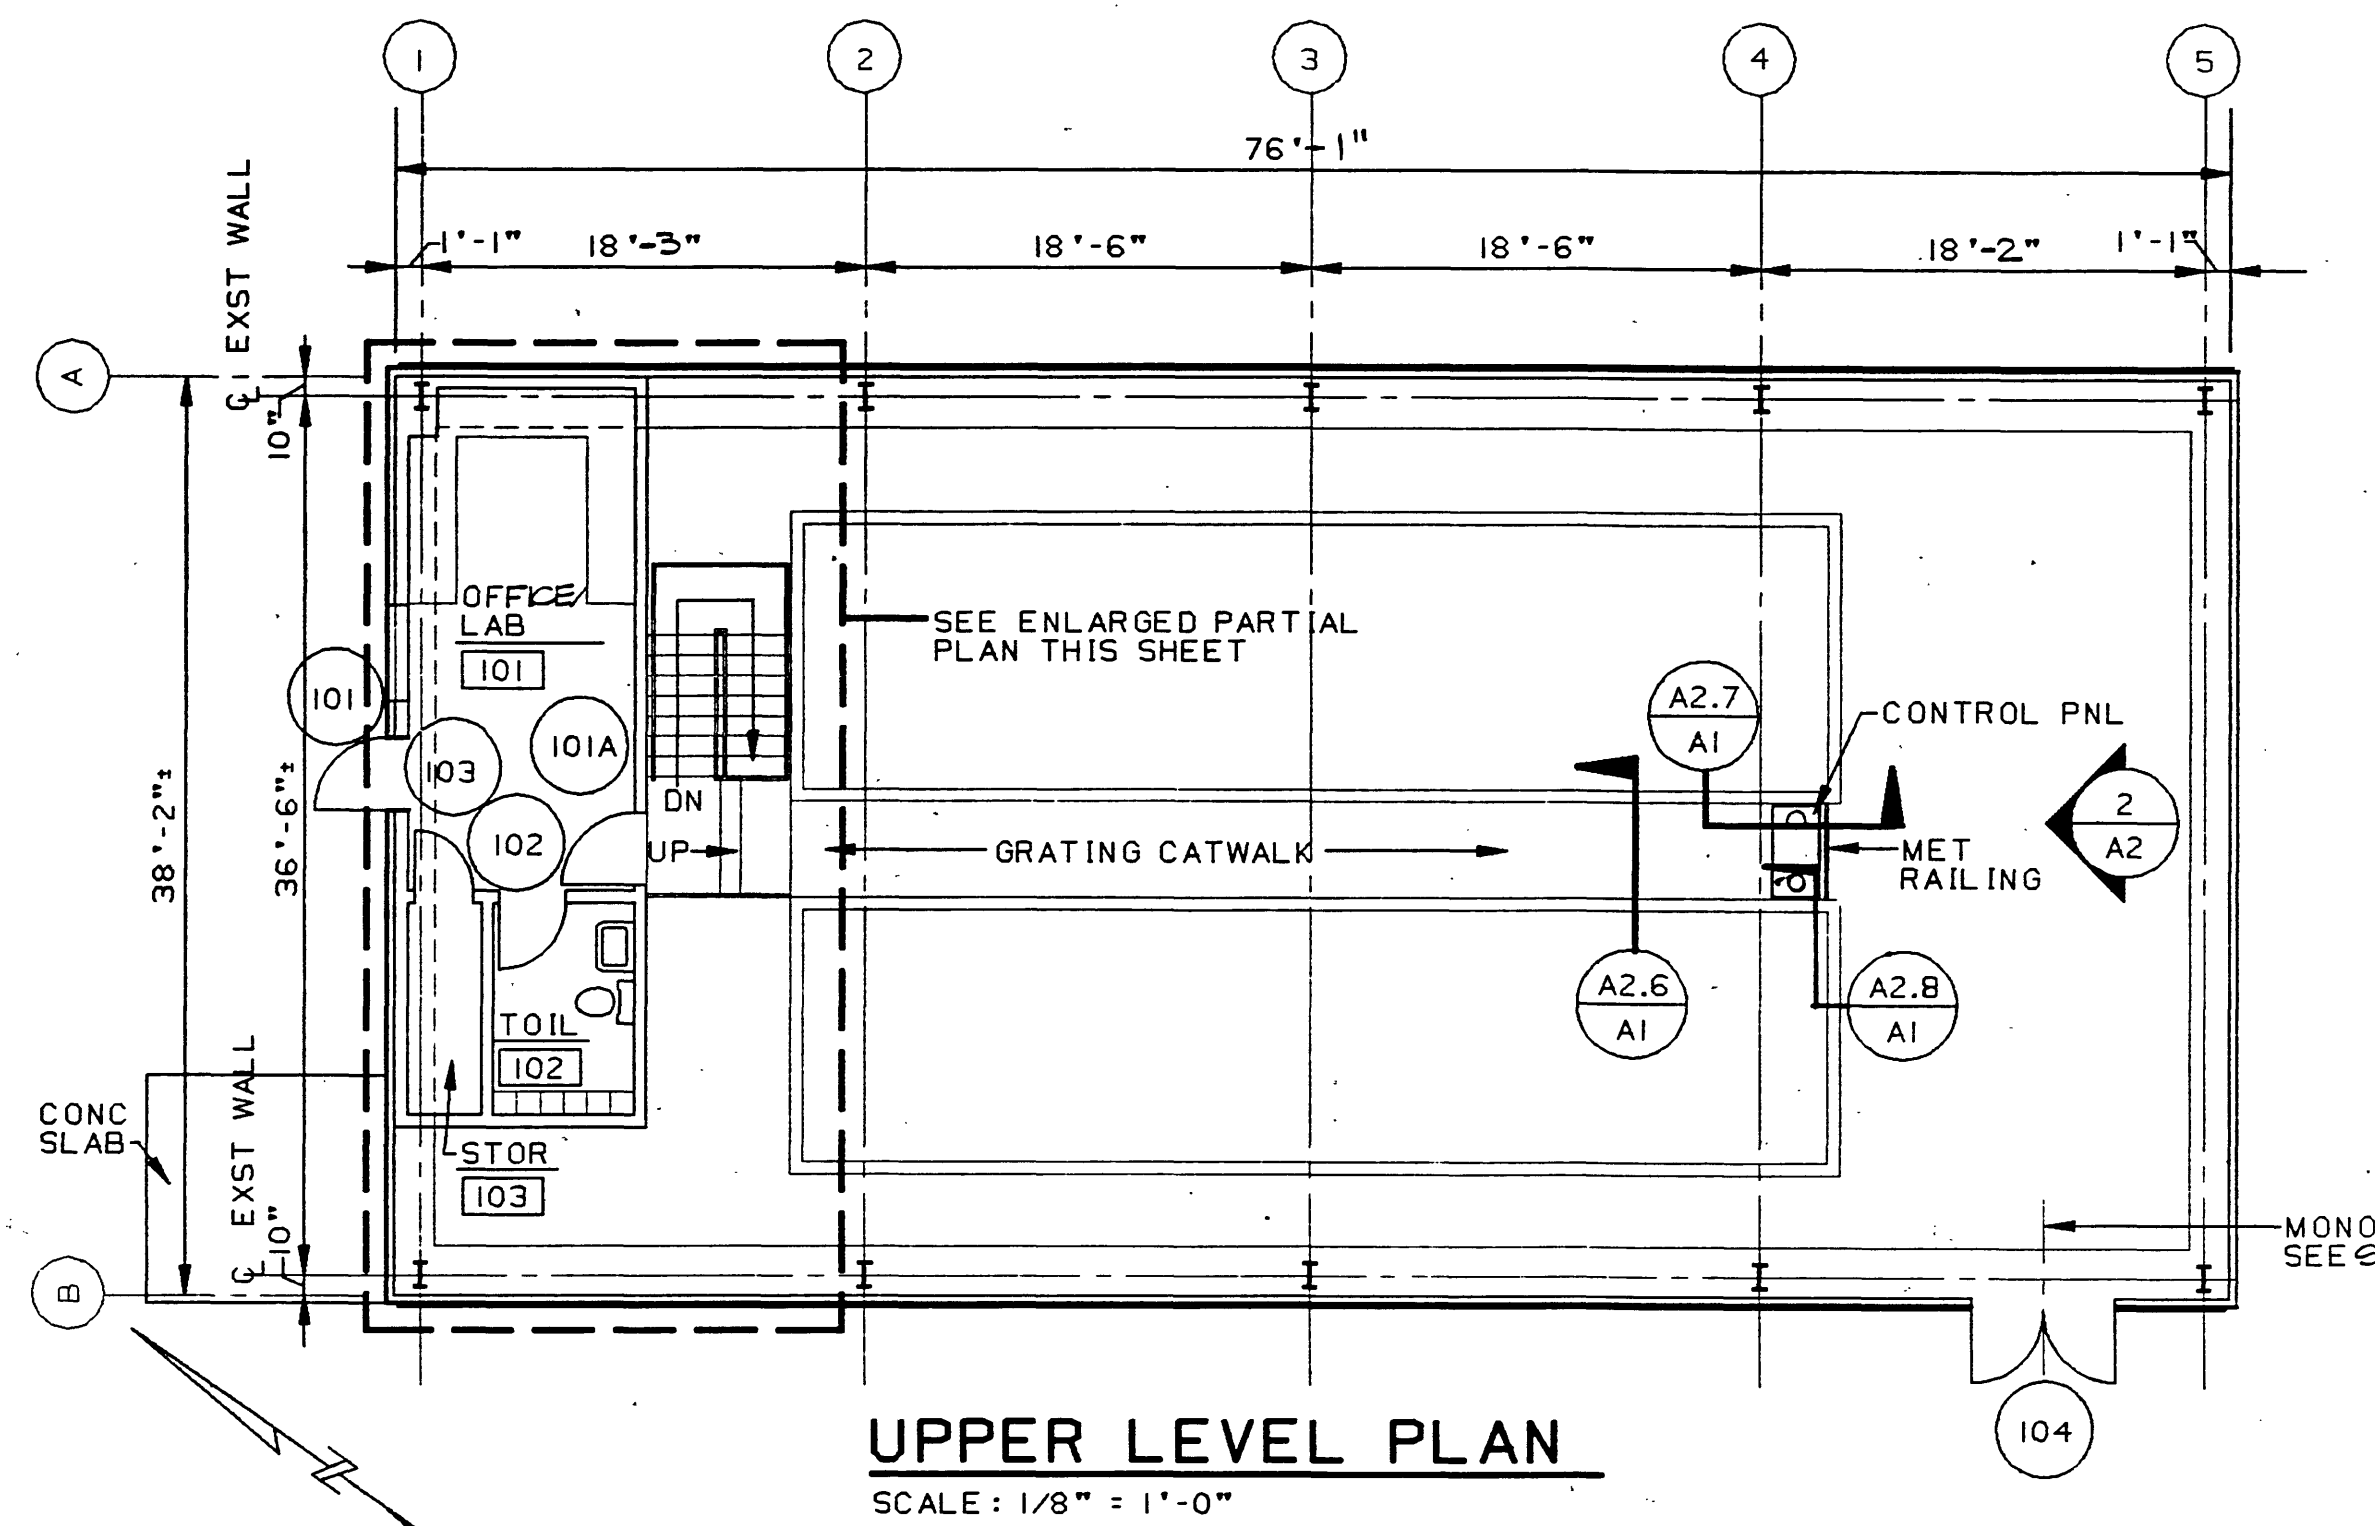


FINISH SCHEDULE

SPACE NO.	SPACE NAME	FLOOR	BASE	WALLS	CEILING	REMARKS
				MATERIAL	FINISH	
001	TREATMENT	CONC	-	EXST STONE	CEMENT COATING	EXP
101	LAB/OFFICE	RVT	RBR	GWB	EPOXY	ACT
102	TOILET	RVT	RBR	GWB	PNT	ACT
103	STORAGE	RVT	RBR	GWB	PNT	ACT


DOOR SCHEDULE

DOOR	NO	TYPE	MATL	WIDTH	HEIGHT	LOUVER OR UC	GLASS TYPE	FRAME	DEPTH	HEAD	JAMB	THRESH	FIRE RATING	HARDWARE	REMARKS
	001	B	HM	3'-0"	6'-8"	-	-	FI	6	1	2	T1	-	1	
	101	B	HM	3'-0"	7'-0"	-	-	FI	7 3/4	3	4	T2	-	1	*SEE PRE-ENGINEERED BUILDING SPEC
	101A	A	HM	3'-0"	7'-0"	-	-	FI	6	5	5	T1 SIM	-	2	
	102	B	HM	2'-8"	7'-0"	-	-	FI	6	5	5	-	-	3	
	103	B	HM	2'-8"	7'-0"	-	-	FI	6	5	5	-	-	4	
	104	B	HM	2'-8"	7'-0"	-	-	FI	4 3/4	A2.9	4 SIM	T2 SIM	-	7	*SEE EL 4/A2
	CL1	B	HM	2'-8"	6'-8"	-	2	EXISTING	-	-	-	-	-	5	VERIFY DIMENSIONS
	CH1	B	HM	2'-8"	6'-8"	-	15" x 12"	EXISTING	-	-	-	-	-	6	VERIFY DIMENSIONS


DOOR TYPES

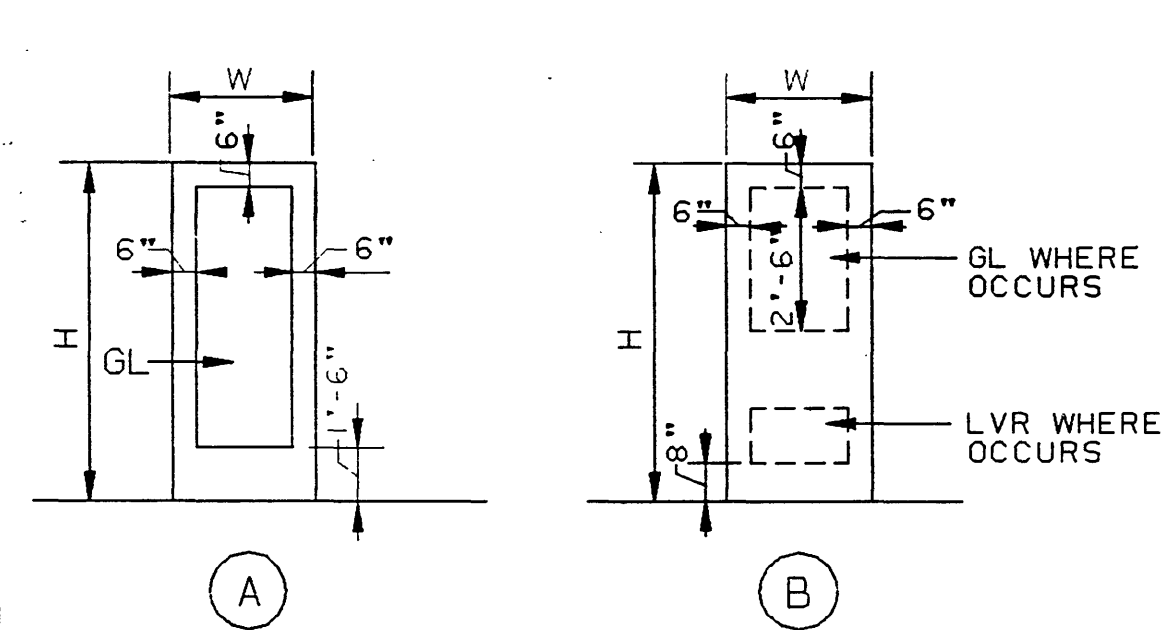



FRAME TYPE

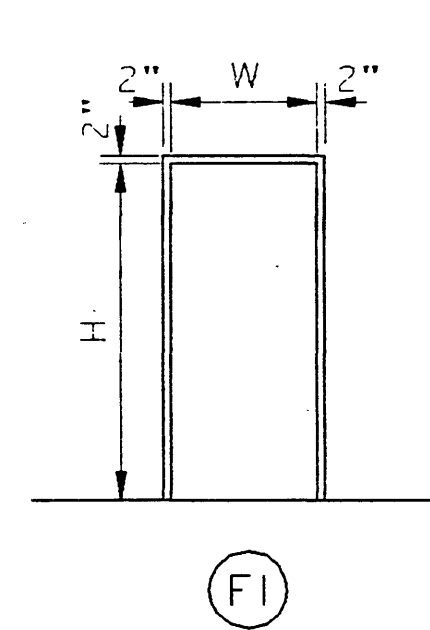

THRESHOLDS

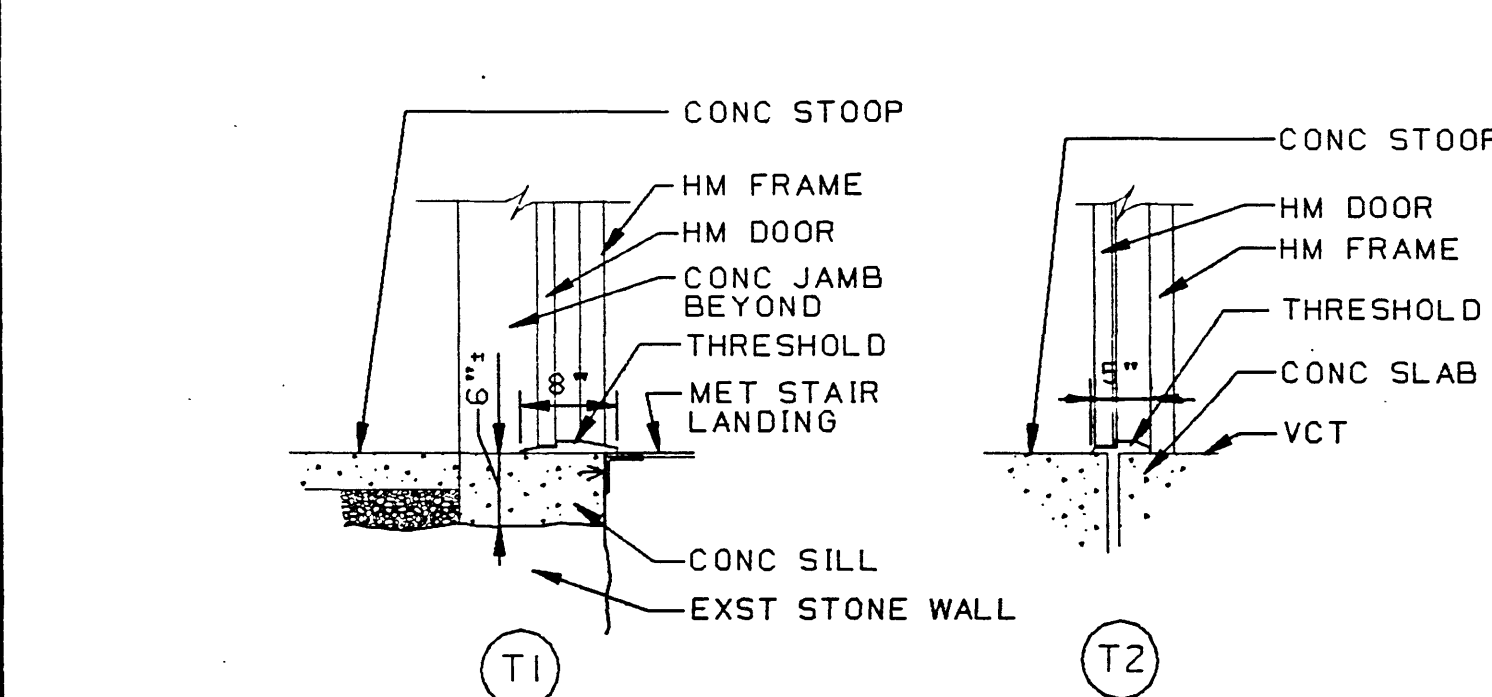

FRAME DETAILS

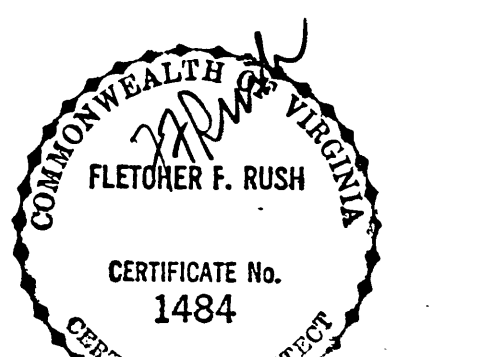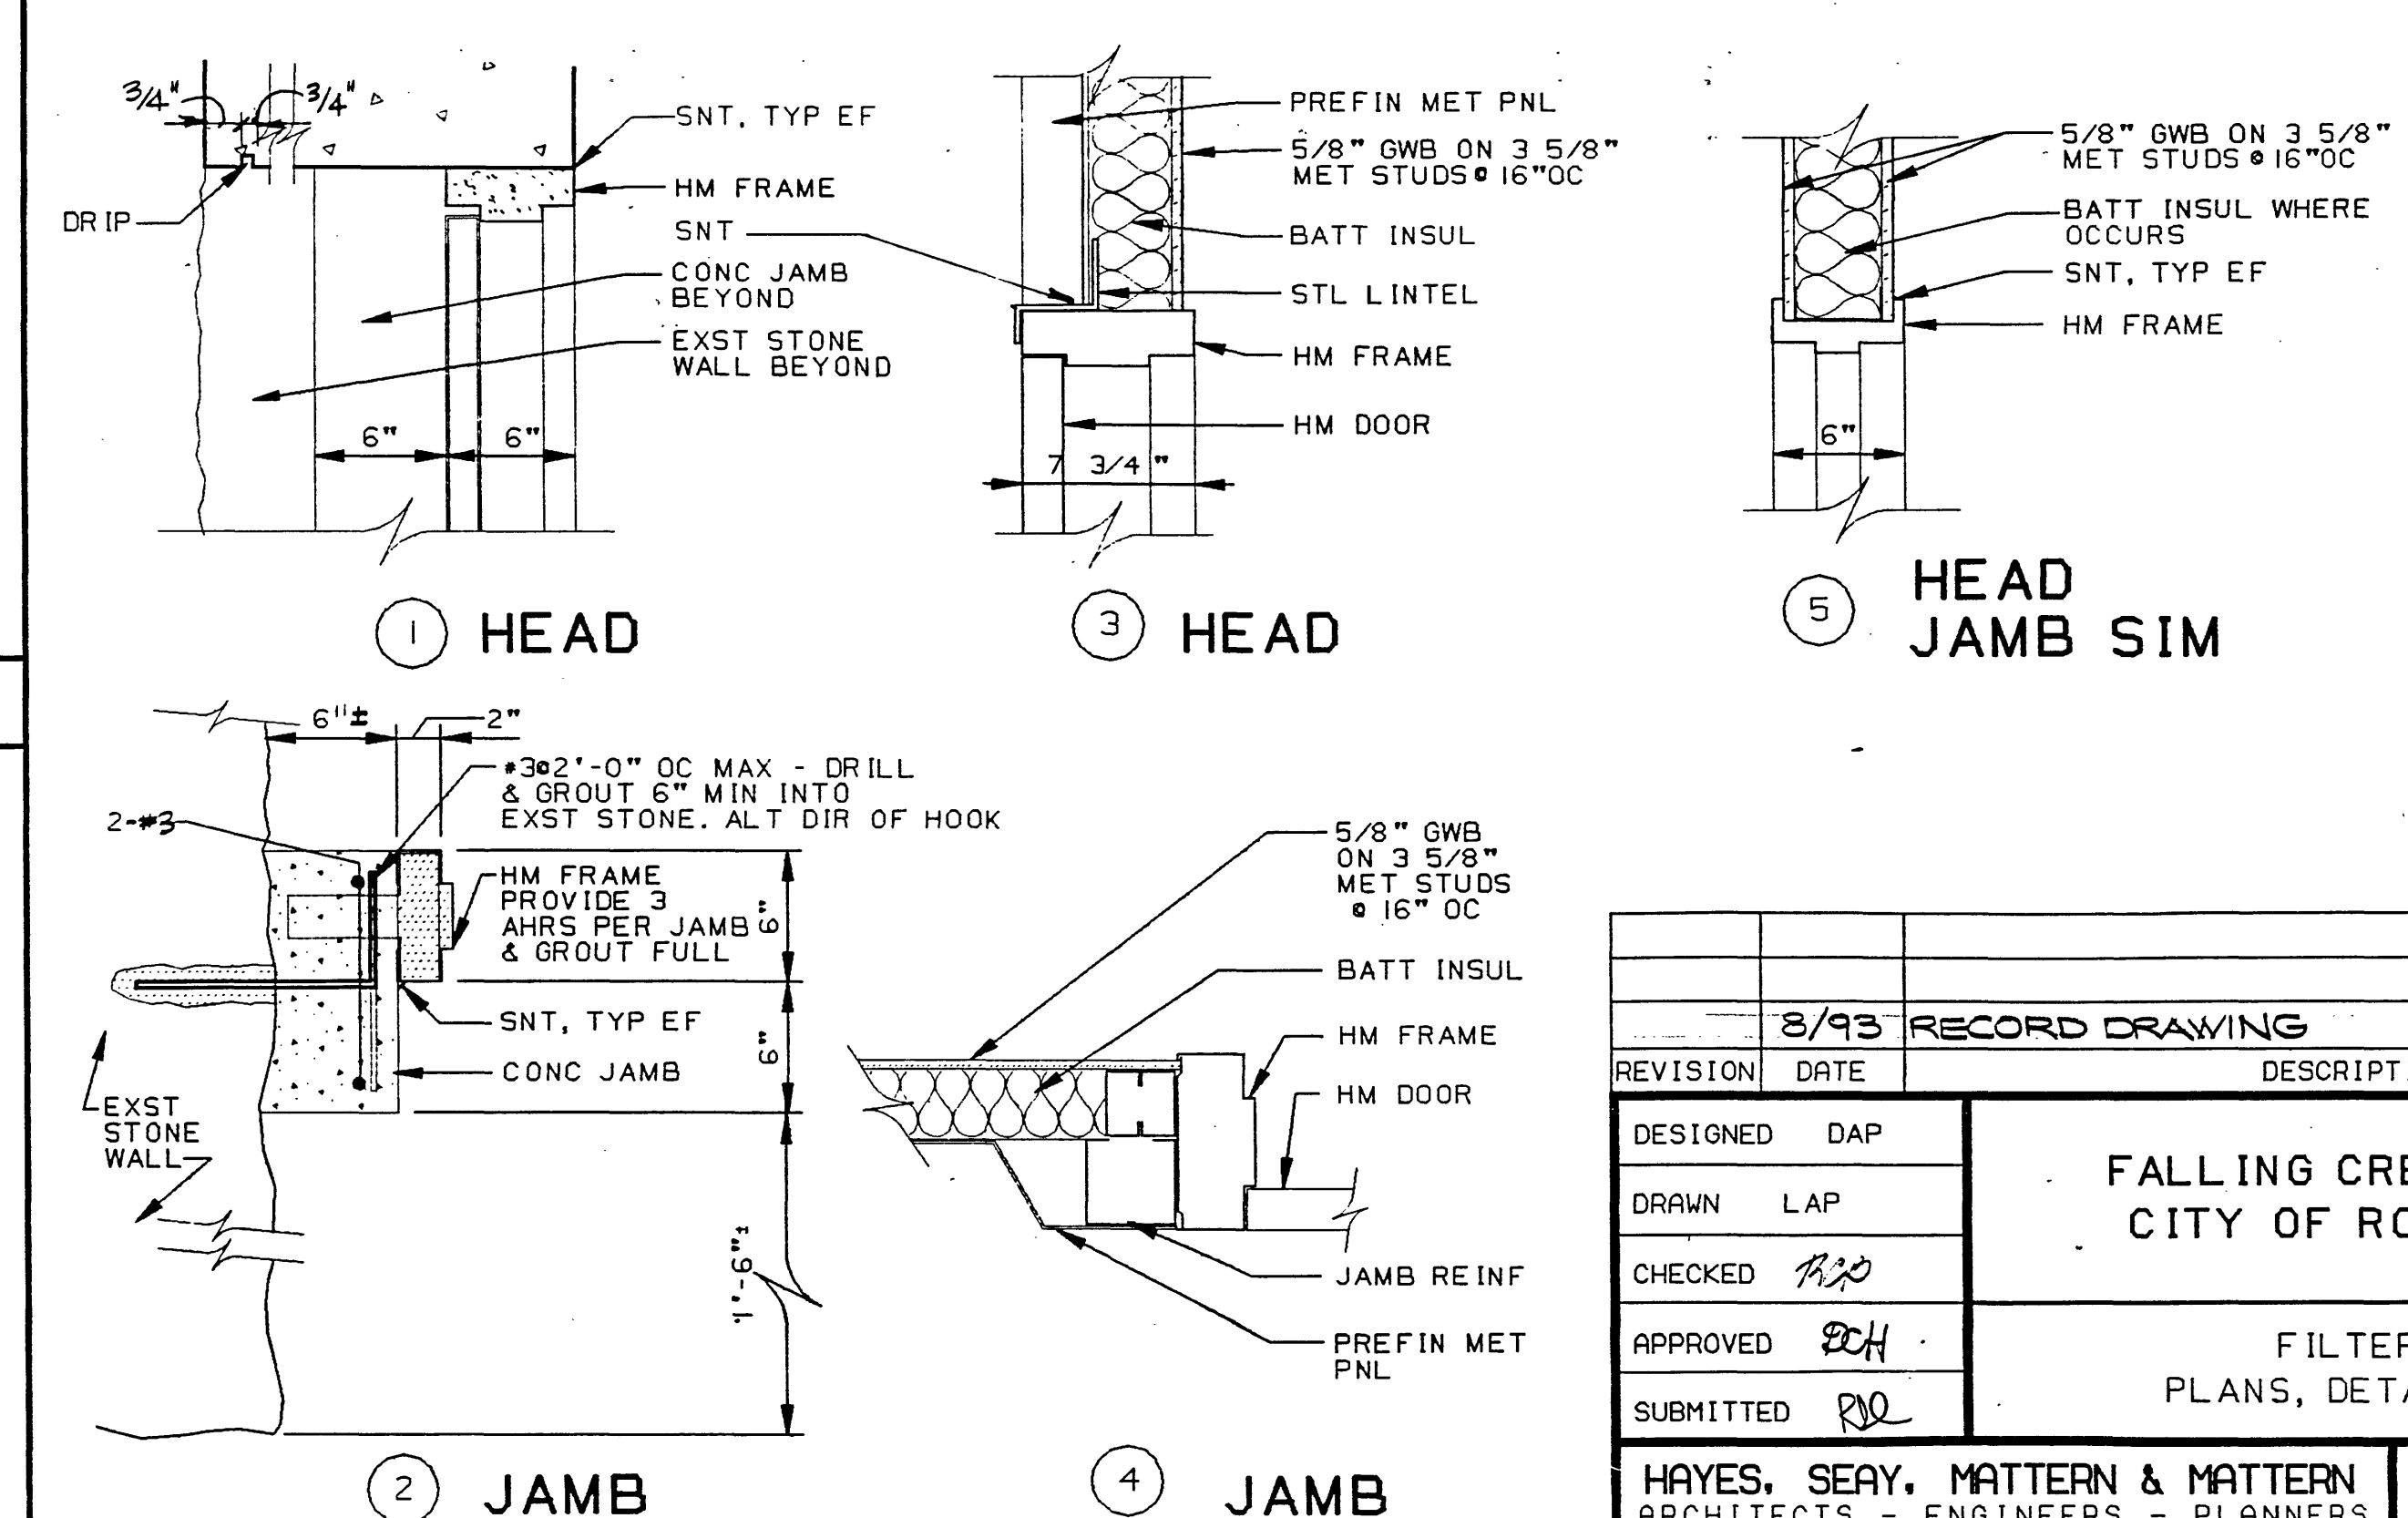

DESIGNED	DAP	DATE	8/93	RECORD DRAWING	DESCRIPTION	BY	APP
DRAWN	LAP	DATE					
CHECKED	RJH	DATE					
APPROVED	RJH	DATE					
SUBMITTED	RJH	DATE					
HAYES, SEAY, MATTERN & MATTERN				FALLING CREEK WATER PLANT			
ARCHITECTS - ENGINEERS - PLANNERS				CITY OF ROANOKE, VIRGINIA			
ROANOKE, VIRGINIA				FILTER BUILDING -			
				PLANS, DETAILS & SCHEDULES			
SCALE AS NOTED				DATE 30 MAY 89			
COMM. NO. 4296				SHEET AI 3			