

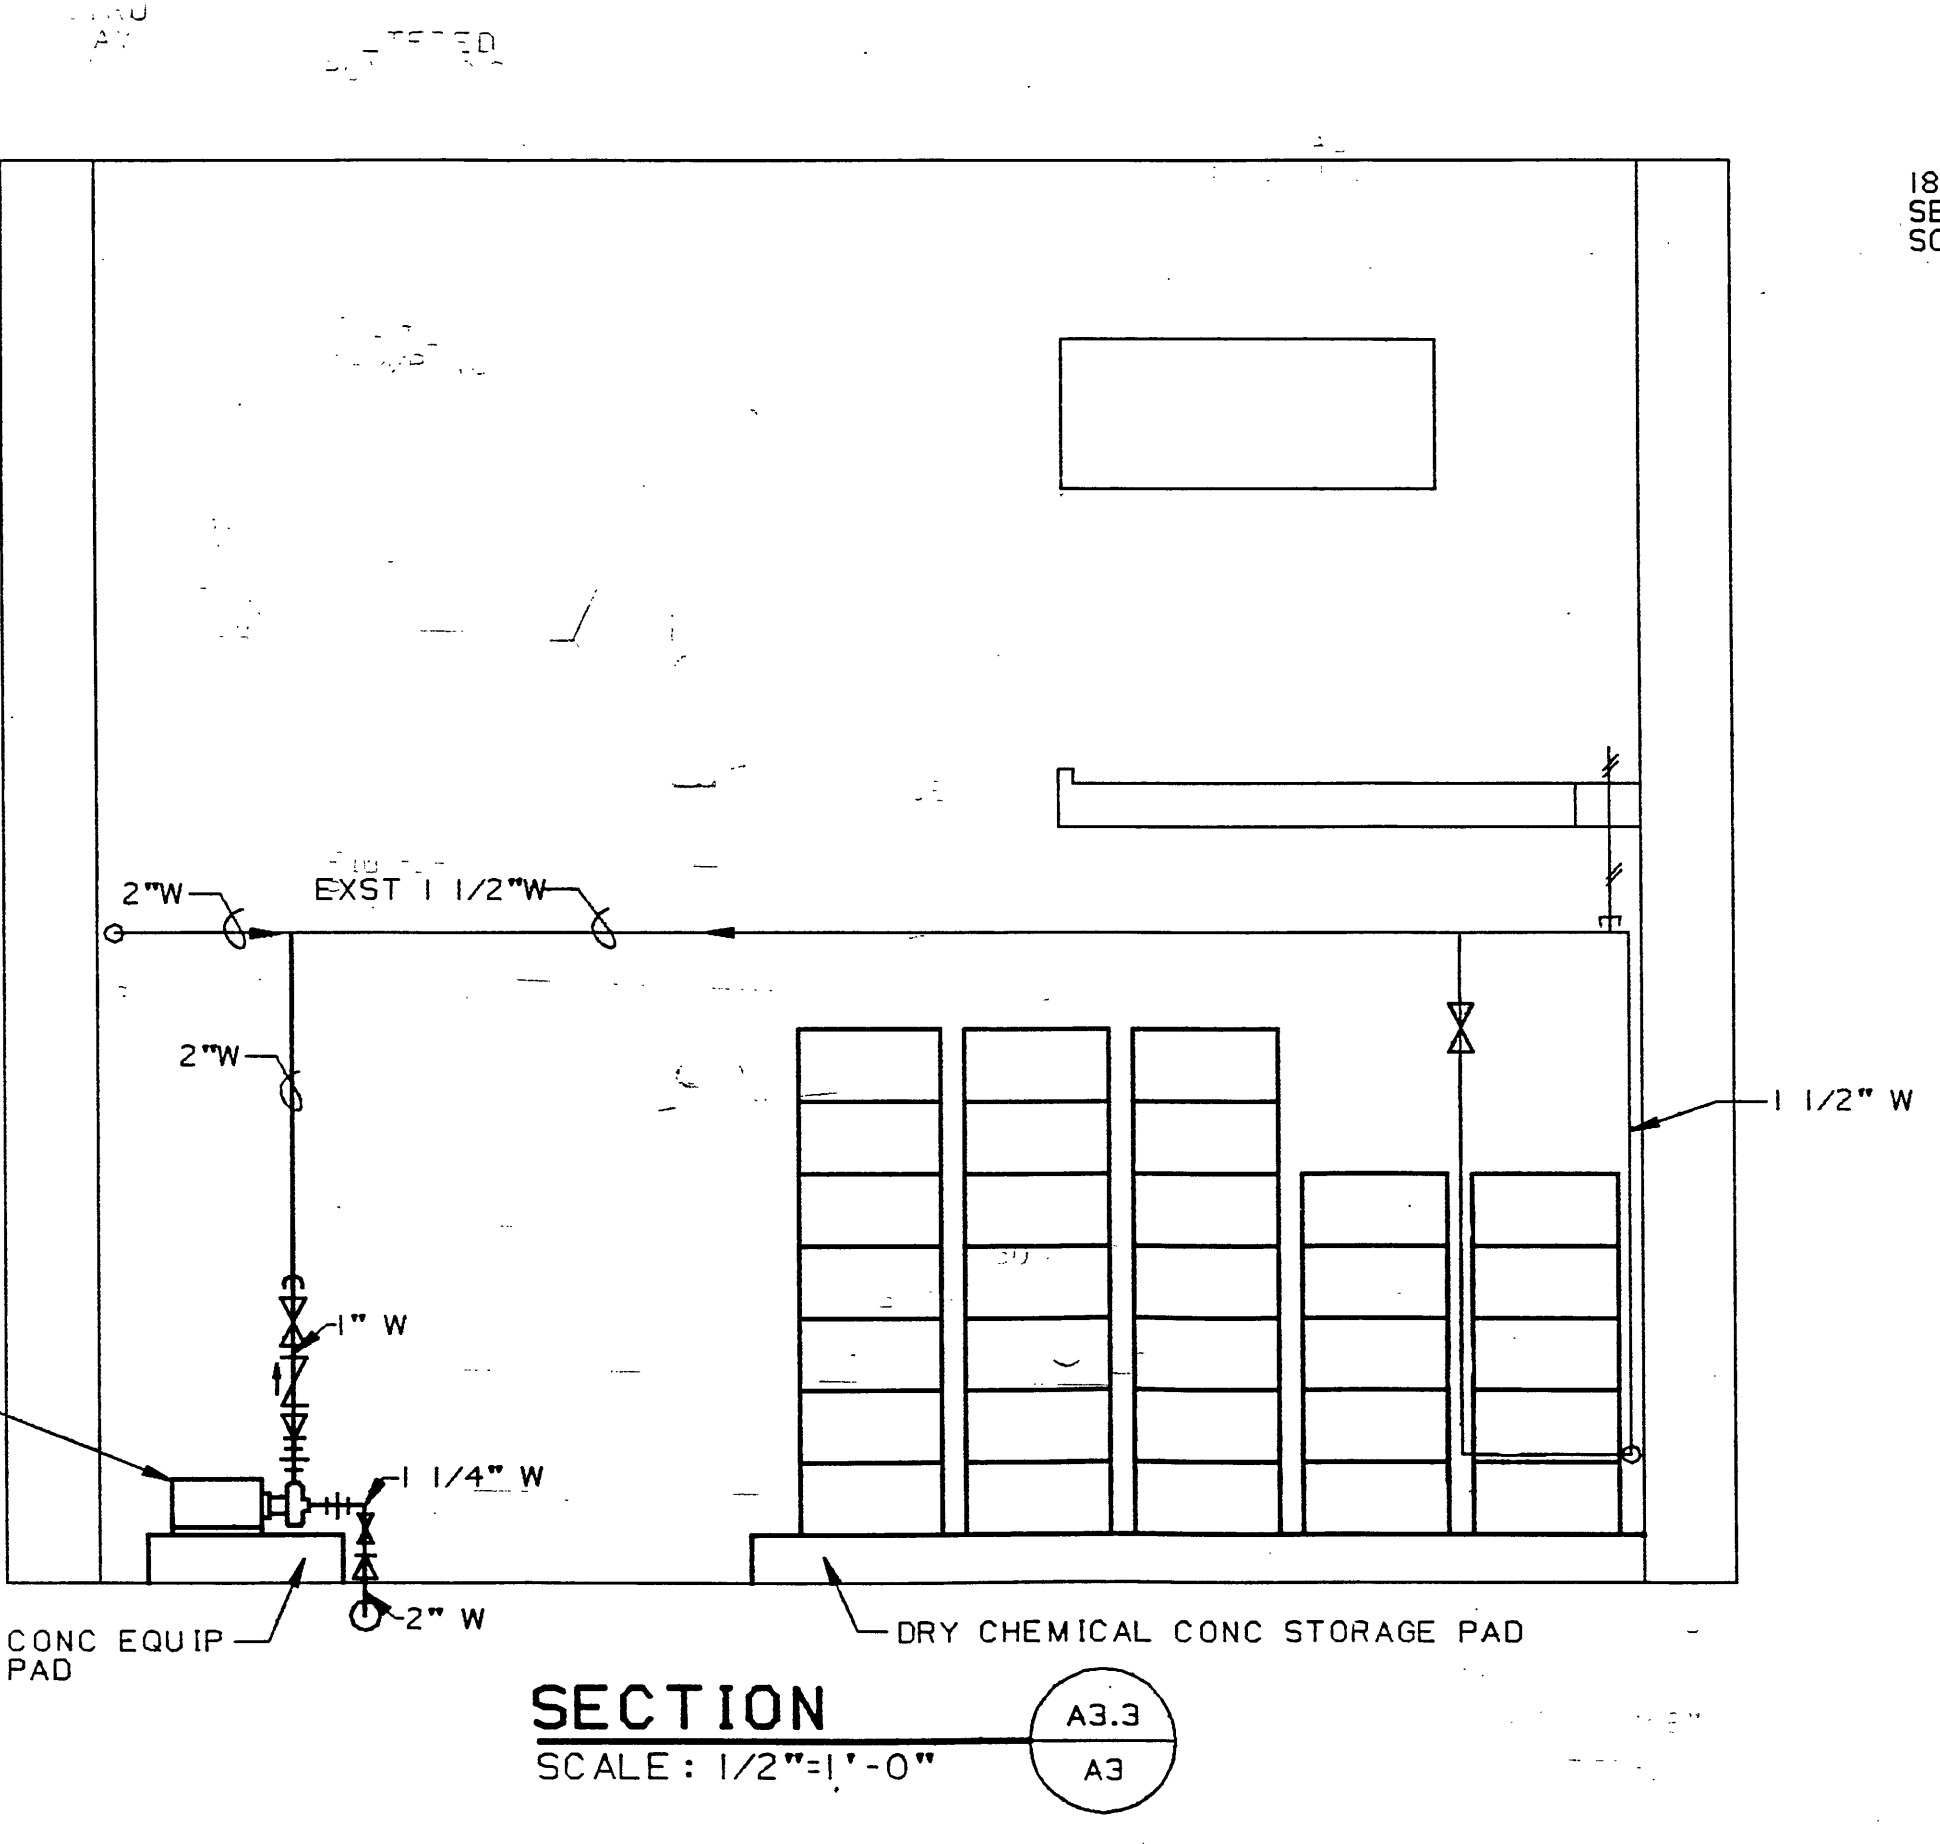
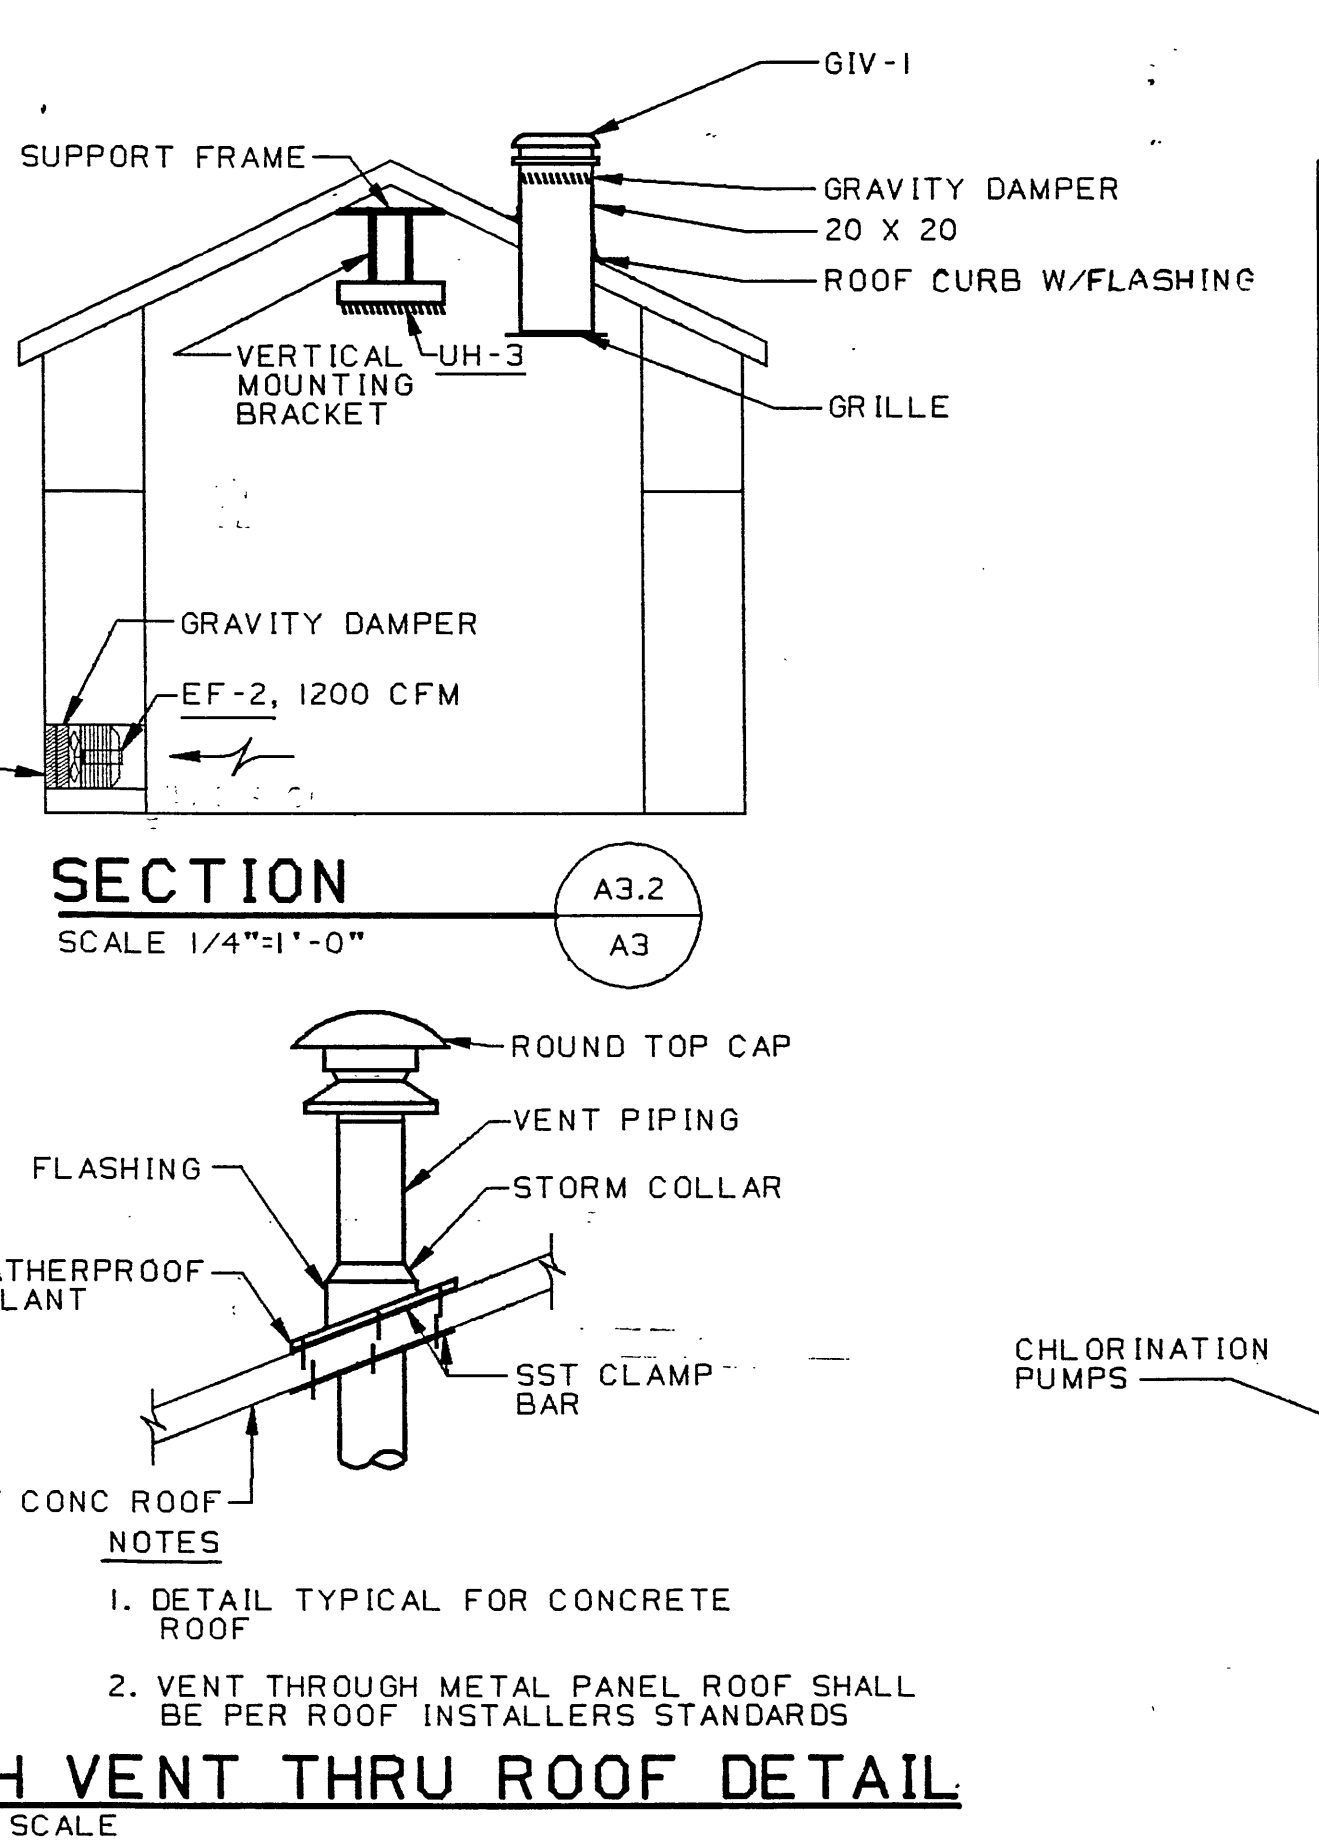
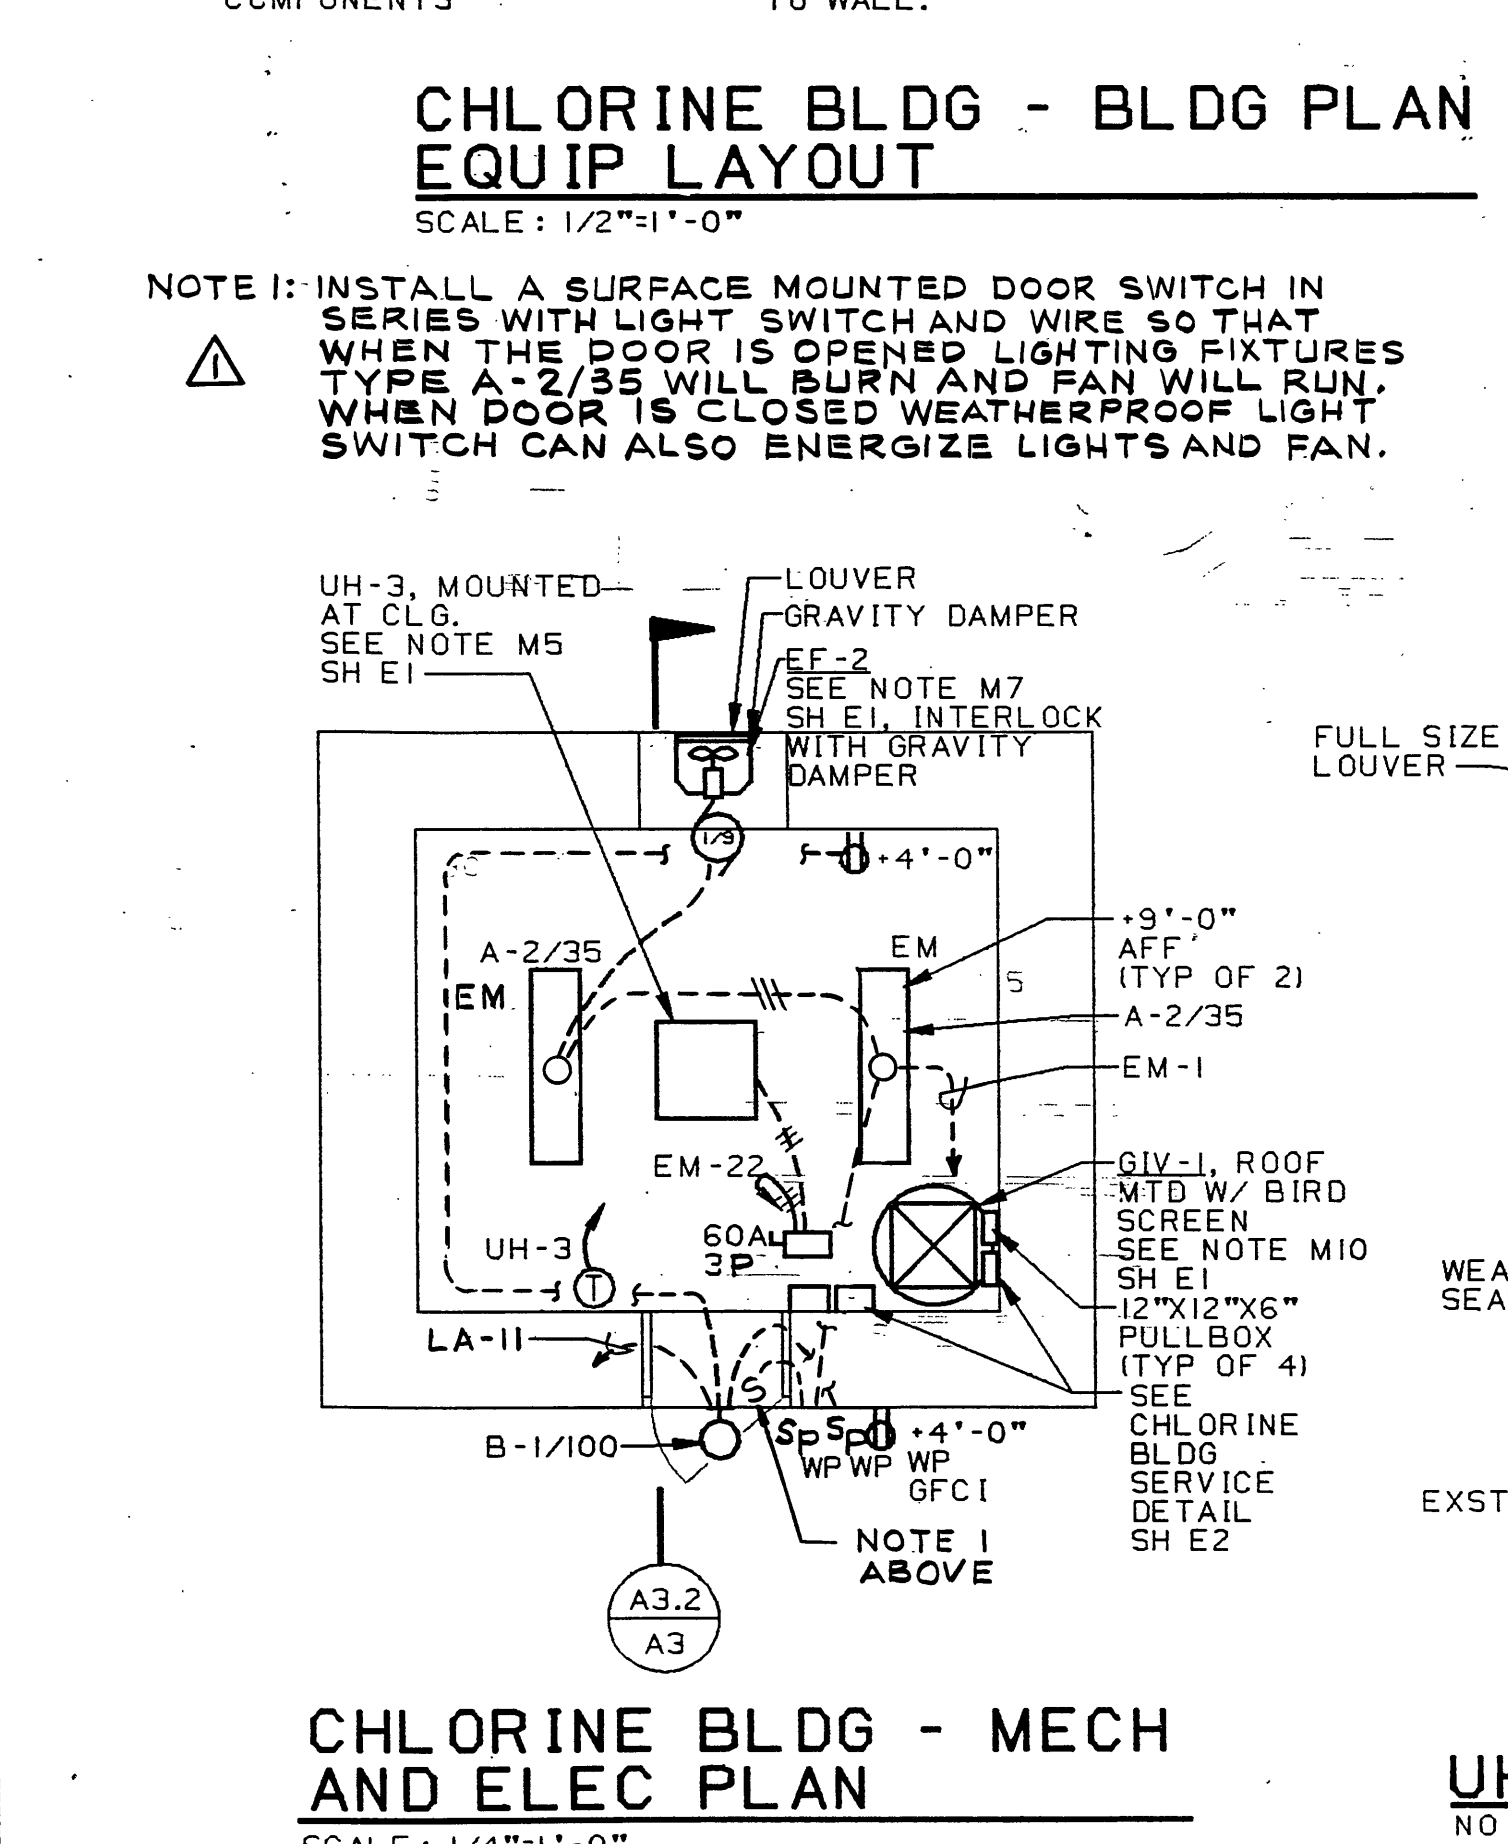
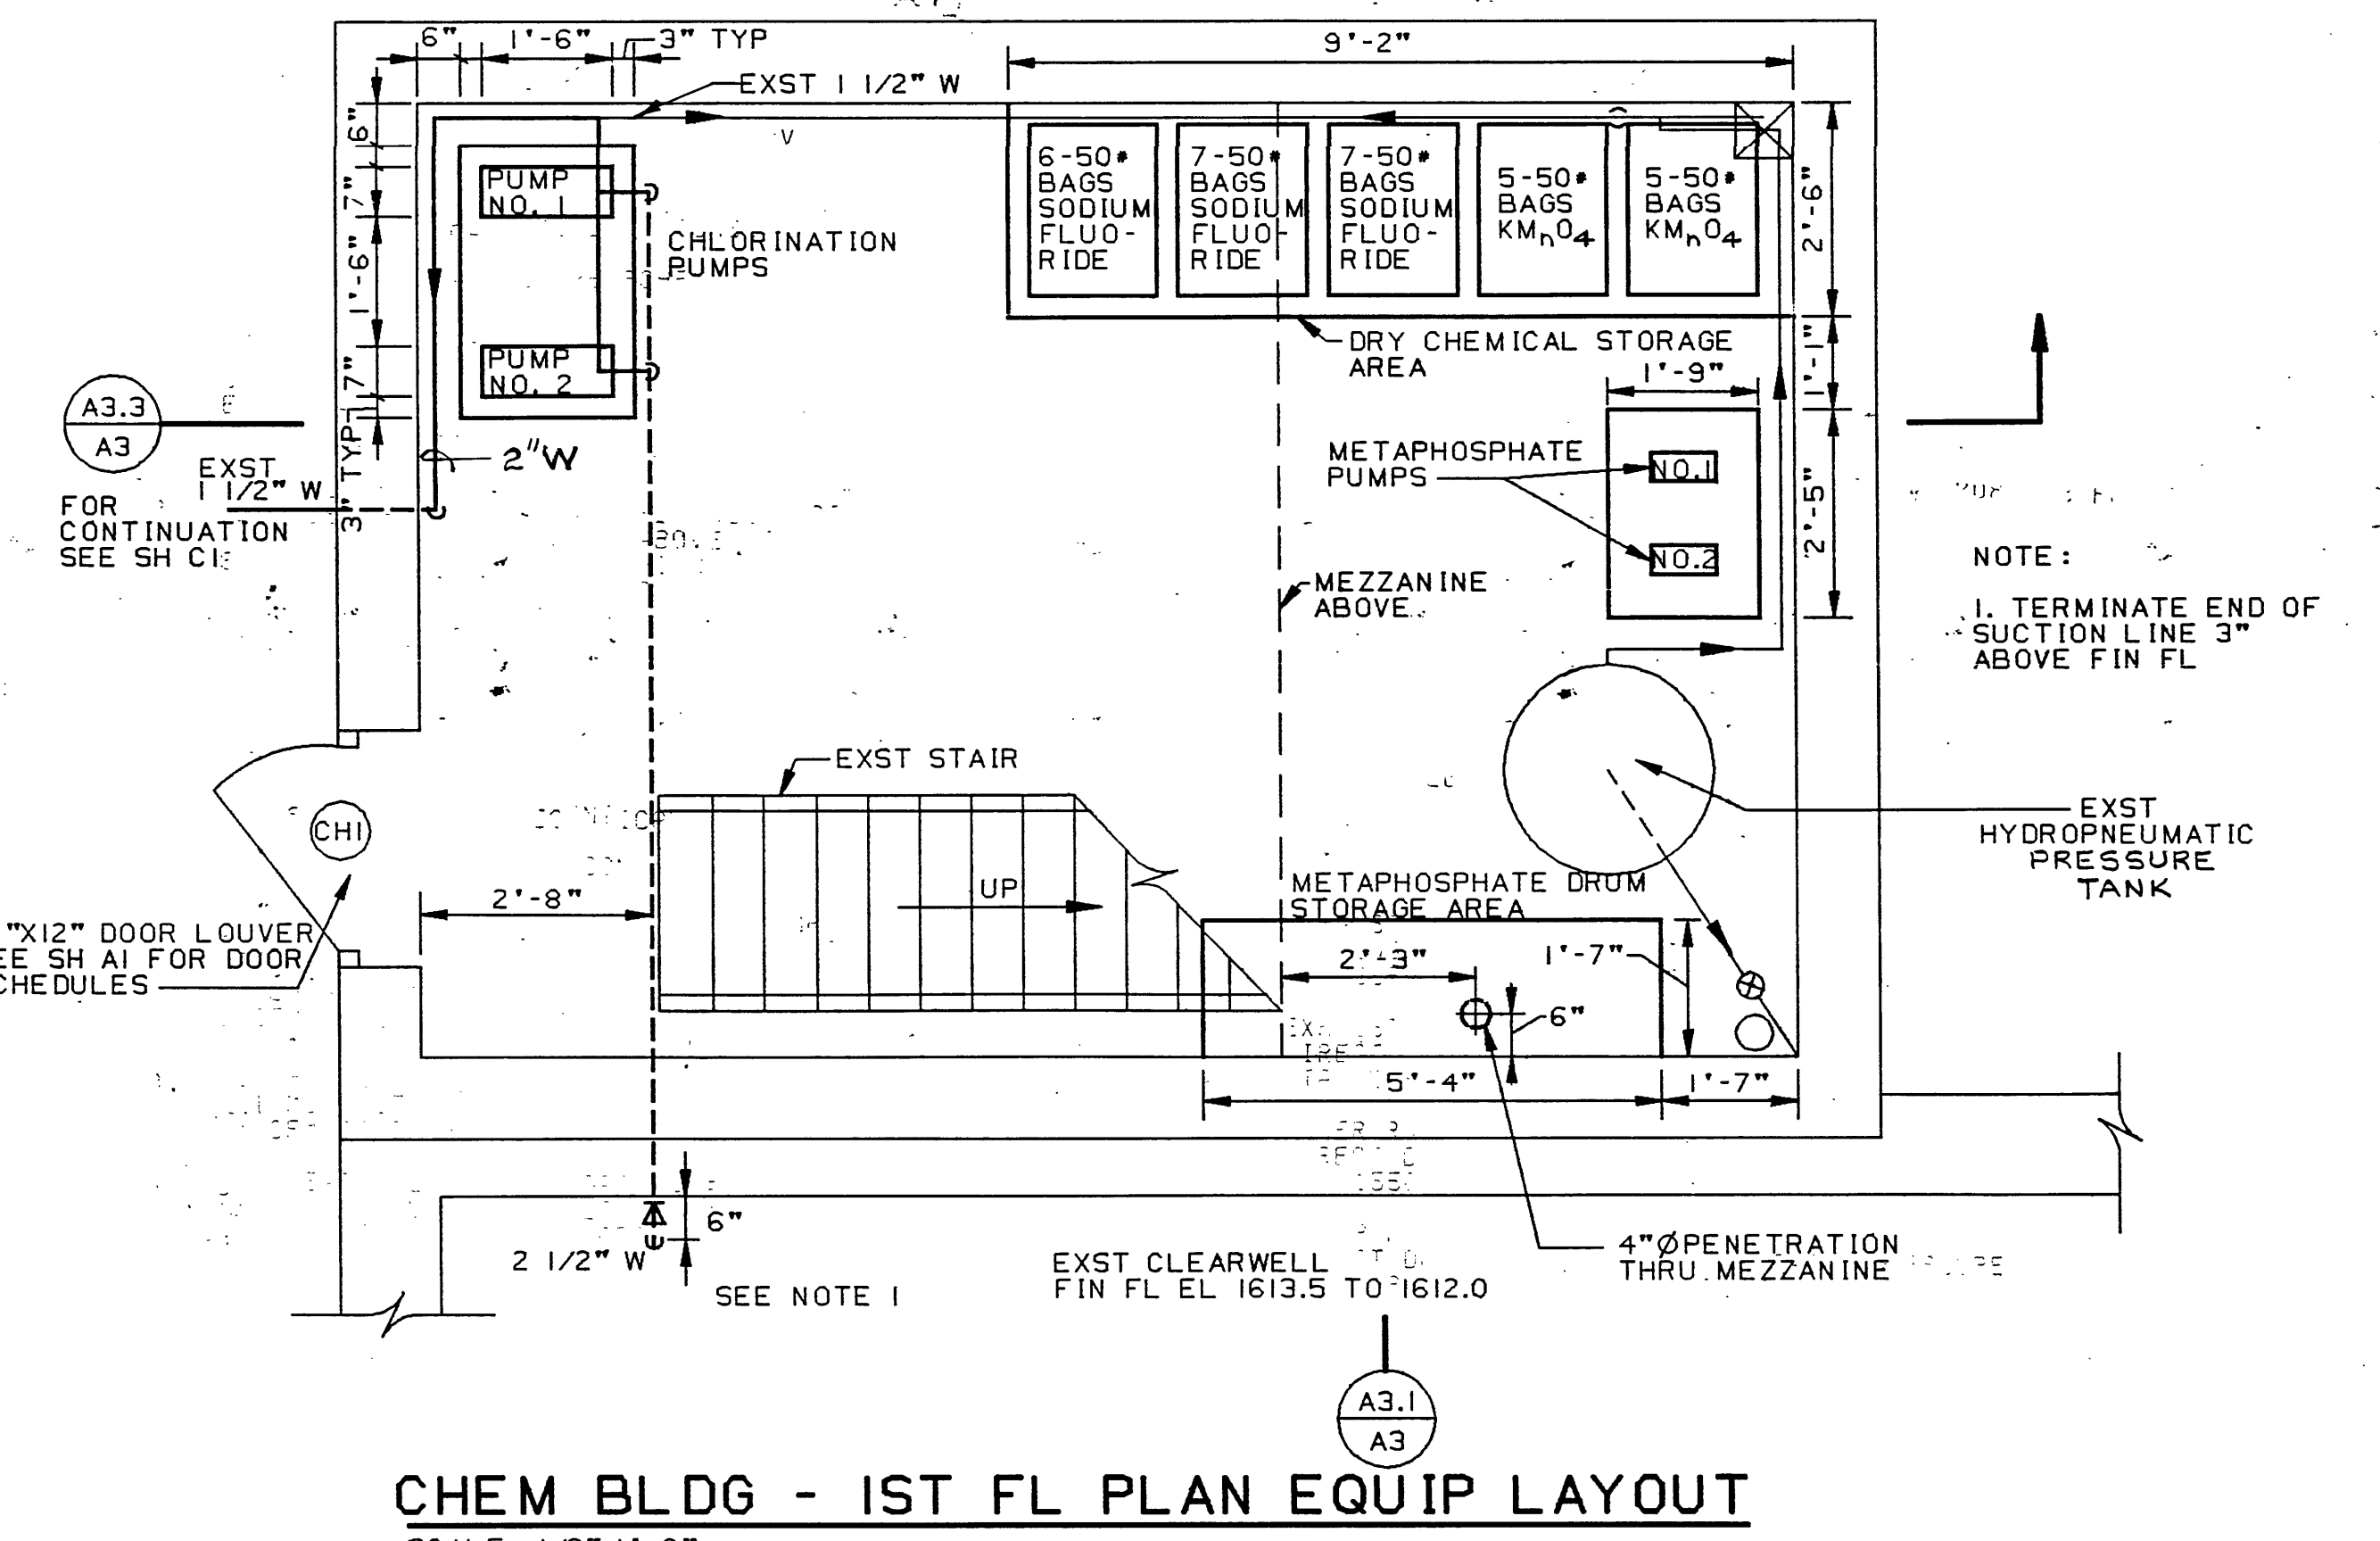
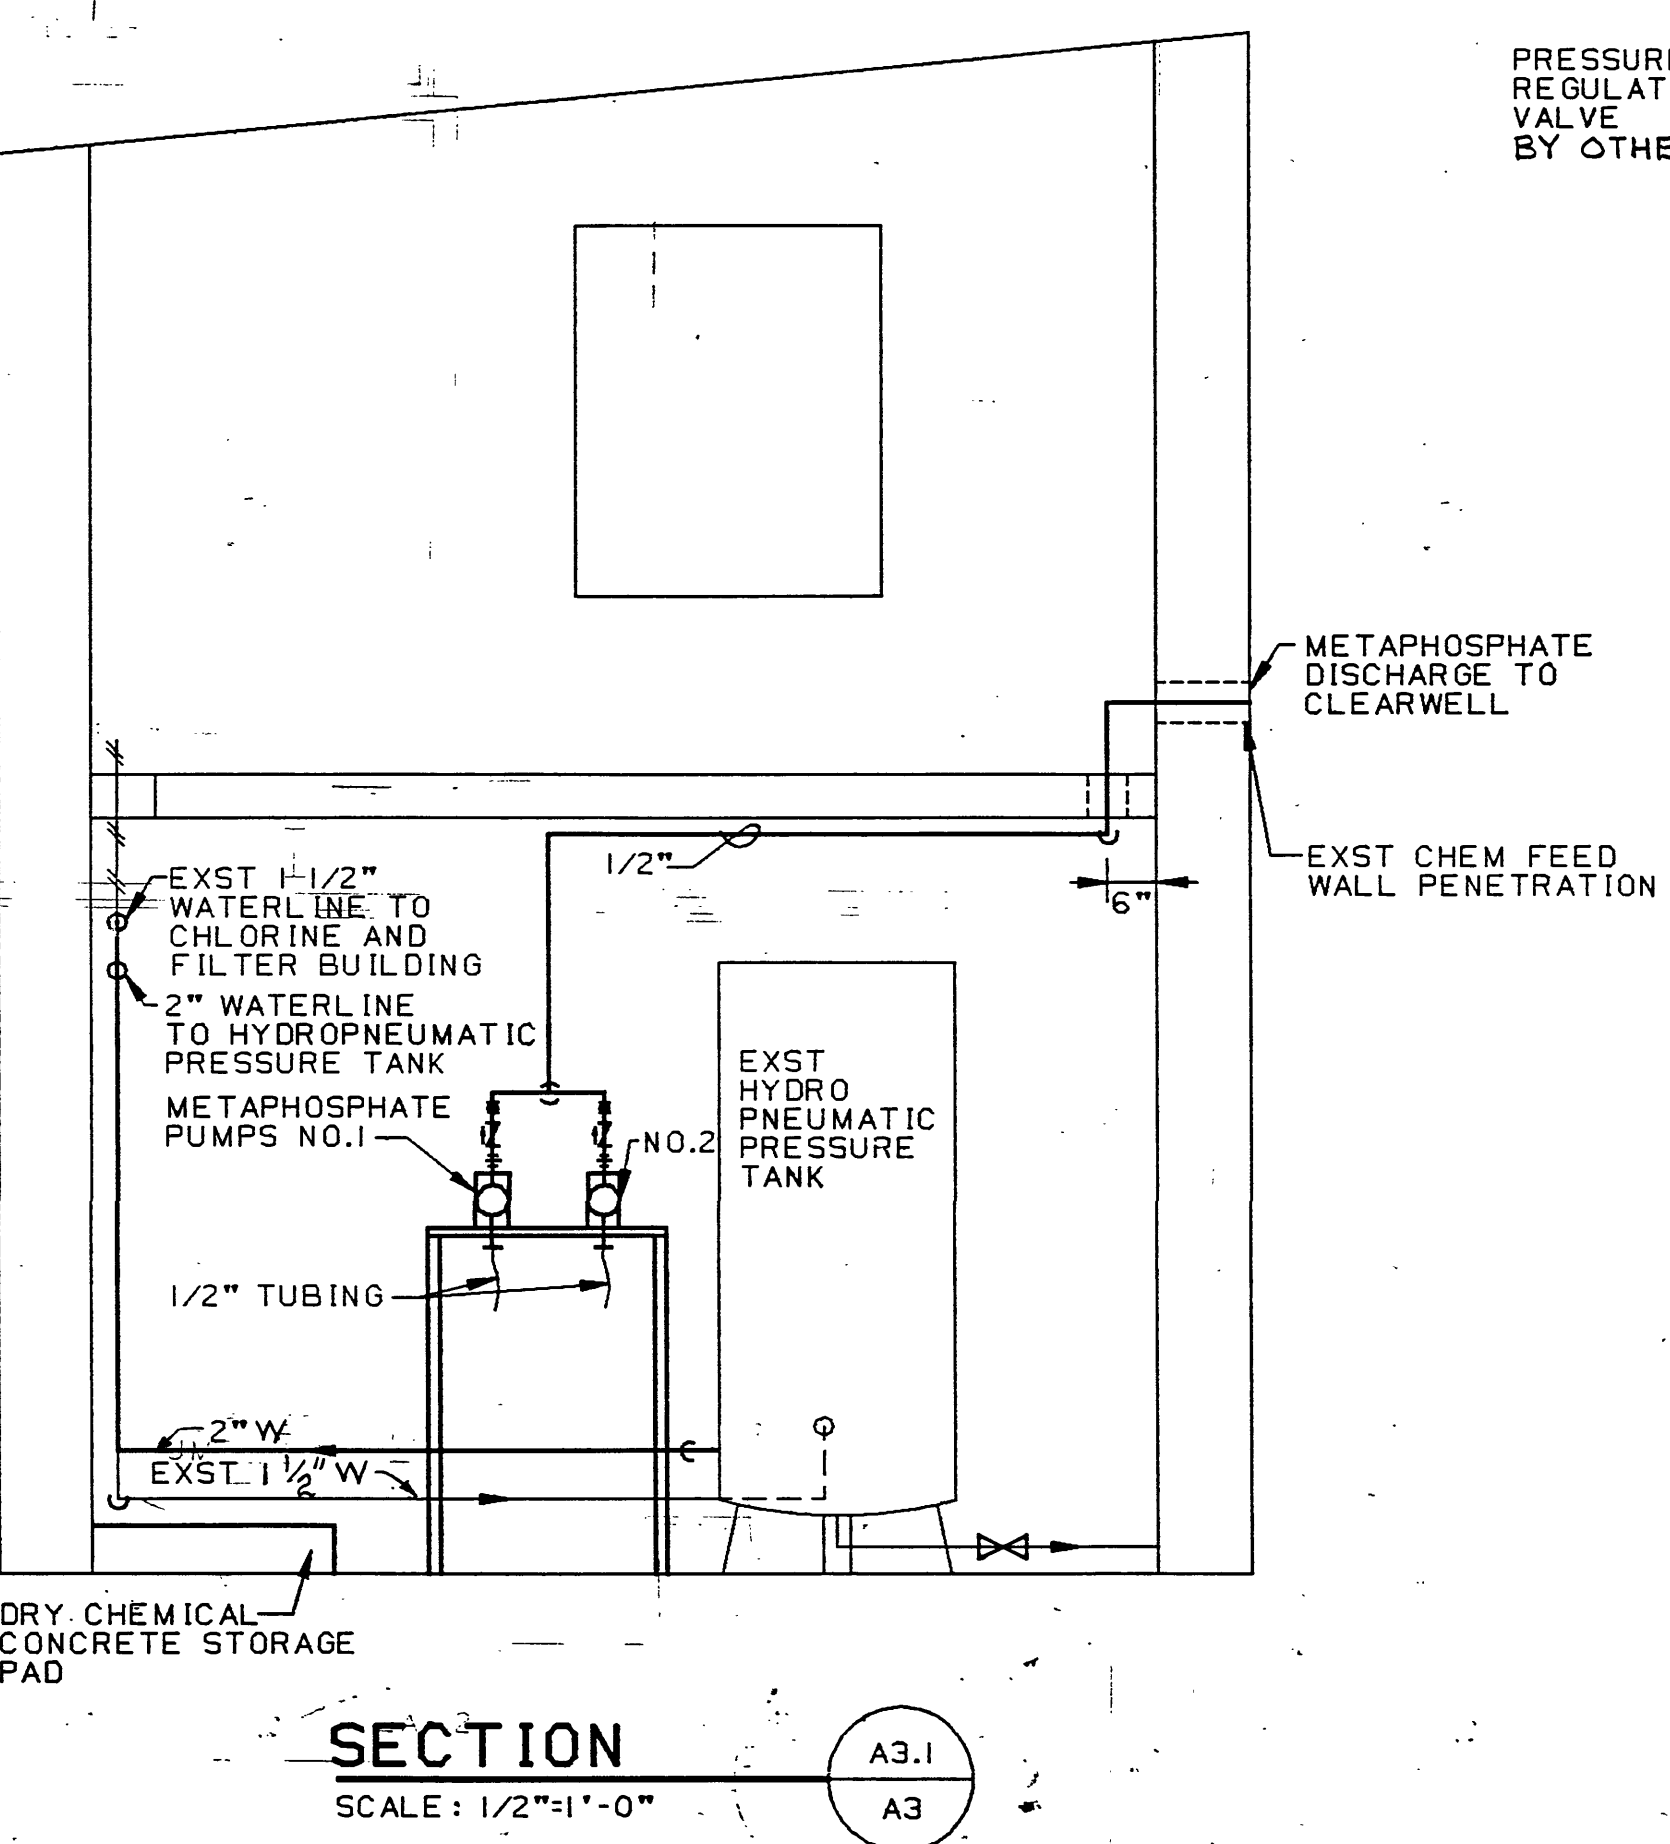
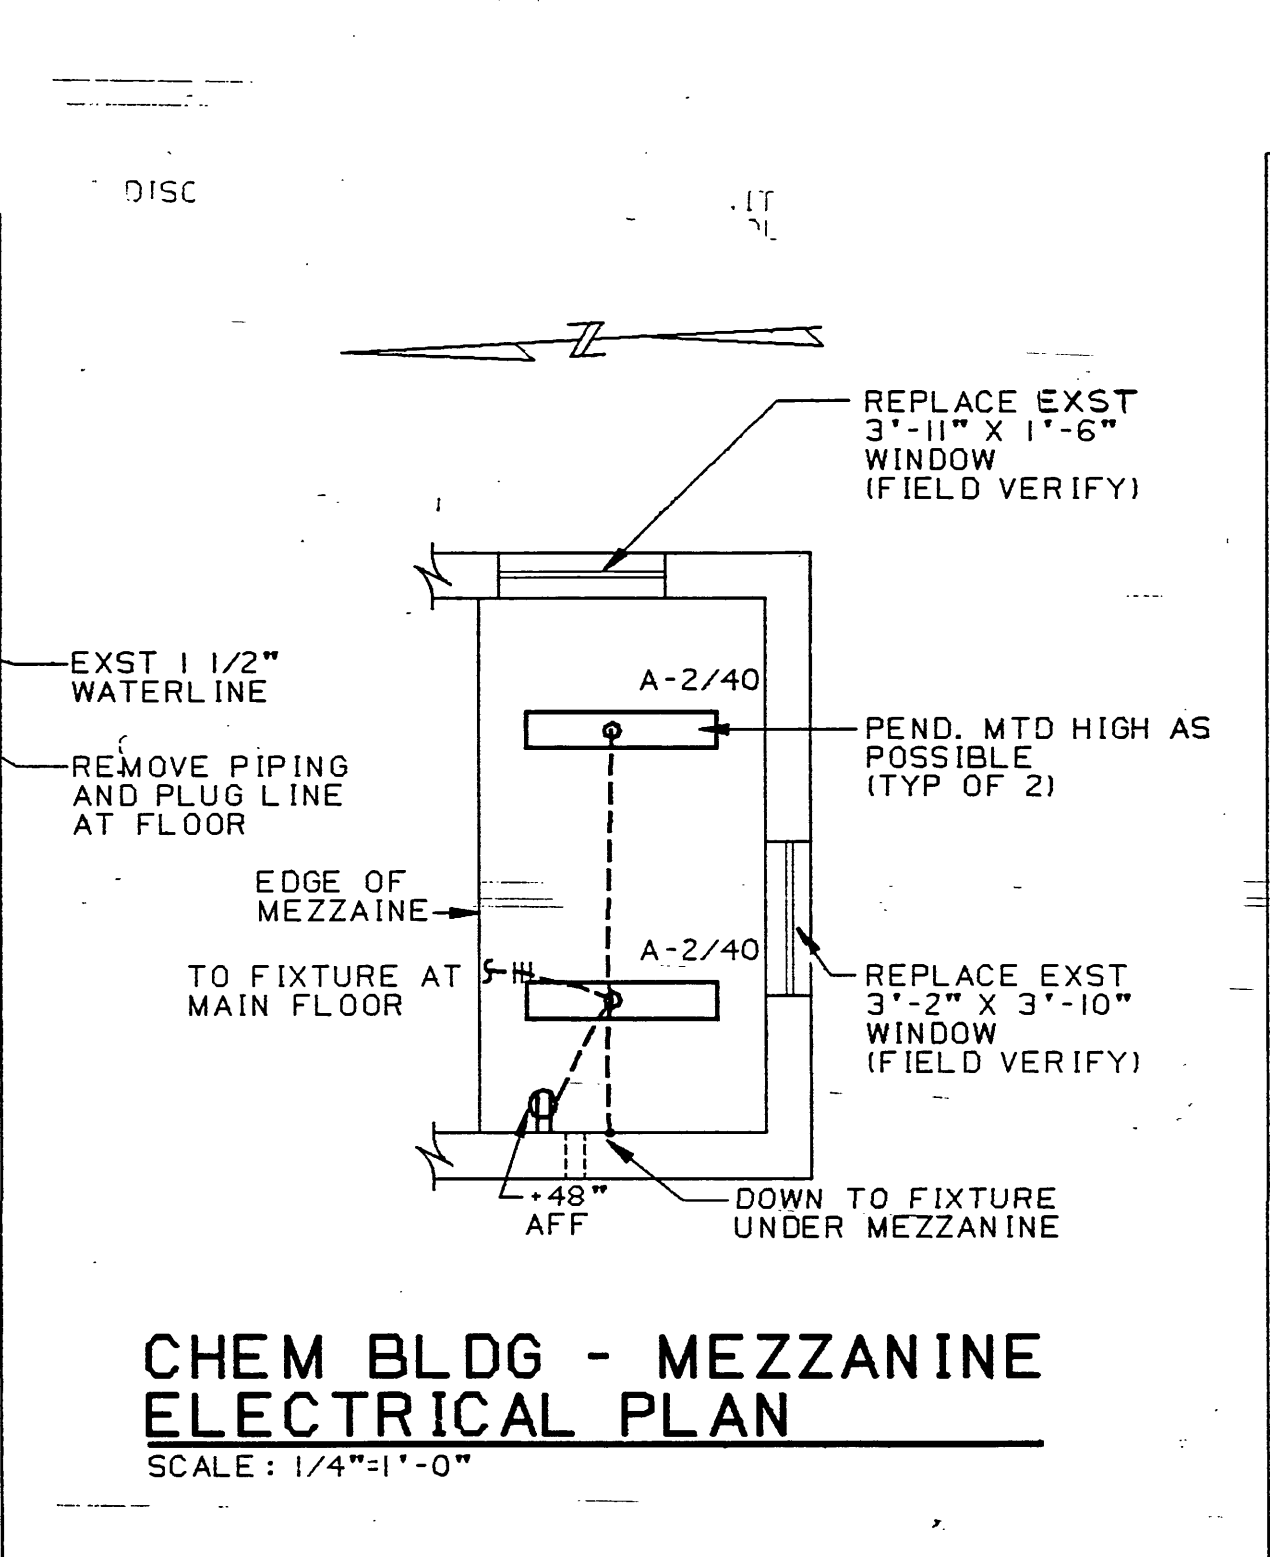
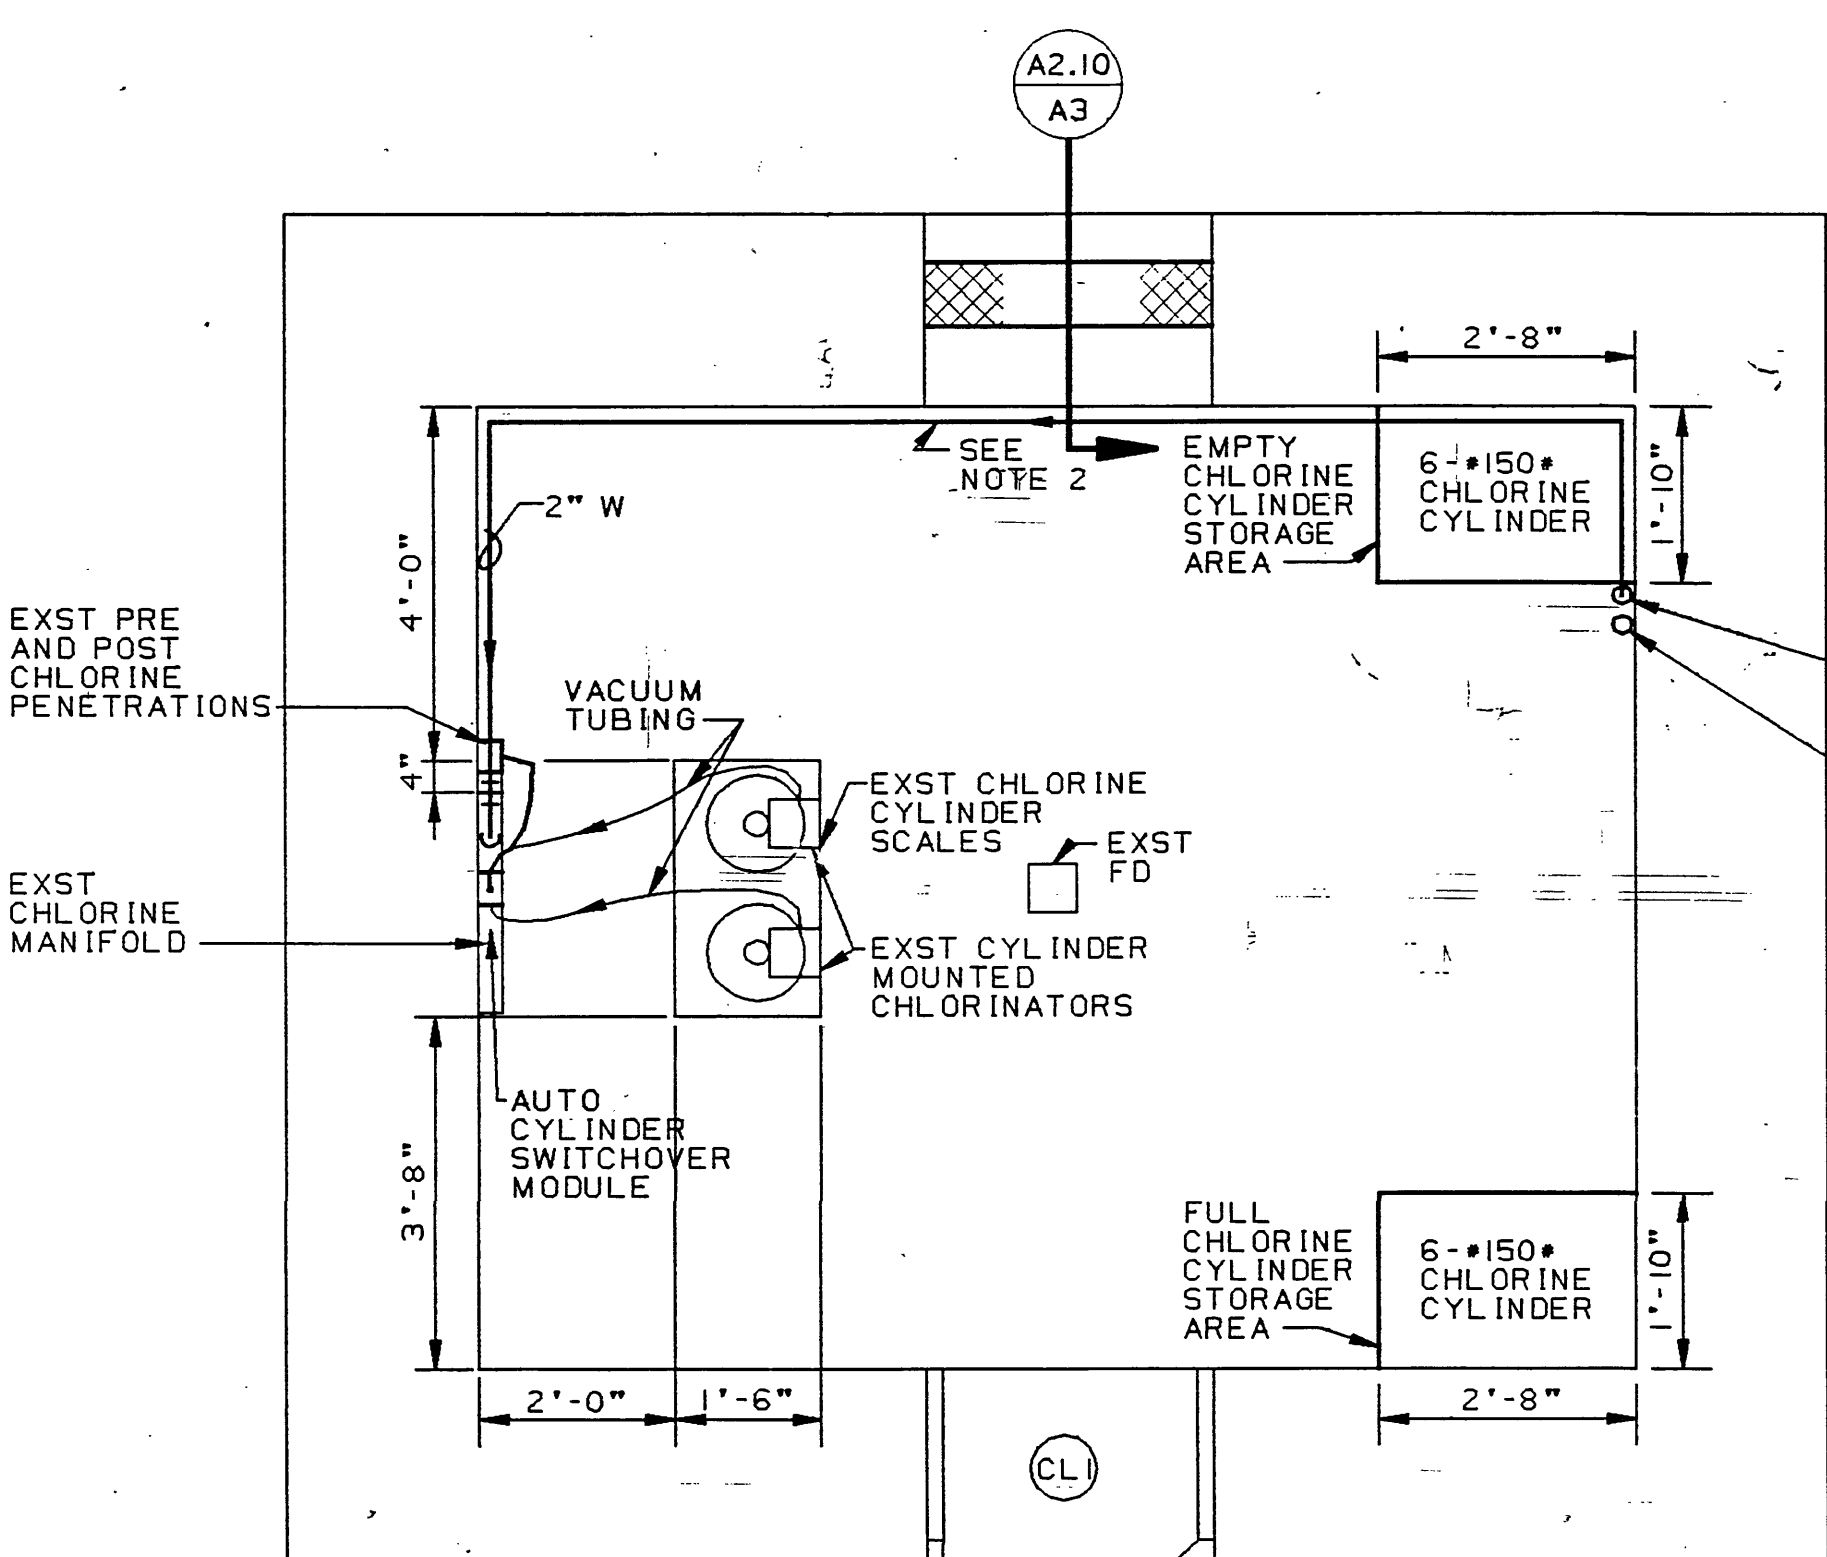
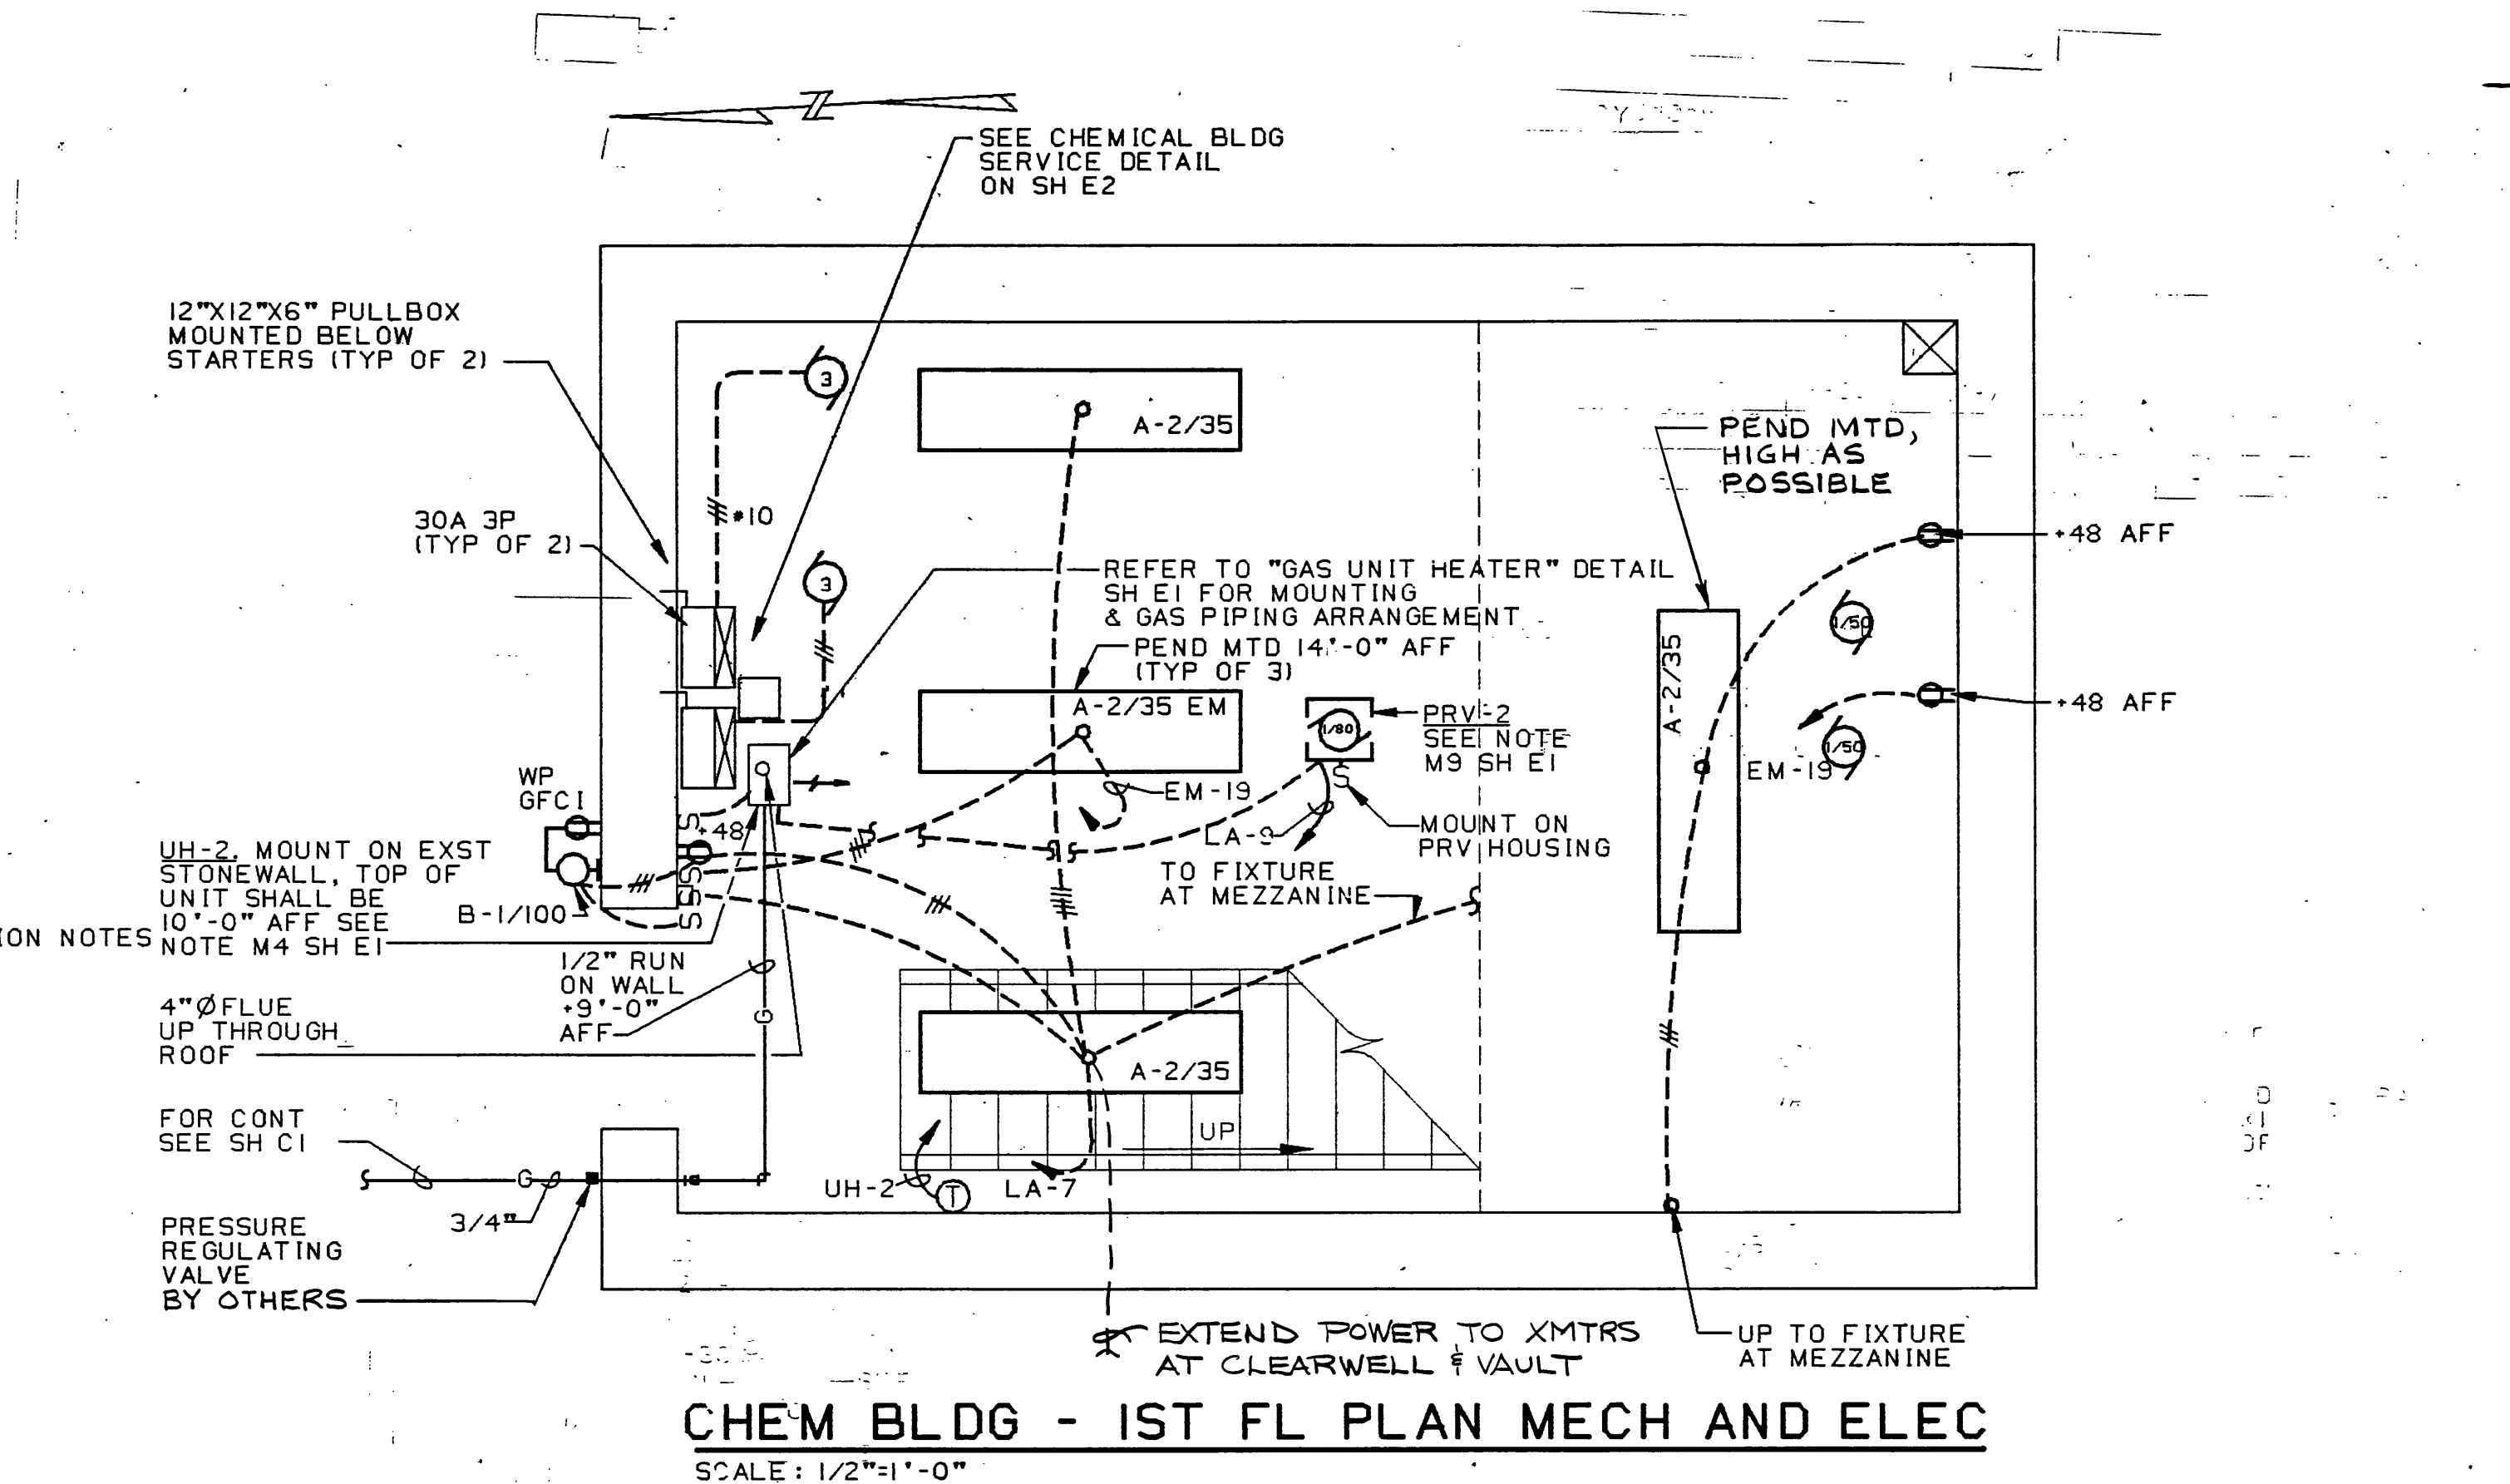
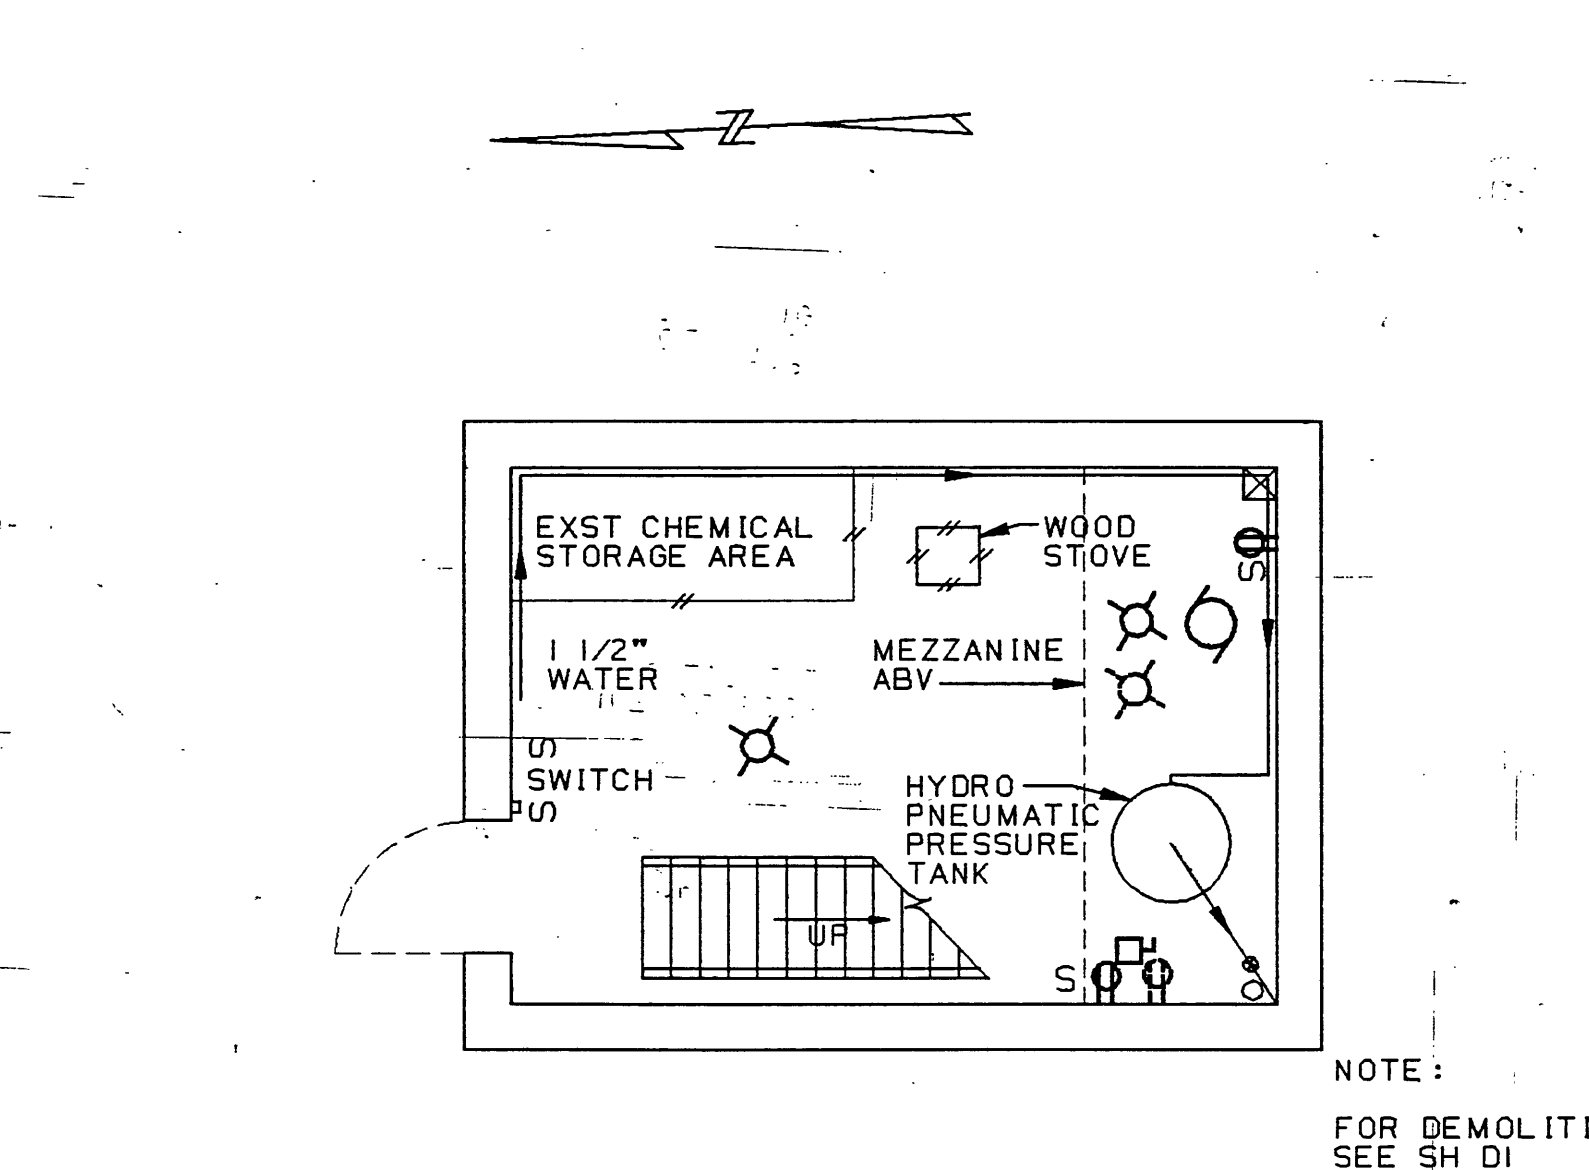
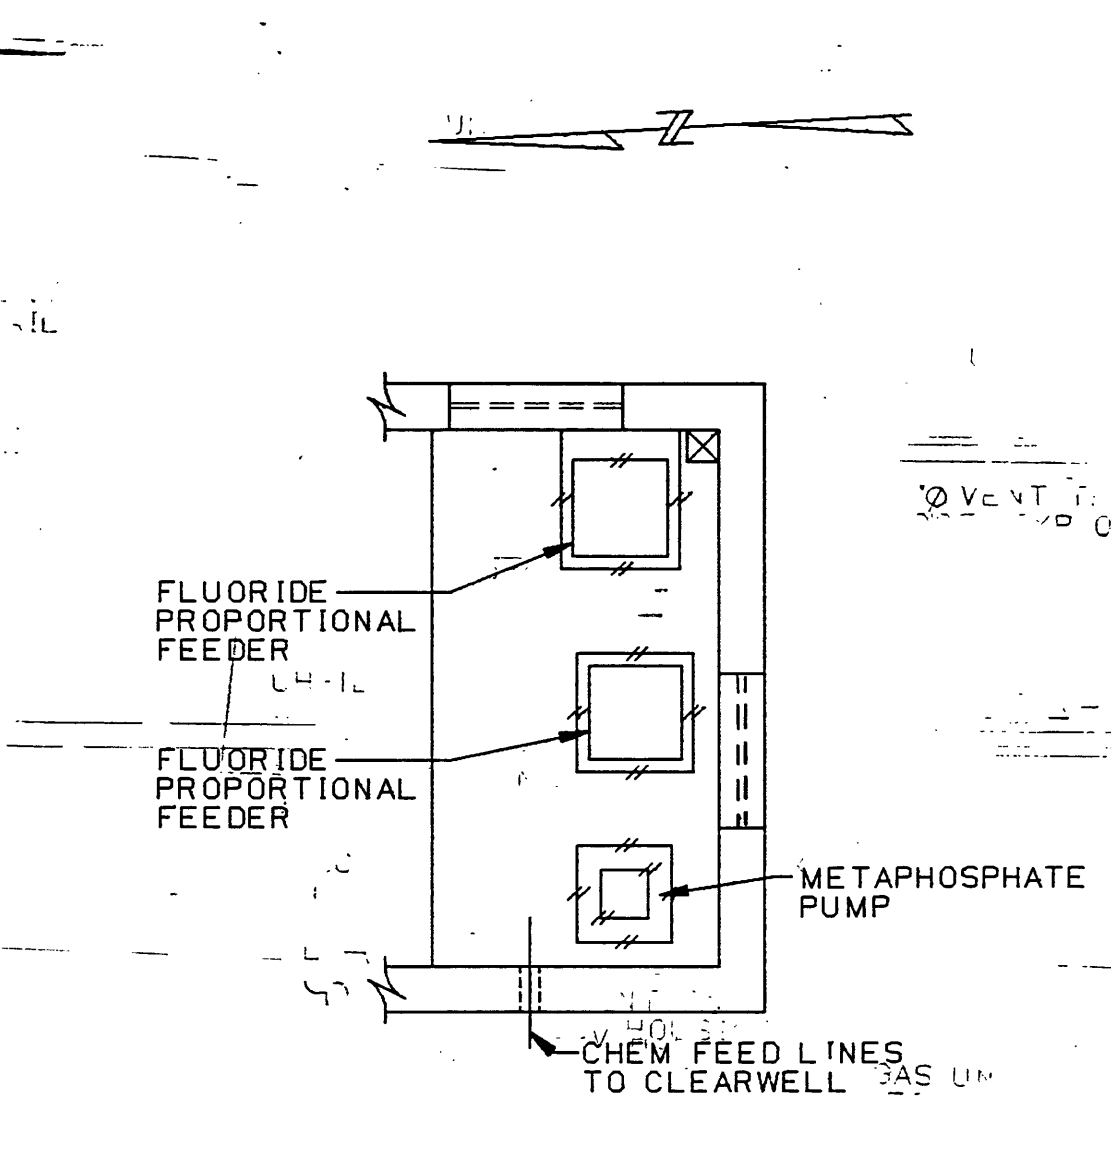
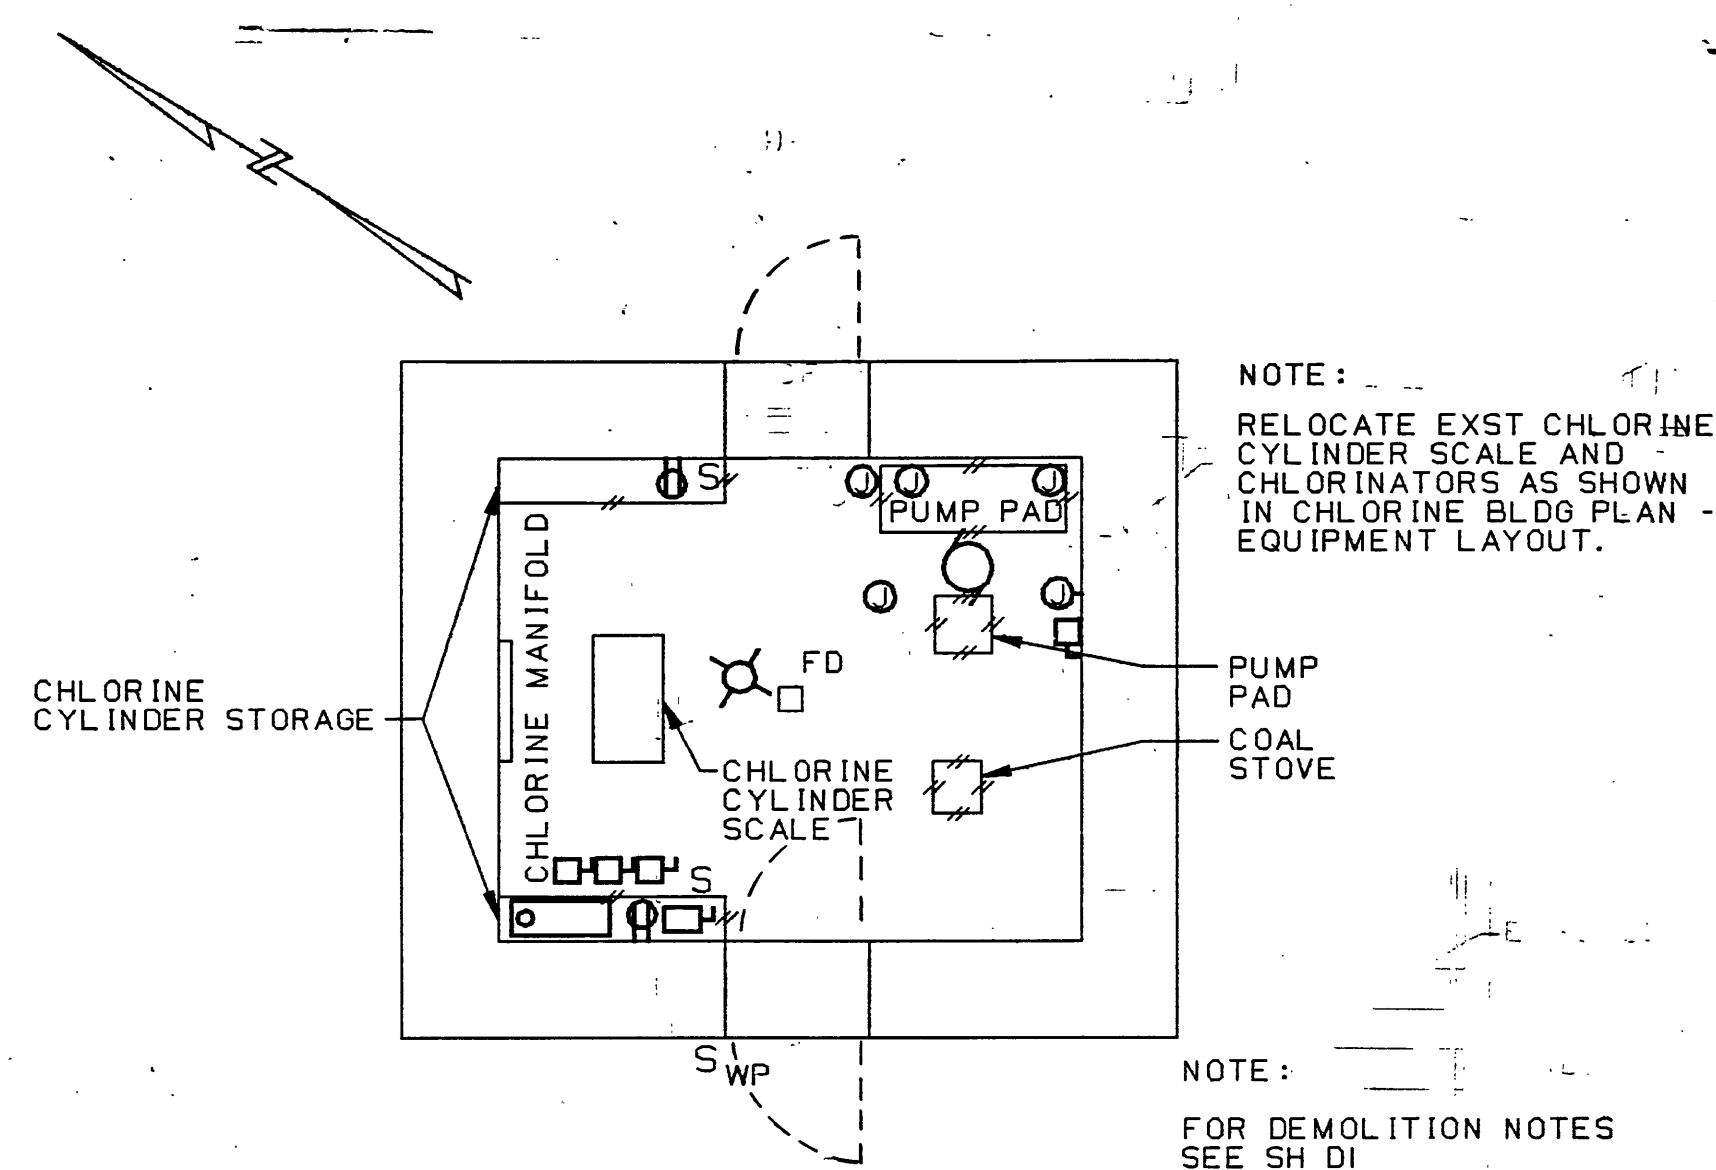


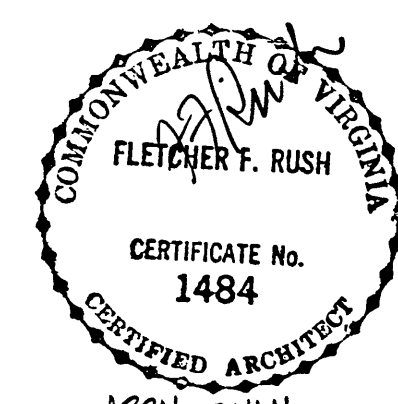

8/93	RECORD DRAWING		
7/89	CHANGE PER VDH COMMENTS	TRK	APP
DESIGNED	TSK/BLR		
DRAWN	DTE		
CHECKED	KOS/APP		
APPROVED	APP		
SUBMITTED	APP		
FALLING CREEK WATER PLANT CITY OF ROANOKE, VIRGINIA			
CHLORINE BUILDING AND CHEMICAL BUILDING			
HAYES, SEAY, MATTERN & MATTERN ARCHITECTS - ENGINEERS - PLANNERS ROANOKE, VIRGINIA		SCALE AS NOTED	COMM. NO. 4296
DATE 30 MAY 1989		SHEET A3	

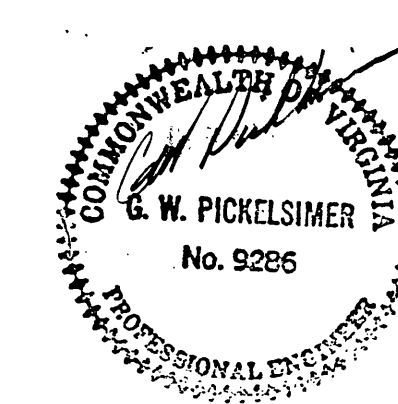

4296 FALL CRK A3
052689 REV. C DRAW 1
5X LAP