

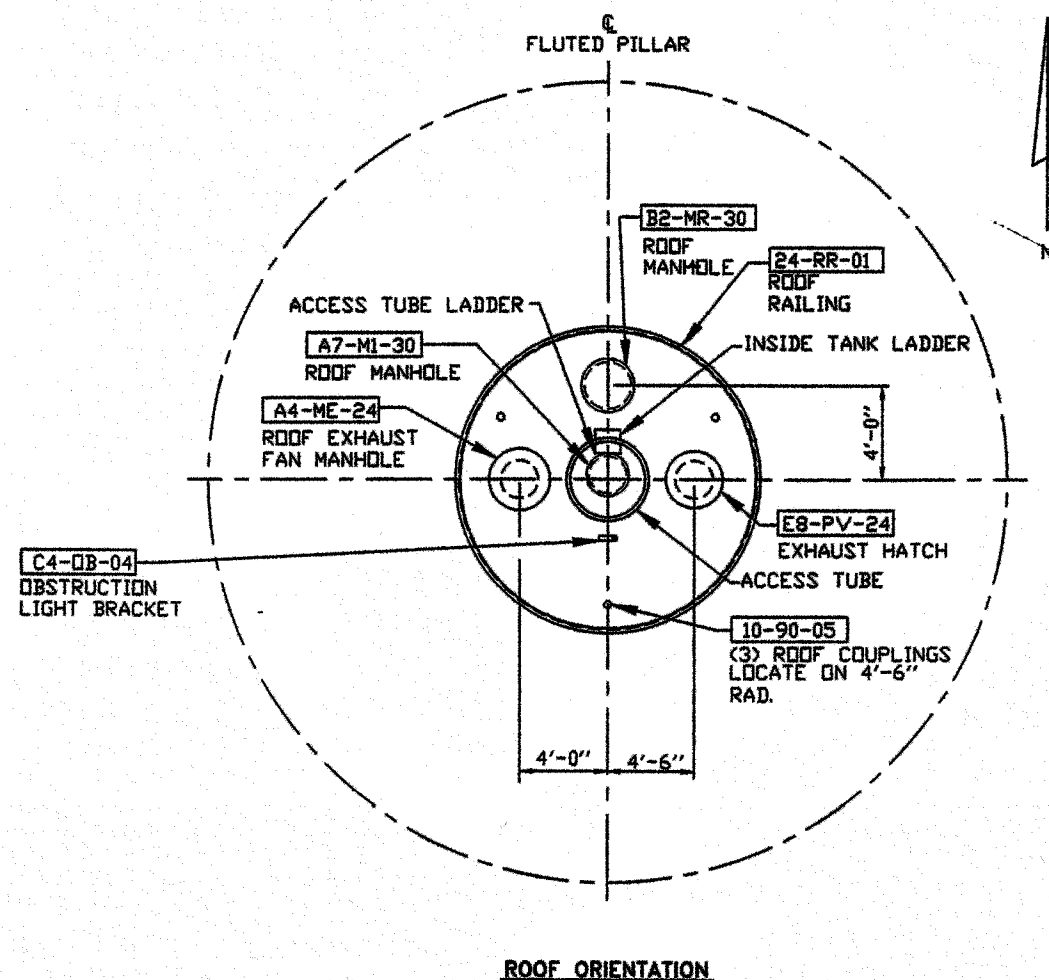


BILL OF MATERIAL				
SUB-ASSY NO	PART NO	QTY	DESCRIPTION	MAT'L REQ'D.
24-RR-01		3	ROOF RAILING	
	24-30-01	3	RAILING POST	3" x 3" x 1/4" ANGLE x 3'-5 3/4" LG.
	24-30-02	1	TOP RAIL	2 1/2" x 2 1/2" x 1/4" ANGLE x 15'-9" LG.
	24-40-01	1	MID RAIL	3" x 3/8" BAR x 15'-9" LG.
	24-40-02	1	TOE PLATE	4" x 1/4" BAR x 15'-9" LG.
	24-40-03	3	SPLICE BAR	1 1/2" x 1/4" BAR x 4" LG.
				PC WT LBS
				395

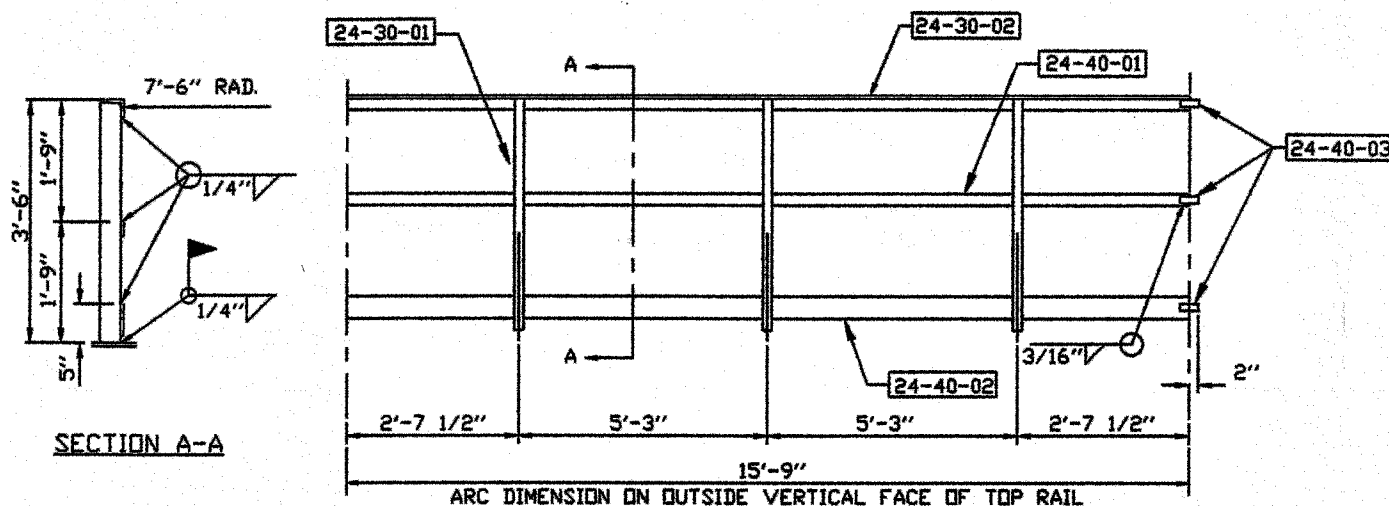


BILL OF MATERIAL				
SUB ASS'Y NO.	PART NO.	QUANTITY	DESCRIPTION	MATERIAL REQ'D.
24-VA-01		8	FLUTE VENT ASSEMBLY	
	24-22-01	1	VENT BODY	10" EX. STRG. PIPE x 8" LG.
	24-90-02	1	FLATTENED-EXPANDED METAL	1/2"-#16 GA x 10 1/4" DIA.
	24-90-03	1	STAINLESS STEEL BAND	S.S. BAND FOR 10 3/4" OD PIPE
	24-90-10	1	#20 MESH	#20 S.S. MESH 16" DIA.
				WEIGHT
				75

NOTE: INSTALL #20 MESH AND S.S. BAND TO INSIDE OF FLUTE VENT AFTER PAINTING IS COMPLETE.

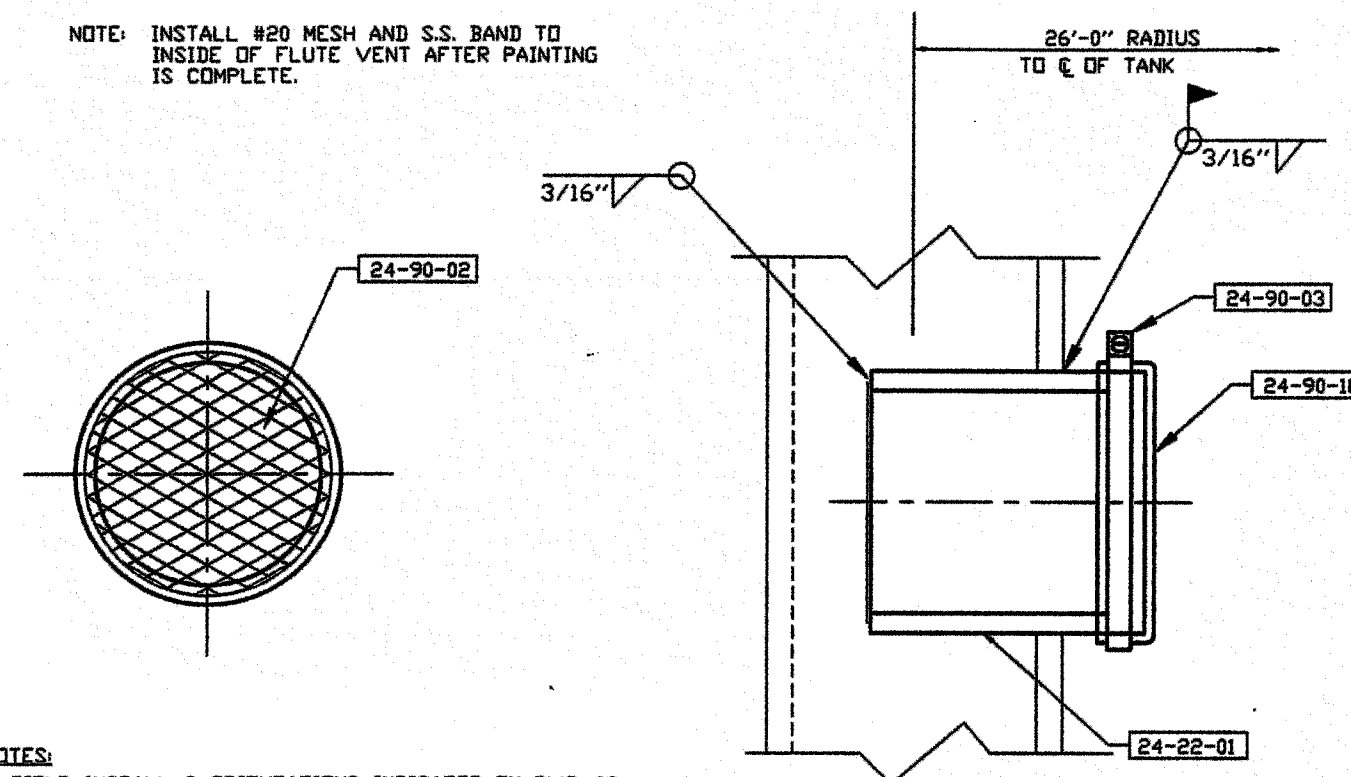

- NOTES:
1. FIELD INSTALL @ ORIENTATIONS INDICATED ON DWG. 02.
 2. INSTALL (4) VENTS @ 5'-6" ABOVE GIRDER LEVEL 3.
 3. INSTALL (4) VENTS 5'-6" ABOVE GIRDER LEVEL 1.

FLUTE VENT
24-VA-01

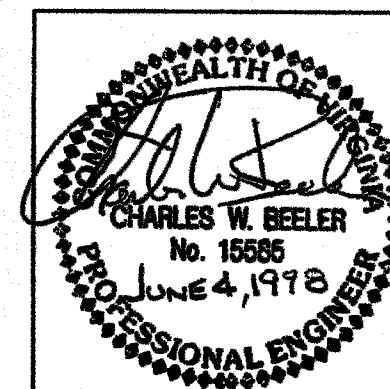

REV.	BY	DATE	REMARKS
Caldwell Tanks, Inc. Louisville, Ky.			
BOTETOURT COUNTY, VA			
BY:	BAW/TB	TITLE:	ROOF RAILING AND FLUTE VENTS
DATE:	5-98	DRAWING NO:	E-4291
			24