



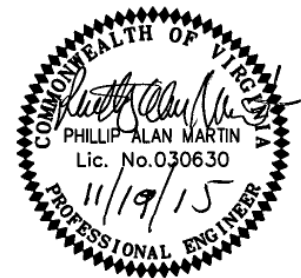

T# 027.08-02-15.00-0000
8131 Emerald Ln.

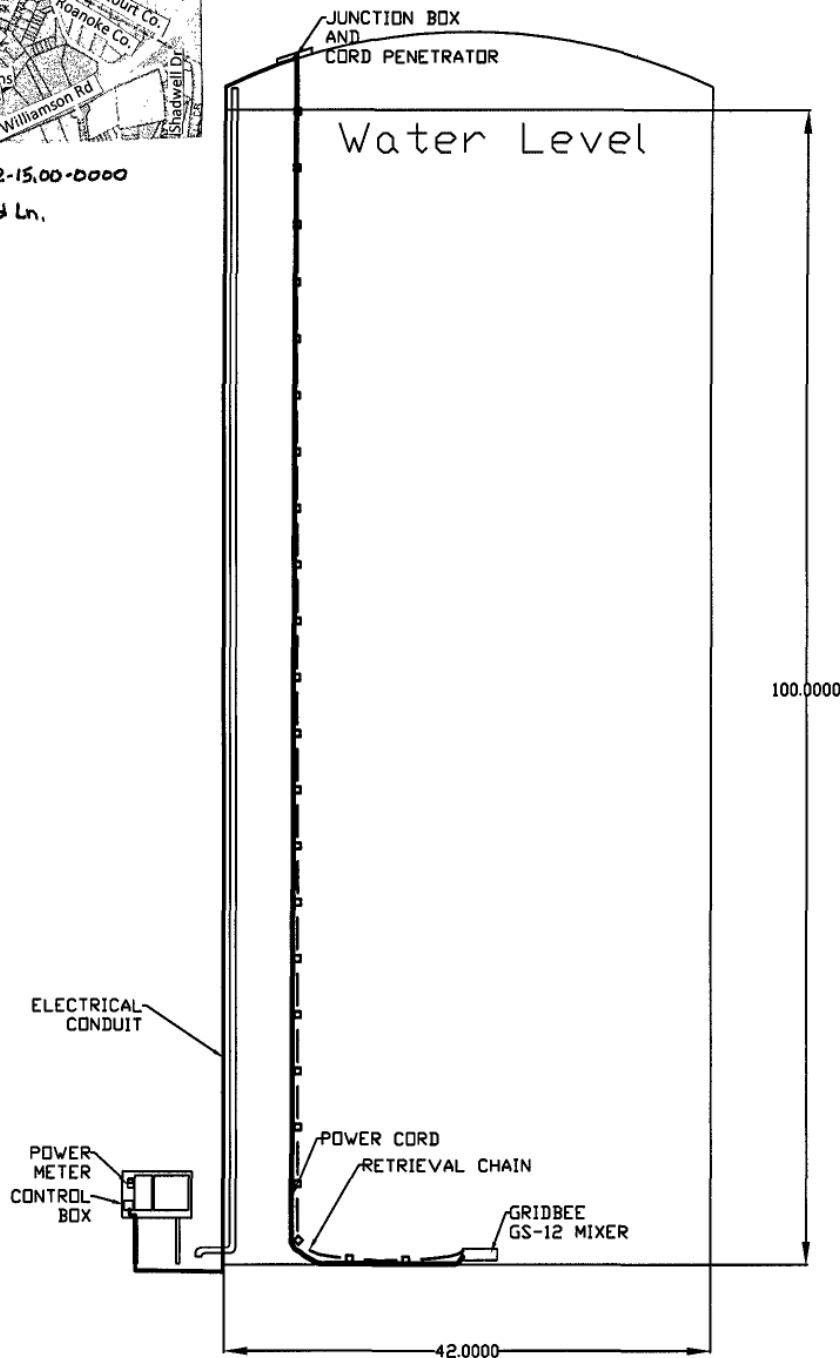

GENERAL NOTES

1. ALL CONSTRUCTION METHODS AND MATERIALS SHALL CONFORM TO THE LATEST EDITION OF THE DESIGN AND CONSTRUCTION STANDARDS AND SPECIFICATIONS OF THE WESTERN VIRGINIA WATER AUTHORITY (AUTHORITY) AVAILABLE AT WWW.WESTERNVAWATER.ORG OR BY CONTACTING THE AUTHORITY AT 540-853-5700. THE PROJECT SHALL ALSO COMPLY WITH THE GOVERNING JURISDICTION'S STANDARDS AND OTHER AGENCY STANDARDS (E.G., VDOT, DEQ, DCR, VDH, ETC.) WHERE APPLICABLE.
2. DIVERS AND ALL EQUIPMENT WILL BE DISINFECTED PRIOR TO LOWERING INTO THE TANK.
3. TWO (2) CONSECUTIVE SAMPLES WILL BE TAKEN AT THE CONCLUSION OF WORK TO INSURE WATER QUALITY.

Rev	Description	Date	By
As-Built		12/02/15	

~~PROPOSED~~ MIXING SYSTEM

HOLLINS TANK

