


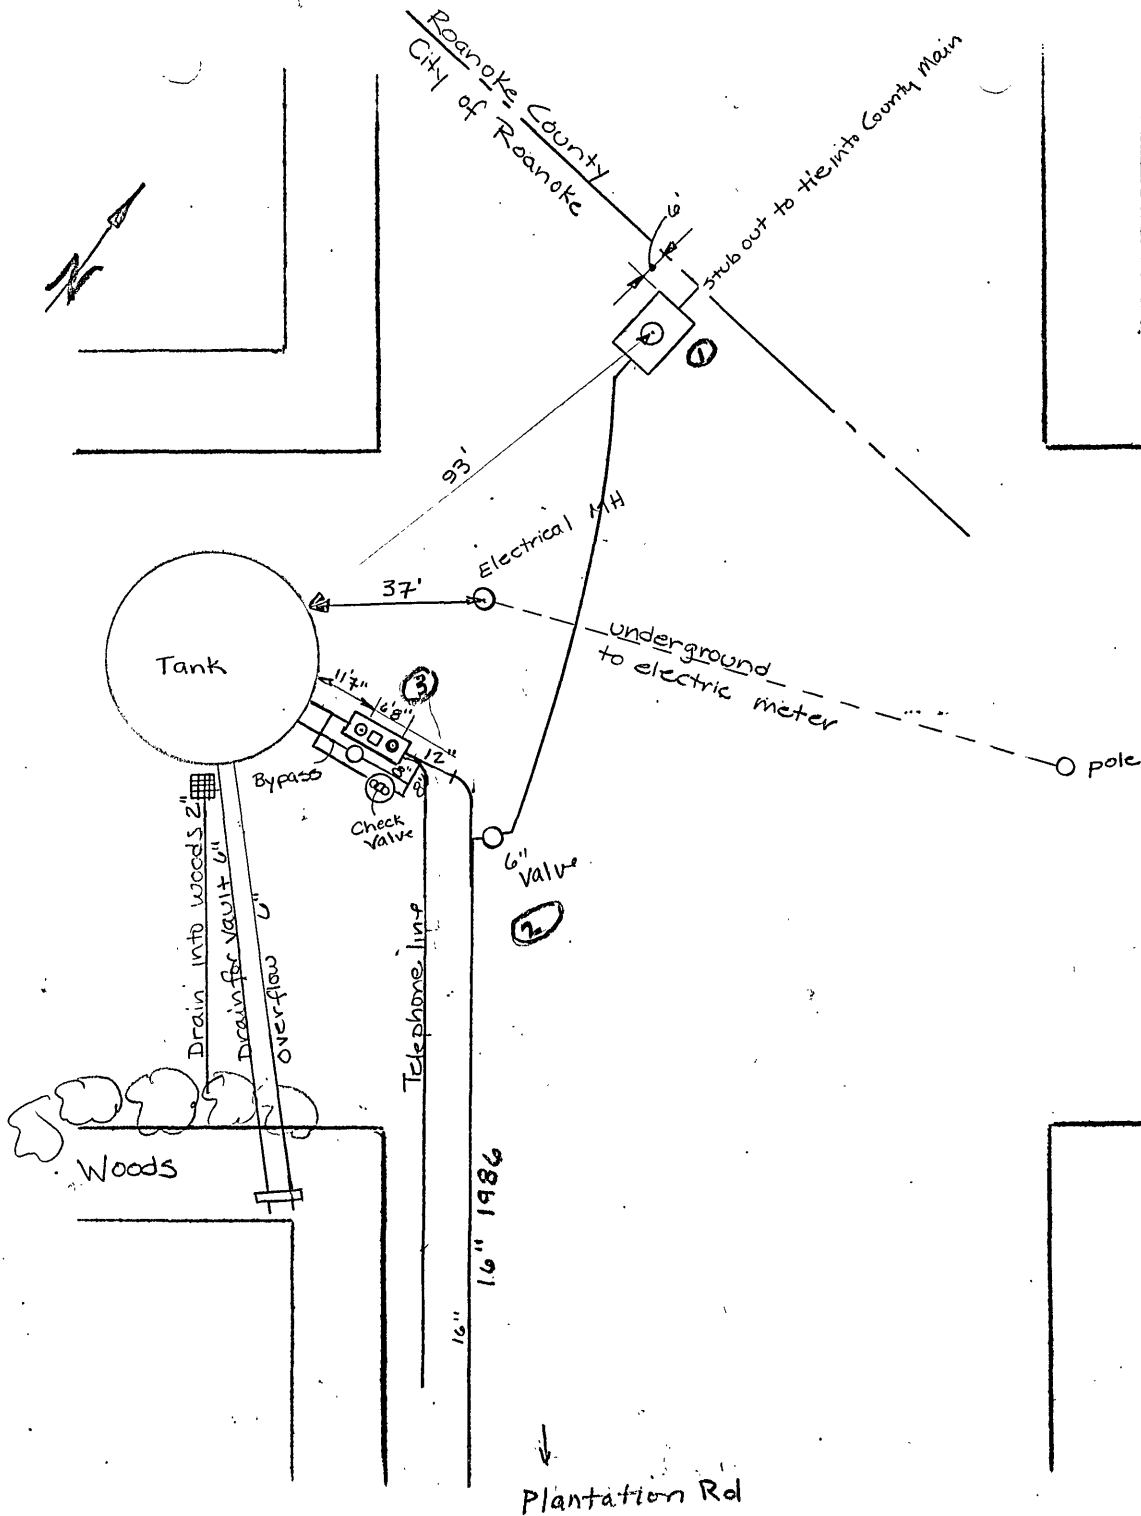

DATE	NO.	SIZE	MAKE	OPEN	TURNS
1986	1	6" #6 Box			
1986	2	6"			
1986	3	altitude Valve			

P. L. Measurements

No.	Distance	Direction

CITY OF ROANOKE - WATER DEPT.

VALVE DIAGRAM

Hollins Tank

Plantation Rd.

Sec. Map

Date

Page No.