


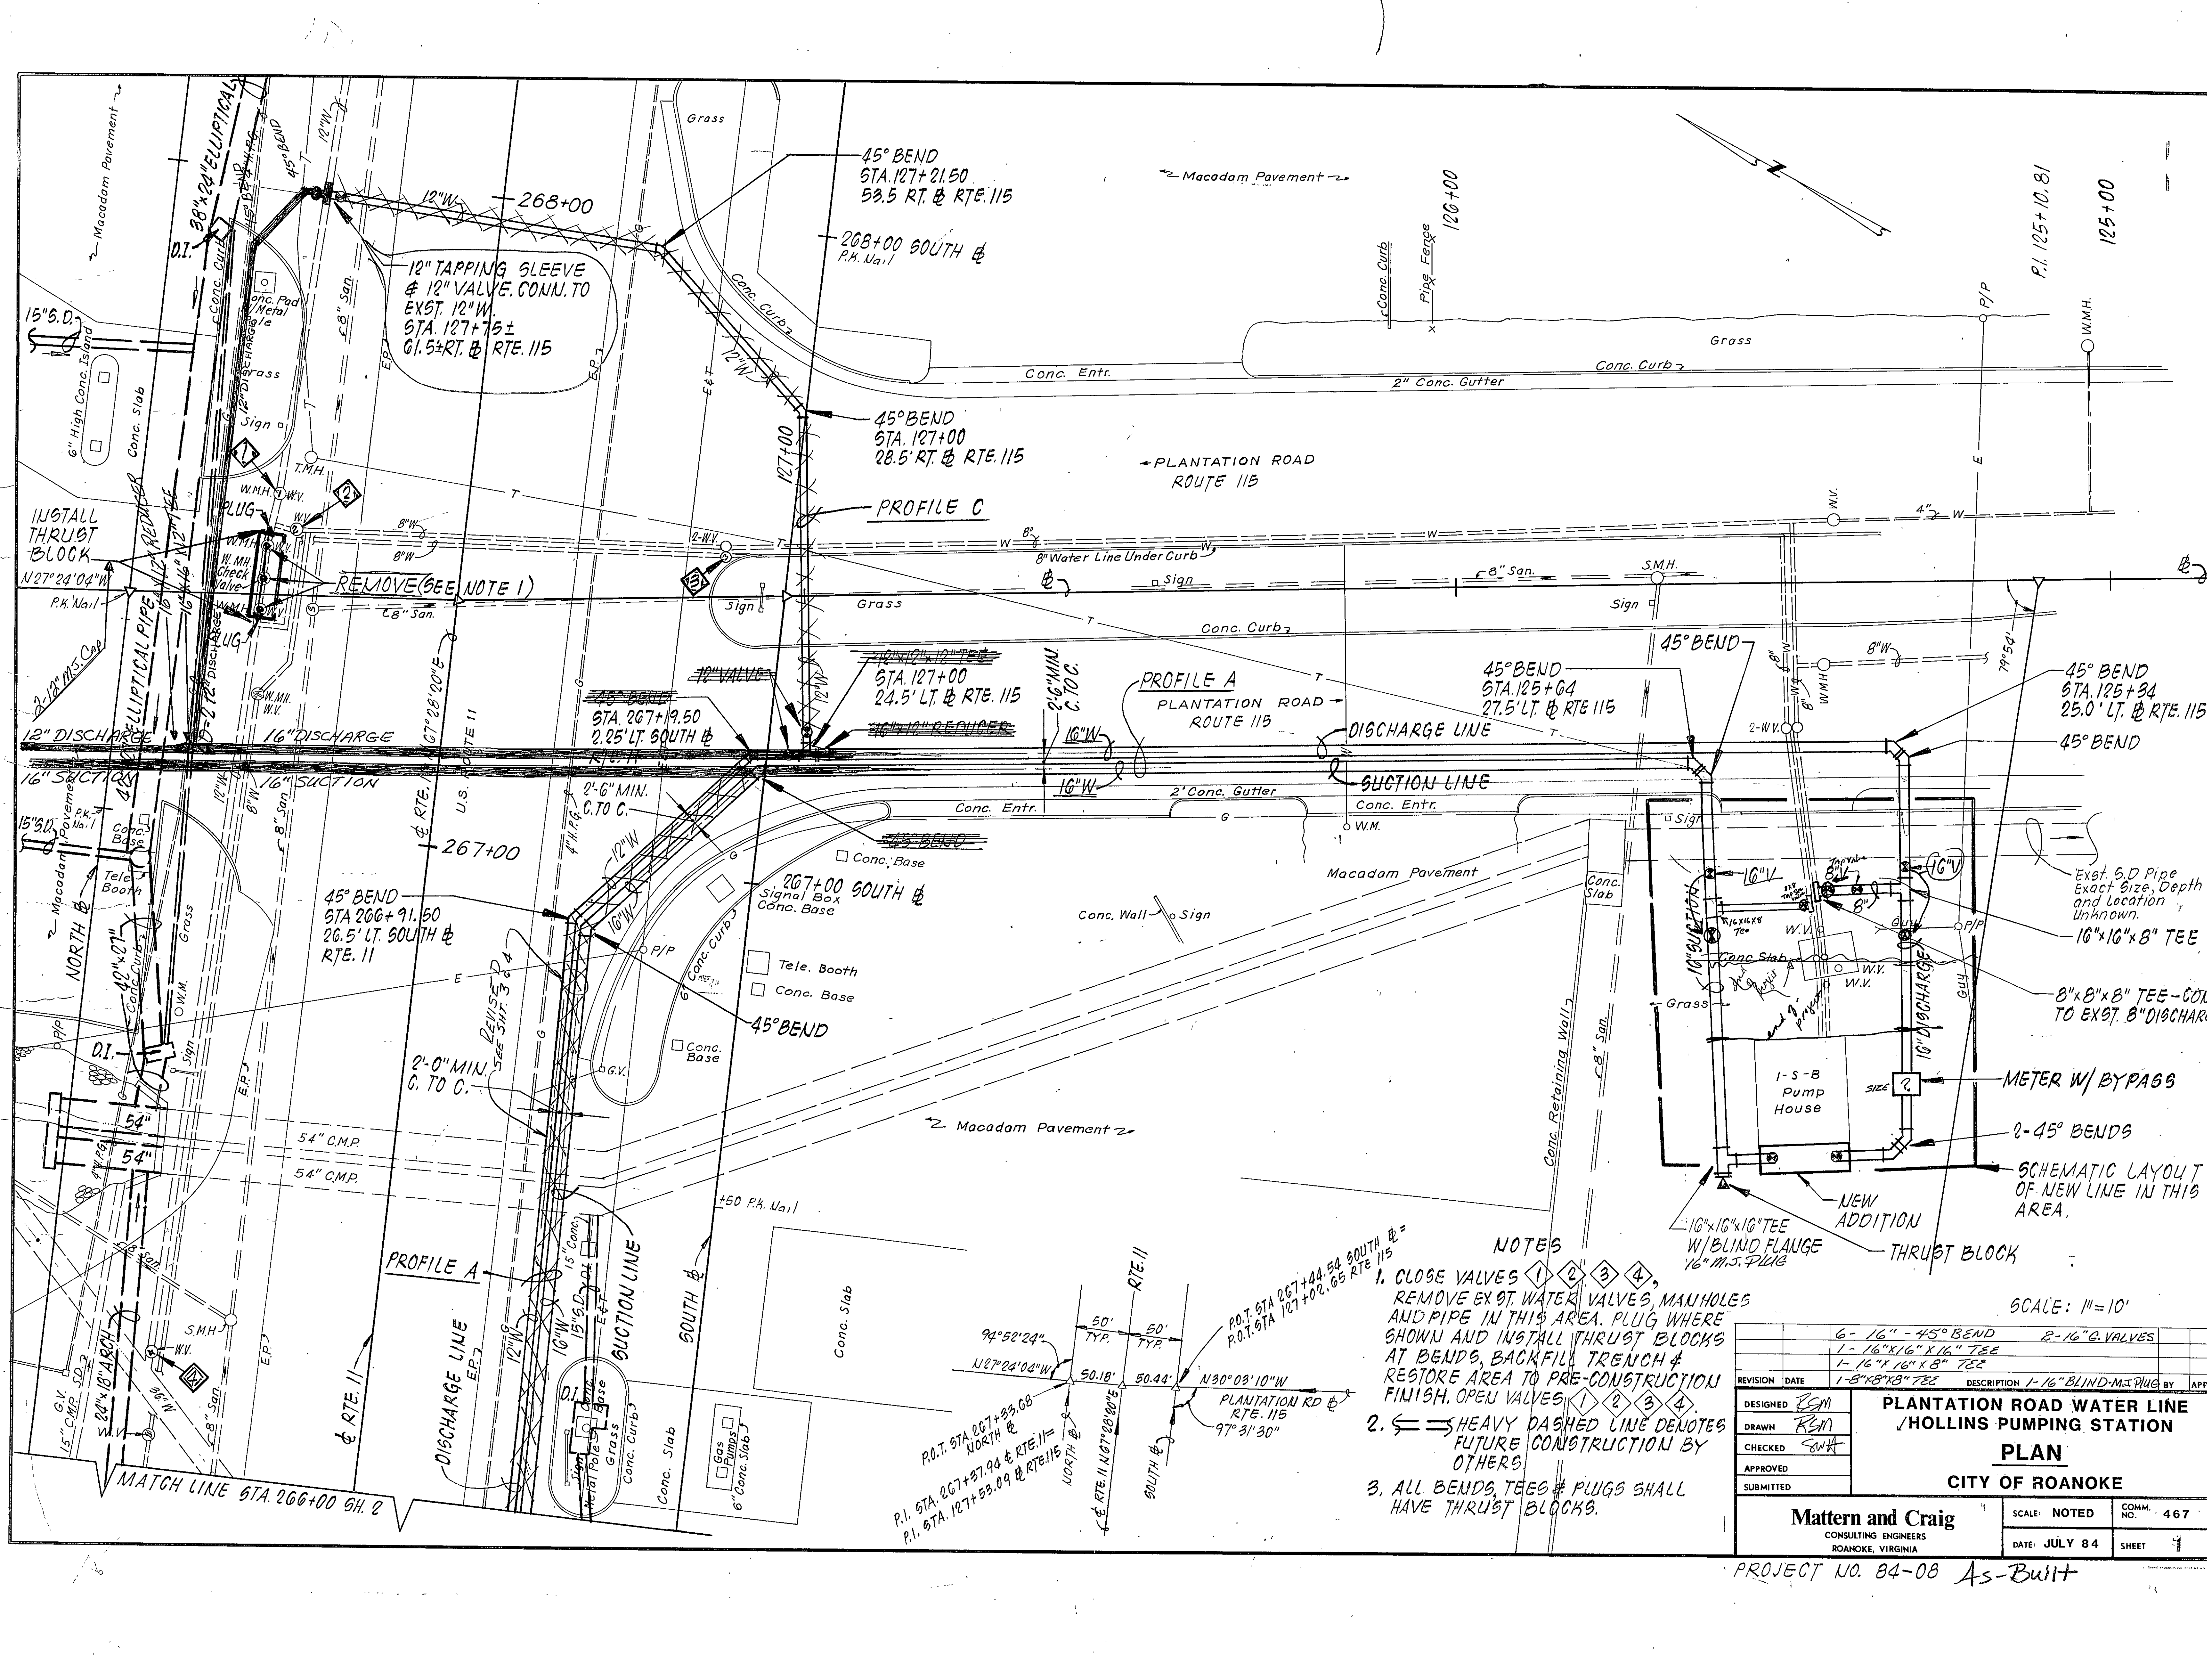

- NOTES
1. CLOSE VALVES 1 2 3 4, REMOVE EXST. WATER VALVES, MANHOLES AND PIPE IN THIS AREA. PLUG WHERE SHOWN AND INSTALL THRUST BLOCKS AT BENDS, BACKFILL TRENCH & RESTORE AREA TO PRE-CONSTRUCTION FINISH. OPEN VALVES 1 2 3 4.
 2. HEAVY DASHED LINE DENOTES FUTURE CONSTRUCTION BY OTHERS
 3. ALL BENDS, TEES & PLUGS SHALL HAVE THRUST BLOCKS.

		6- 16" - 45° BEND		2- 16" G. VALVES			
		1- 16"X16" X 16" TEE					
		1- 16"X 16" X 8" TEE					
REVISION	DATE	1- 8"X8"X8" TEE		DESCRIPTION	1- 16" BLIND-M.S. PLUG BY	AF	
DESIGNED	REM	PLANTATION ROAD WATER LINE / HOLLINS PUMPING STATION PLAN CITY OF ROANOKE					
DRAWN	REM						
CHECKED	SWA						
APPROVED							
SUBMITTED							
Mattern and Craig		SCALE: NOTED		COMM. NO. 467			
CONSULTING ENGINEERS		DATE: JULY 84		SHEET		4	
ROANOKE, VIRGINIA							

PROJECT NO. 84-08 As-Built