

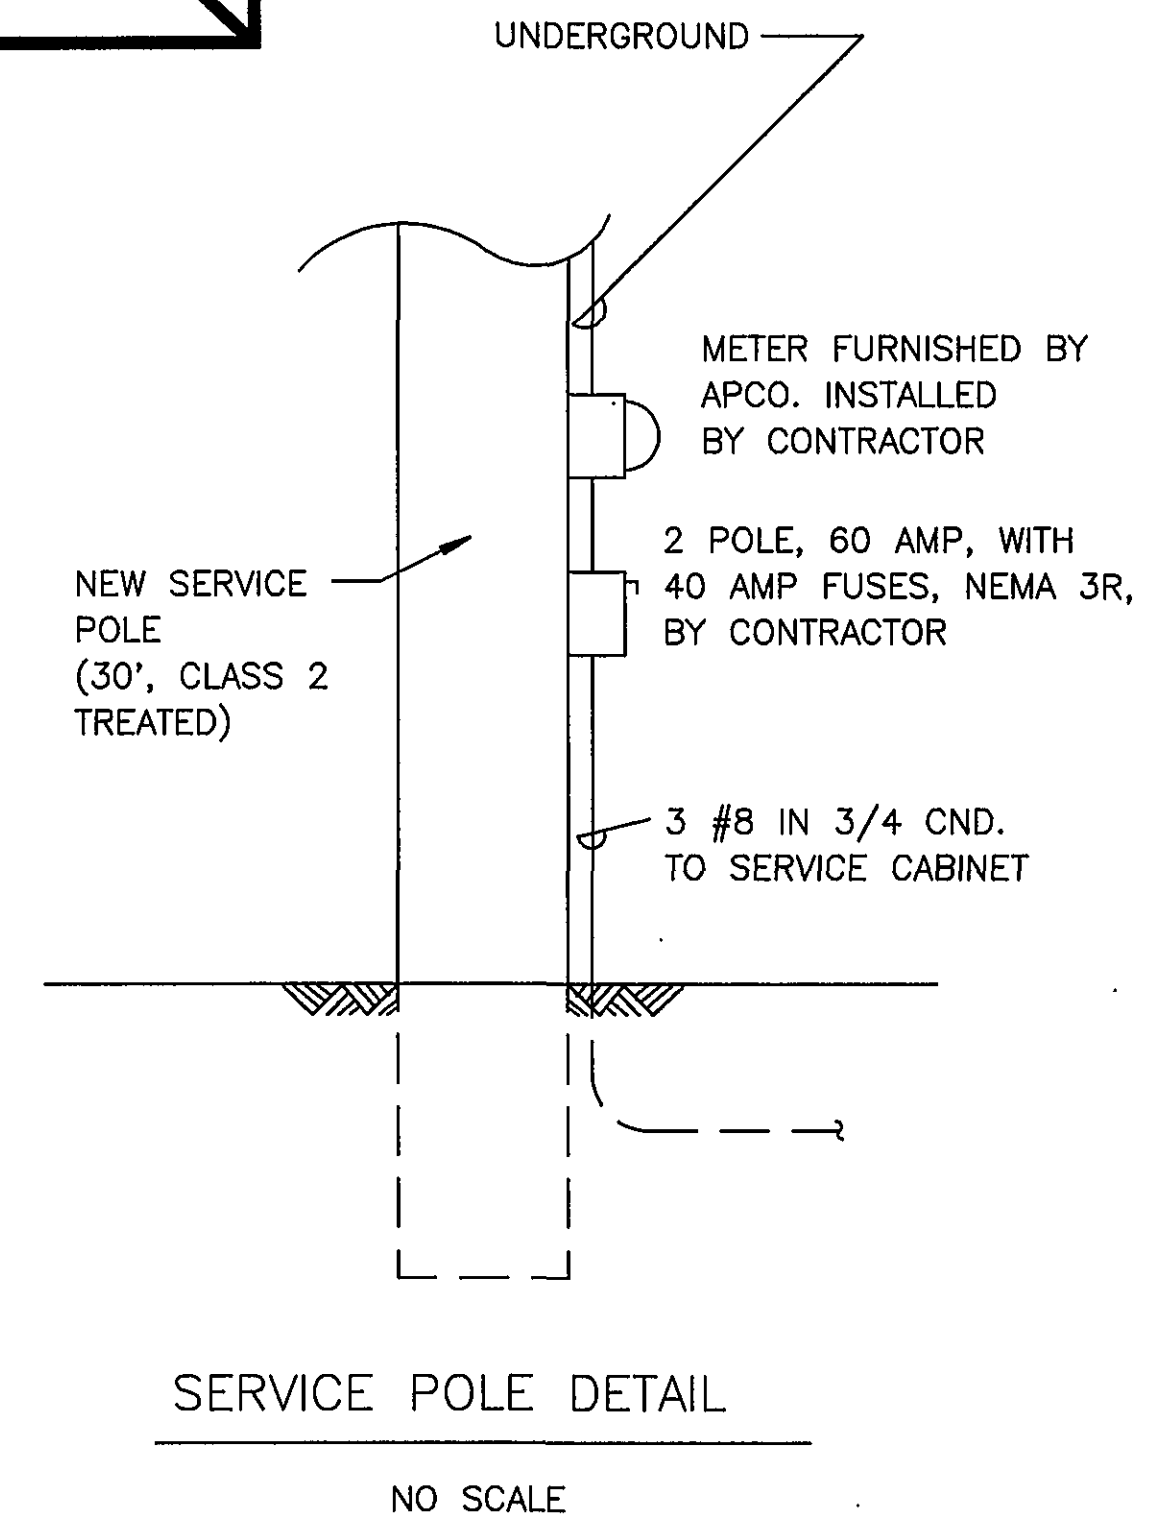


NOTES:

- 120/240 VOLT, 1 PHASE, 3 WIRE 12 POLE WITH 60 AMP. MAIN BREAKER AHD:  
5 - 1 POLE, 20 AMP BREAKERS (1,3,5,7,9) 1 - 2 POLE, 20 AMP BREAKER (10) 5 - SPACE ONLY (11,2,4,6,8)
- CONTRACTOR SHALL SIZE ENCLOSURE TO SUIT THE SIZE OF THE TANK LEVEL INDICATOR AND TRANSMITTER WHICH IS PROVIDED IN CONTRACT I.

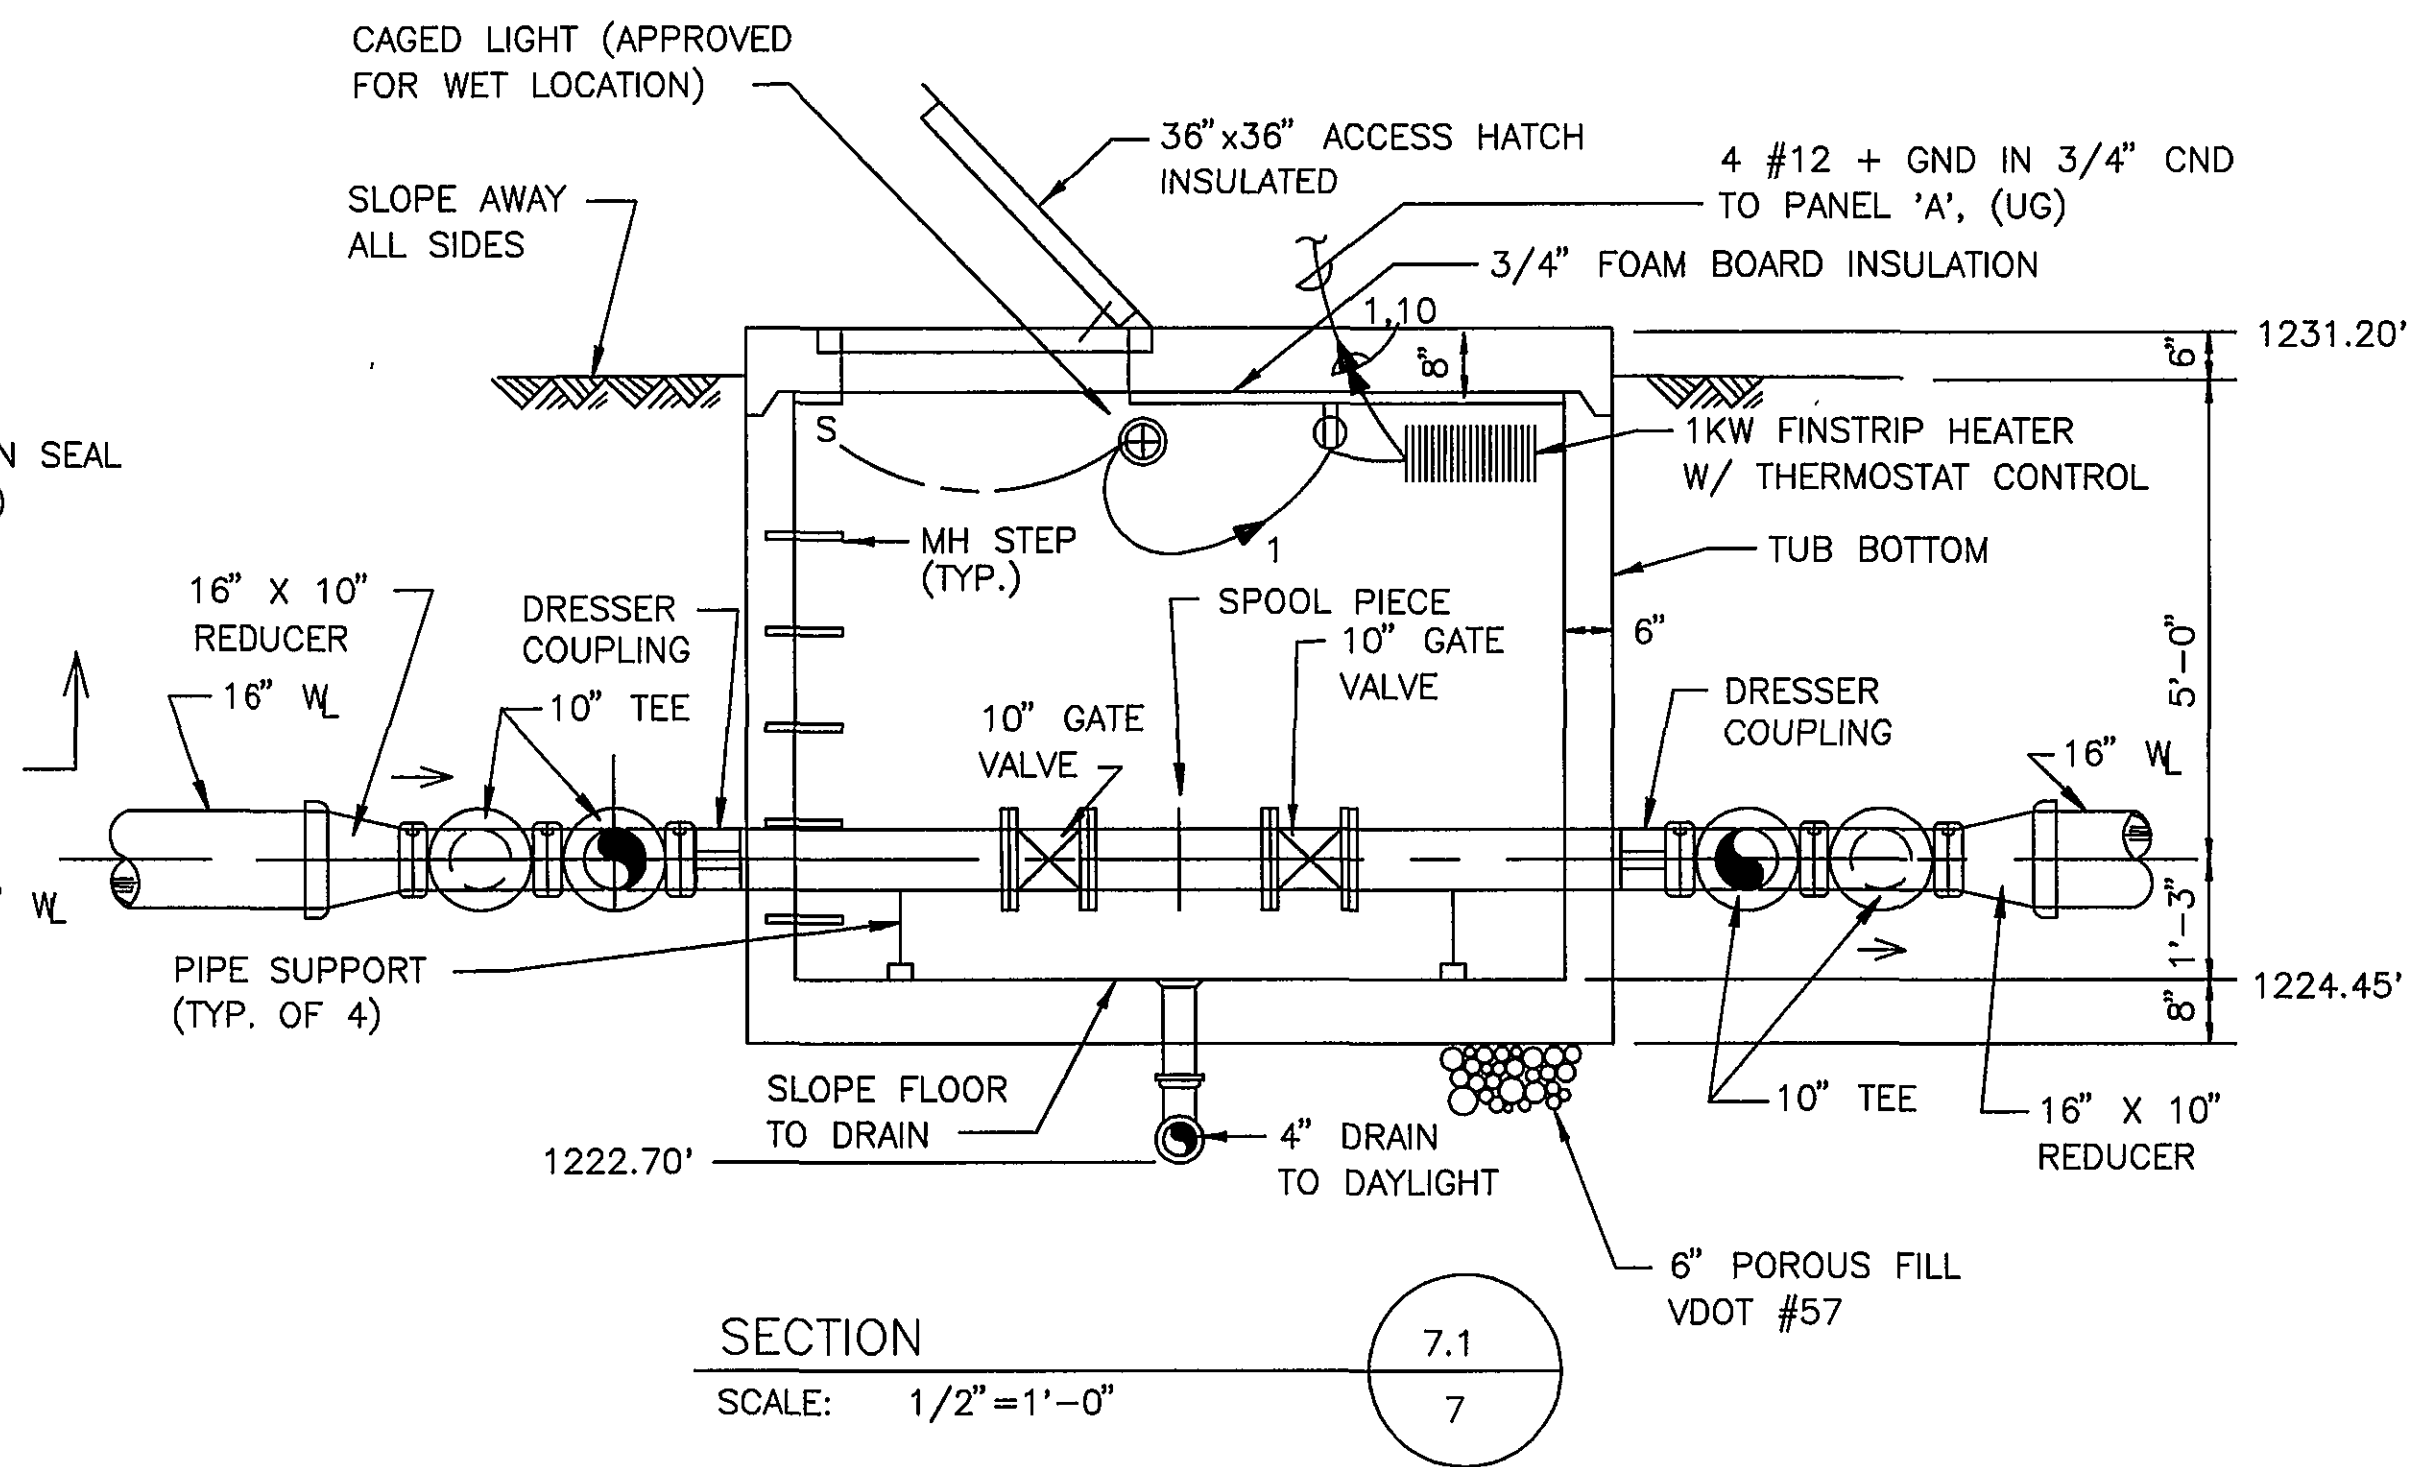


**RECORD DRAWING**

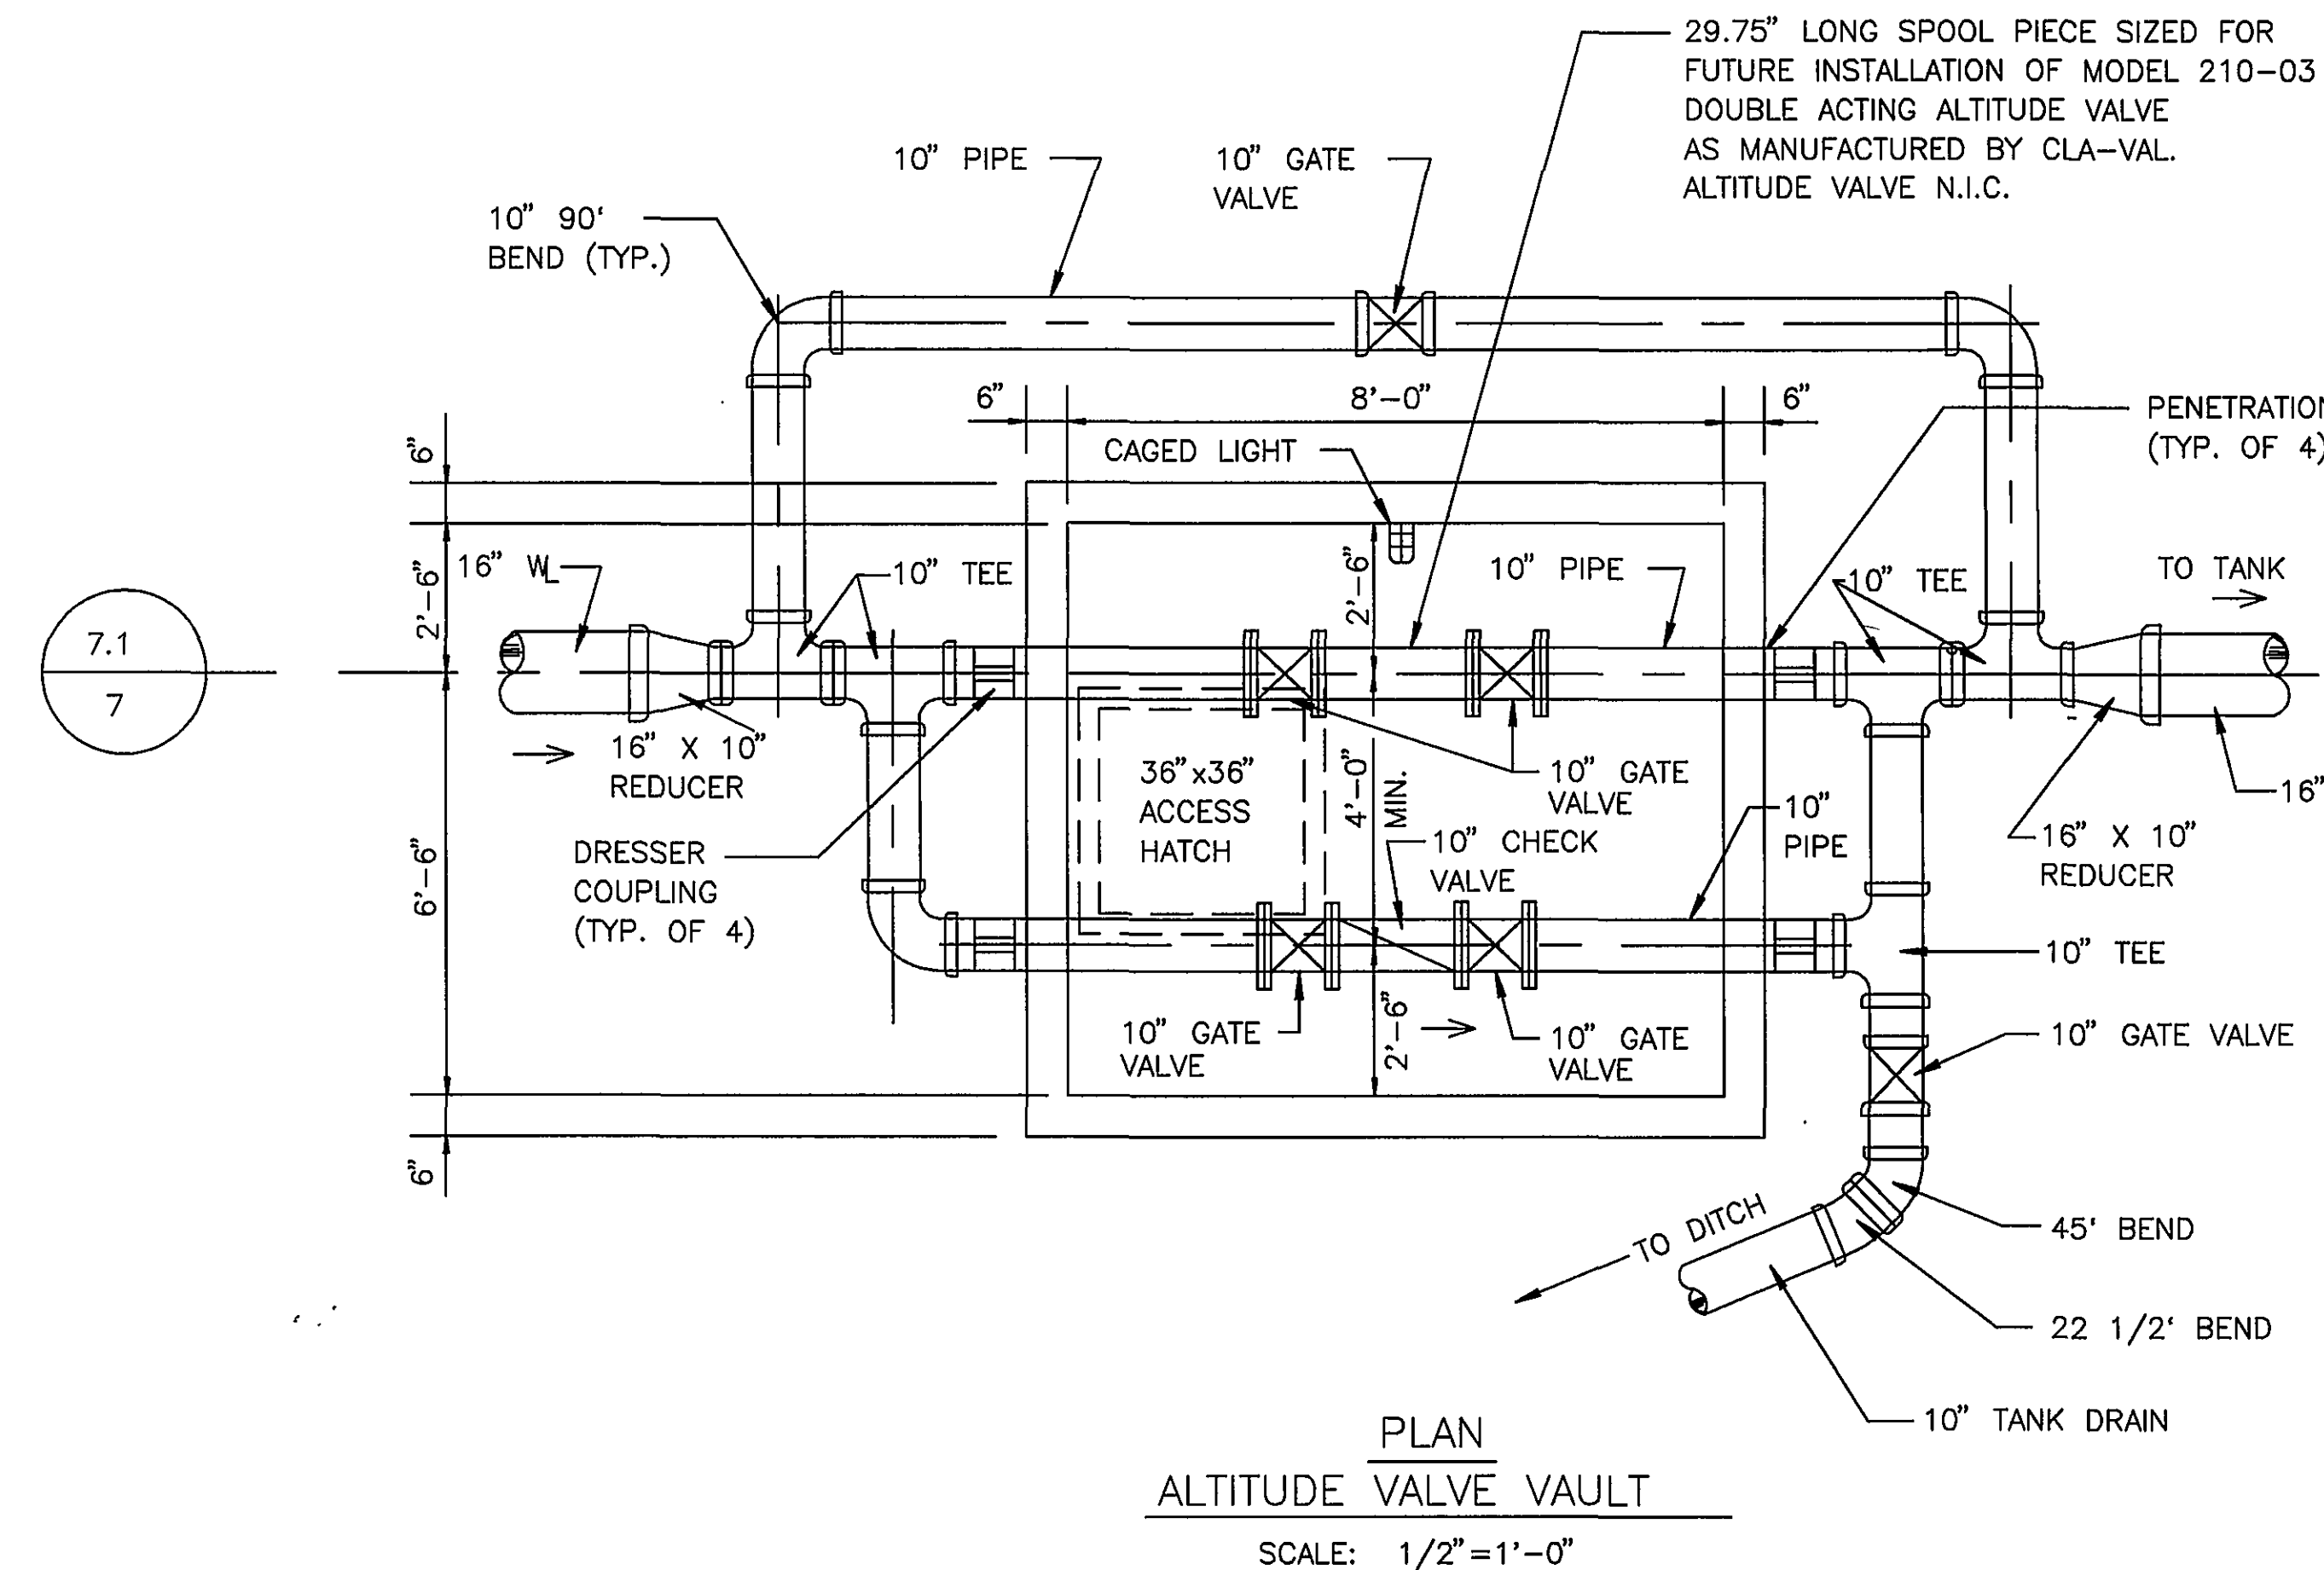

**Mattern & Craig**  
CONSULTING ENGINEERS - SURVEYORS

DESIGNED: BCC  
DRAWN: SMM  
CHECKED: SWH

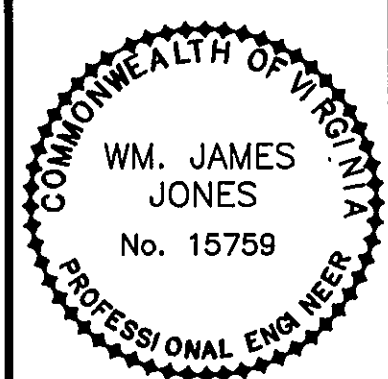

REV.	DATE	DESCRIPTION	BY	APP.	DATE
					NOVEMBER 1993
					1165G

ROANOKE CENTRE FOR INDUSTRY & TECHNOLOGY  
WATER TANK - CONTRACT I  
CITY OF ROANOKE, VIRGINIA  
ELECTRICAL & MISC. DETAILS WATER DEPT. #93-2B

SHEET

7