



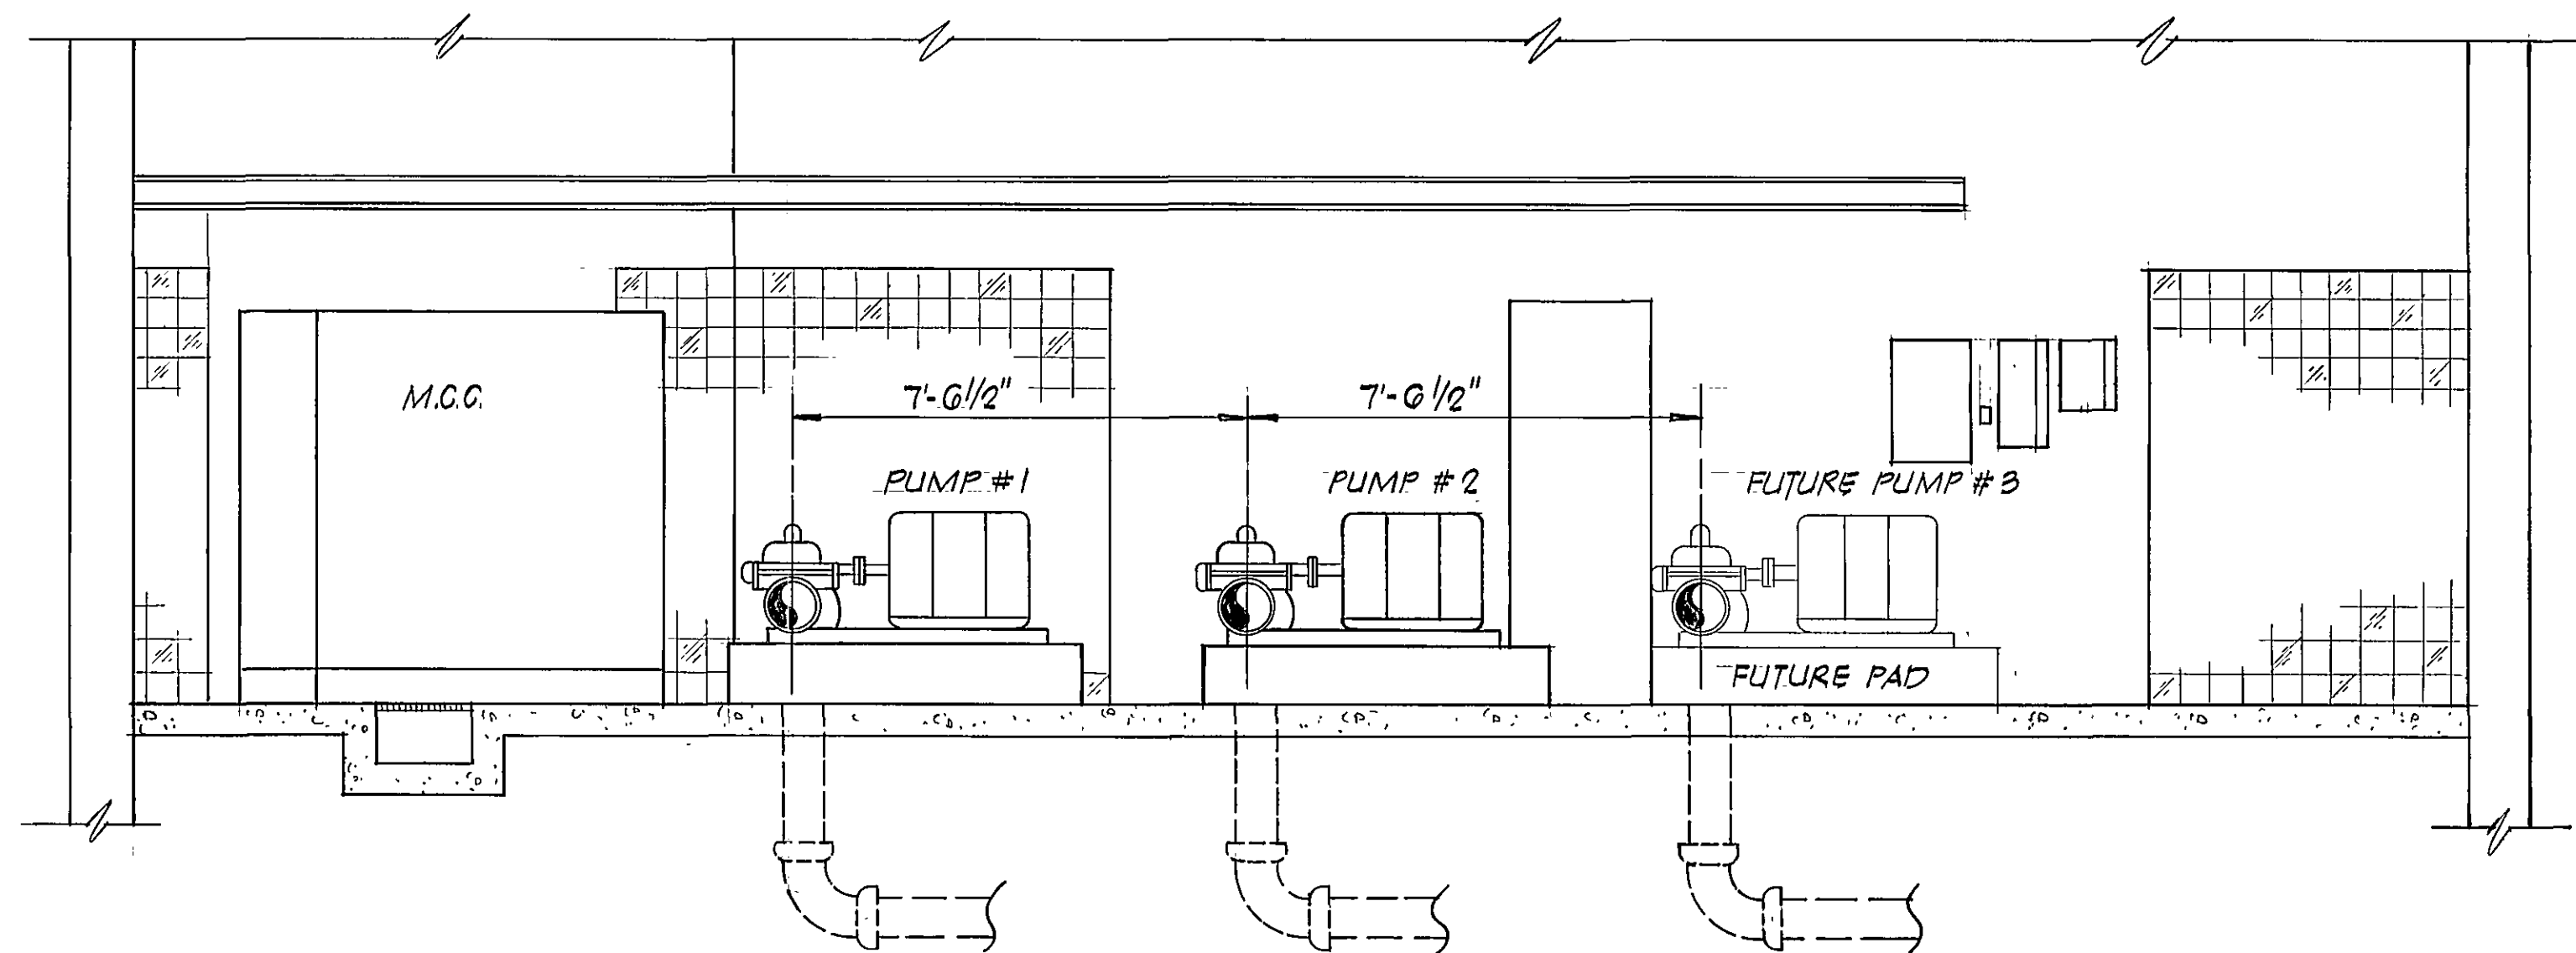

SECTION
SCALE: 3/8"=1'-0"


B
G

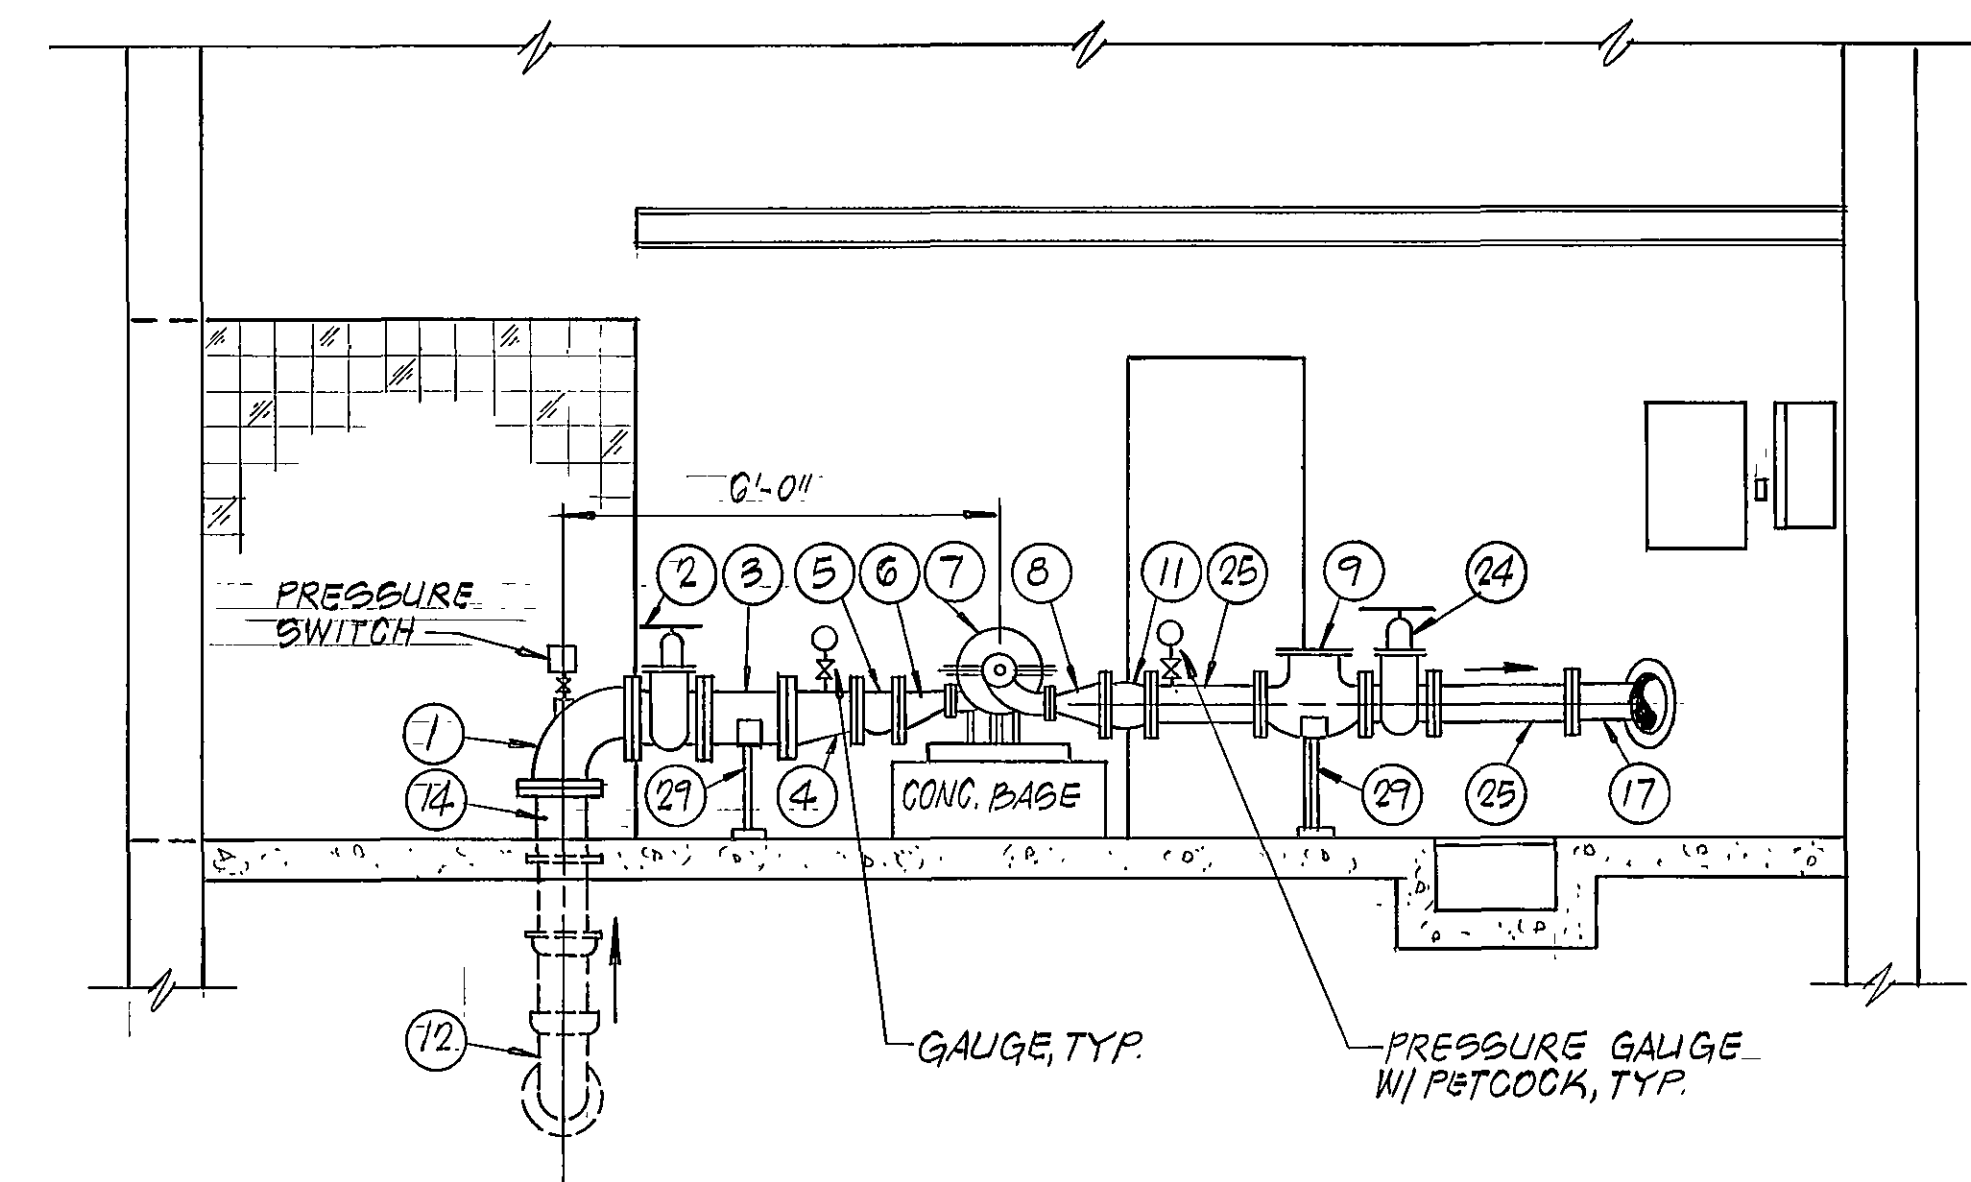



SEE S.H.G. FOR NUMBER LEGEND.

SECTION
SCALE: 3/8"=1'-0"


C
G

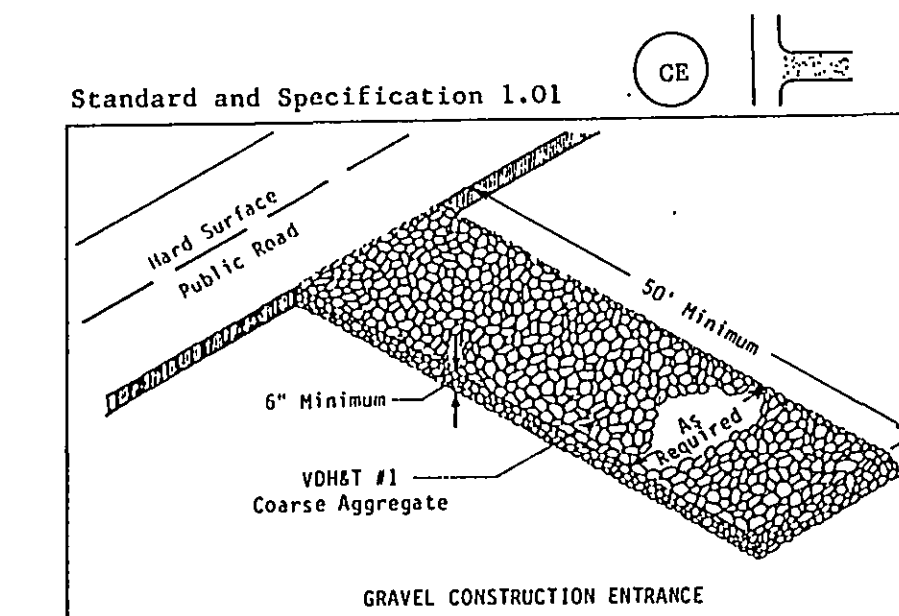


TEMPORARY GRAVEL CONSTRUCTION ENTRANCE

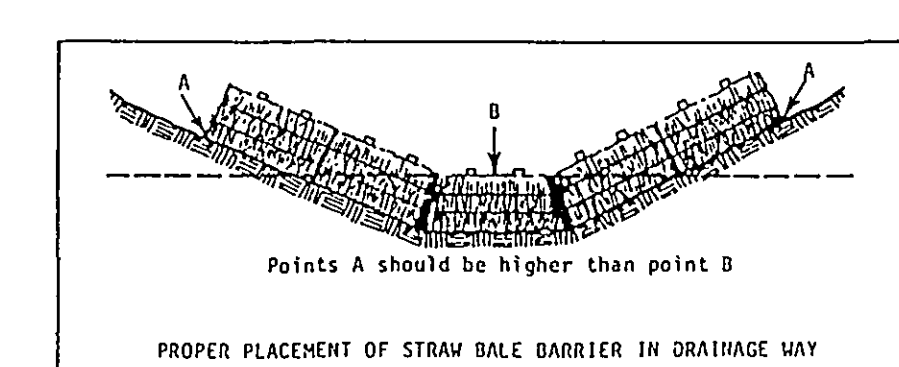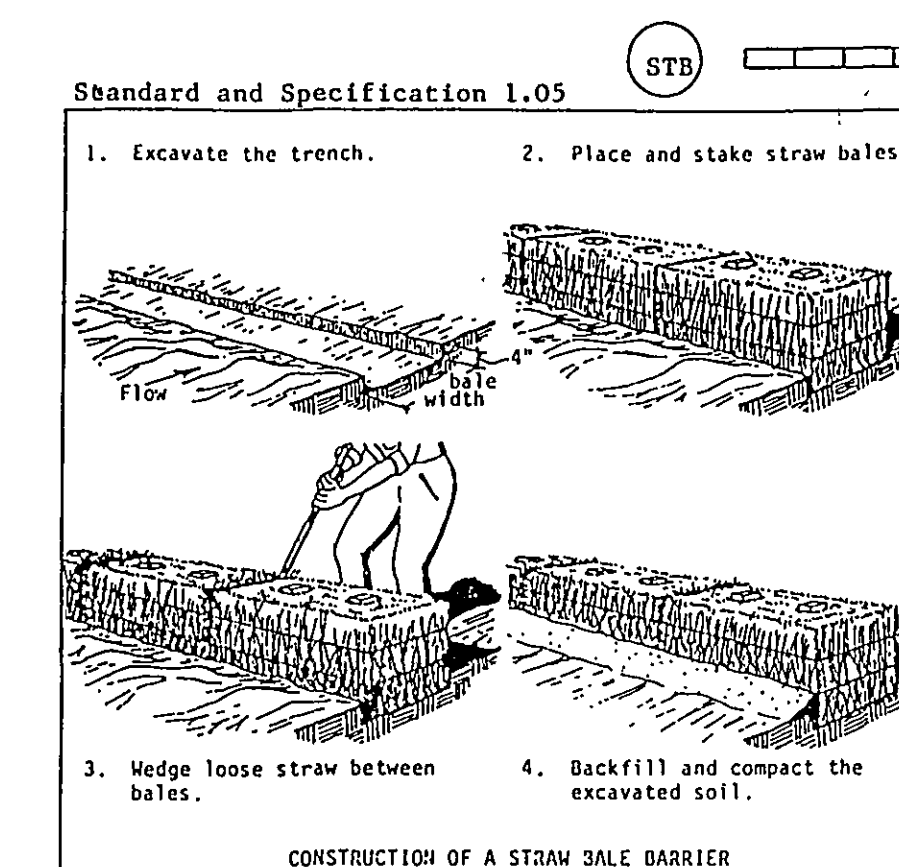

STRAW BALE BARRIER

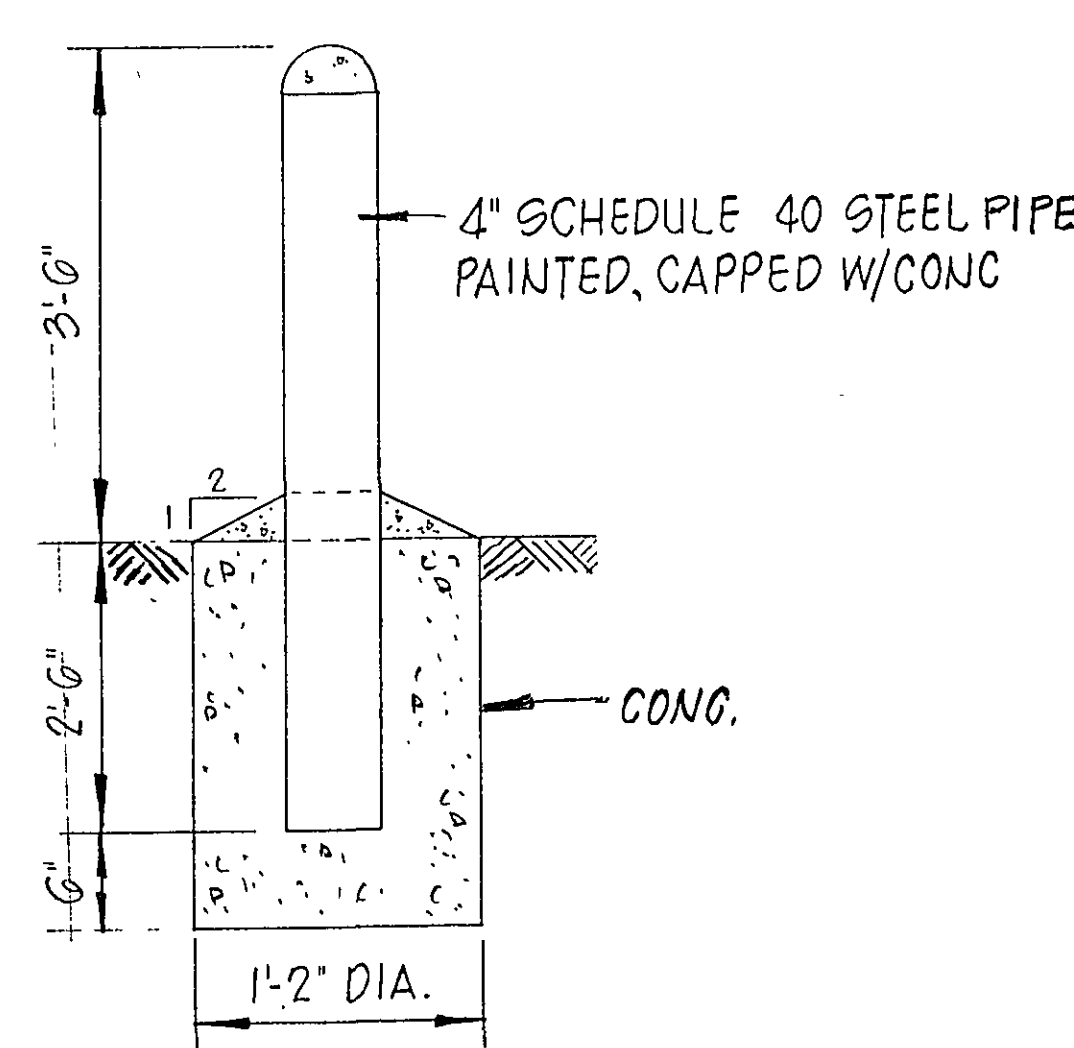


BOLLARD
NO SCALE

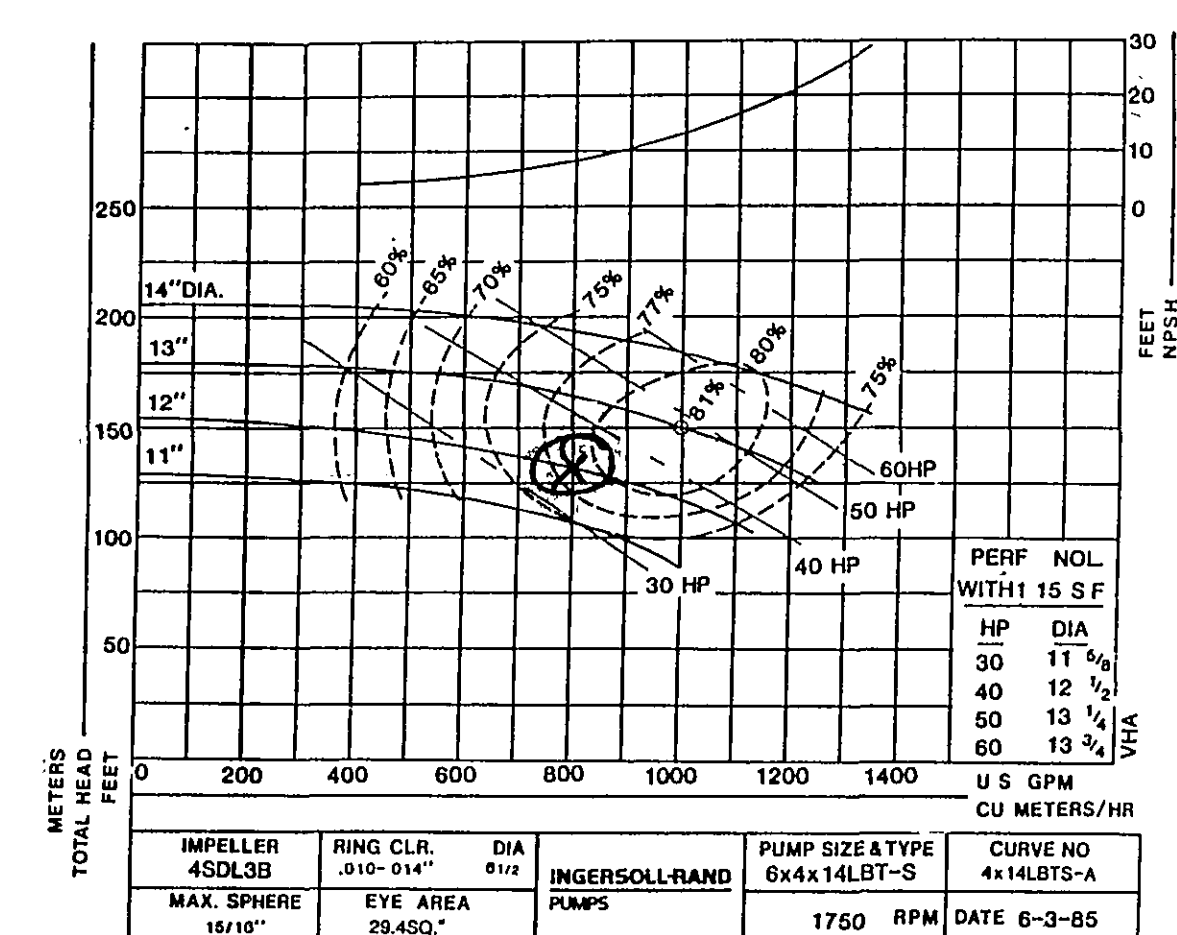

RECORD DRAWING

DESIGNED	SWH	DATE	12/10/87	DESCRIPTION	RECORD DWG	BY	SWH	APP	
DRAWN	RSM								
CHECKED	STM								
APPROVED	STM								
SUBMITTED									
ROANOKE CITY-SALEM INTERCONNECT PUMPING STATION									
SECTIONS									
SCALE: NOTED				COMM. NO. 566					
DATE: JUNE 86				SHEET 7					

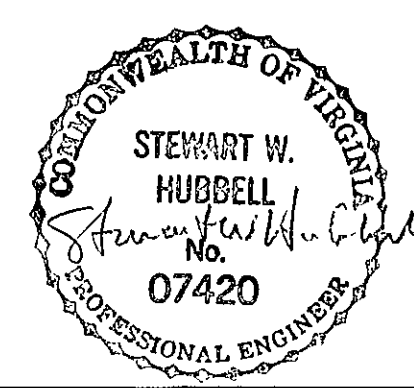

Mattern & Craig
CONSULTING ENGINEERS