

# ROANOKE RIVER

MEAN ANNUAL FLOW (MAF) = 250± cfs AT INTAKE SITE.  
 0.4 x MAF = 100 cfs  
 0.3 x MAF = 75 cfs  
 0.2 x MAF = 50 cfs  
 100 YR FLOOD ELEVATION = 1170.5 ft MSL AT INTAKE SITE

## INTAKE SCREENS

QUANTITY 4 (4 FUTURE)  
 MAXIMUM DESIGN CAPACITY 40 MGD (80 MGD FUTURE)  
 DIMENSIONS 54 in. diameter, 179 in. long, 36 in. tee connect.  
 OPENING SIZE 1 mm  
 MAXIMUM VELOCITY 0.50 fps  
 CLEANING SYSTEM AIR SCOUR  
 CONNECTION NOZZLE 6 in. diameter  
 COMPRESSOR TYPE 2 stage, 7.5 hp rotary  
 COMPRESSOR CAPACITY 36 acfm  
 RECEIVER TANK 140 cf 150 psi

## INTAKE STRUCTURE

PUMP WET WELL DIMENSIONS 8 ft wide x 50 ft long x 30'-33' (VARIES)  
 (each pump chamber)  
 MAX APPROACH CHANNEL VELOCITY 0.4 fps @ 20 MGD (each pump chamber)  
 CHANNEL ISOLATION SLUICE GATES 60 in. x 60 in.  
 MIN. WATER DEPTH AT PUMPS 12 ft

## VERTICAL TURBINE PUMPS

	INITIAL				
EQUIPMENT NUMBER	VT-01	VT-02	VT-03	VT-04	VT-05
NUMBER OF STAGES	3	3	3	3	3
MAX SPEED (rpm)	900	900	900	900	900
COLUMN DIAMETER (in)	24	24	24	24	24
DISCHARGE NOZZLE DIA (in)	24	24	24	24	24
MOTOR (bhp)	800	800	800	800	800
NOMINAL CAPACITY (mgd)	16	16	16	16	16

## PUMP DISCHARGE PIPING

DIAMETER 24 INCH  
 MATERIAL DI CLASS S3 OR AWWA C200 STEEL, 1/4 in. WALL  
 LINING CEMENT MORTAR AWWA C104 (OR C205)

## FLOWMETERS

TYPE: VELOCITY-SENSING FLOW TRANSDUCER  
 LOCATION: 1 ON EACH PUMP DISCHARGE LINE  
 FEATURES: LOCAL READ OUT/SUMMING STATION & TOTALIZER

## DISCHARGE HEADER

DIAMETER 54 in.  
 MATERIAL AWWA C200 STEEL, 3/8 in. wall  
 LINING CEMENT MORTAR AWWA C205  
 VELOCITY @ 80 MGD 7.78 fps

## RAW WATER TRANSMISSION MAIN


LENGTH (approximate) 960 ft  
 DIAMETER (inside) 42 in. INSIDE (42 in. PARALLEL MAIN - FUTURE)  
 MATERIAL DI CLASS S3 OR AWWA C200 STEEL, 3/8 in. THICKNESS  
 LINING CEMENT MORTAR AWWA C205  
 VELOCITY @ 40 MGD 6.43 fps

## ENERGY DISSIPATION STRUCTURE

DESIGN DISCHARGE RATE 0-30 MGD  
 DISCHARGE RATE, PEAK 60 MGD (PMF RELEASE)  
 ENERGY DISSIPATION VALVES  
 TYPE MULTI-JET SLEEVE VALVE, ELECTRIC OPERATOR  
 QUANTITY 2  
 SIZE 20 in.  
 CAPACITY 32 MGD (each)  
 DISCHARGE WEIR  
 TYPE RECTANGULAR, SHARP-CRESTED  
 DIMENSIONS 12 ft width  
 FLOWMETER ULTRASONIC

# RESERVOIR

DRAINAGE AREA 0.80 SQUARE MILES  
 PROBABLE MAXIMUM FLOOD 1669 ACRE-Feet


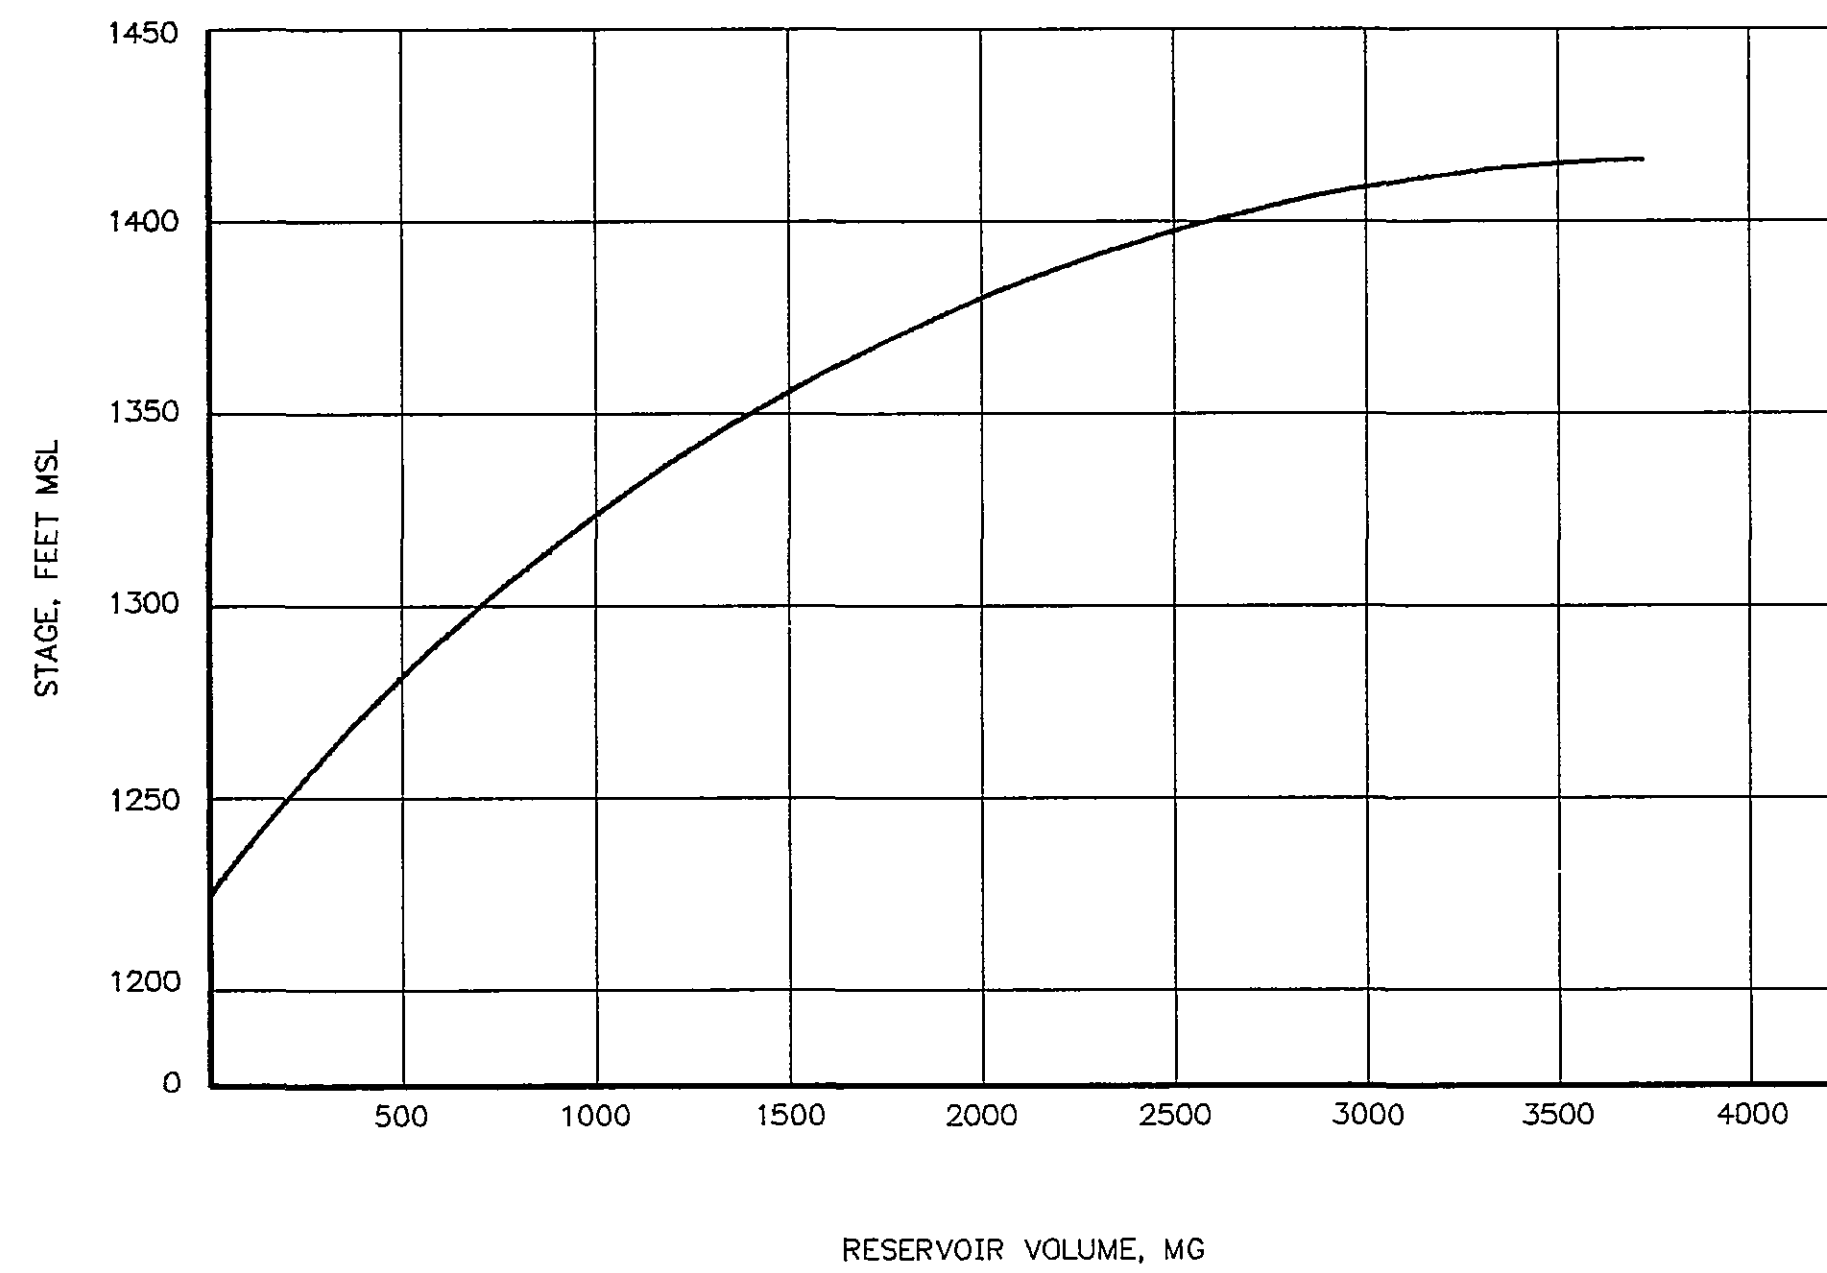


## WITHDRAWAL TOWER

WITHDRAWAL RATE FOR PMF RELEASE 60 MGD  
 DURATION OF PMF RELEASE 10 DAYS  
 WITHDRAWAL RATE FOR WATER DEMAND 0-23 MGD  
 SLUICE GATES:


QTY	DESIGNATION	SIZE	INVERT ELEV.	CAPACITY
2	RESERVOIR DRAIN	3 ft x 4 ft	1220 ft	15 MGD
2	LOW	4 ft x 4 ft	1300 ft	20 MGD
2	MIDDLE	4 ft x 6 ft	1344 ft	30 MGD
2	UPPER	4 ft x 6 ft	1374 ft	30 MGD

HIGH LEVEL RELIEF OPENINGS:  
 2 HIGH LEVEL 2 ft x 6 ft 1415 ft

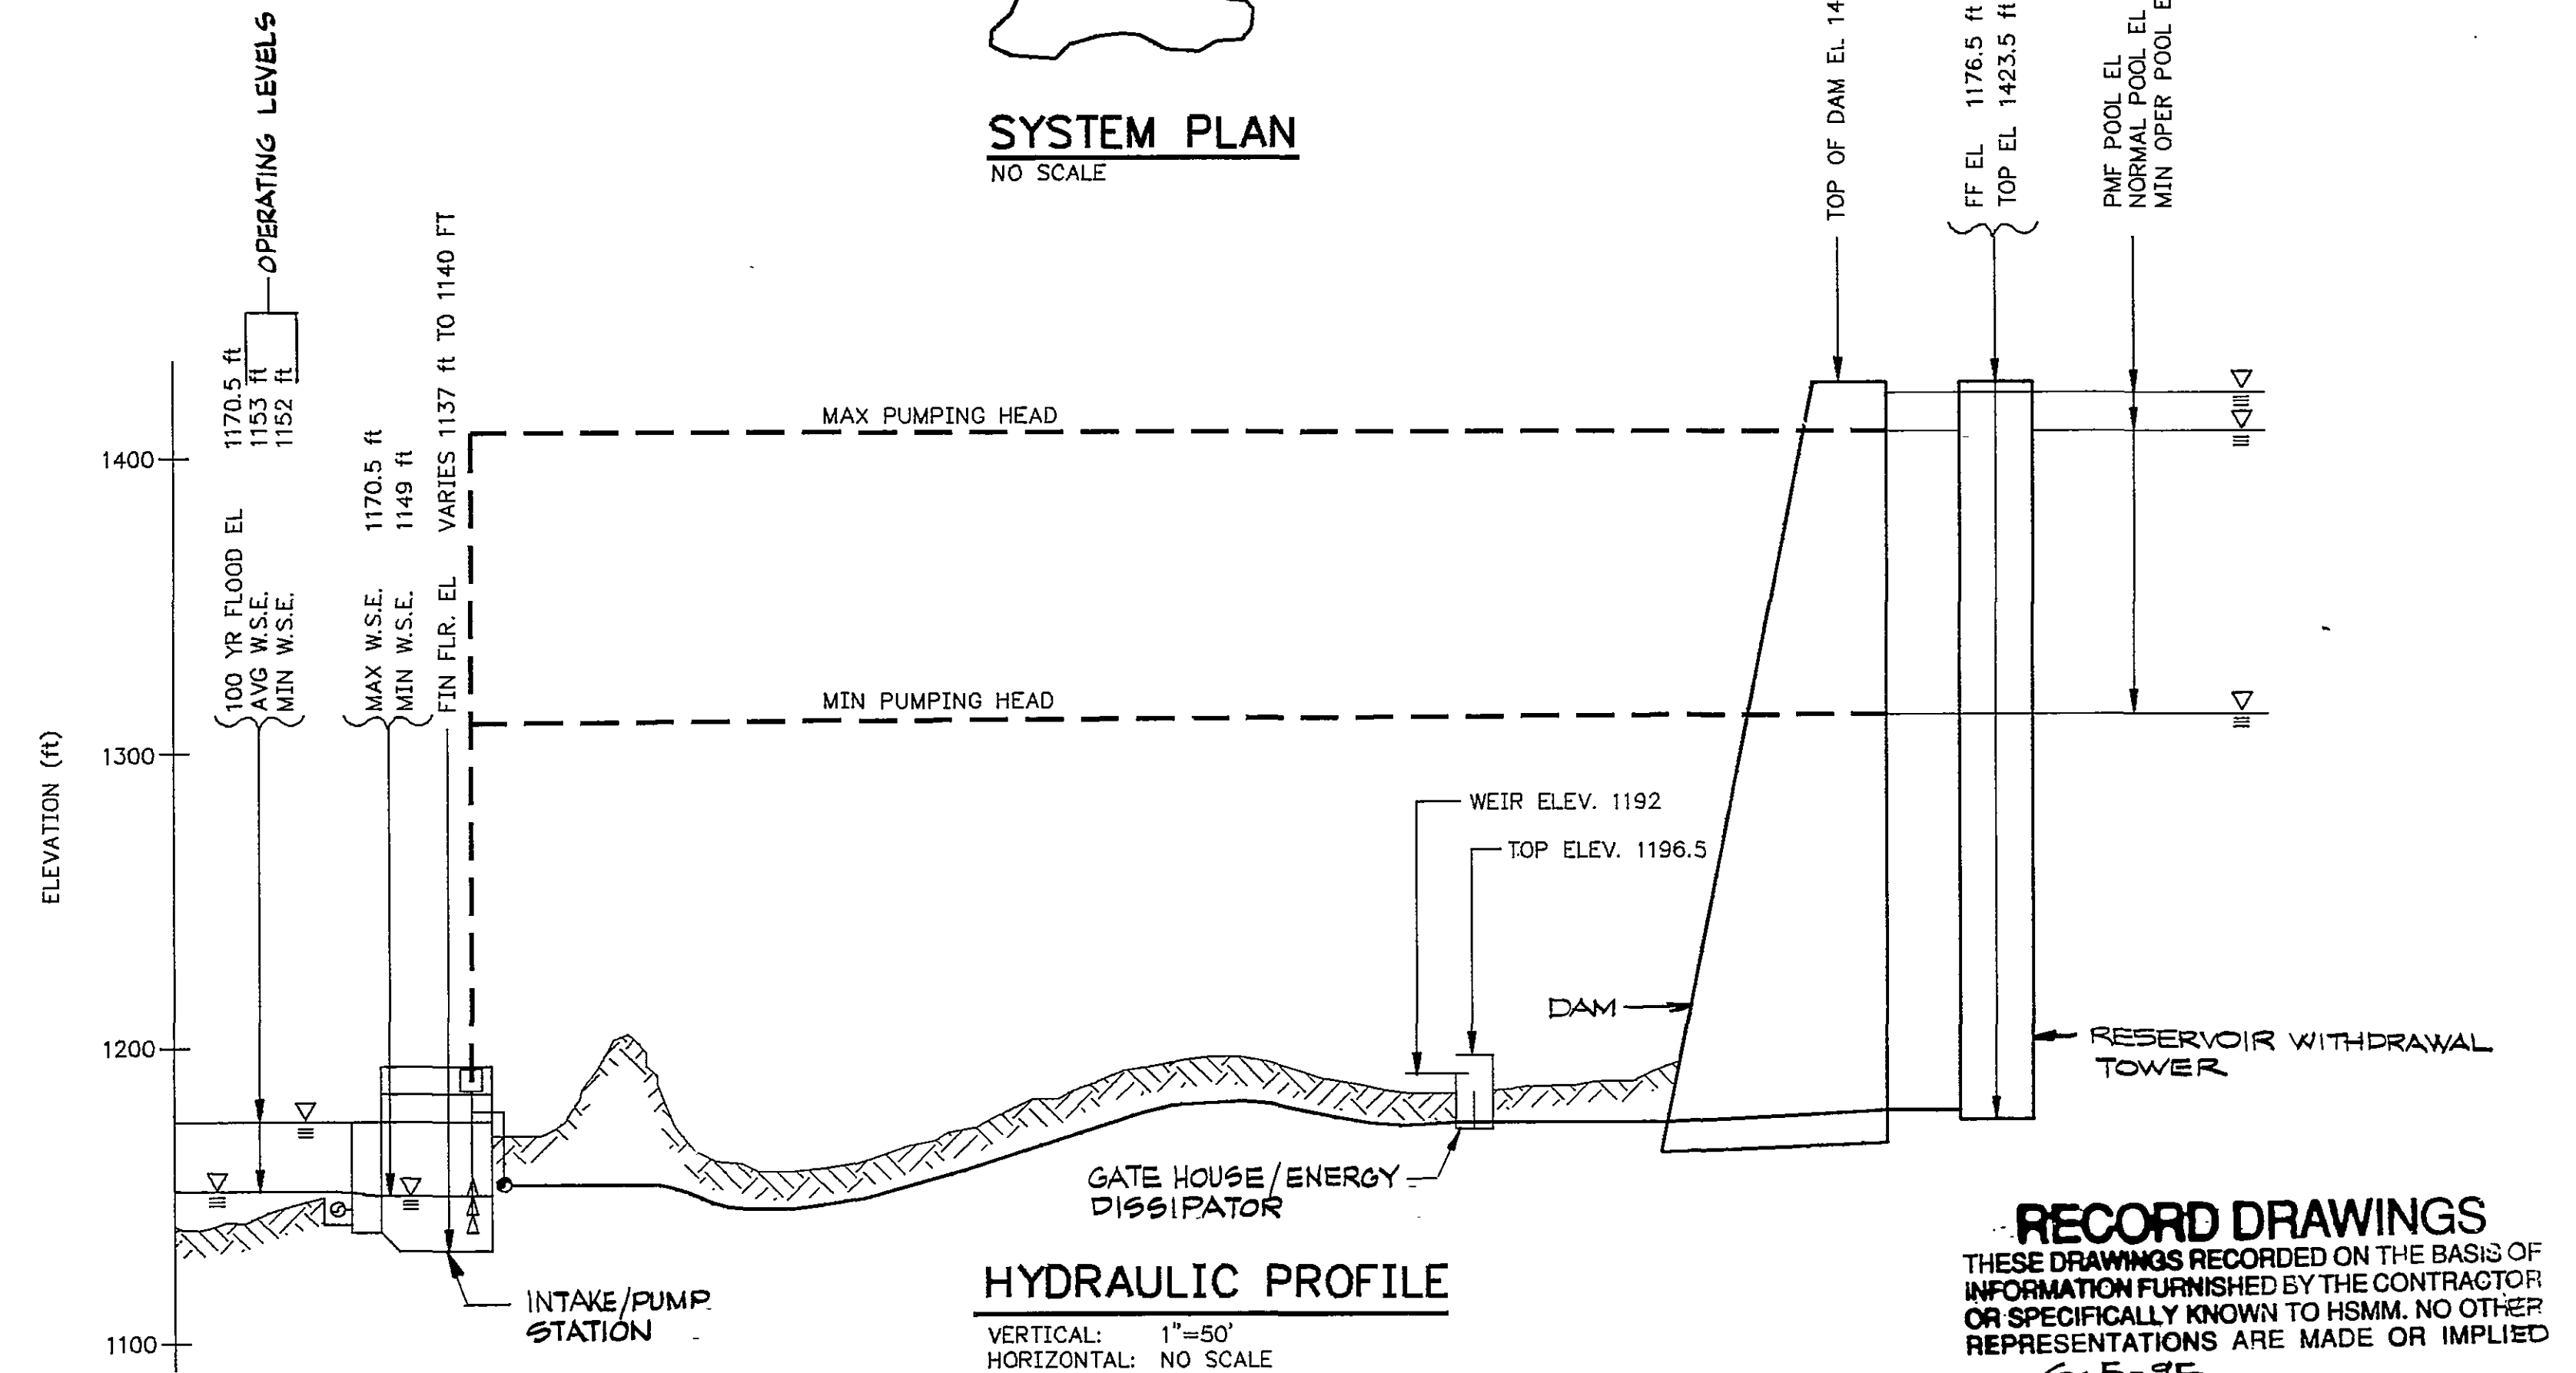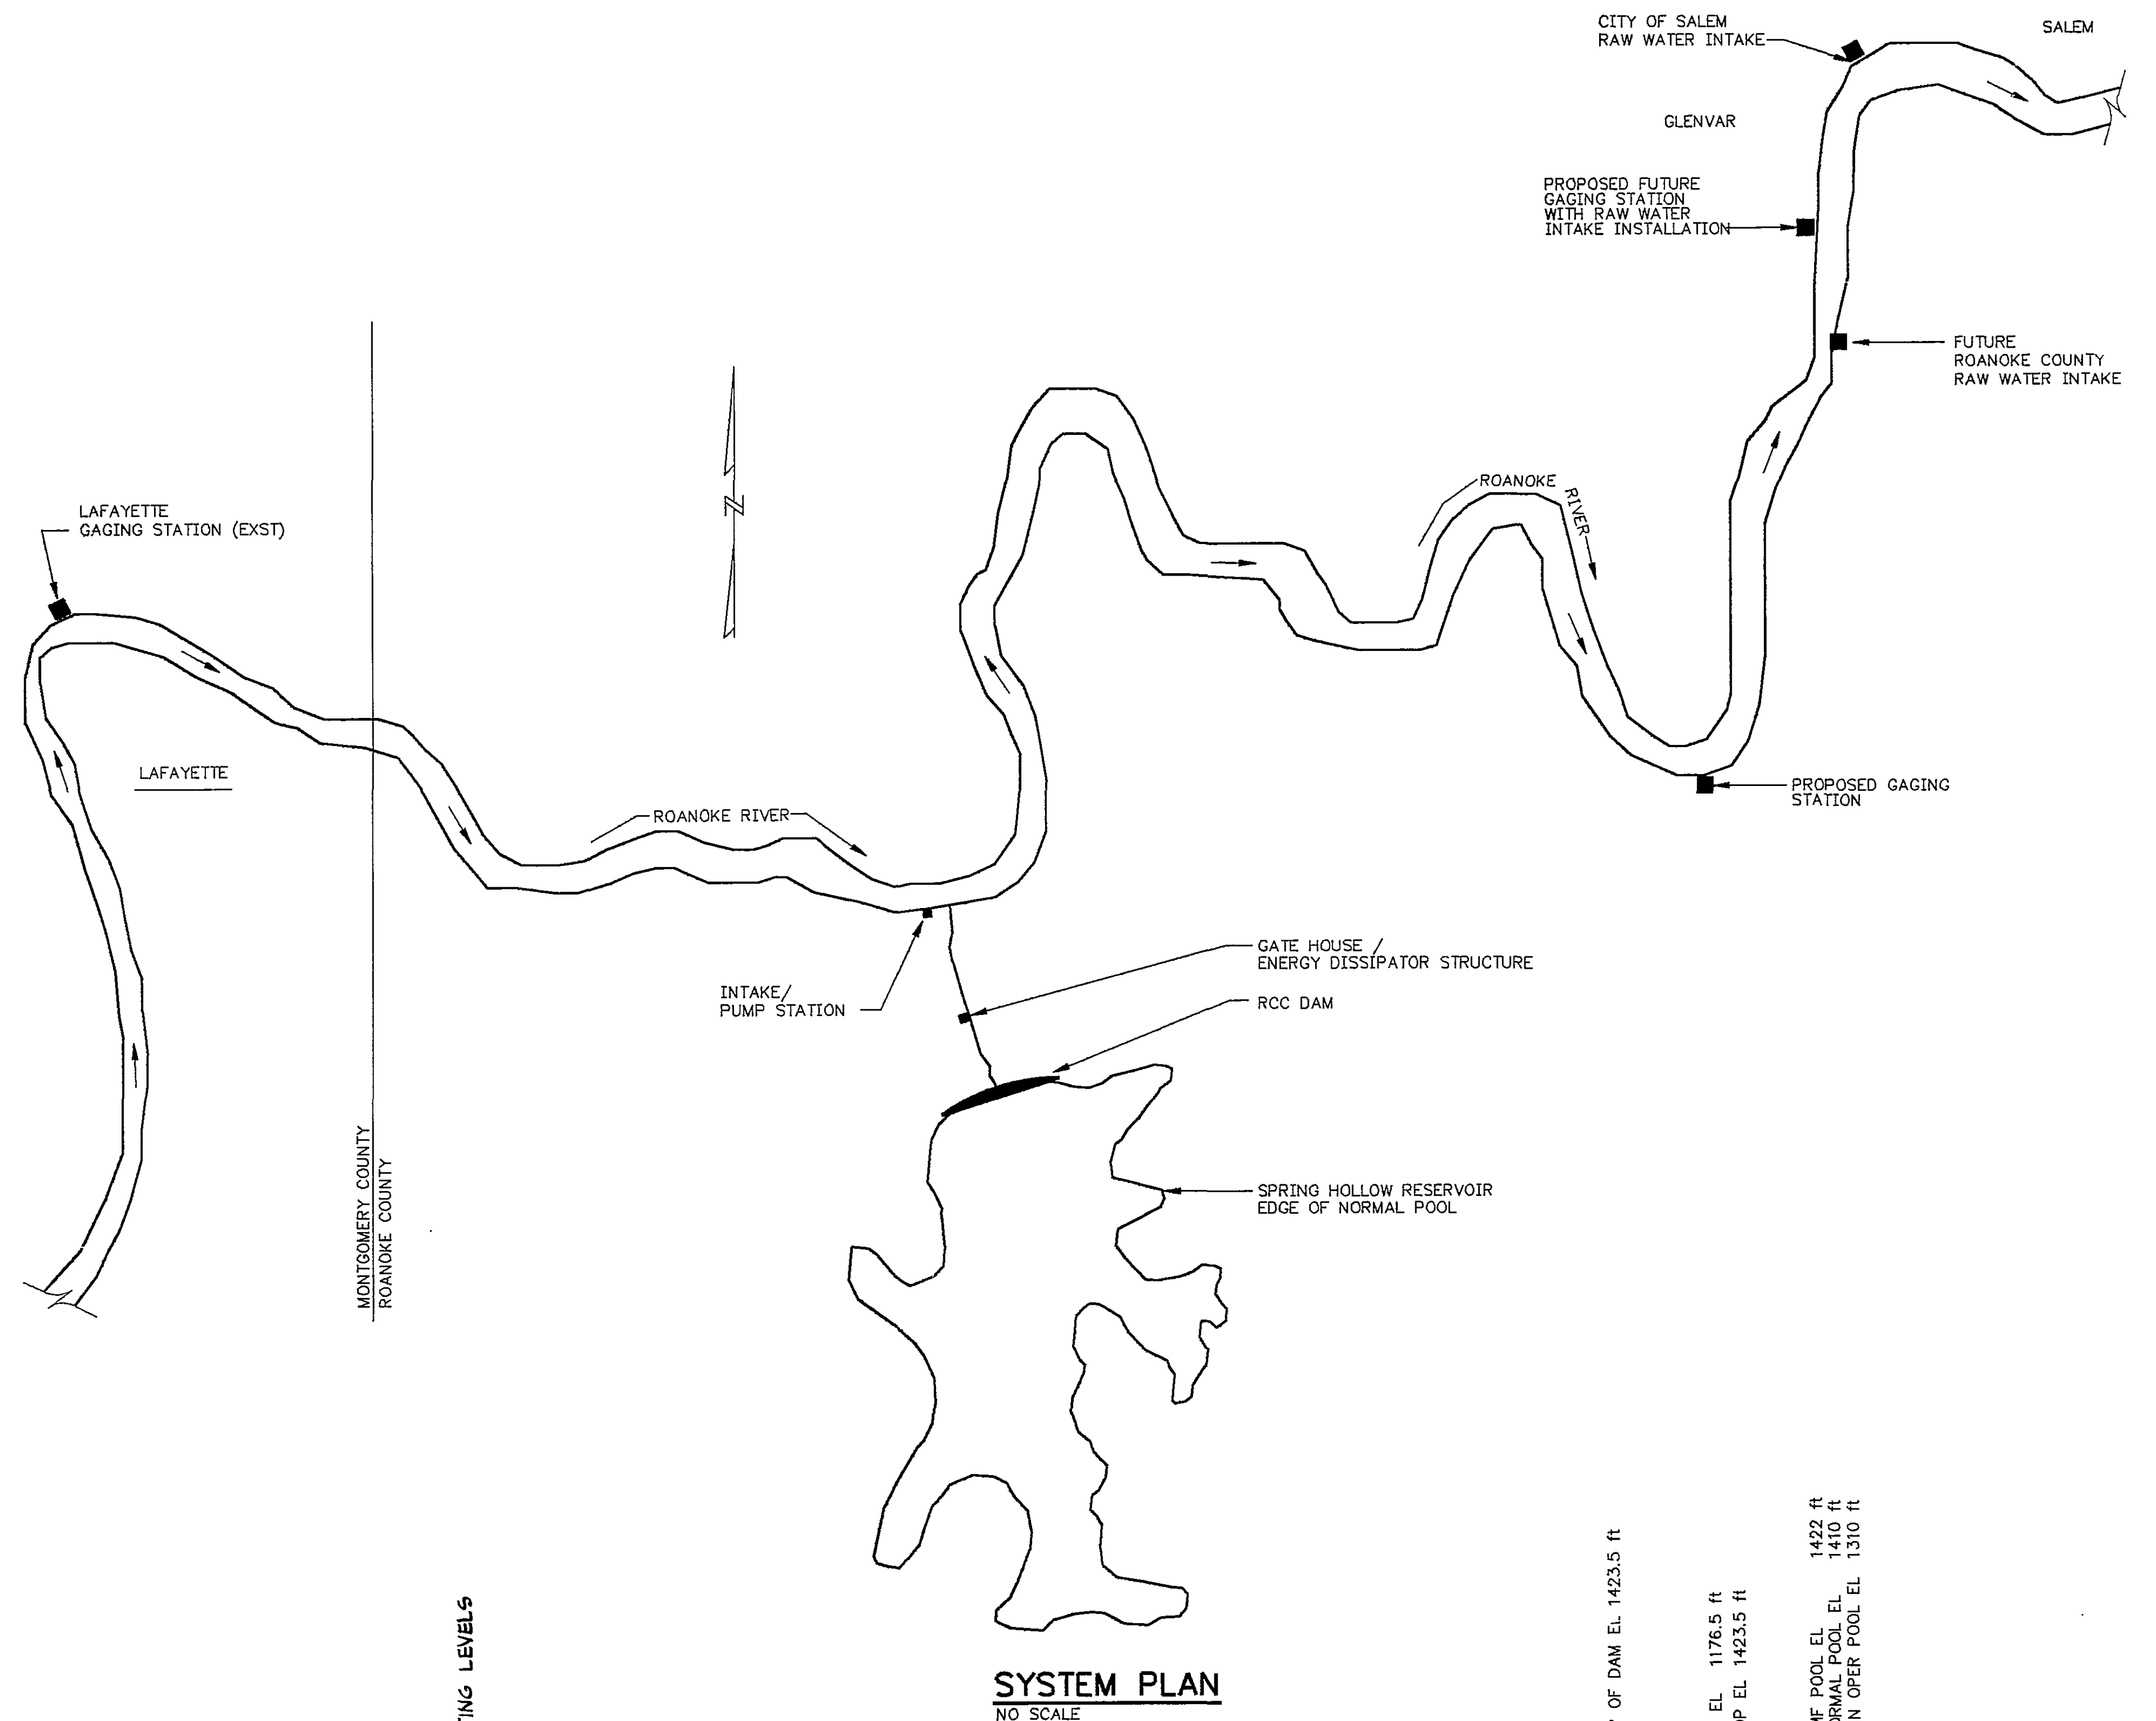


**RECORD DRAWINGS**  
 THESE DRAWINGS RECORDED ON THE BASIS OF INFORMATION FURNISHED BY THE CONTRACTOR OR SPECIFICALLY KNOWN TO HSM. NO OTHER REPRESENTATIONS ARE MADE OR IMPLIED  
 Date: 6-5-95

DESIGNED MBD DATE 8/4/91  
 DRAWN DAY DATE 8/4/91  
 CHECKED TSK DATE 8/4/91  
 APPROVED JAP DATE 8/4/91  
 ISSUED JAP DATE 8/21/91

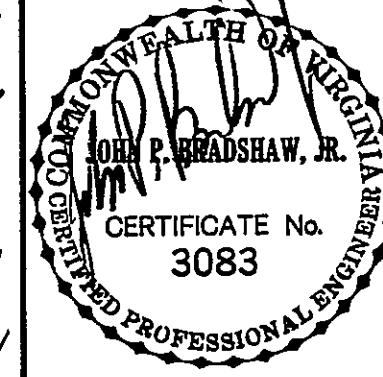

REVISIONS				
DATE	BY	DESCRIPTION	DATE	BY
8-15-94	BA	PER CONTR RECORD DWG		
8-15-95	JBA	ISSUED TO VA. DAM SAFETY		
8-31-97	RWF	RECORD DRAWING		

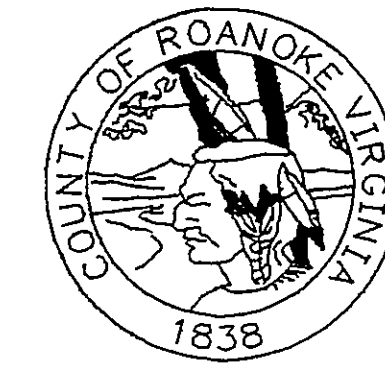

**SPRING HOLLOW RESERVOIR**  
**ROANOKE COUNTY, VIRGINIA**  
 HAYES, SEAY, MATTERN & MATTERN, INC.  
 ARCHITECTS - ENGINEERS - PLANNERS  
 ROANOKE, VIRGINIA

CIVIL  
 SUMMARY OF DESIGN CRITERIA

SCALE	DATE	COMM	SHEET	DWG
AS NOTED	8/4/91	4194E	C-1	3