
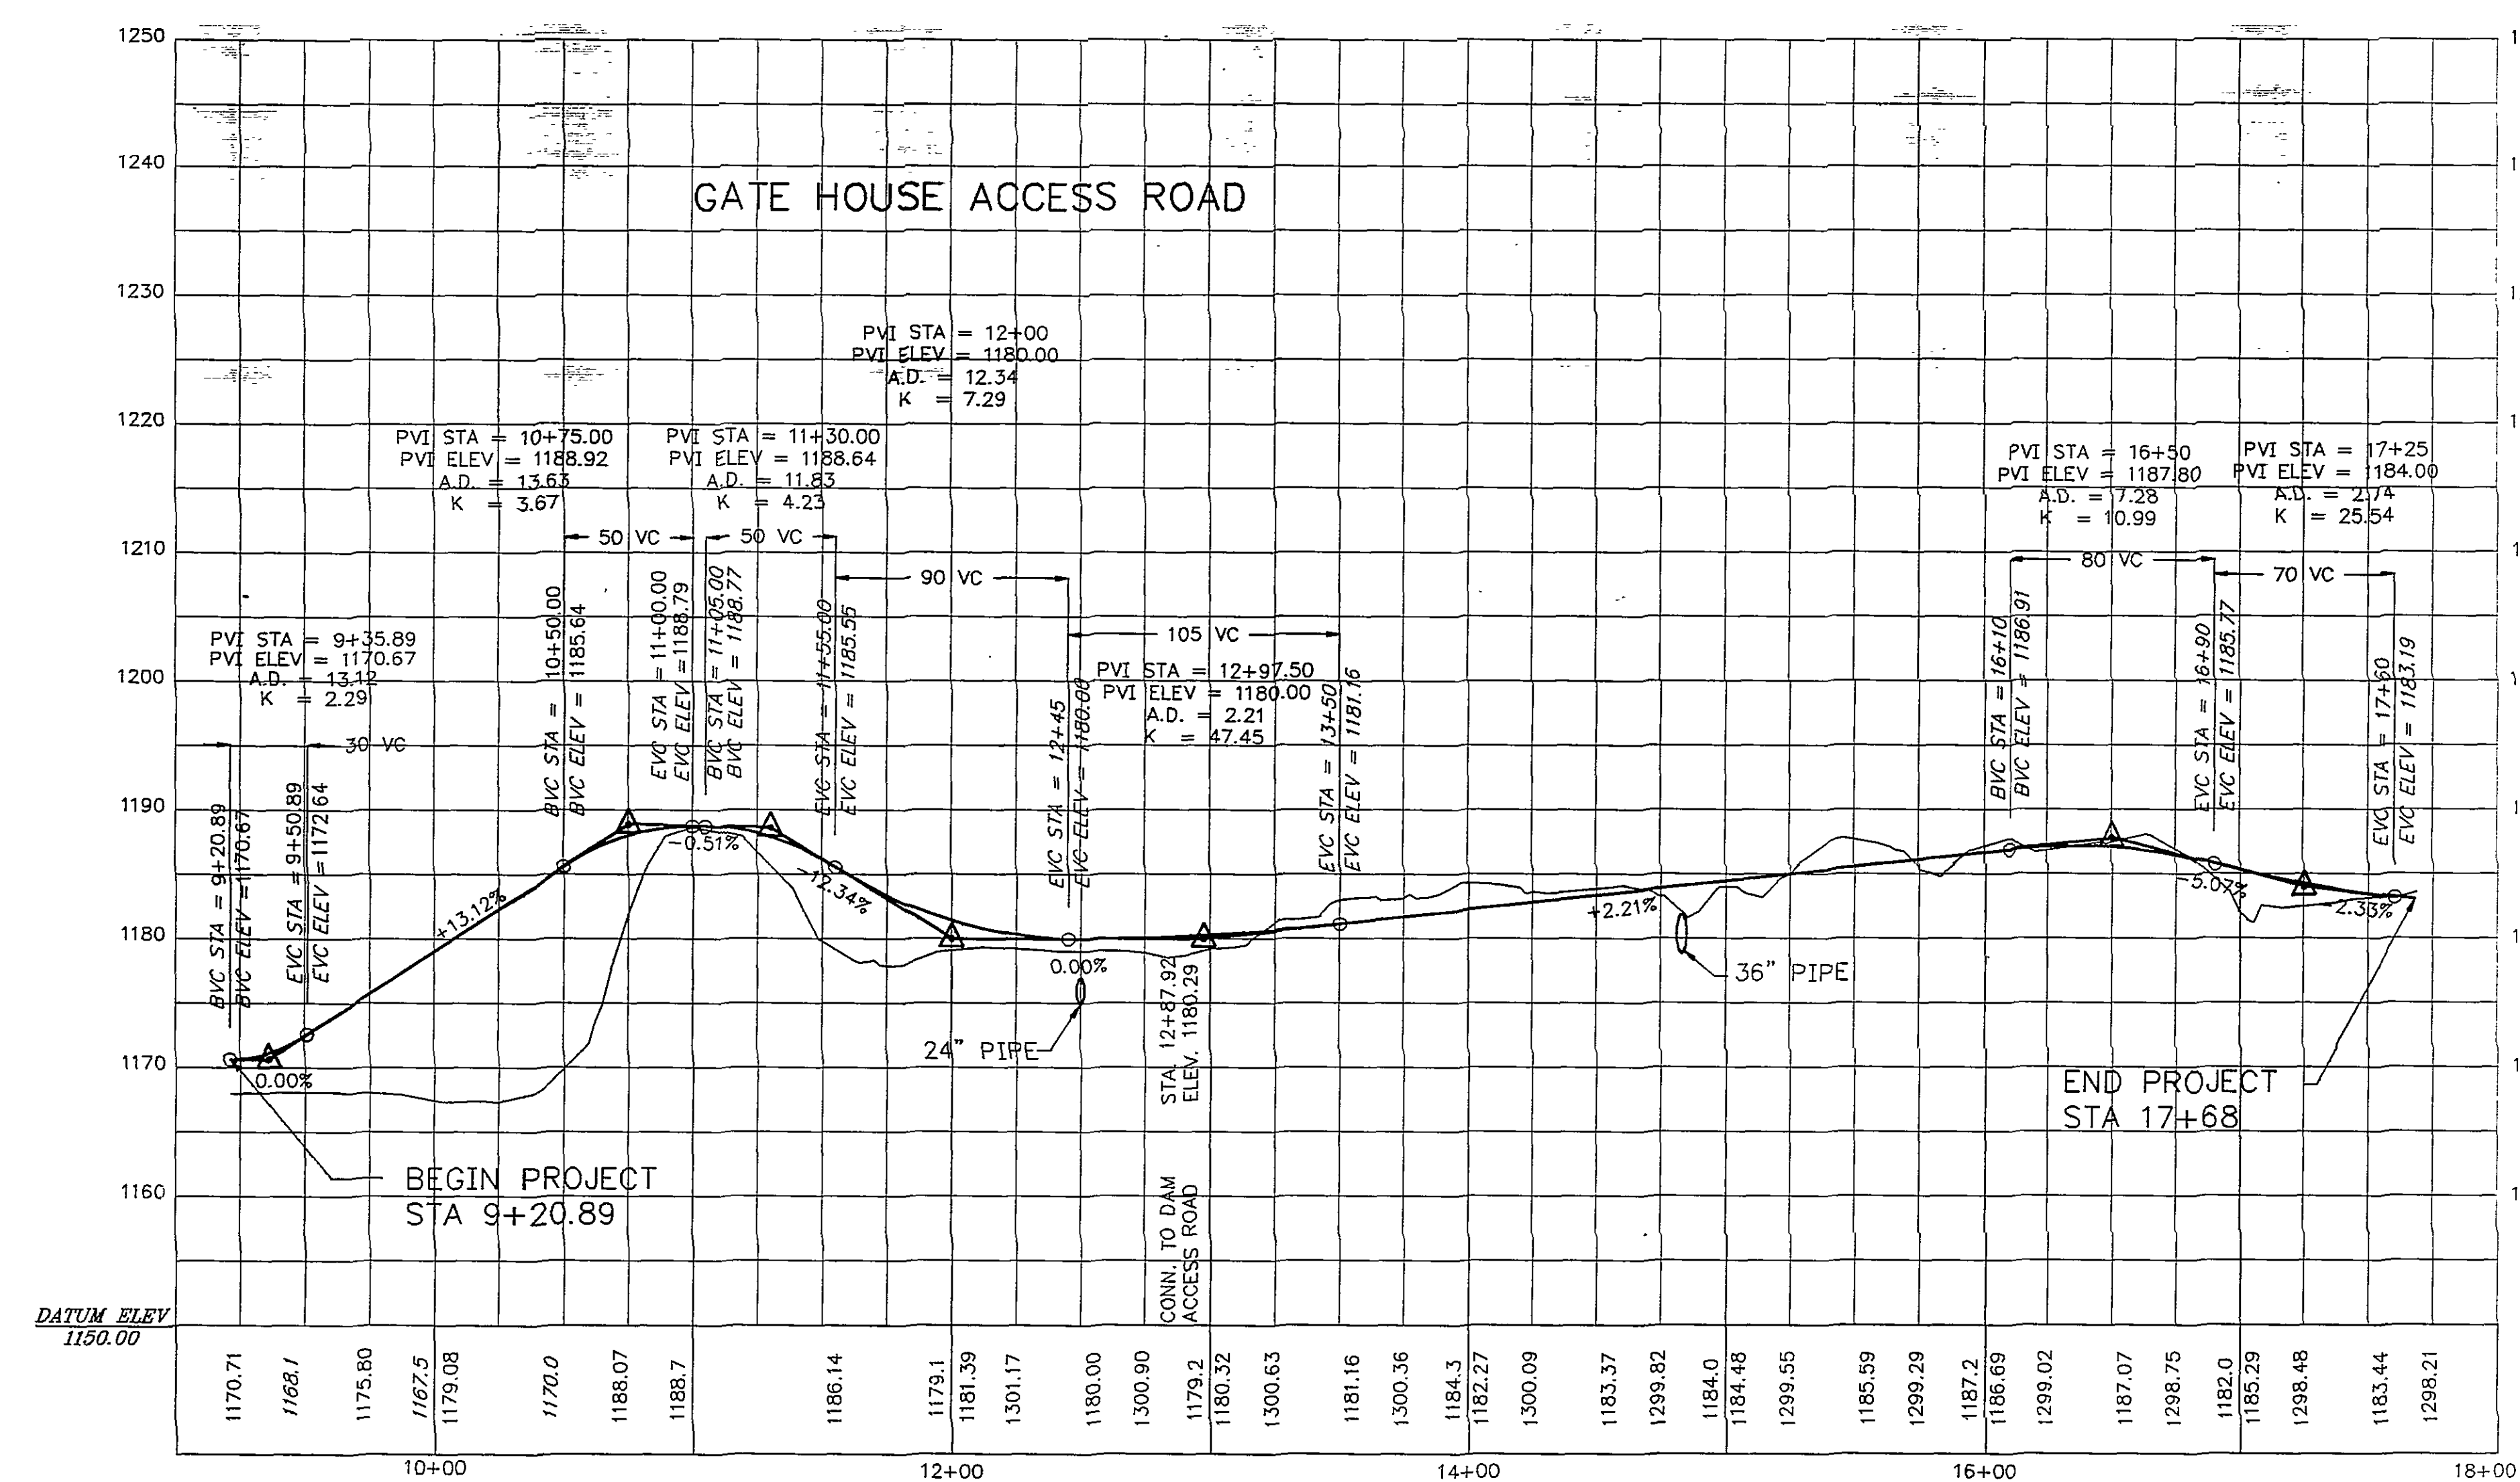


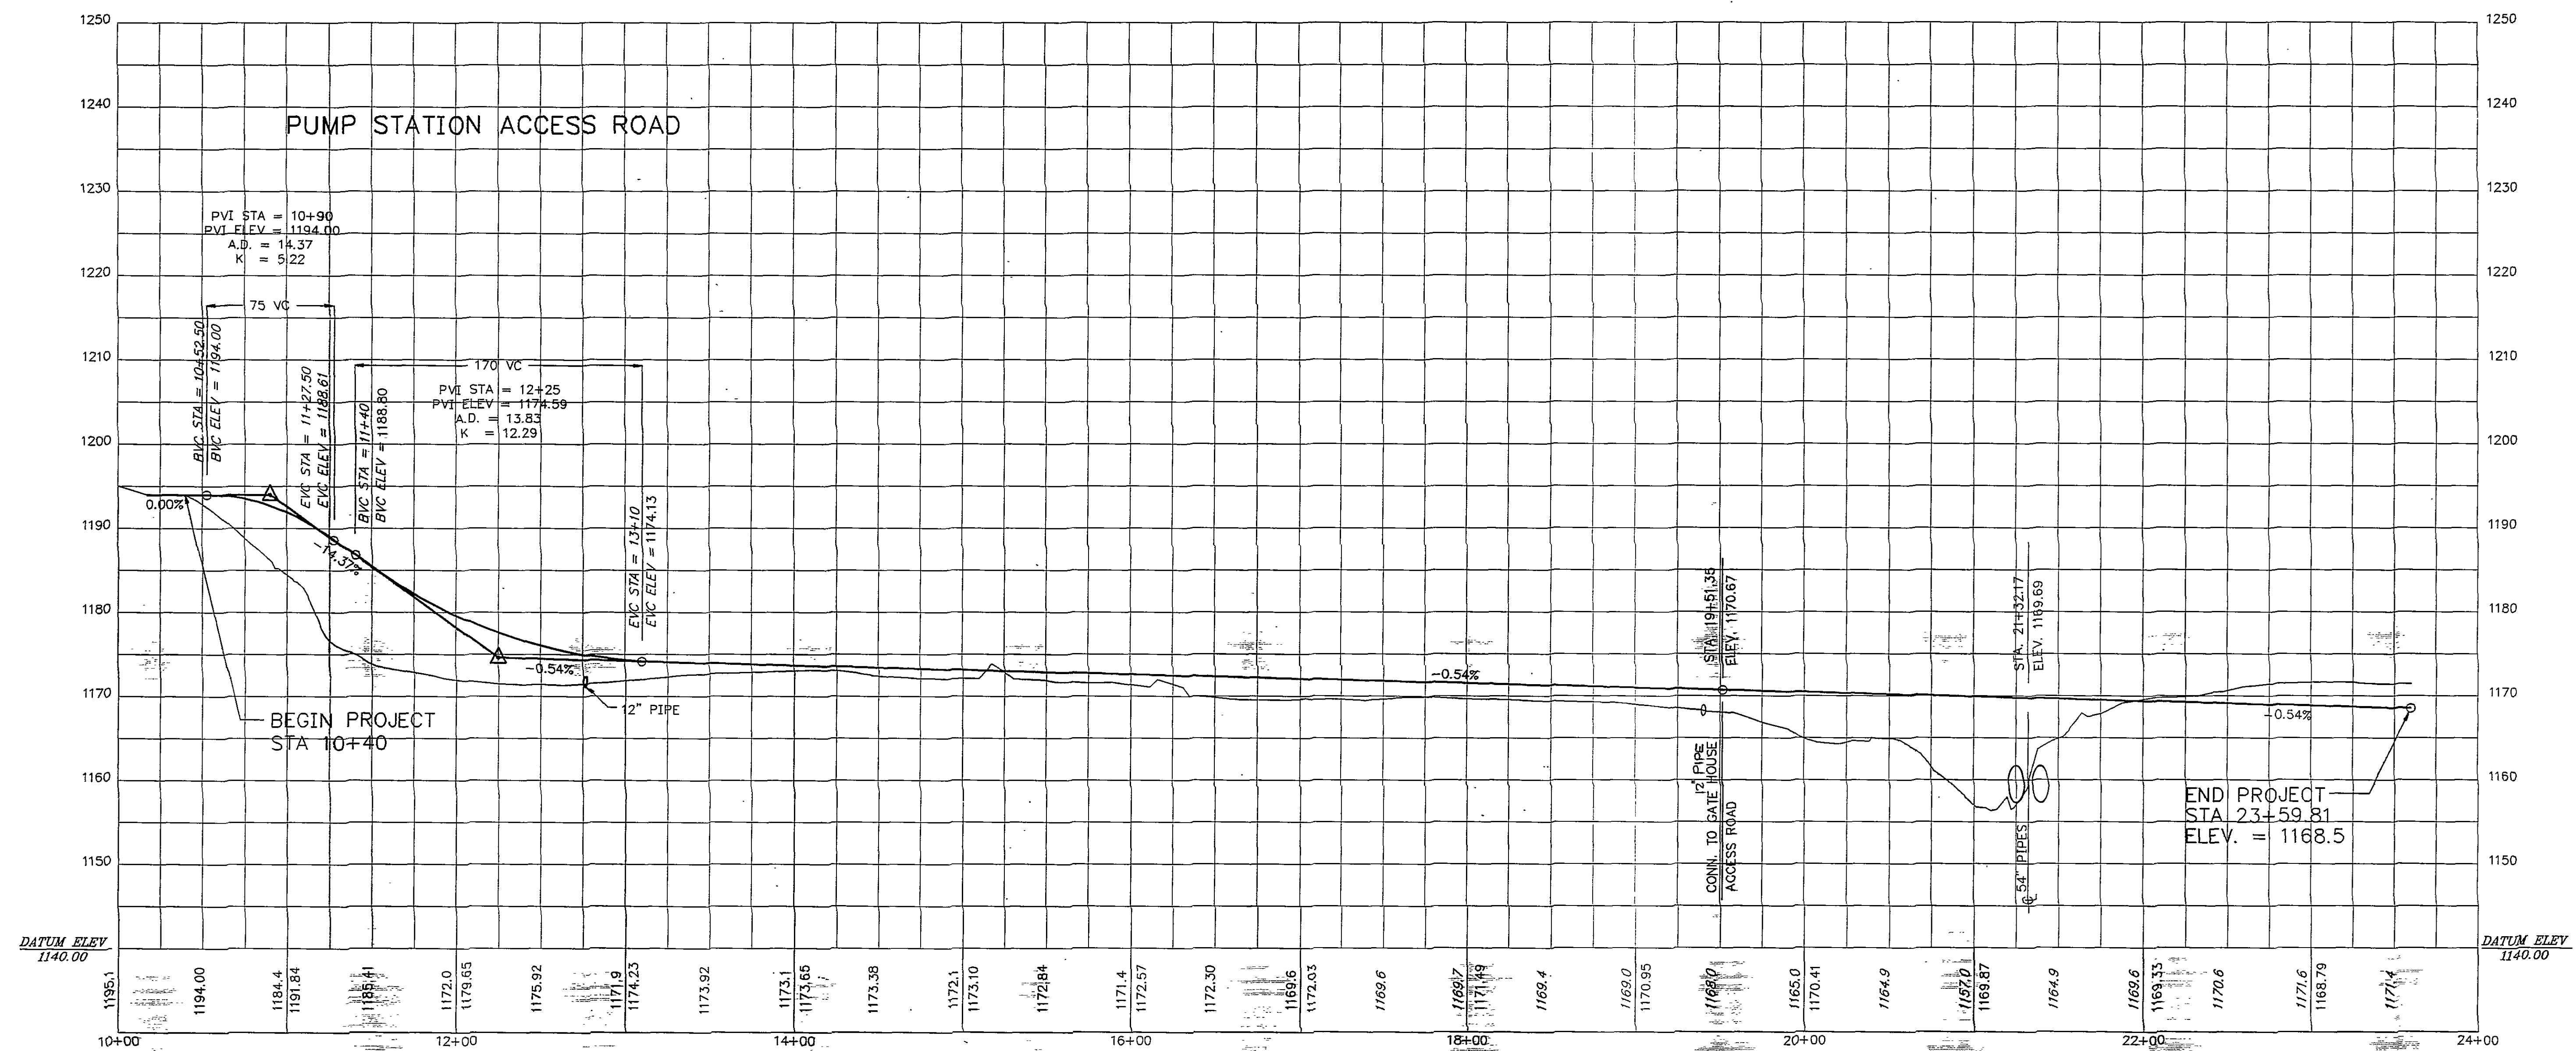


NOTE:
FOR PUMP STATION ACCESS ROAD PROFILE
FROM STA 13+50.90' AT, SEE SH C-5 DWG 8.

RECORD DRAWINGS
THESE DRAWINGS RECORDED ON THE BASIS OF
INFORMATION FURNISHED BY THE CONTRACTOR
OR SPECIFICALLY KNOWN TO HMM. NO OTHER
REPRESENTATIONS ARE MADE OR IMPLIED
Date: 6-5-95

DESIGNED DMC DATE 5/30/92
DRAWN RHM DATE 5/30/92
CHECKED DLG DATE 6/26/92
APPROVED FLP DATE 7/7/92
ISSUED DJR DATE 7/7/92

REVISIONS					
DATE	BY	DESCRIPTION	DATE	BY	DESCRIPTION
8-15-94	BA	PER CONTR RECORD DWG			
6-5-95	JBH	ISSUED TO VA. DAM. SAFETY			
6-30-95	RMF	RECORD DRAWING			

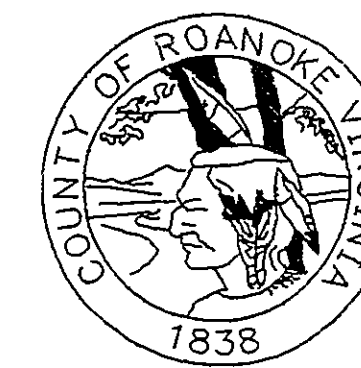

SPRING HOLLOW RESERVOIR
ROANOKE COUNTY, VIRGINIA
HAYES, SEAY, MATTERN & MATTERN, INC.
ARCHITECTS - ENGINEERS - PLANNERS
ROANOKE, VIRGINIA

CIVIL
ACCESS ROADS PROFILES
SCALE: HORIZ. 1"=50'
VERT. 1"=10'
DATE: 30 MAY 1992
COMM: 41941
SHEET: C-5
DWG: 7