




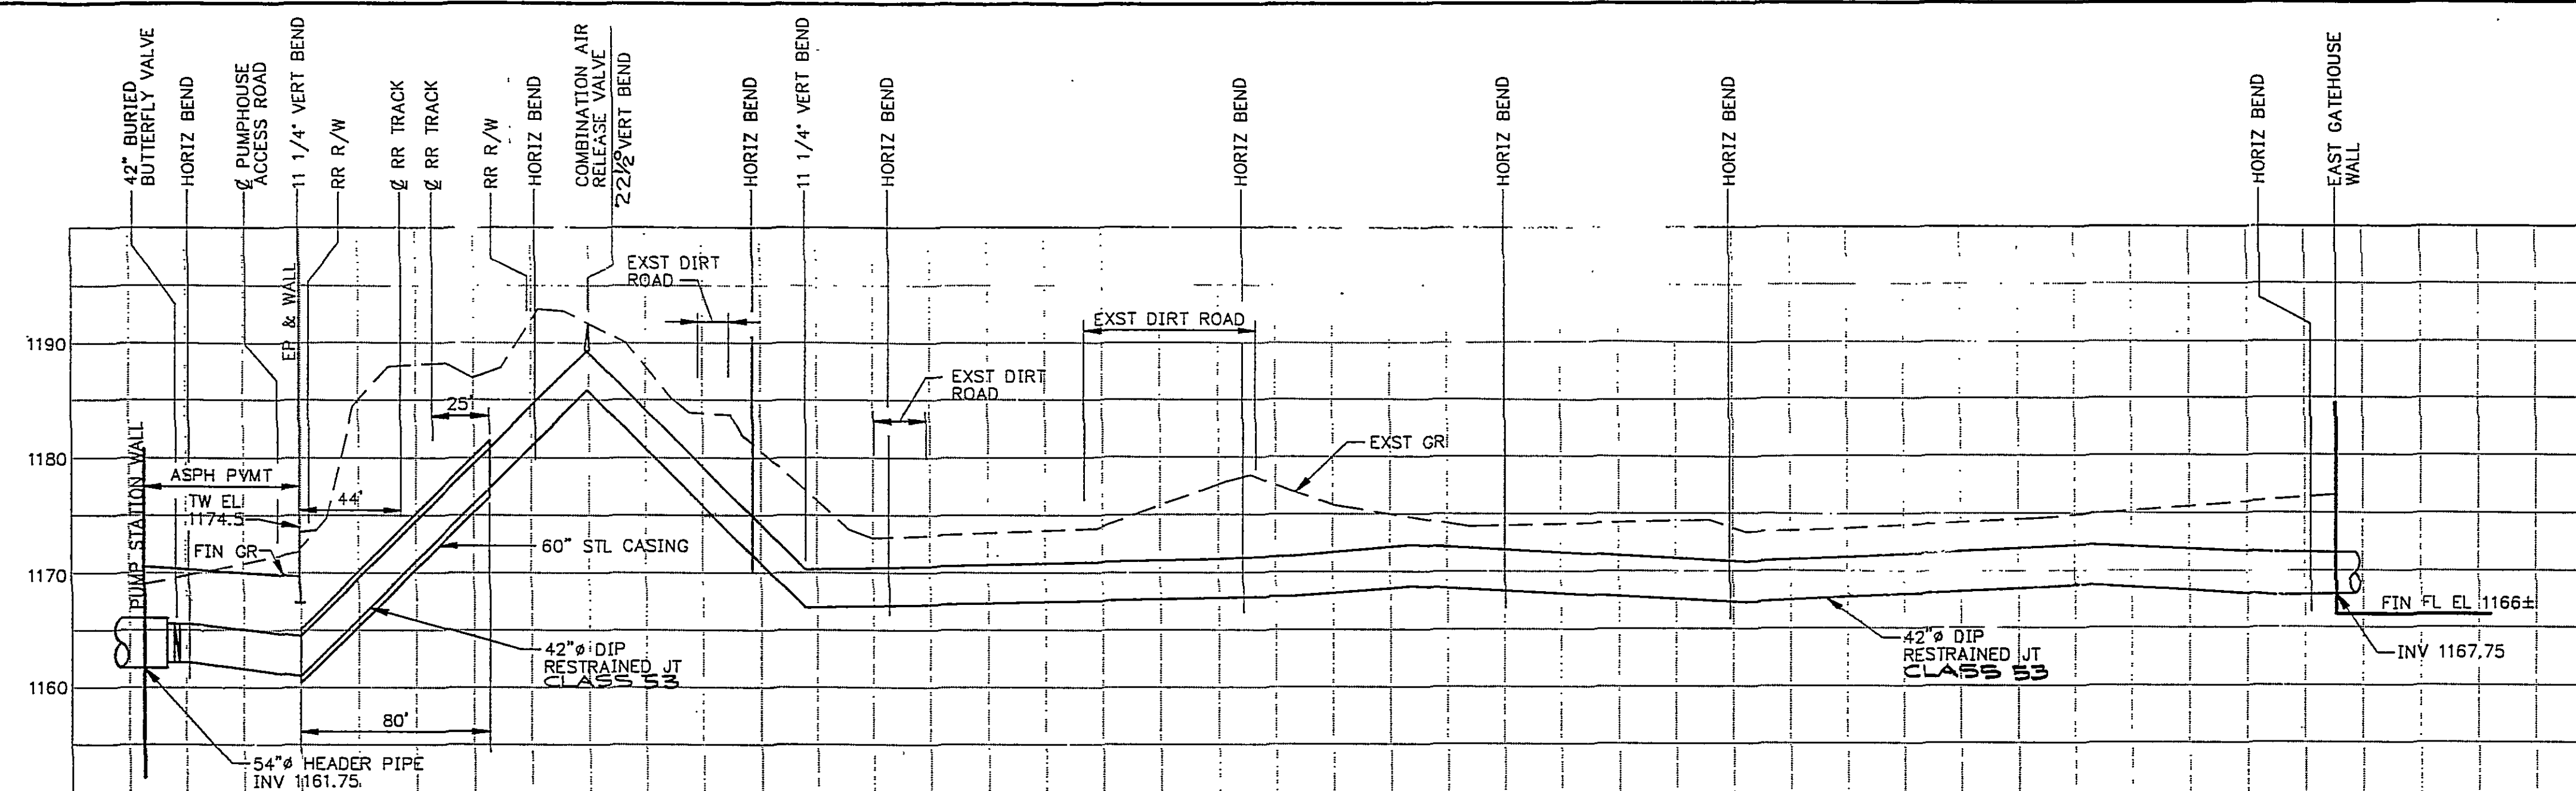



RAW WATER LINE A
SCALE: 1"=50' HORIZ
1"=10' VERT

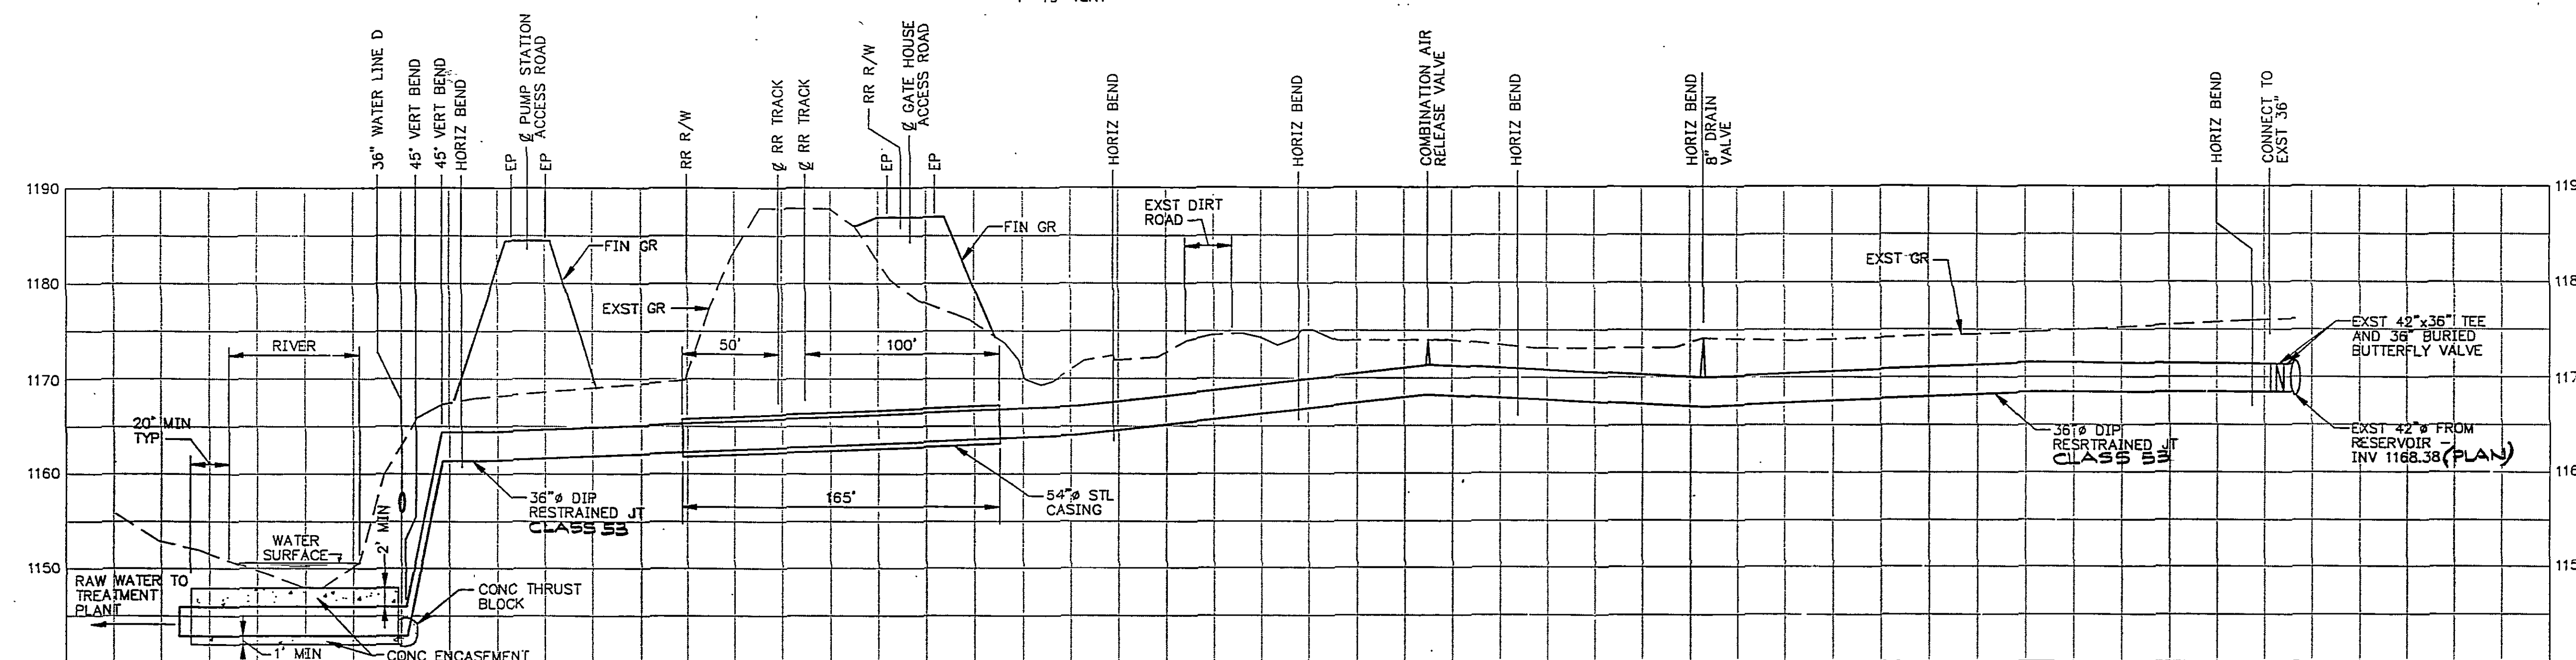

RAW WATER LINE B TO PLANT
SCALE: 1"=50' HORIZ
1"=10' VERT

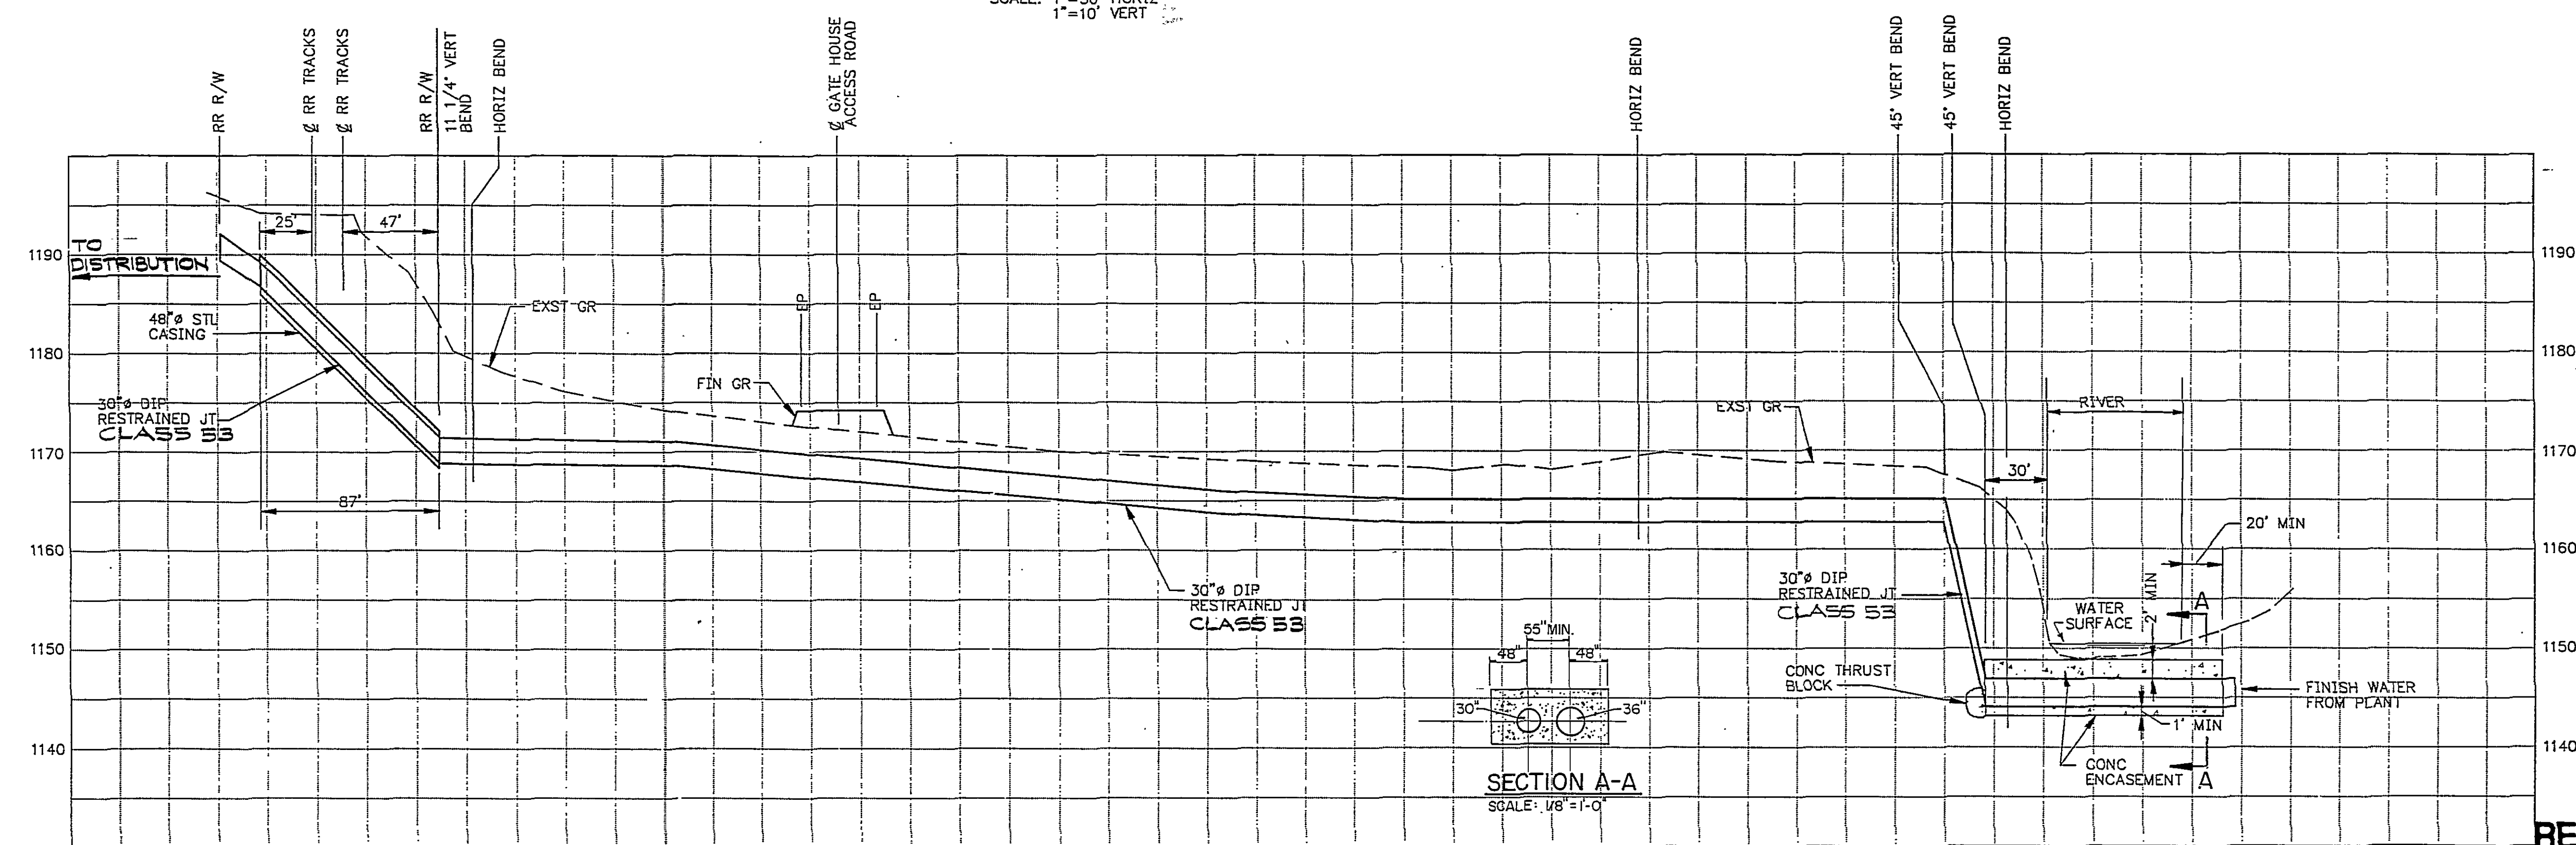

FINISH WATER LINE C
SCALE: 1"=50' HORIZ
1"=10' VERT

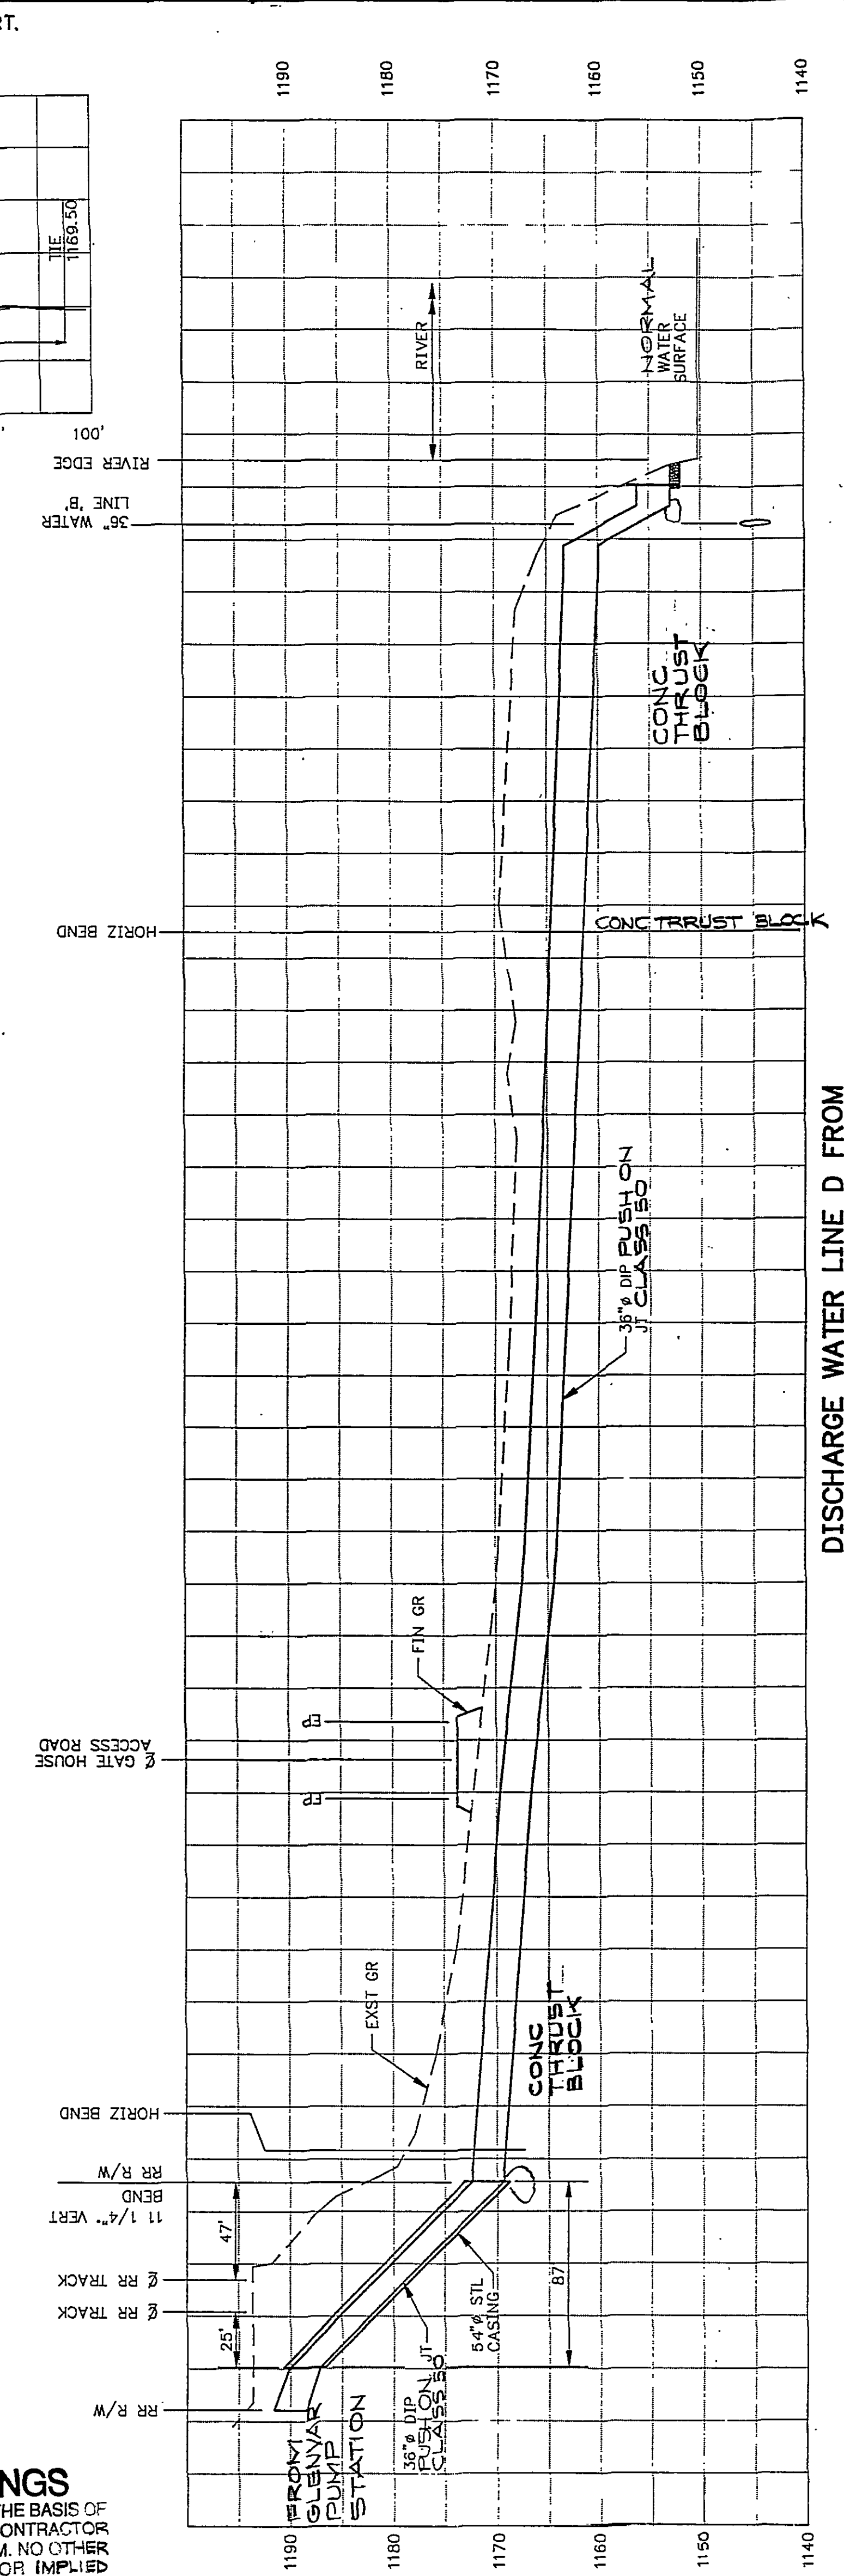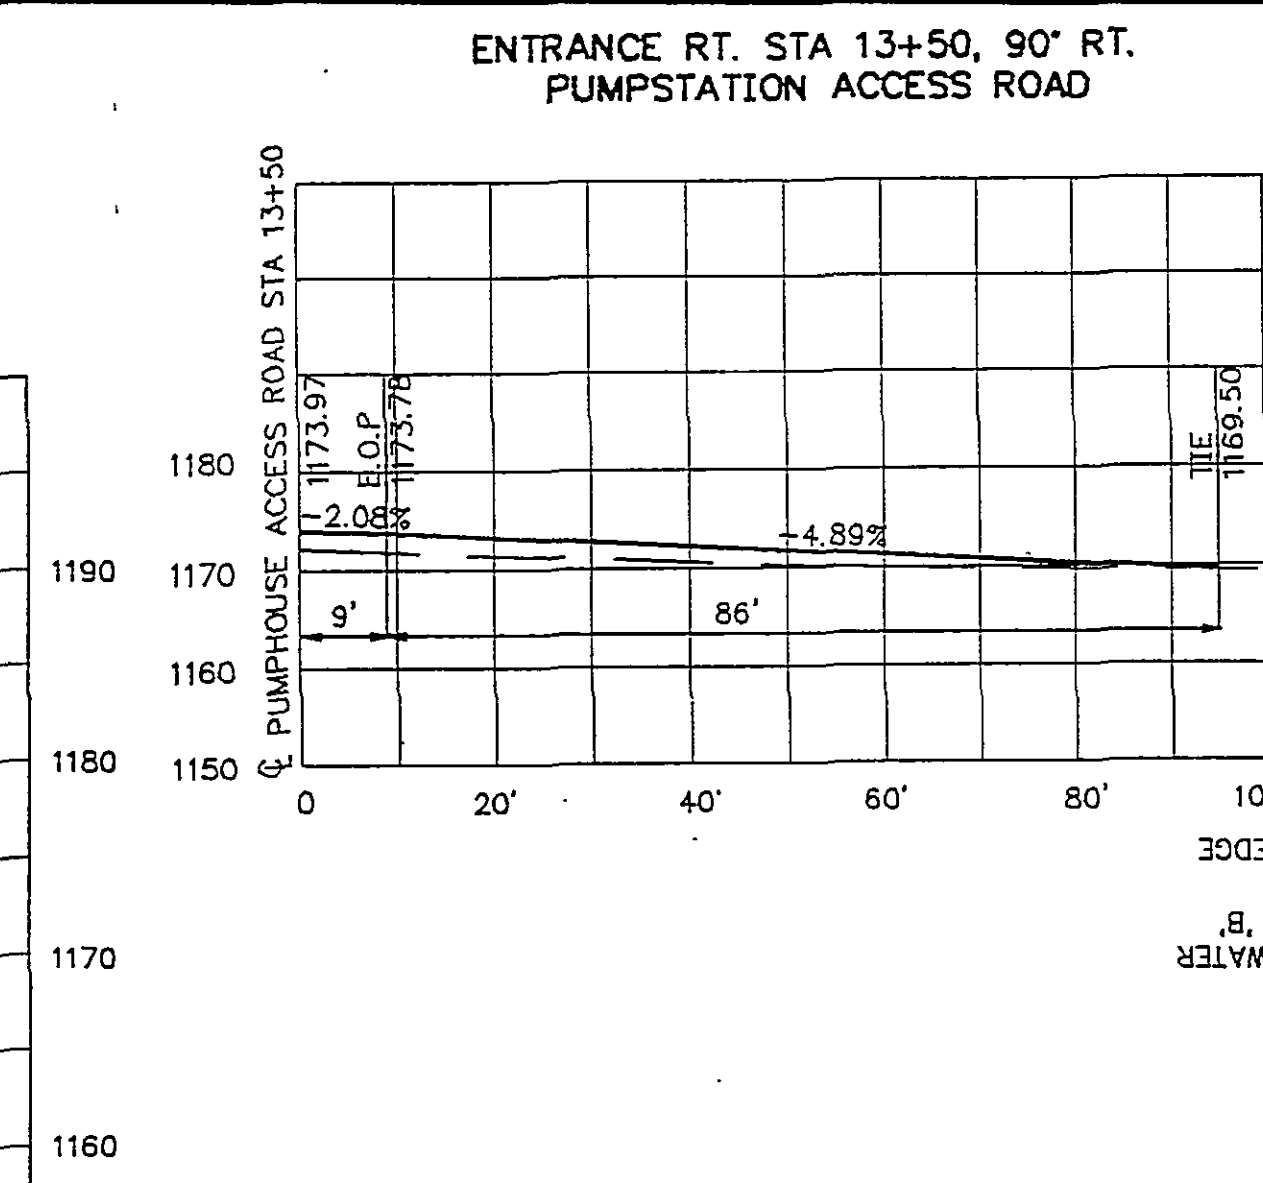


DISCHARGE WATER LINE D FROM GLENVAR PUMP STATION
SCALE: 1"=50' HORIZ
1"=10' VERT


RECORD DRAWINGS
THESE DRAWINGS RECORDED ON THE BASIS OF INFORMATION FURNISHED BY THE CONTRACTOR OR SPECIFICALLY KNOWN TO HMM. NO OTHER REPRESENTATIONS ARE MADE OR IMPLIED.
Date: 6-5-95

4721AC-48 C4721A APR1992 REV. B ACAD .JOB PLOT SCALE: 1"=50'

DESIGNED	AK	DATE	8/1/91
DRAWN	PPA	DATE	8/1/91
CHECKED	AWB	DATE	8/1/91
APPROVED	AWB	DATE	8/21/91
ISSUED	PPA	DATE	8/21/91

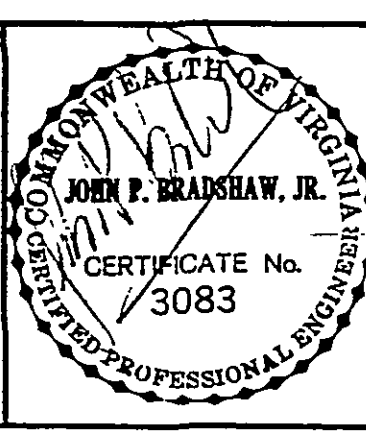

DATE	BY	DESCRIPTION	DATE	BY	DESCRIPTION
8/15/91	BA	PER CONTR RECORD DWG			
6-5-95	JBH	ISSUED TO VA. PAM SAFETY			
6/3/97	WRF	RECORD DRAWING			

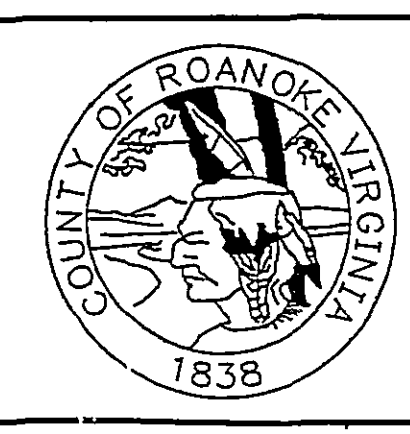

SPRING HOLLOW RESERVOIR
ROANOKE COUNTY, VIRGINIA
HAYES, SEAY, MATTERN & MATTERN, INC.
ARCHITECTS - ENGINEERS - PLANNERS
ROANOKE, VIRGINIA

CIVIL PROFILES		WATER PIPELINES	
SCALE	DATE	COMM	SHEET
AS NOTED	20 APRIL 1992	4721A	C-6 8