



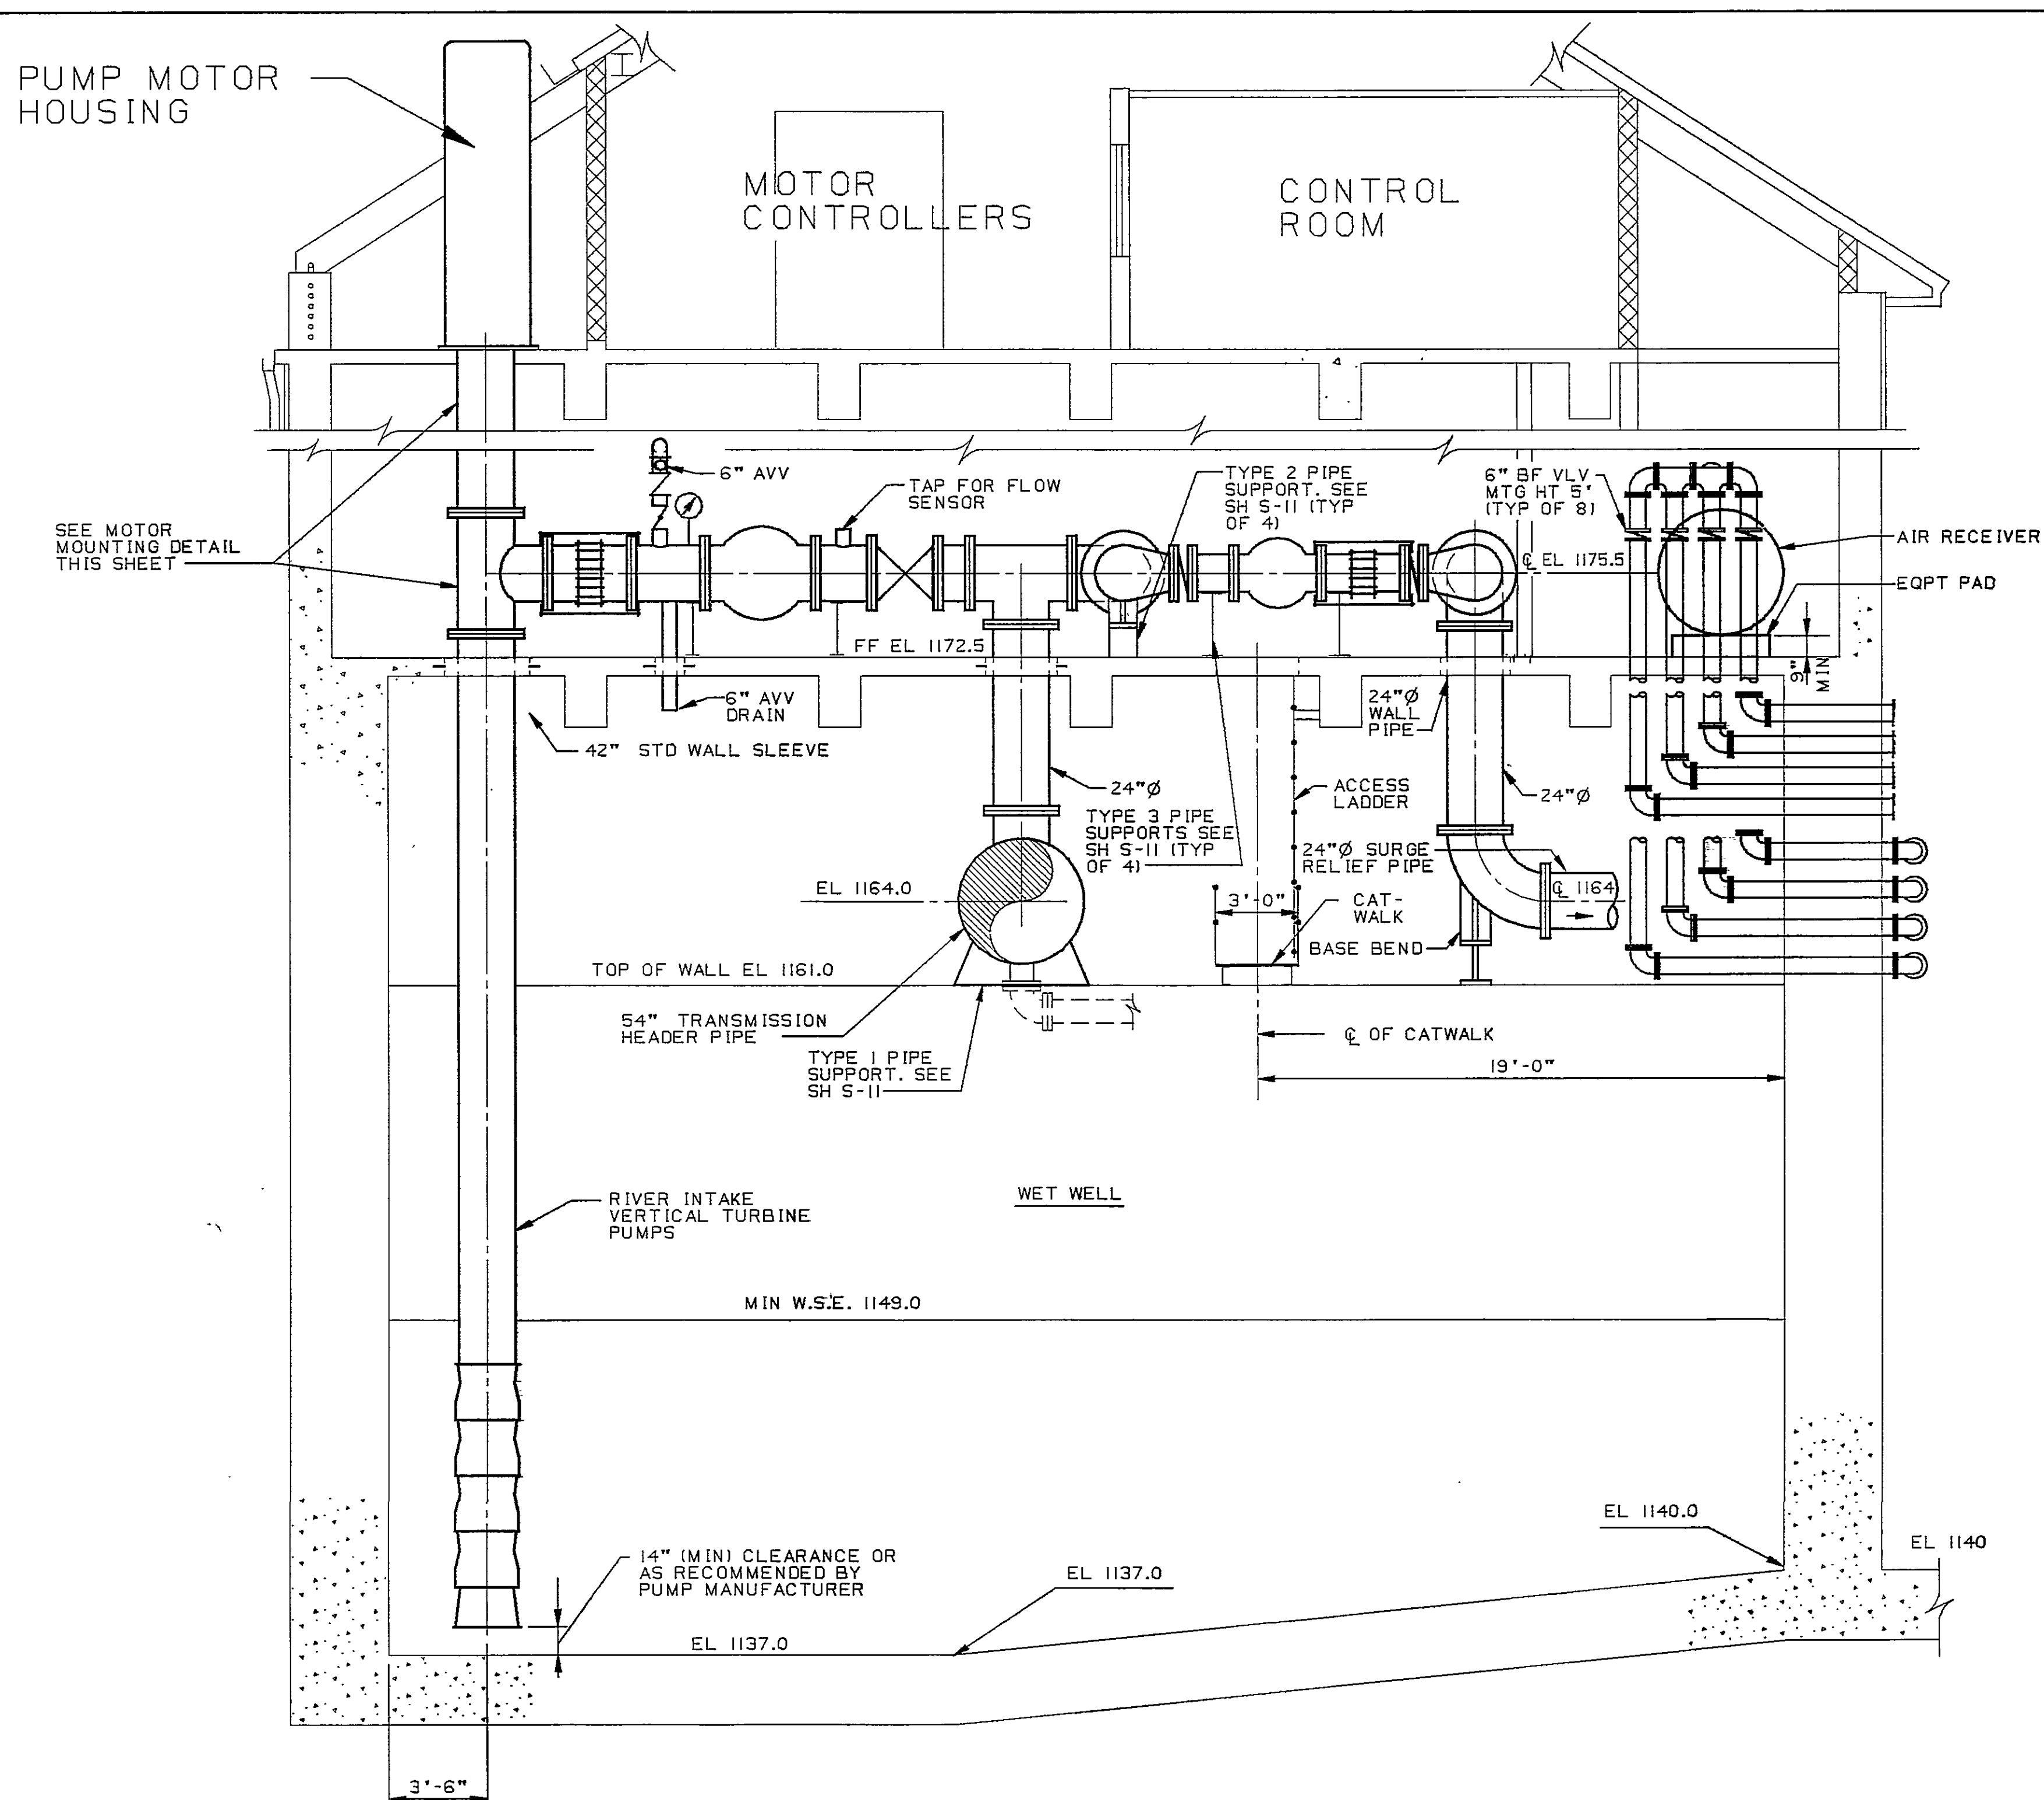


SECTION

SCALE : 1/4" = 1'-0"

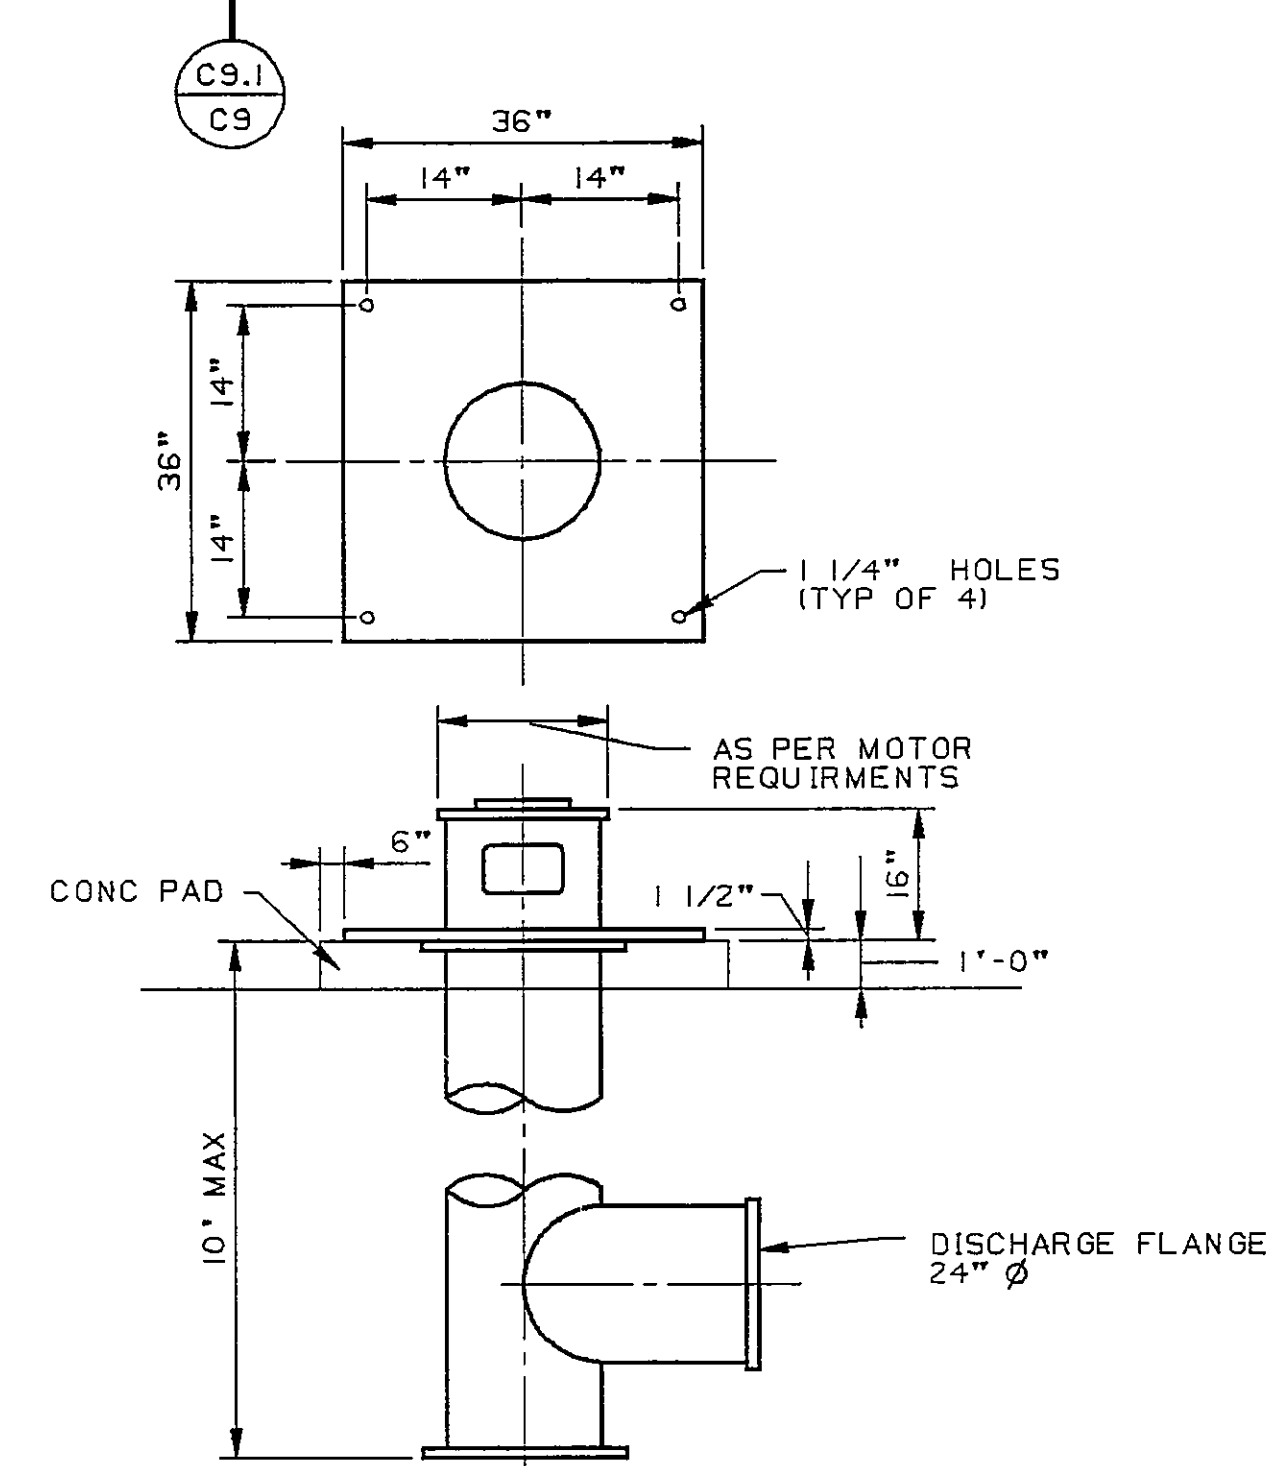


TYPE UG
MOTOR MOUNTING

SCALE : NONE

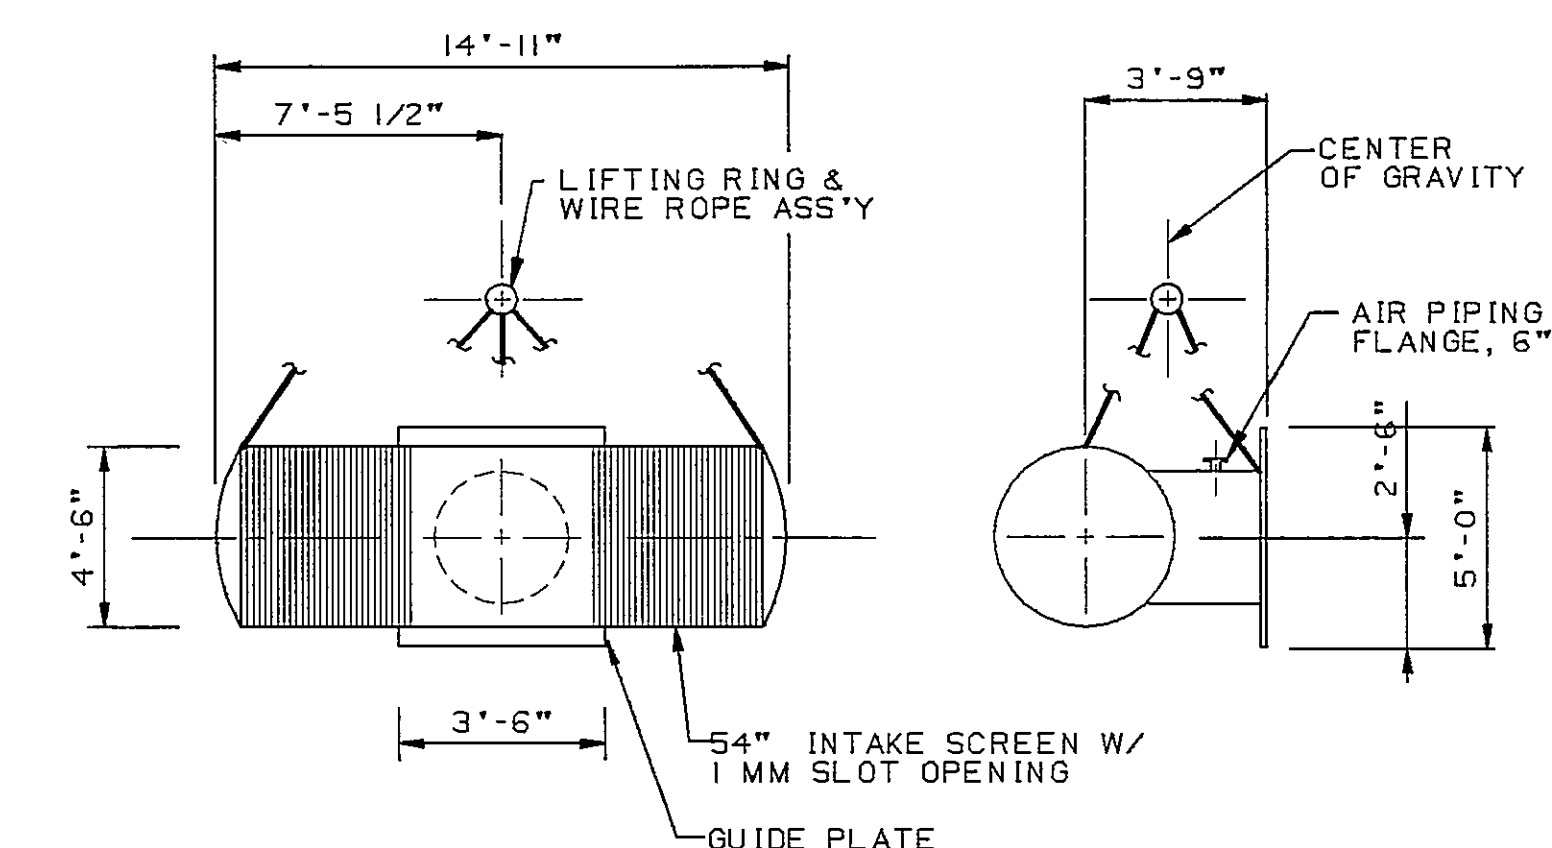


GUIDE RAIL DETAIL

SCALE : NONE

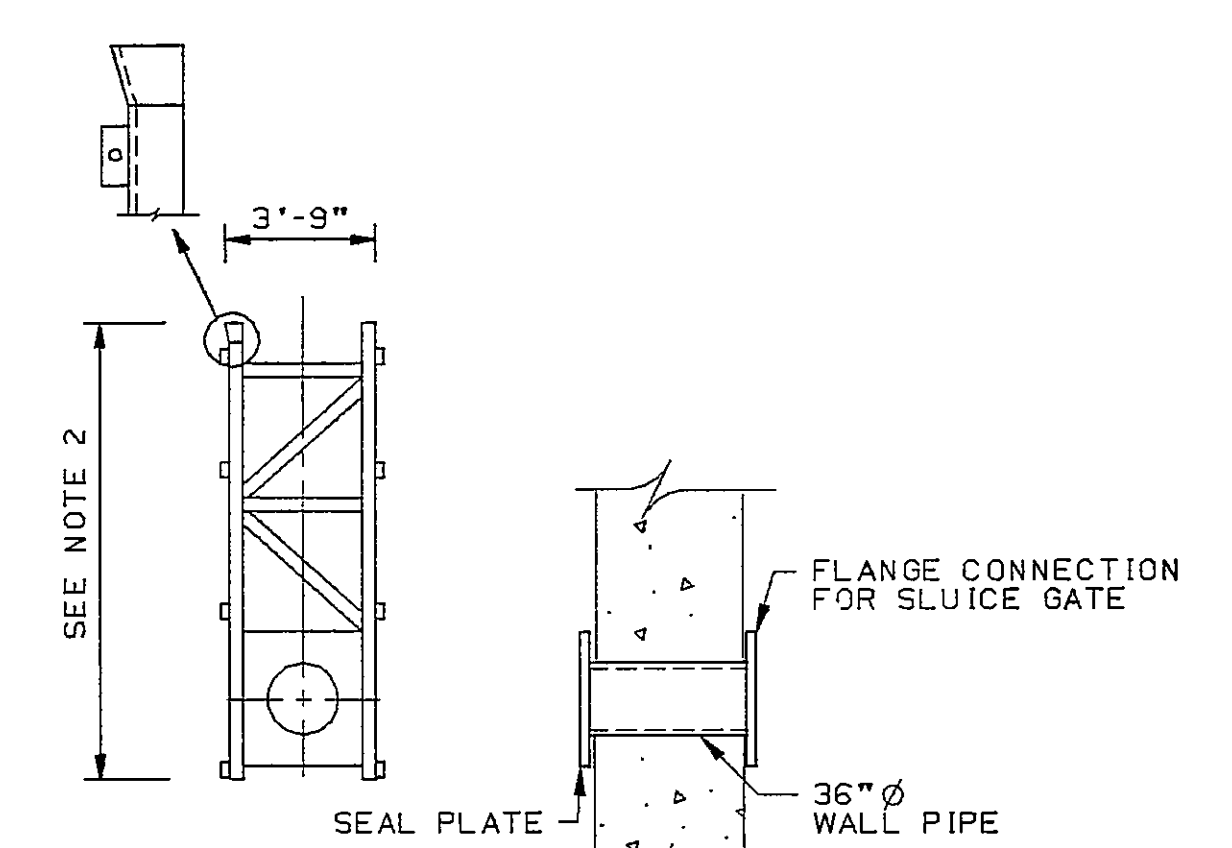

RECORD DRAWINGS

- THESE DRAWINGS RECORDED ON THE BASIS OF
INFORMATION FURNISHED BY THE CONTRACTOR
OR SPECIFICALLY KNOWN TO HMM. NO OTHER
REPRESENTATIONS ARE MADE OR IMPLIED
Date: 6-5-95

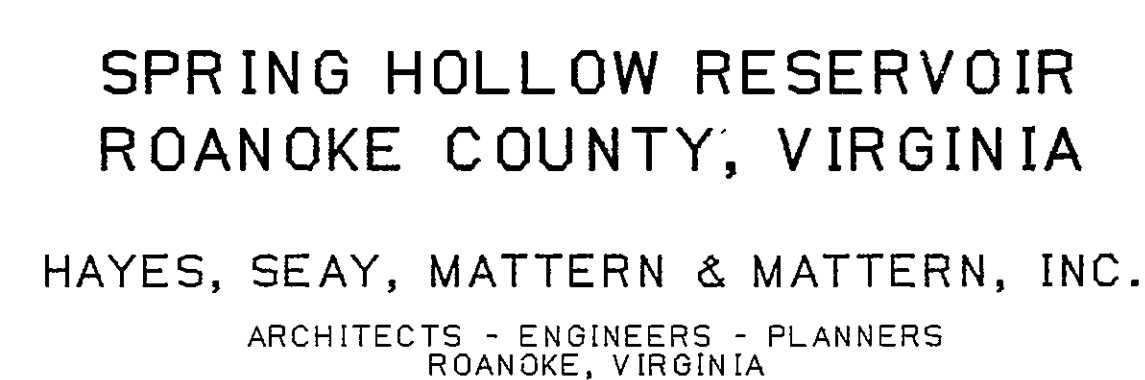Date: 6-5-95[illegible]

CIVIL
INTAKE/PUMP STATION PIPING LEVEL
PLANS AND SECTIONS

SCALE	DATE	COMM	SHEET	DWG
AS NOTED	8/4/91	4194E	C-9	11