

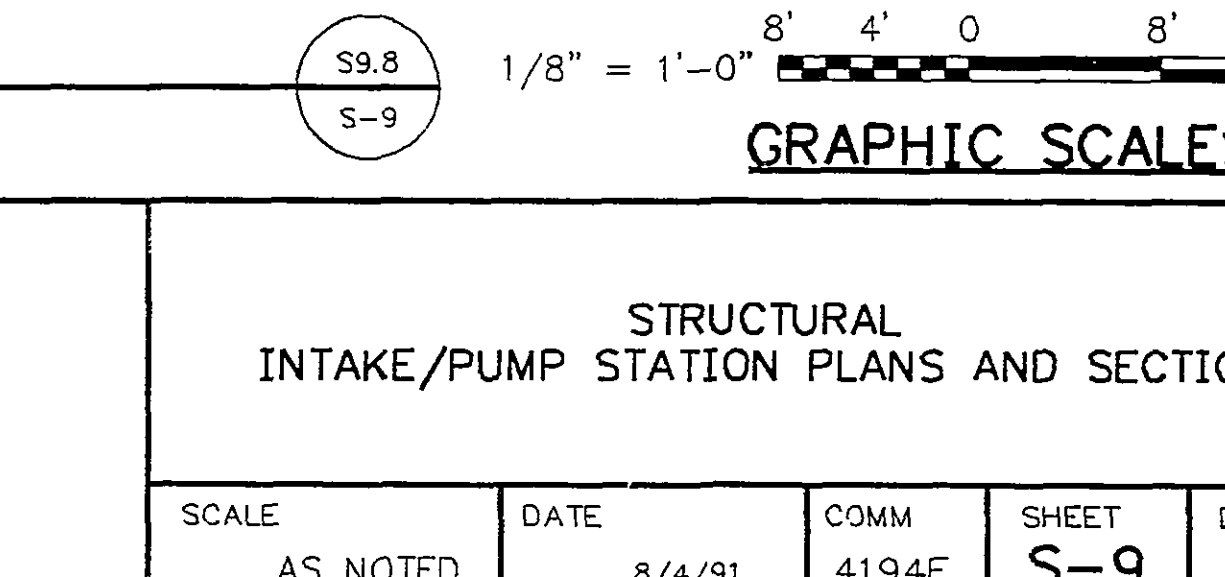
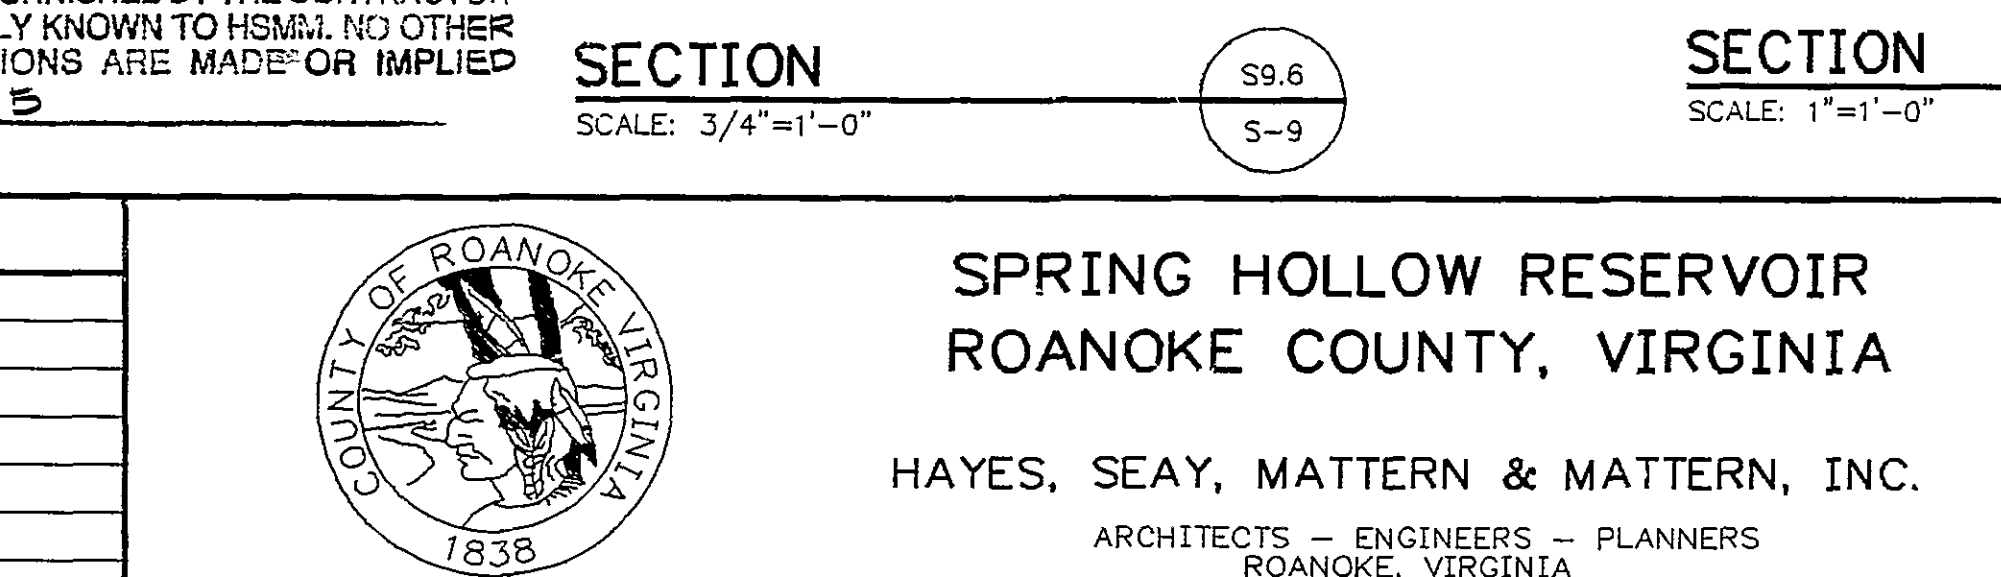
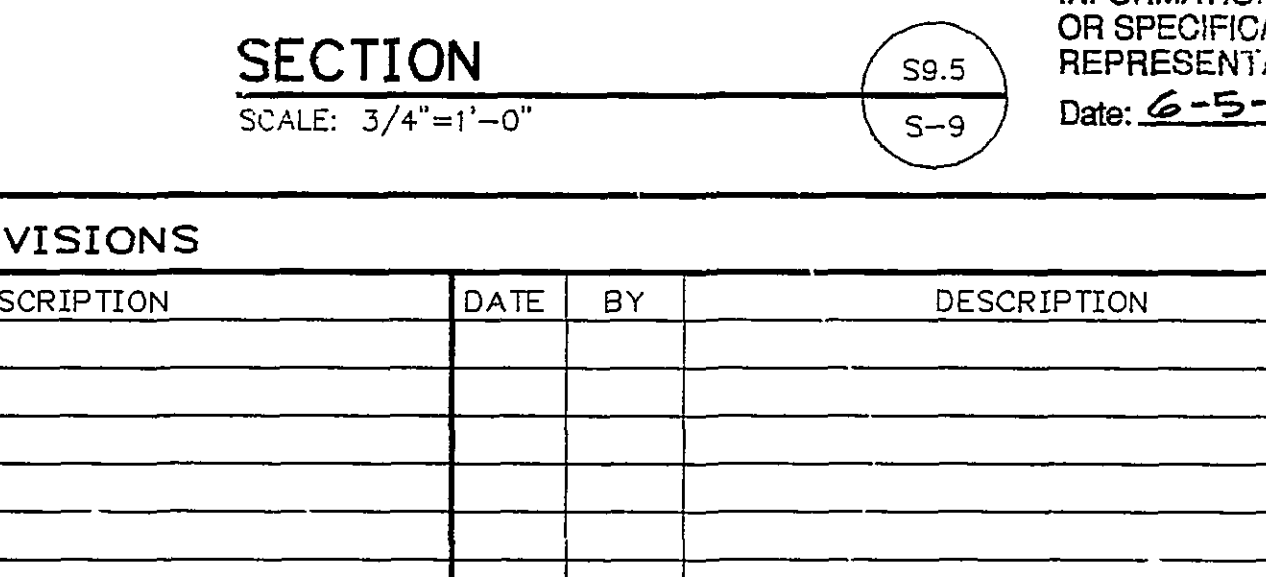
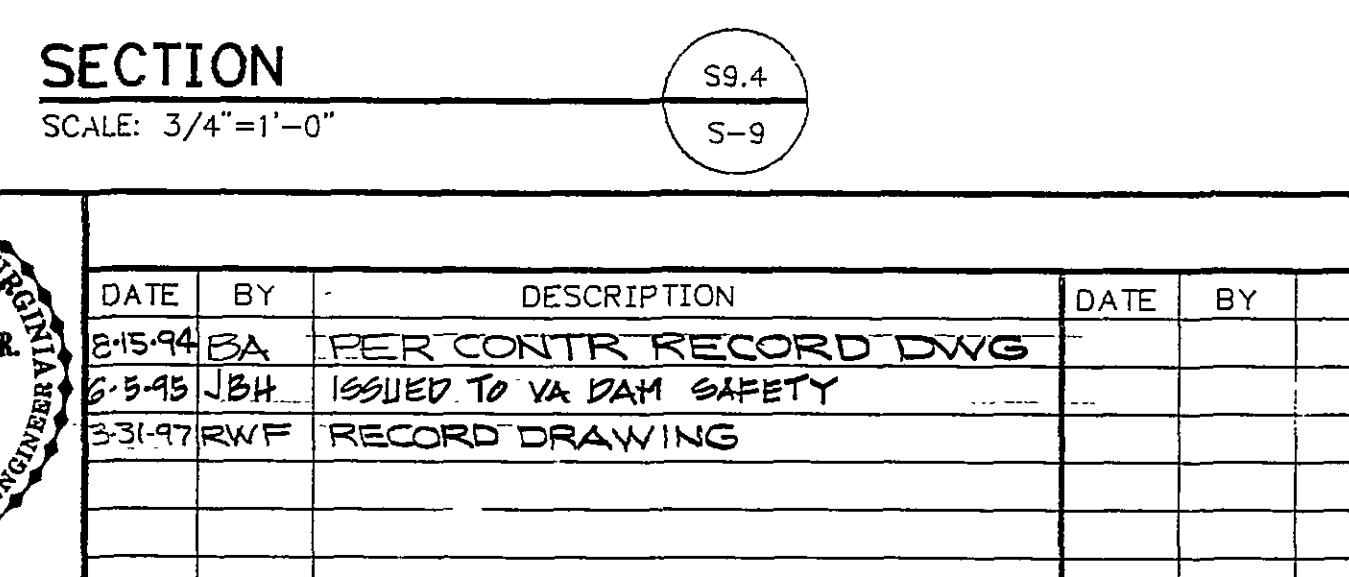
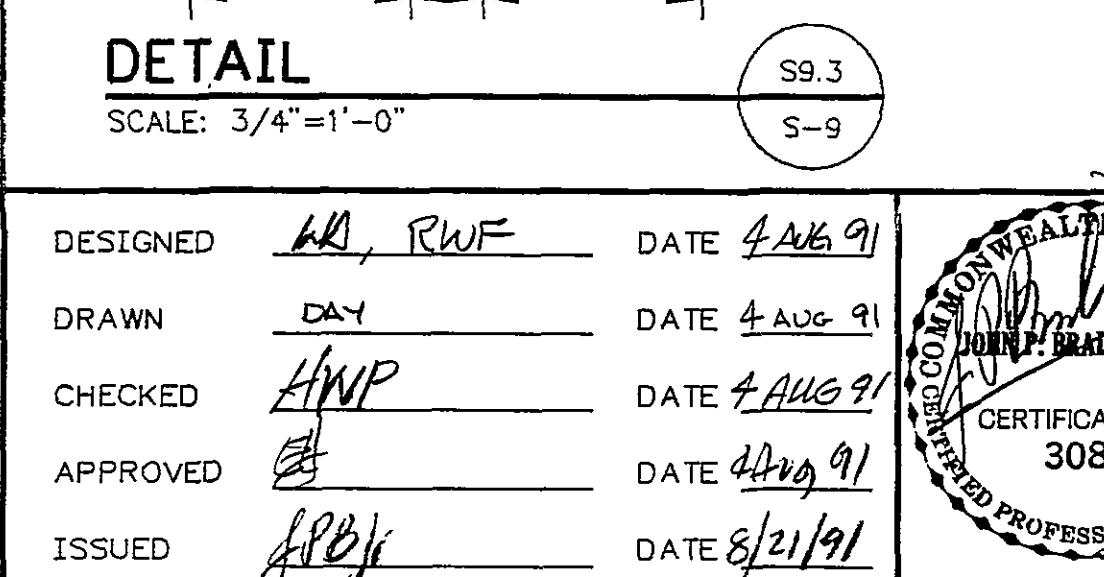
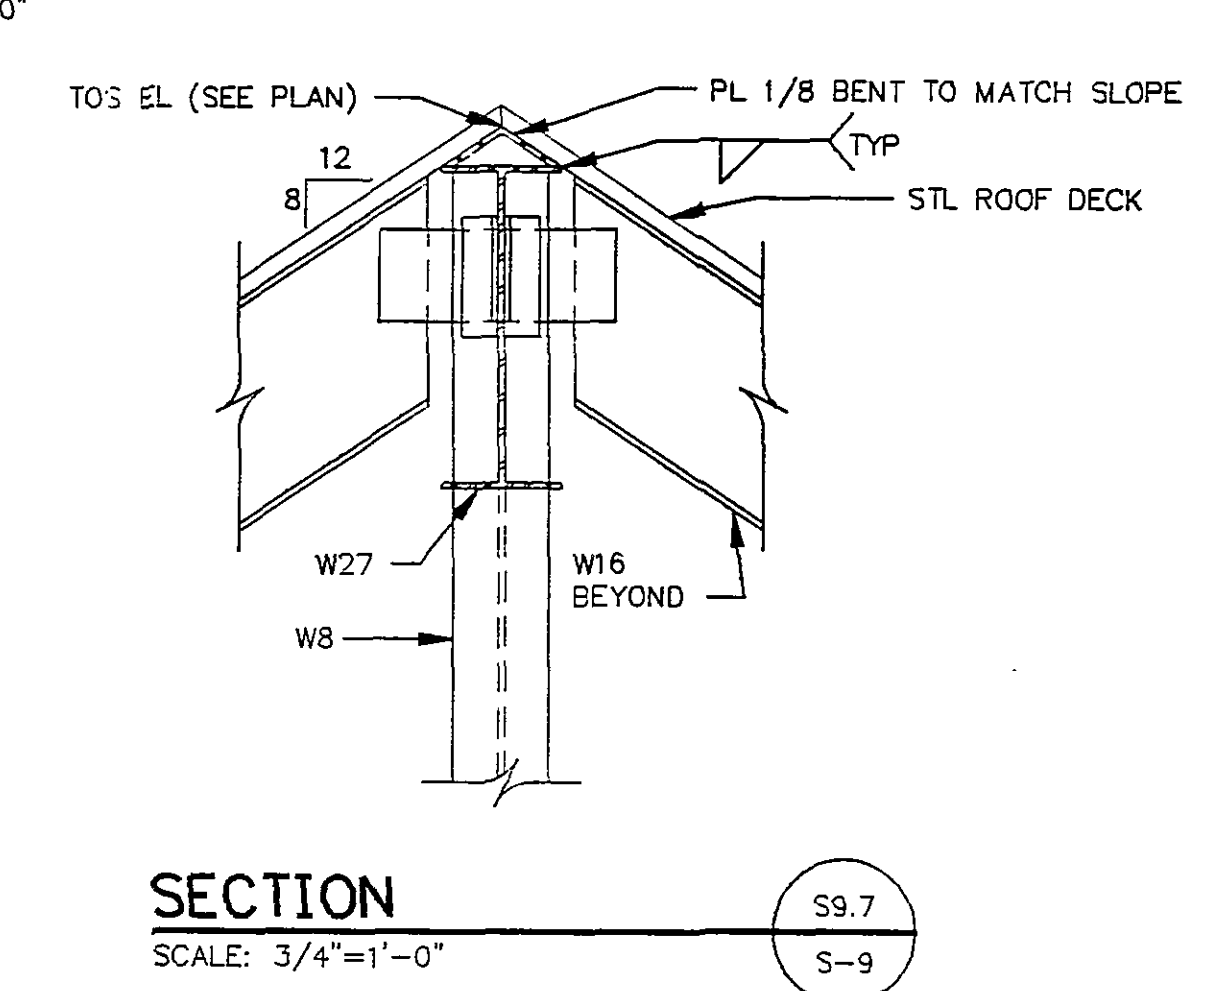
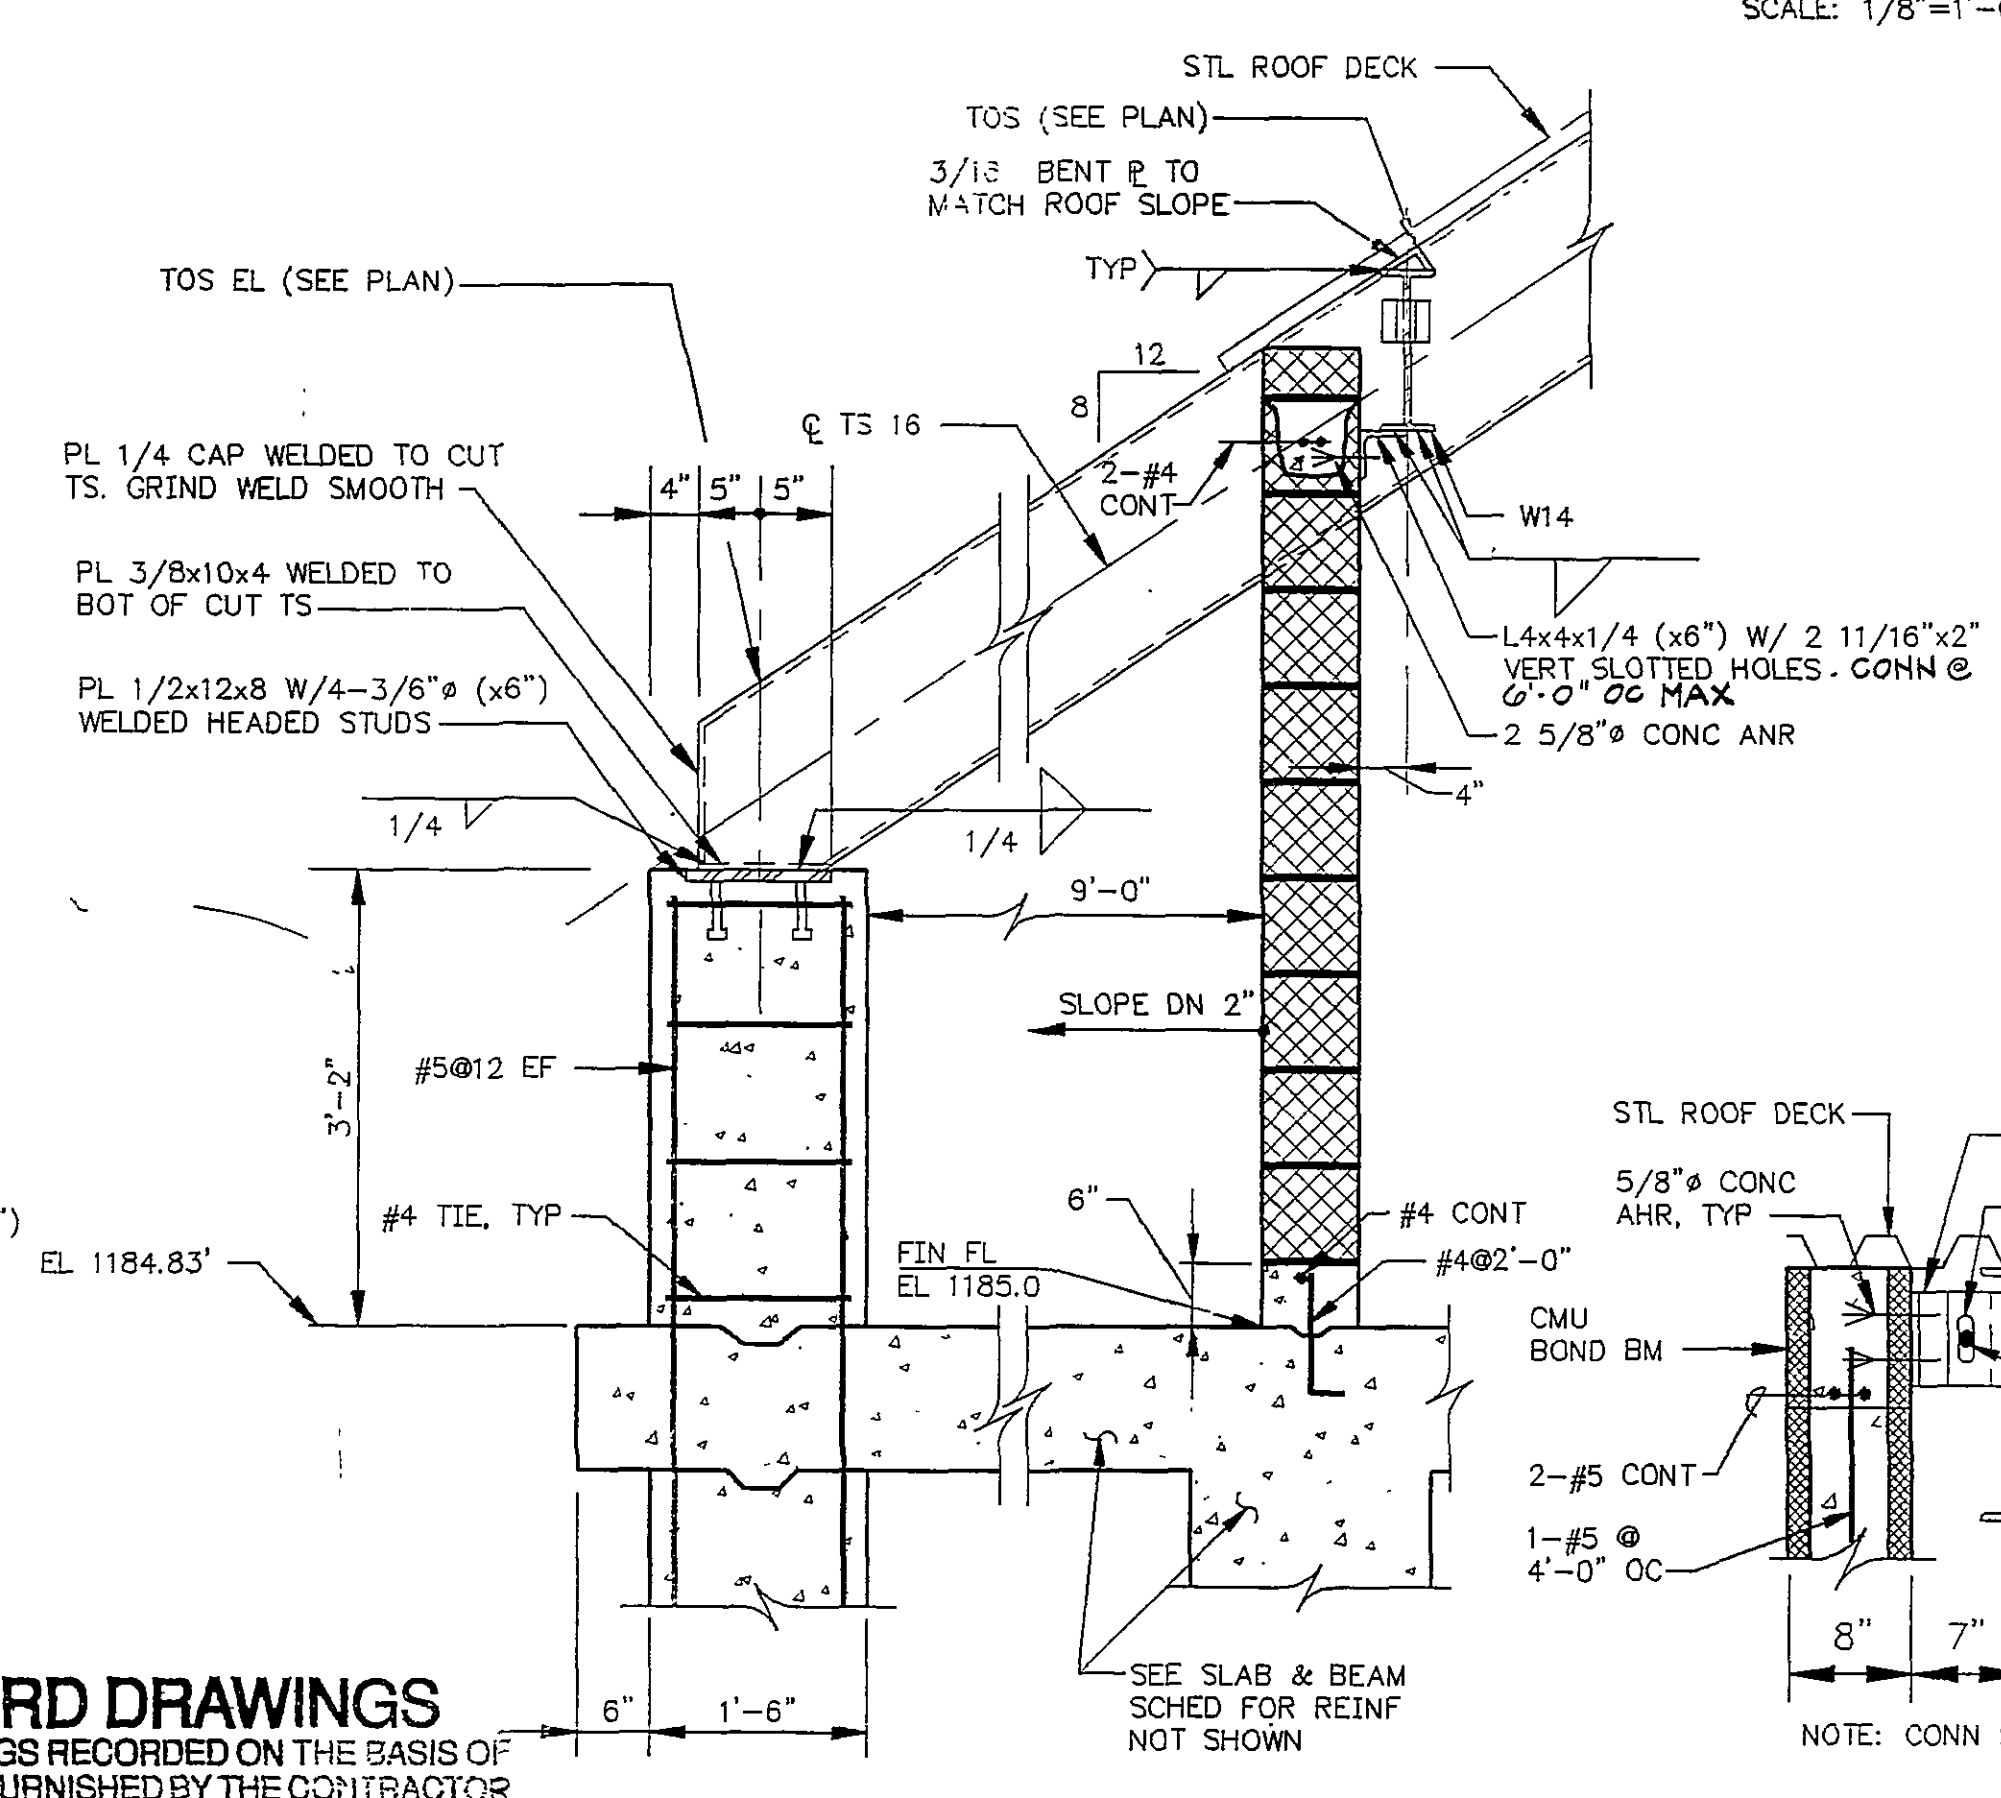
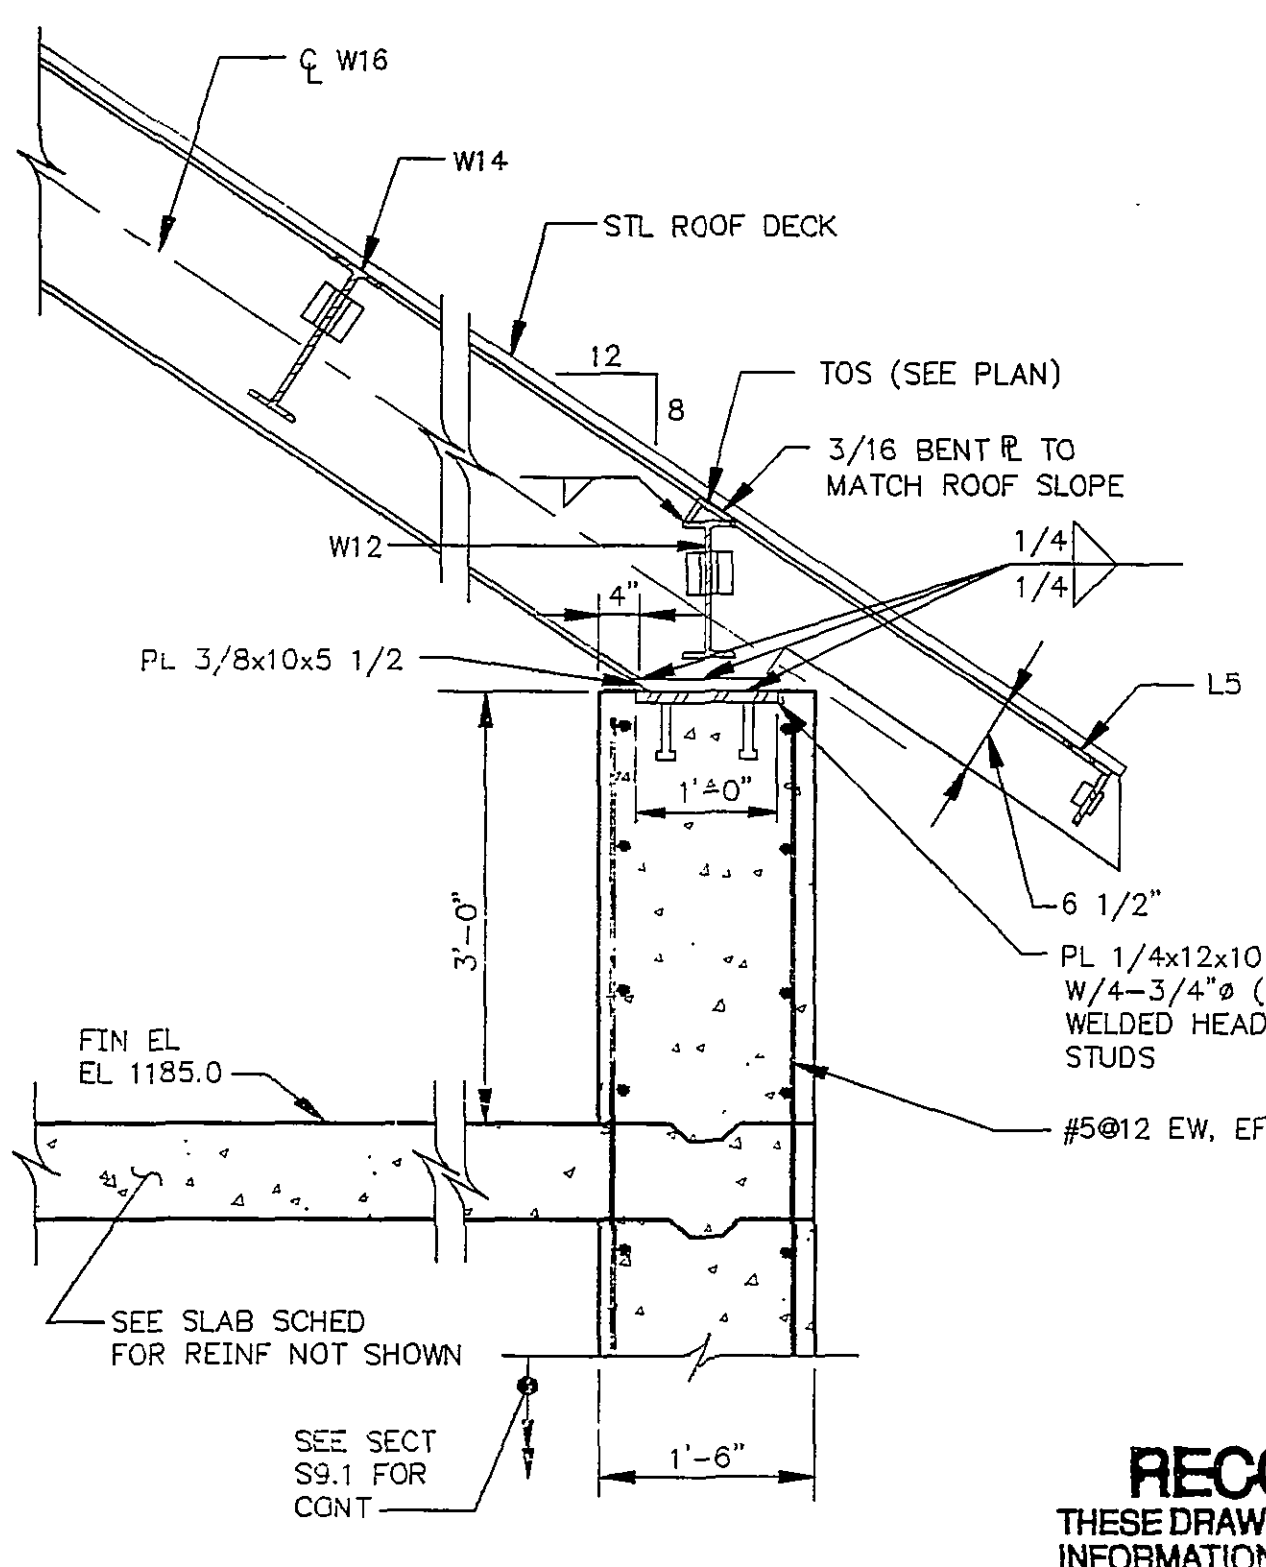
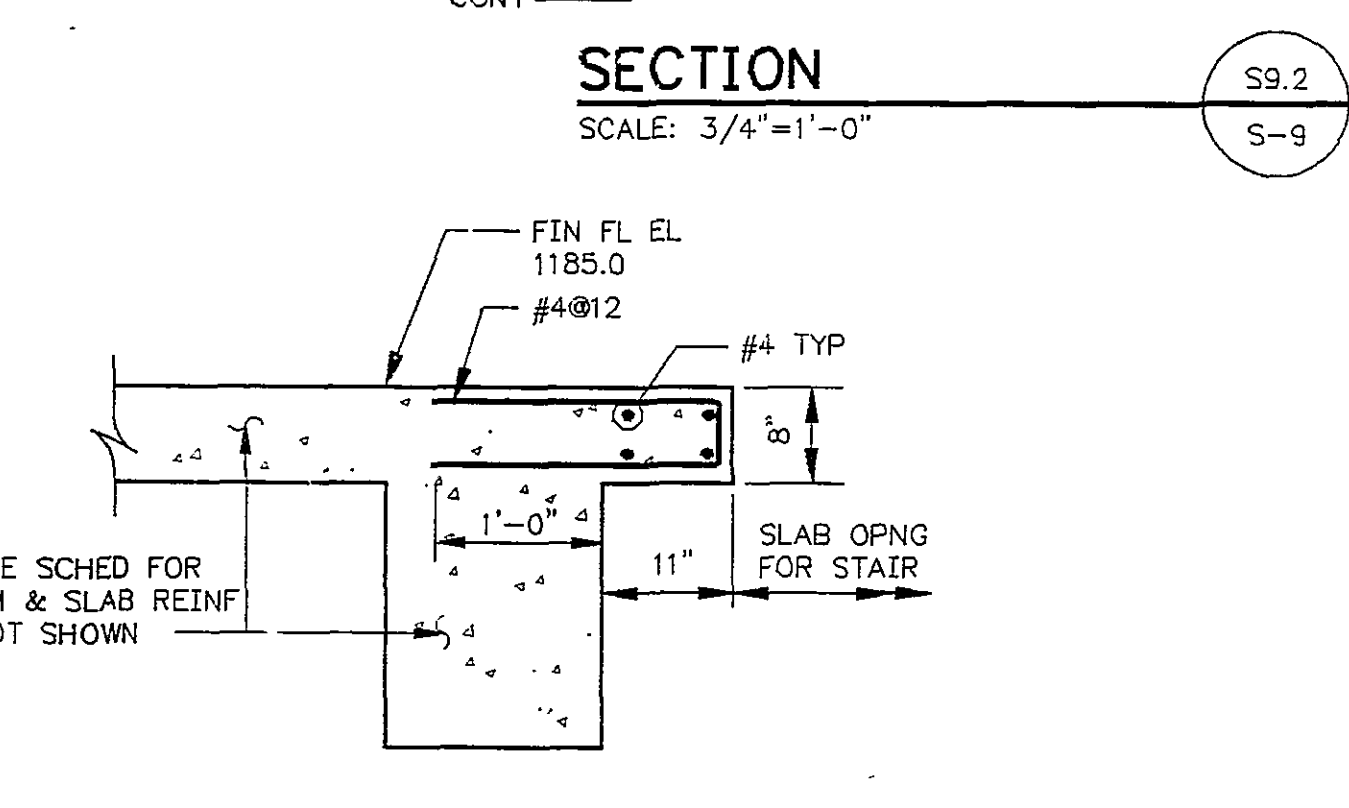
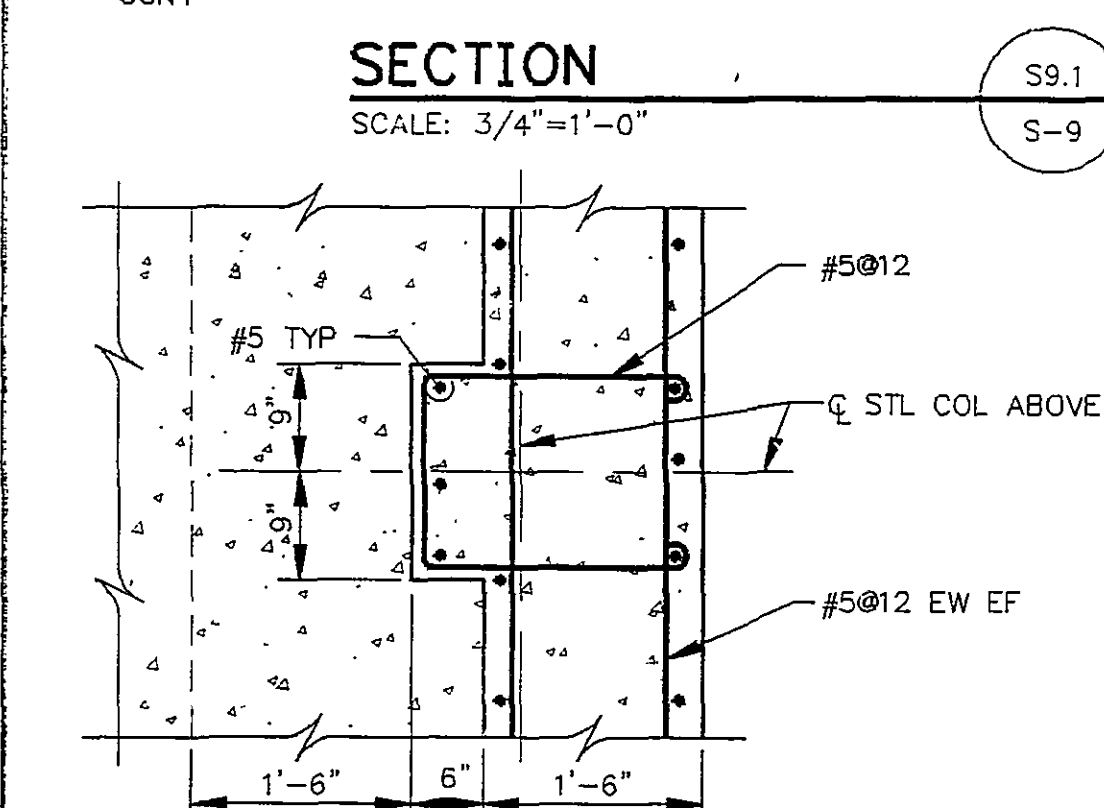
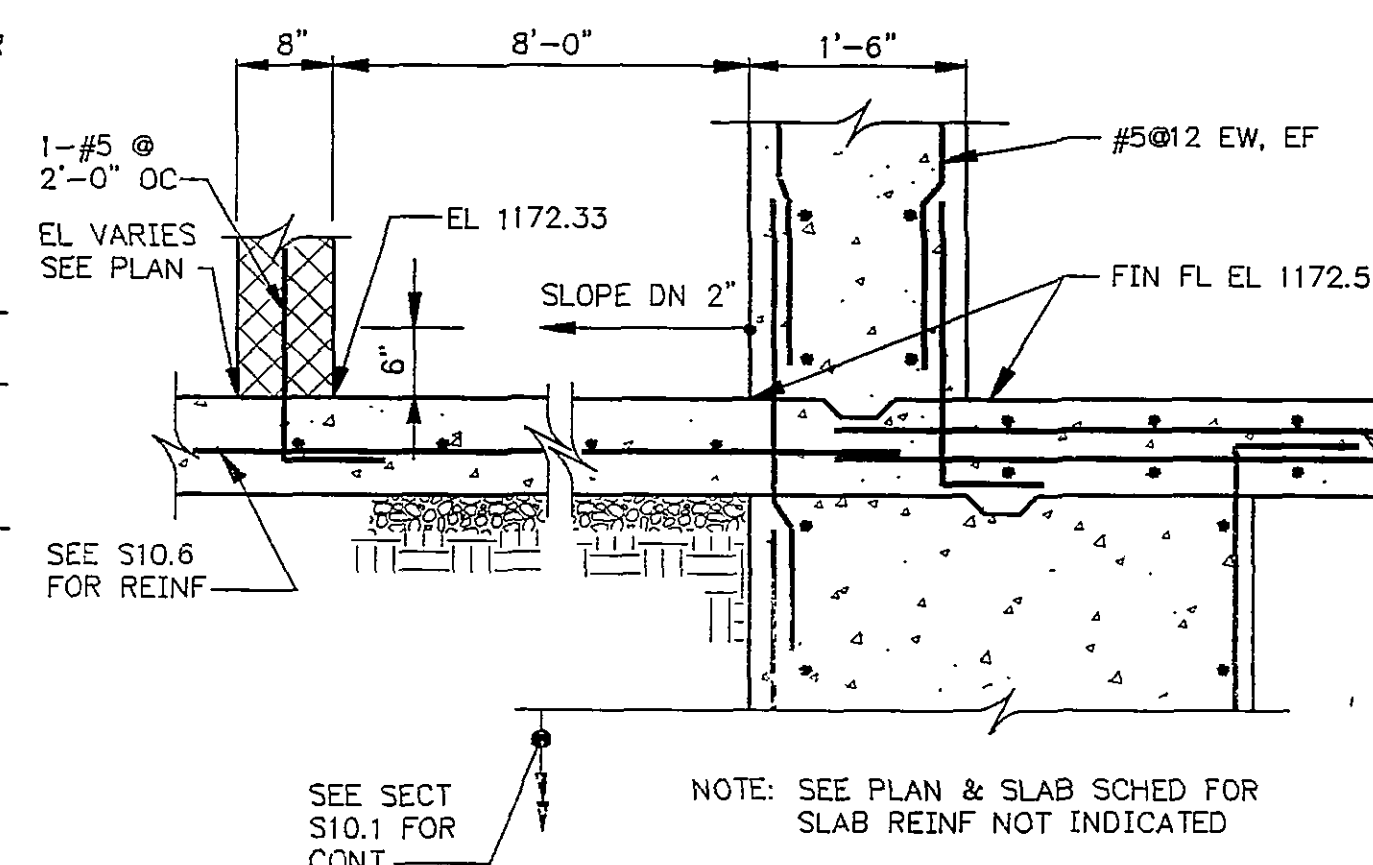
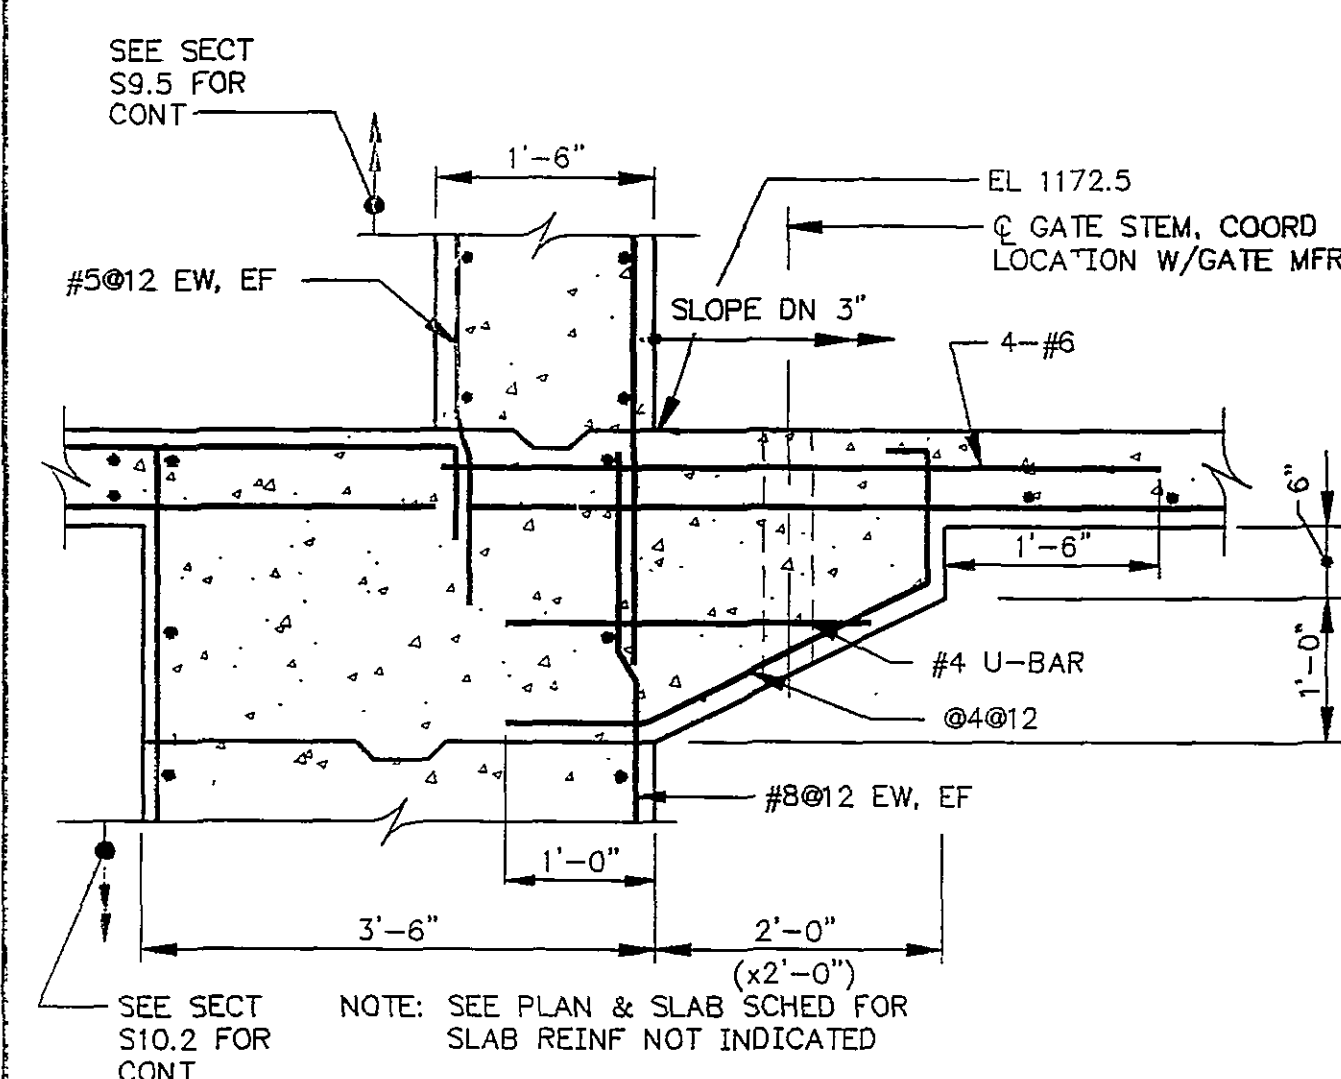
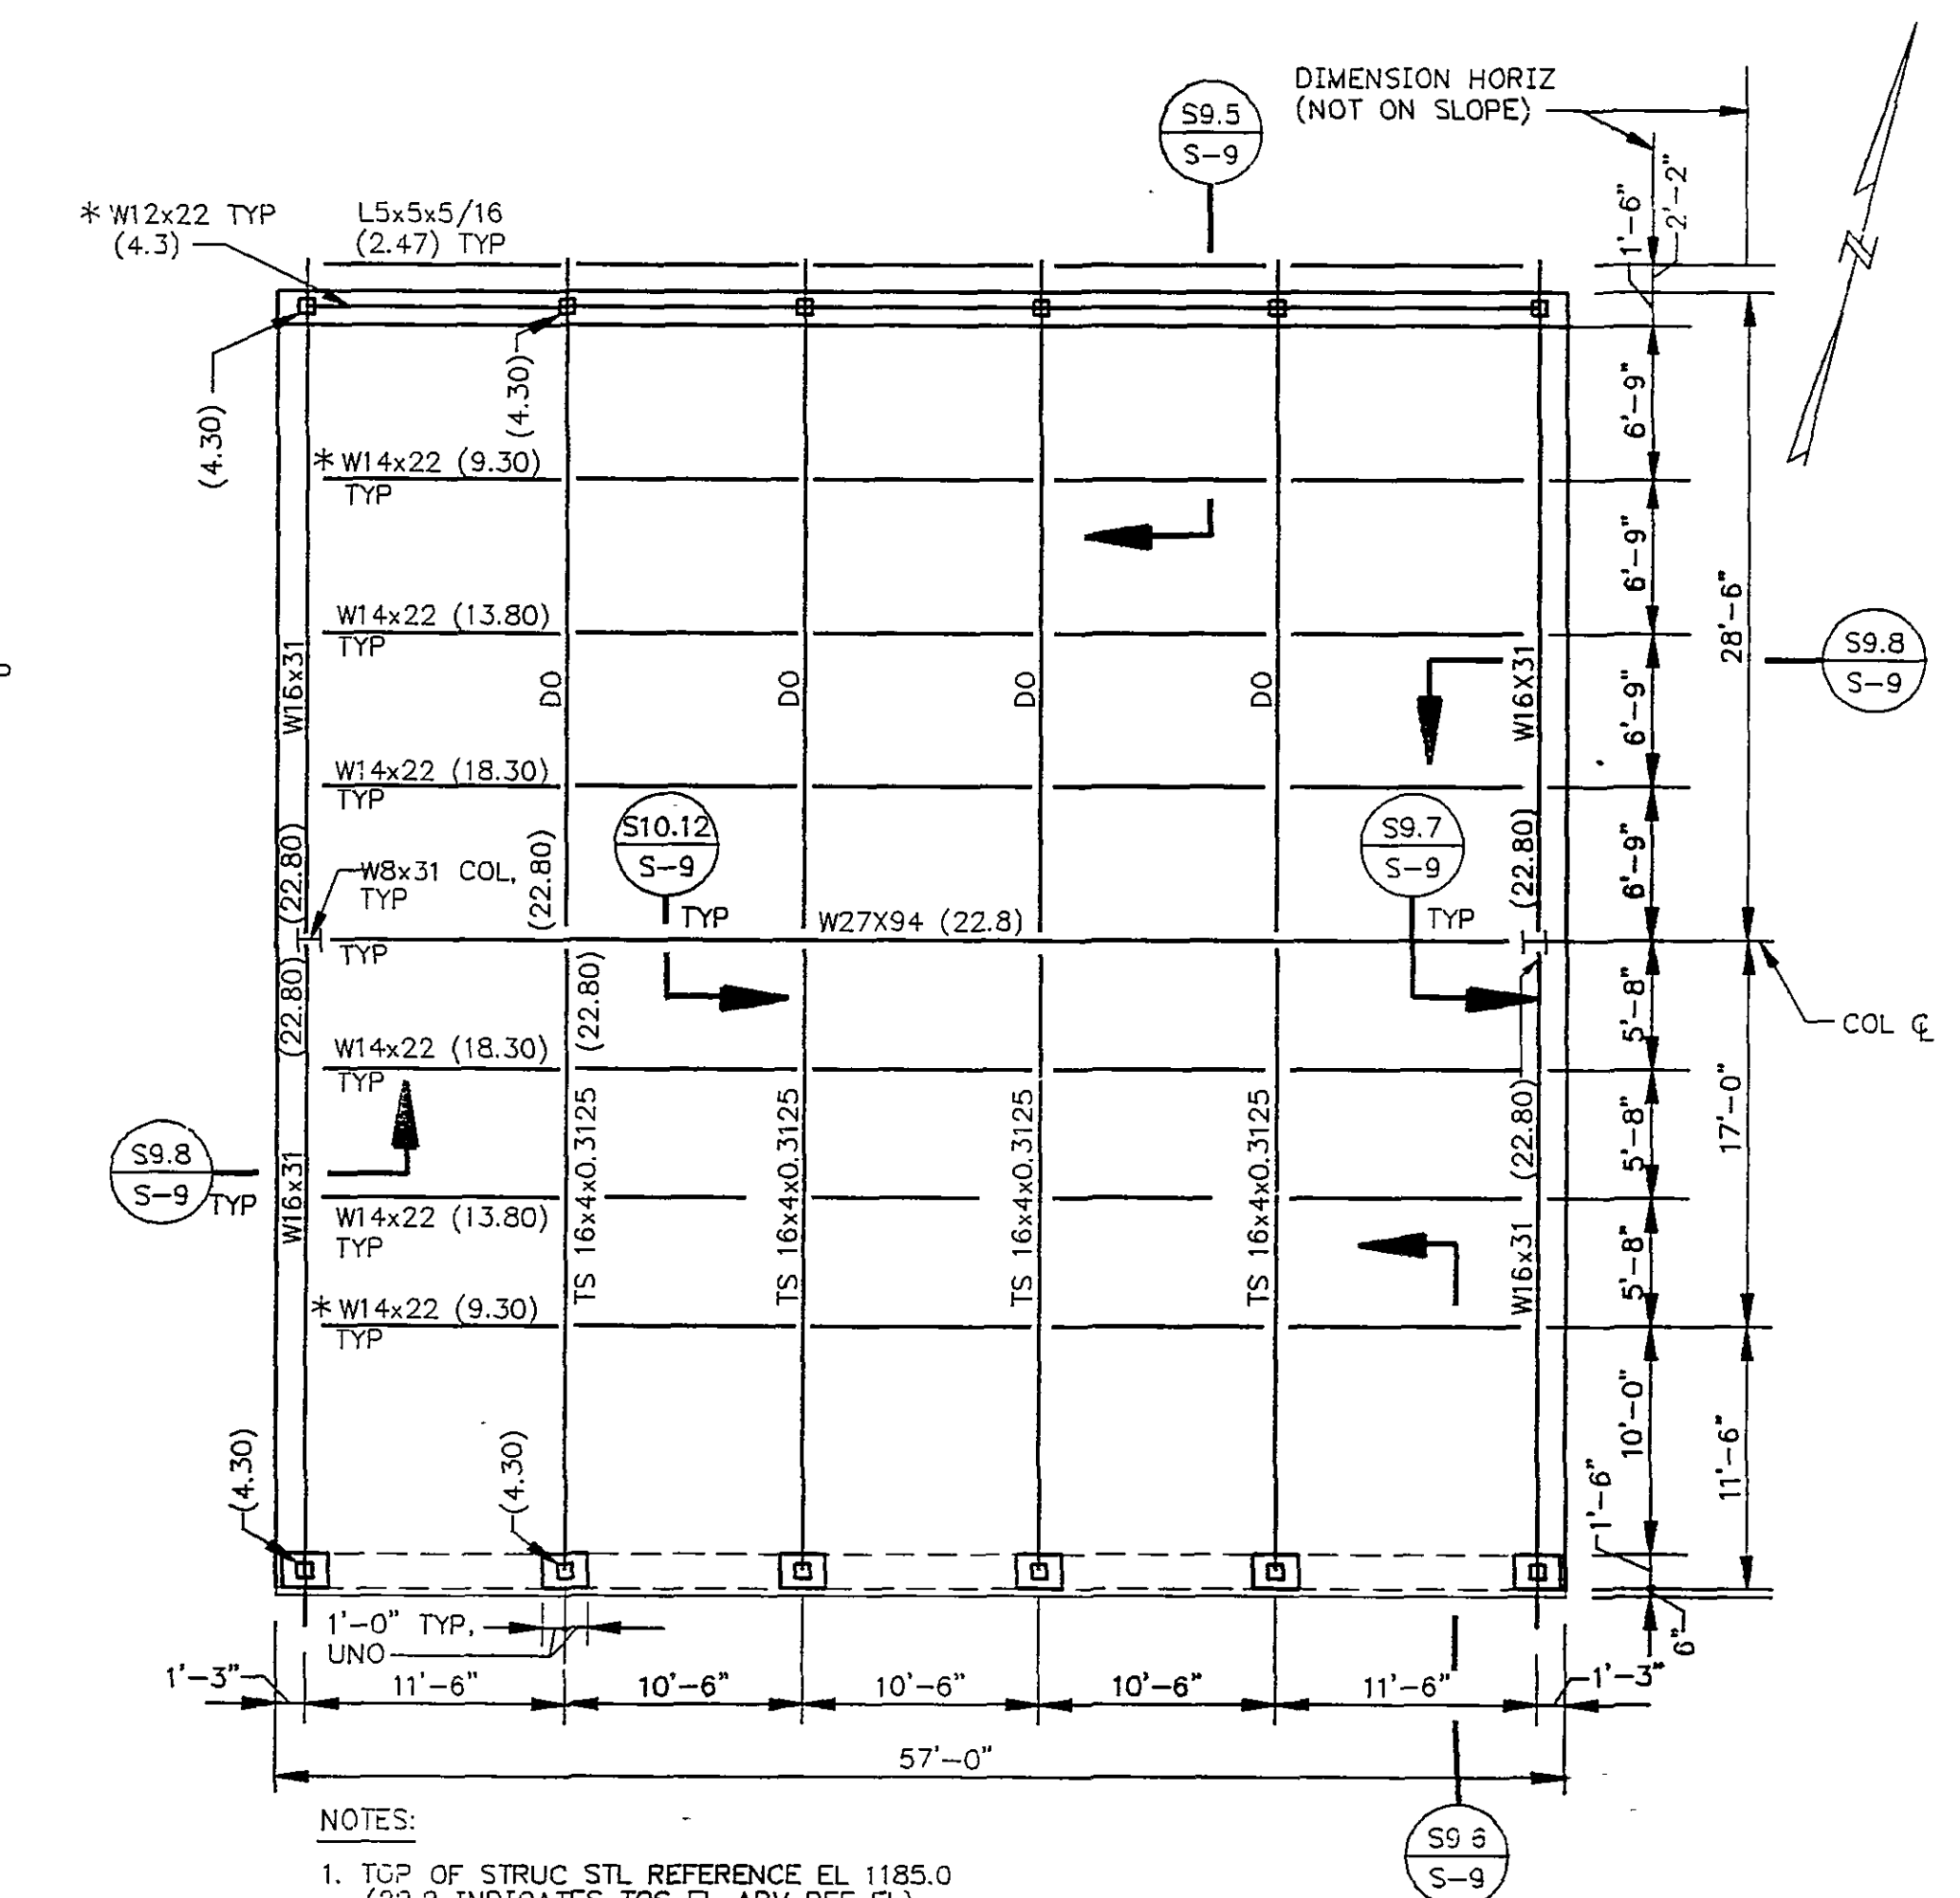
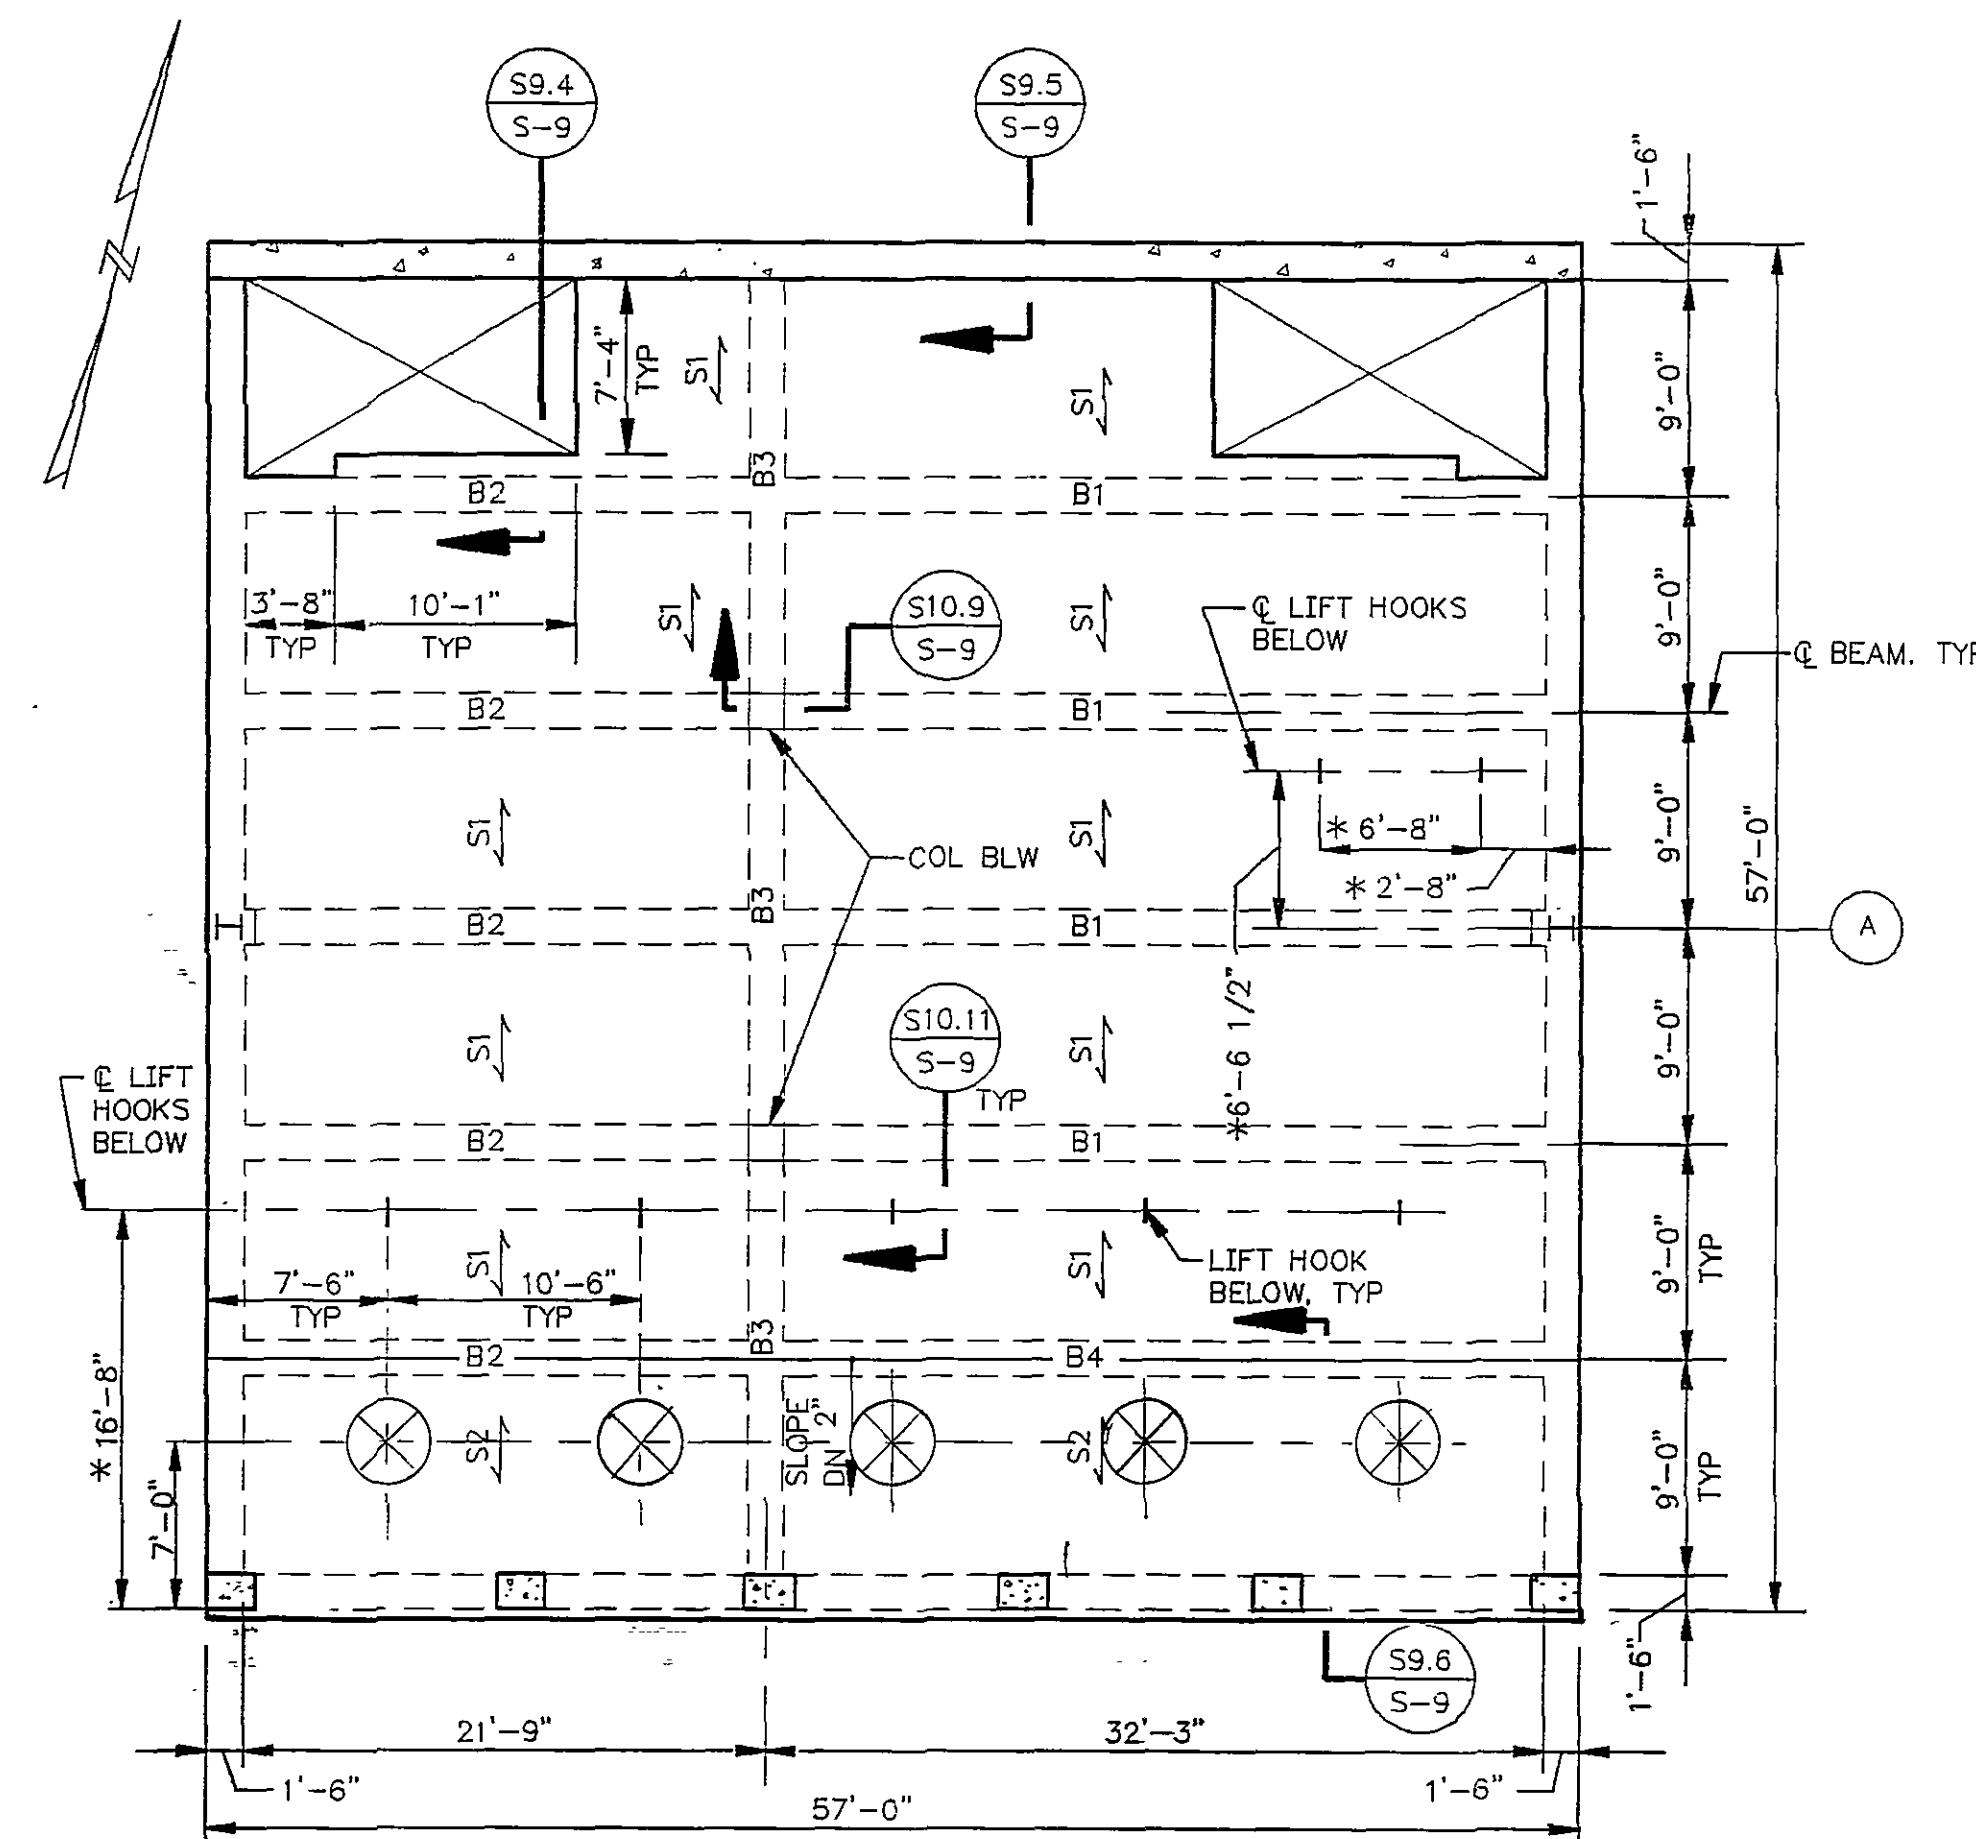


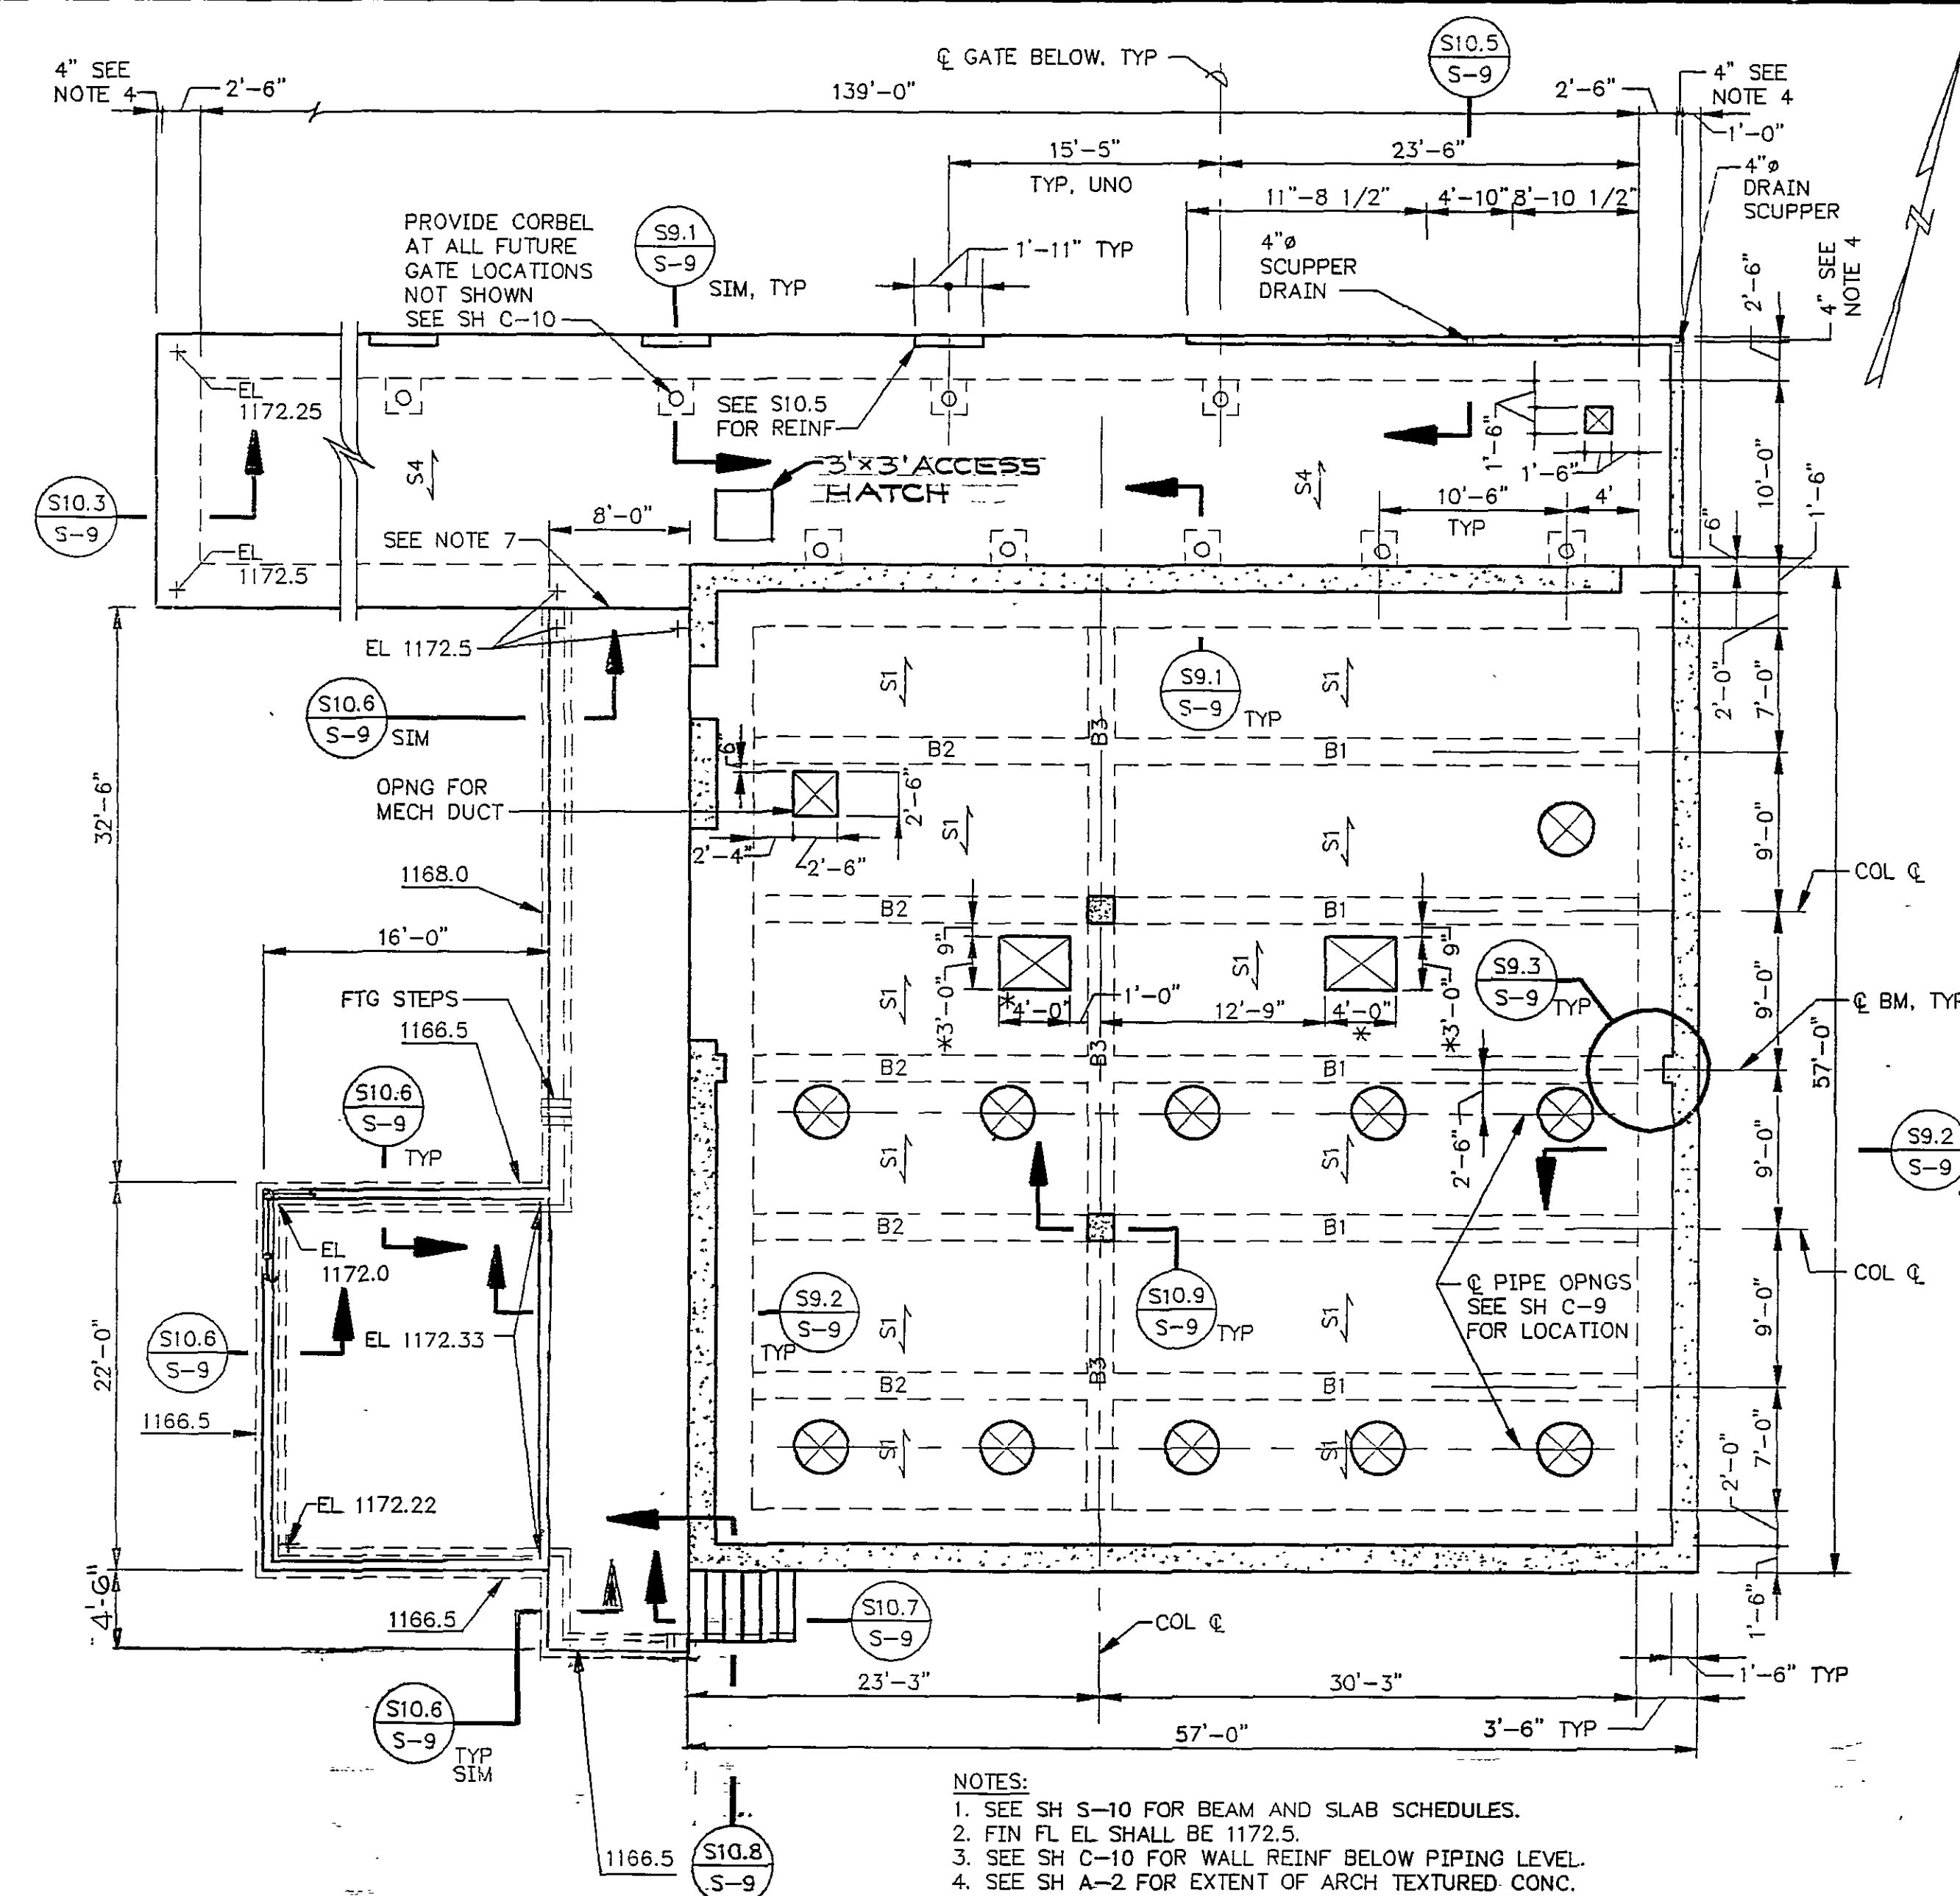

DESIGNED	<u>AK, RWF</u>	DATE	<u>4/26/91</u>		REVISIONS							
DRAWN	<u>DAV</u>	DATE	<u>4/26/91</u>		DATE	BY	DESCRIPTION	DATE	BY	DESCRIPTION		
CHECKED	<u>HWP</u>	DATE	<u>4/26/91</u>		2/15/94	SA	PER CONTR RECORD DWG					
APPROVED	<u>CH</u>	DATE	<u>4/26/91</u>		2/24/95	JBH	ISSUED TO VA DAM SAFETY					
ISSUED	<u>SPB</u>	DATE	<u>8/21/91</u>		5/1/97	RWF	RECORD DRAWING					

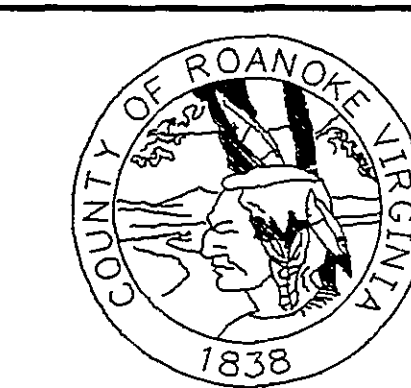

SPRING HOLLOW RESERVOIR
ROANOKE COUNTY, VIRGINIA

HAYES, SEAY, MATTERN & MATTERN, INC.

ARCHITECTS - ENGINEERS - PLANNERS
ROANOKE, VIRGINIA

STRUCTURAL INTAKE/PUMP STATION PLANS AND SECTIONS				
SCALE AS NOTED	DATE 8/4/91	COMM 4194F	SHEET S-9	DWG 13