

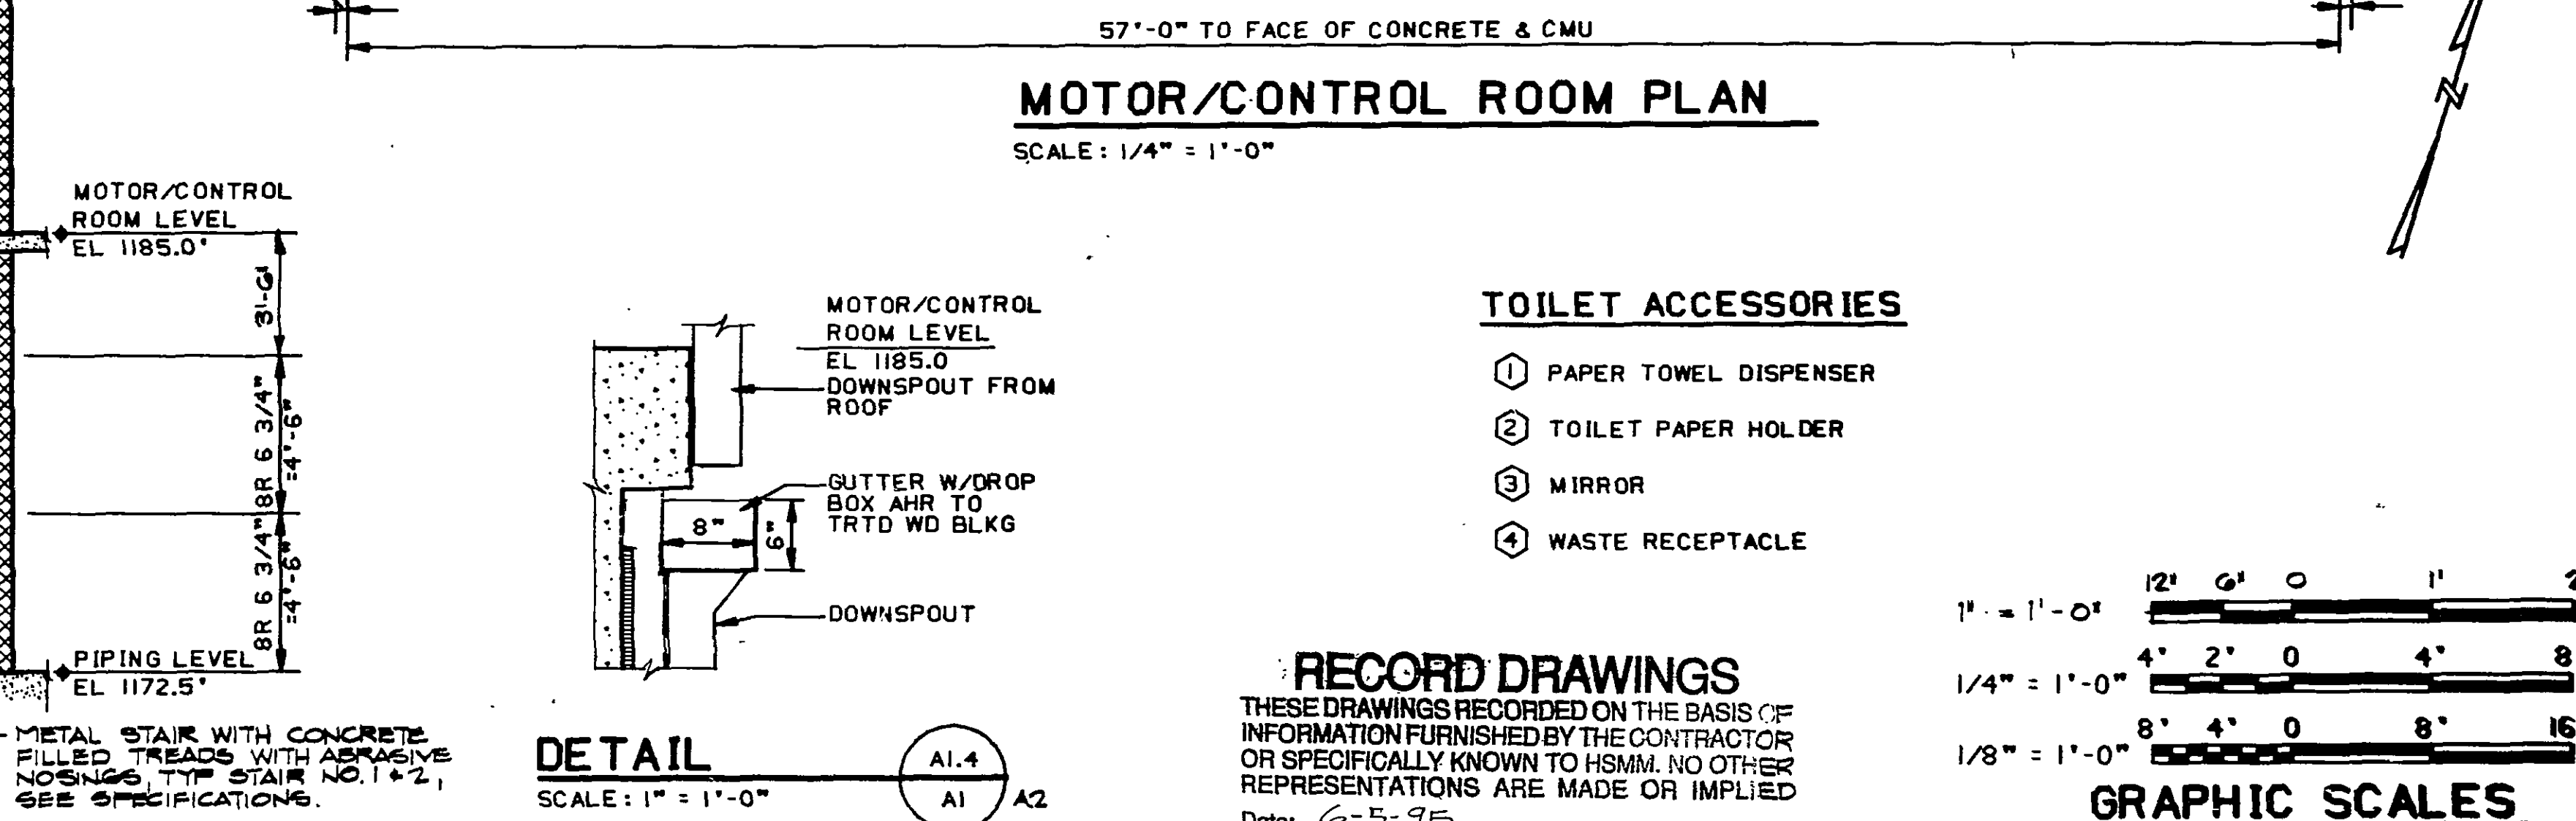
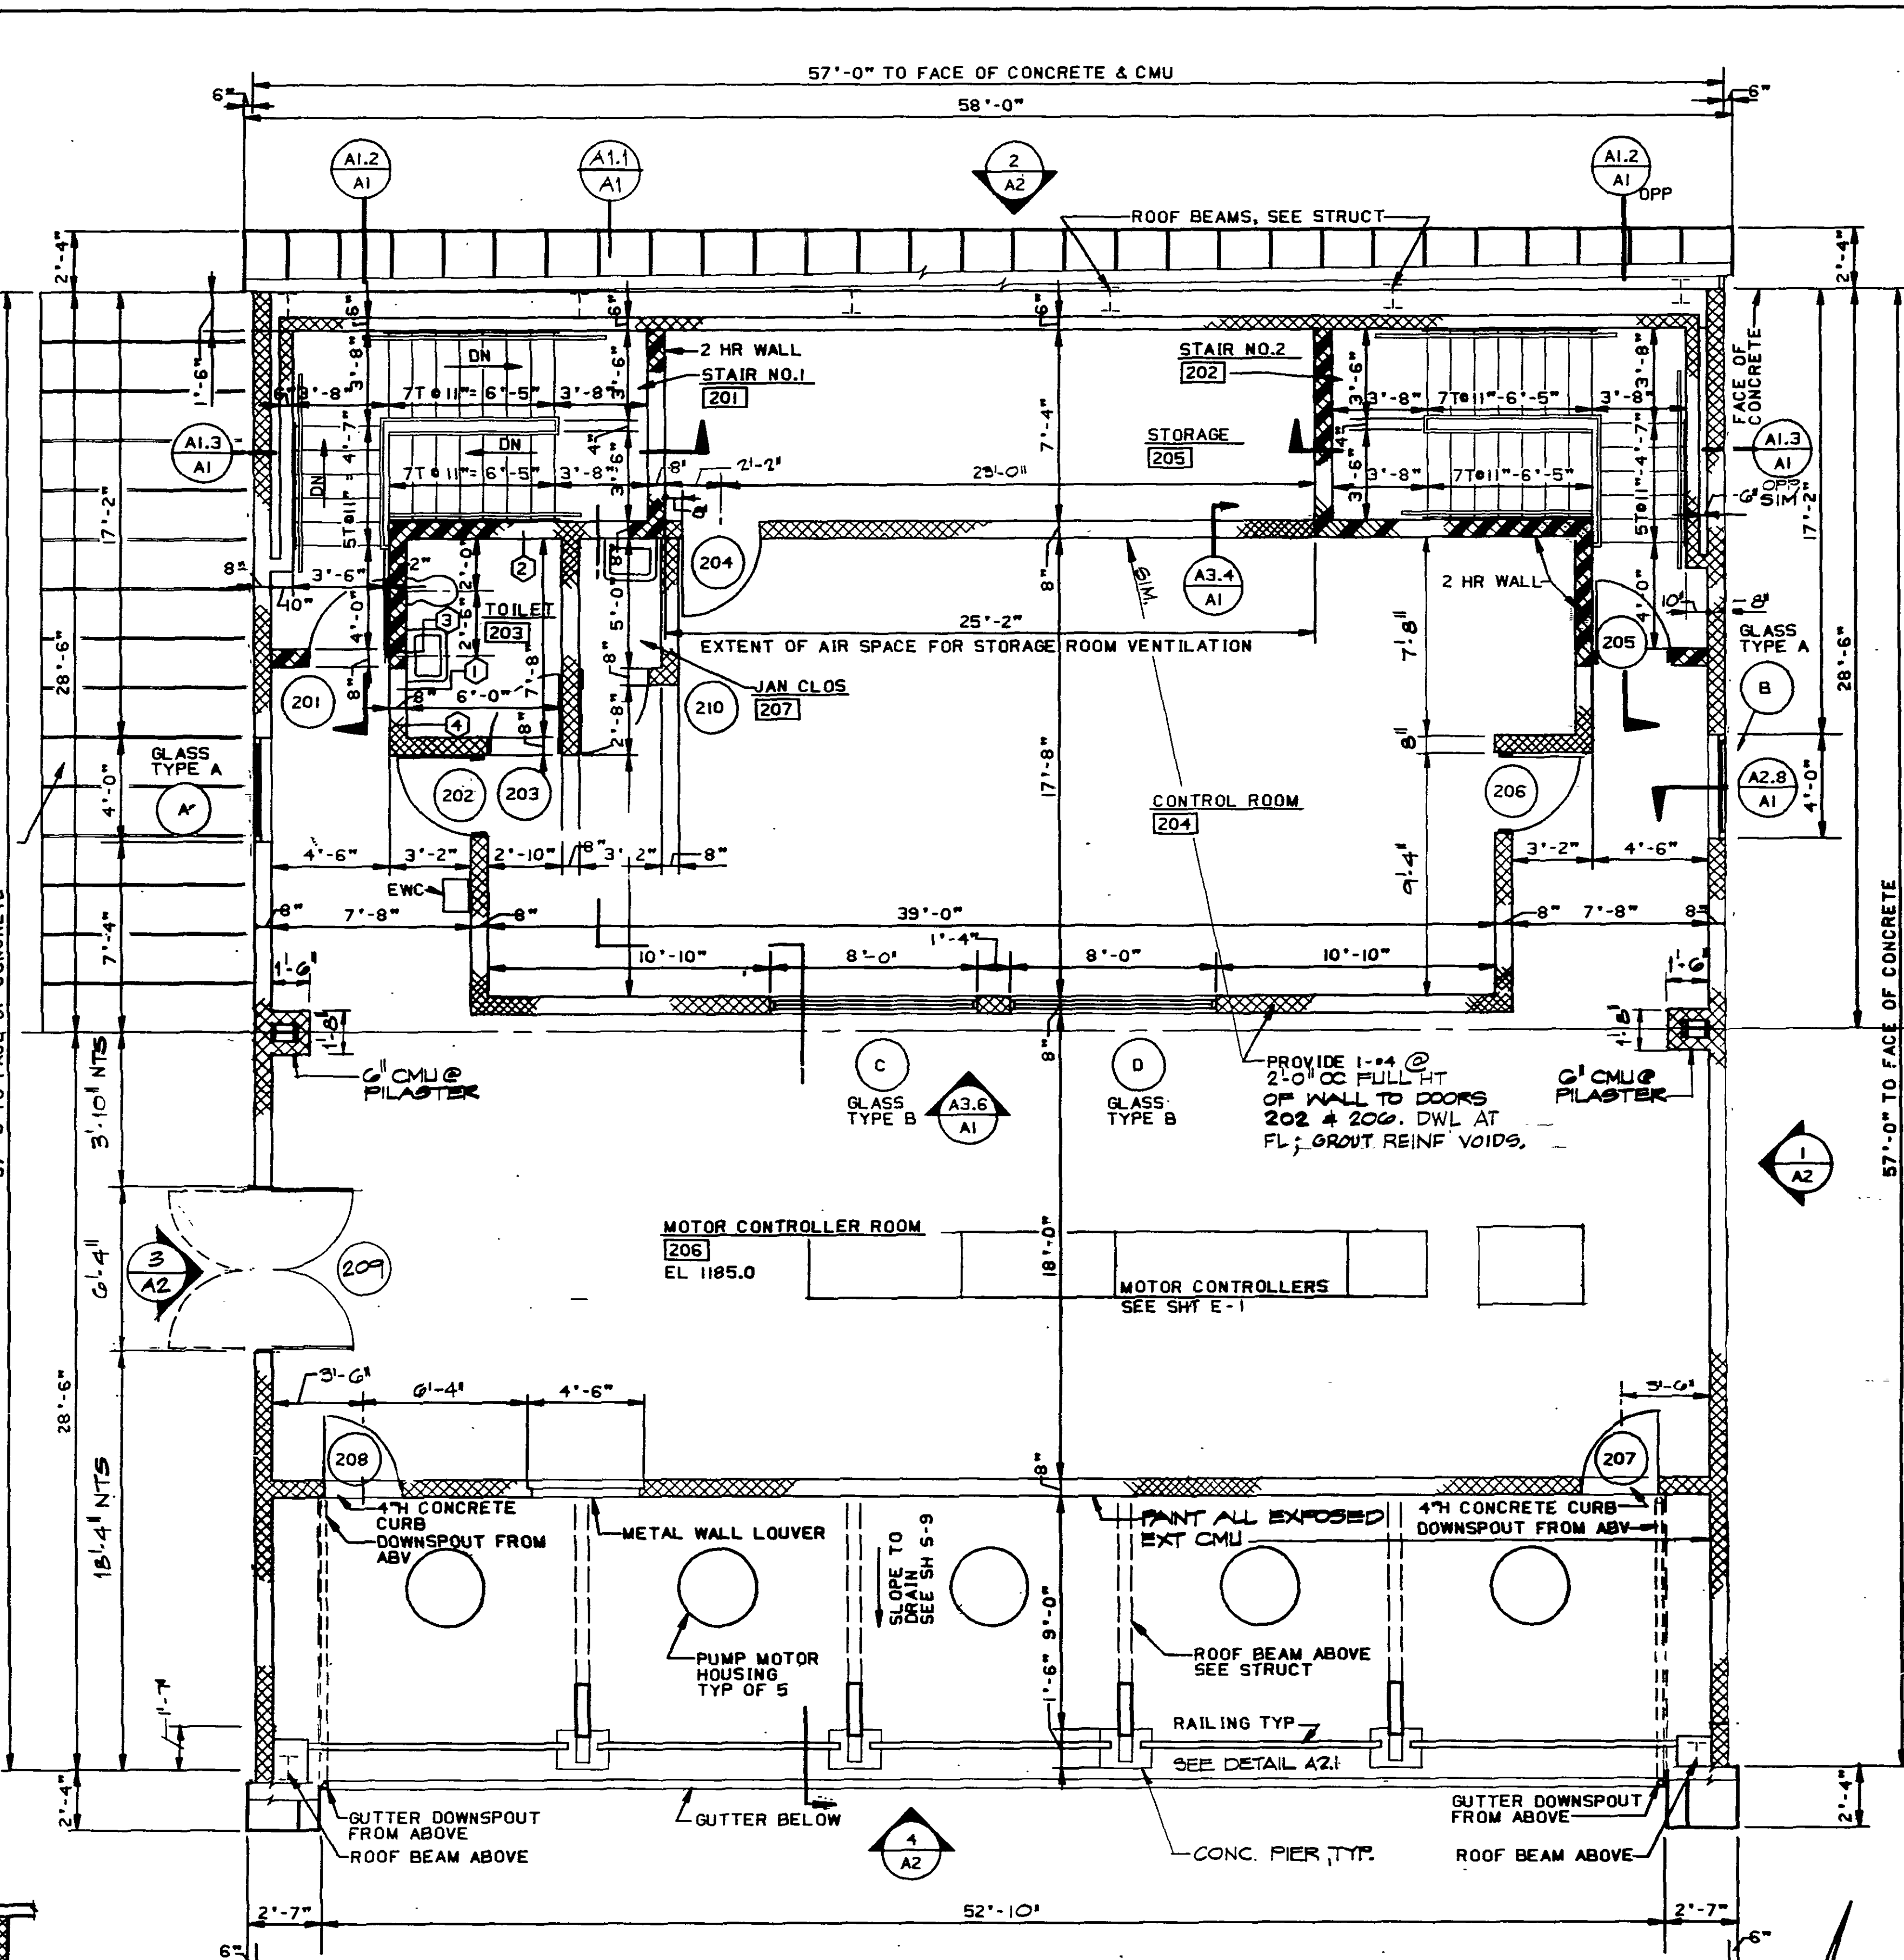
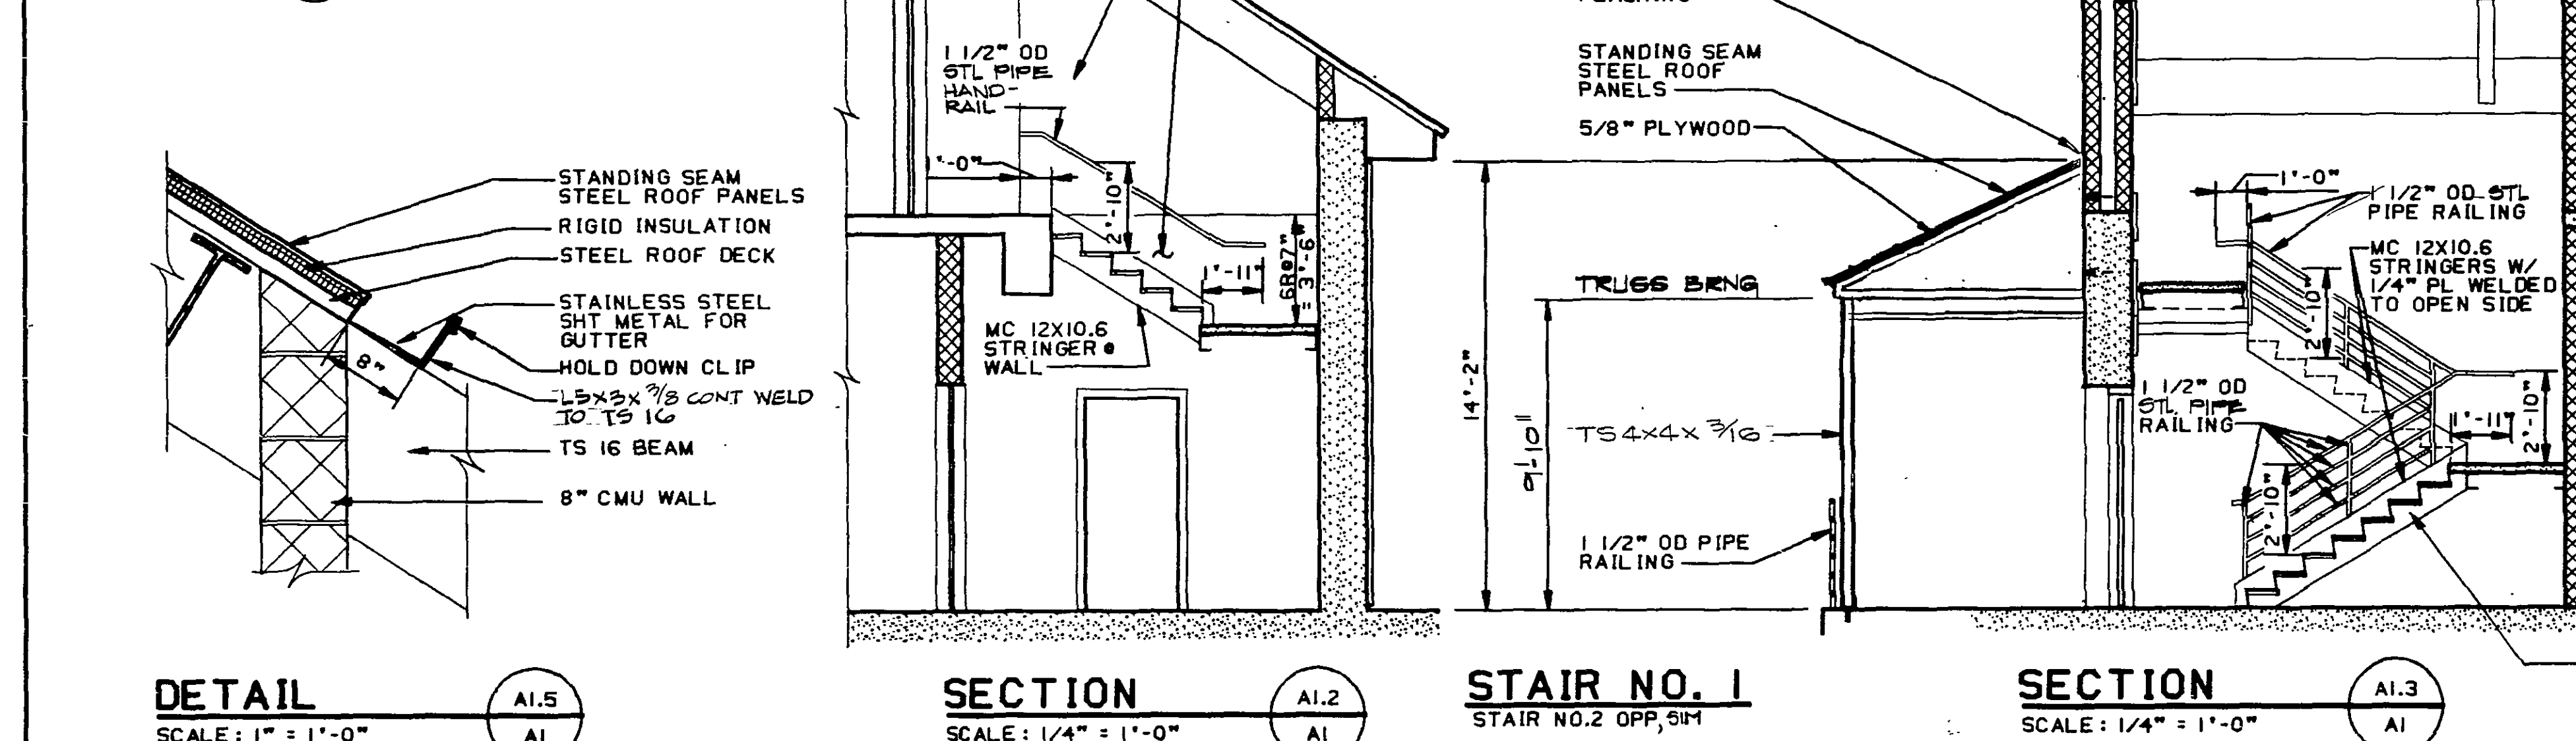
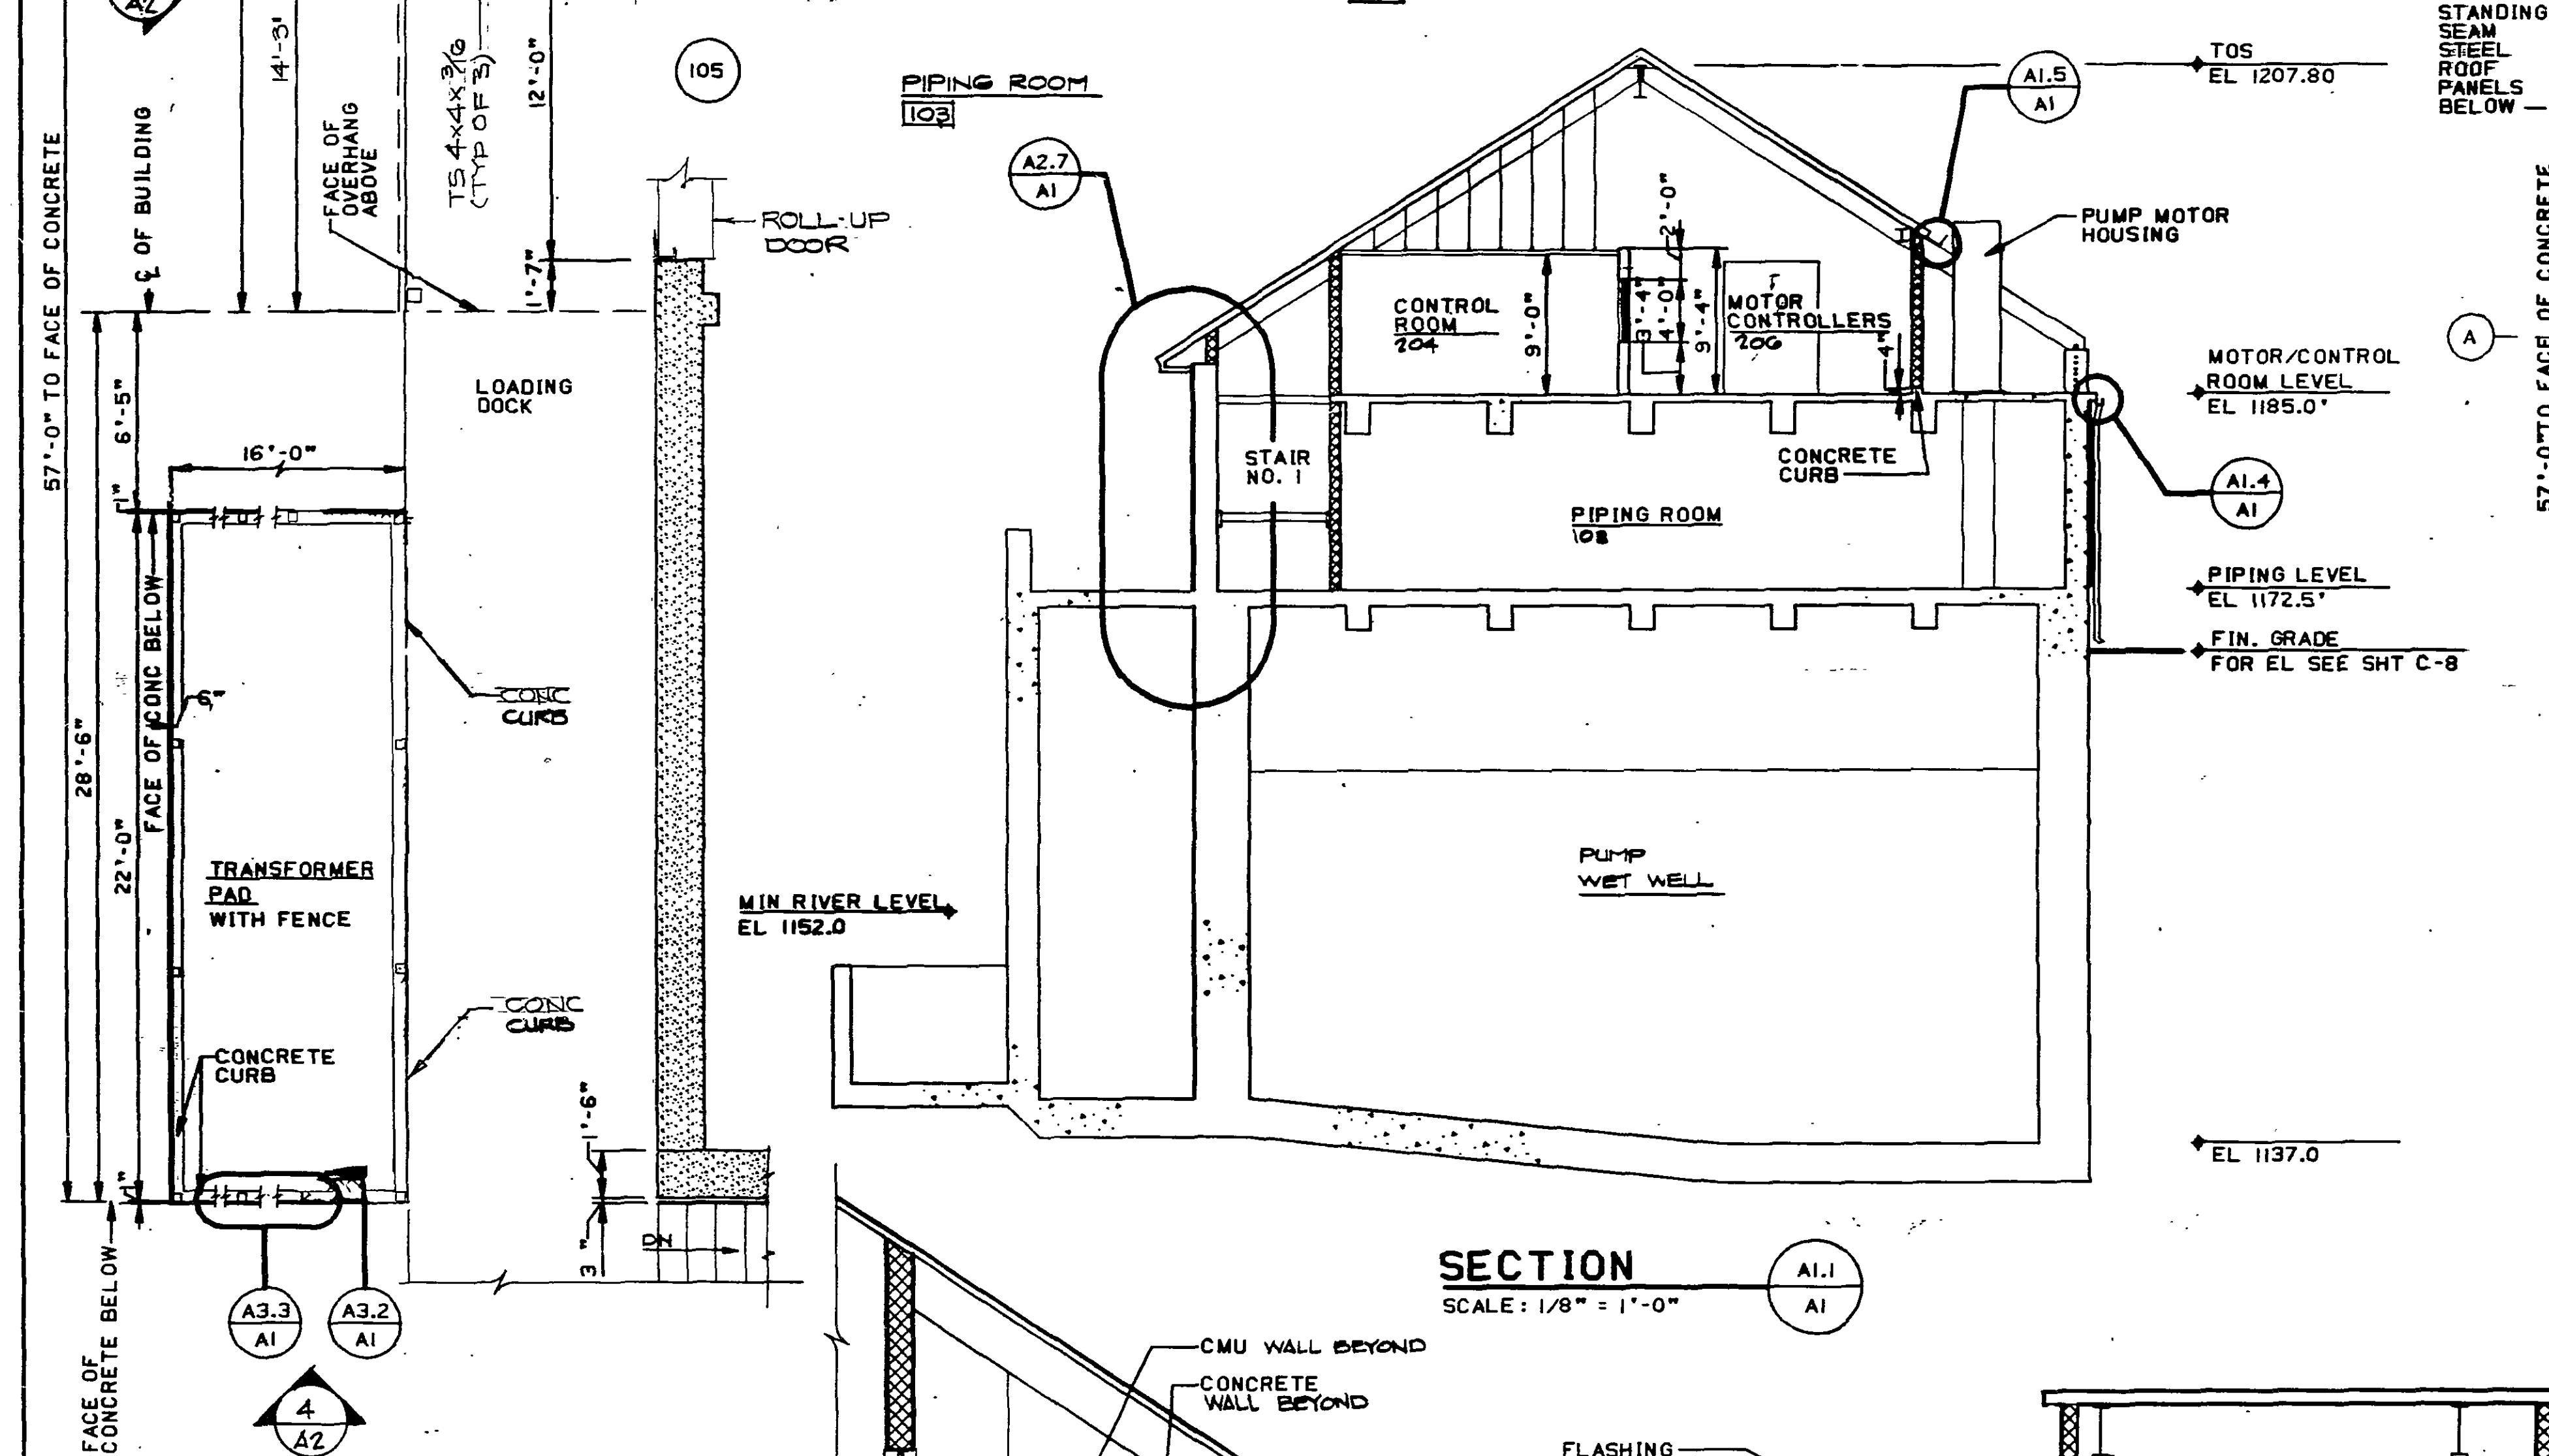


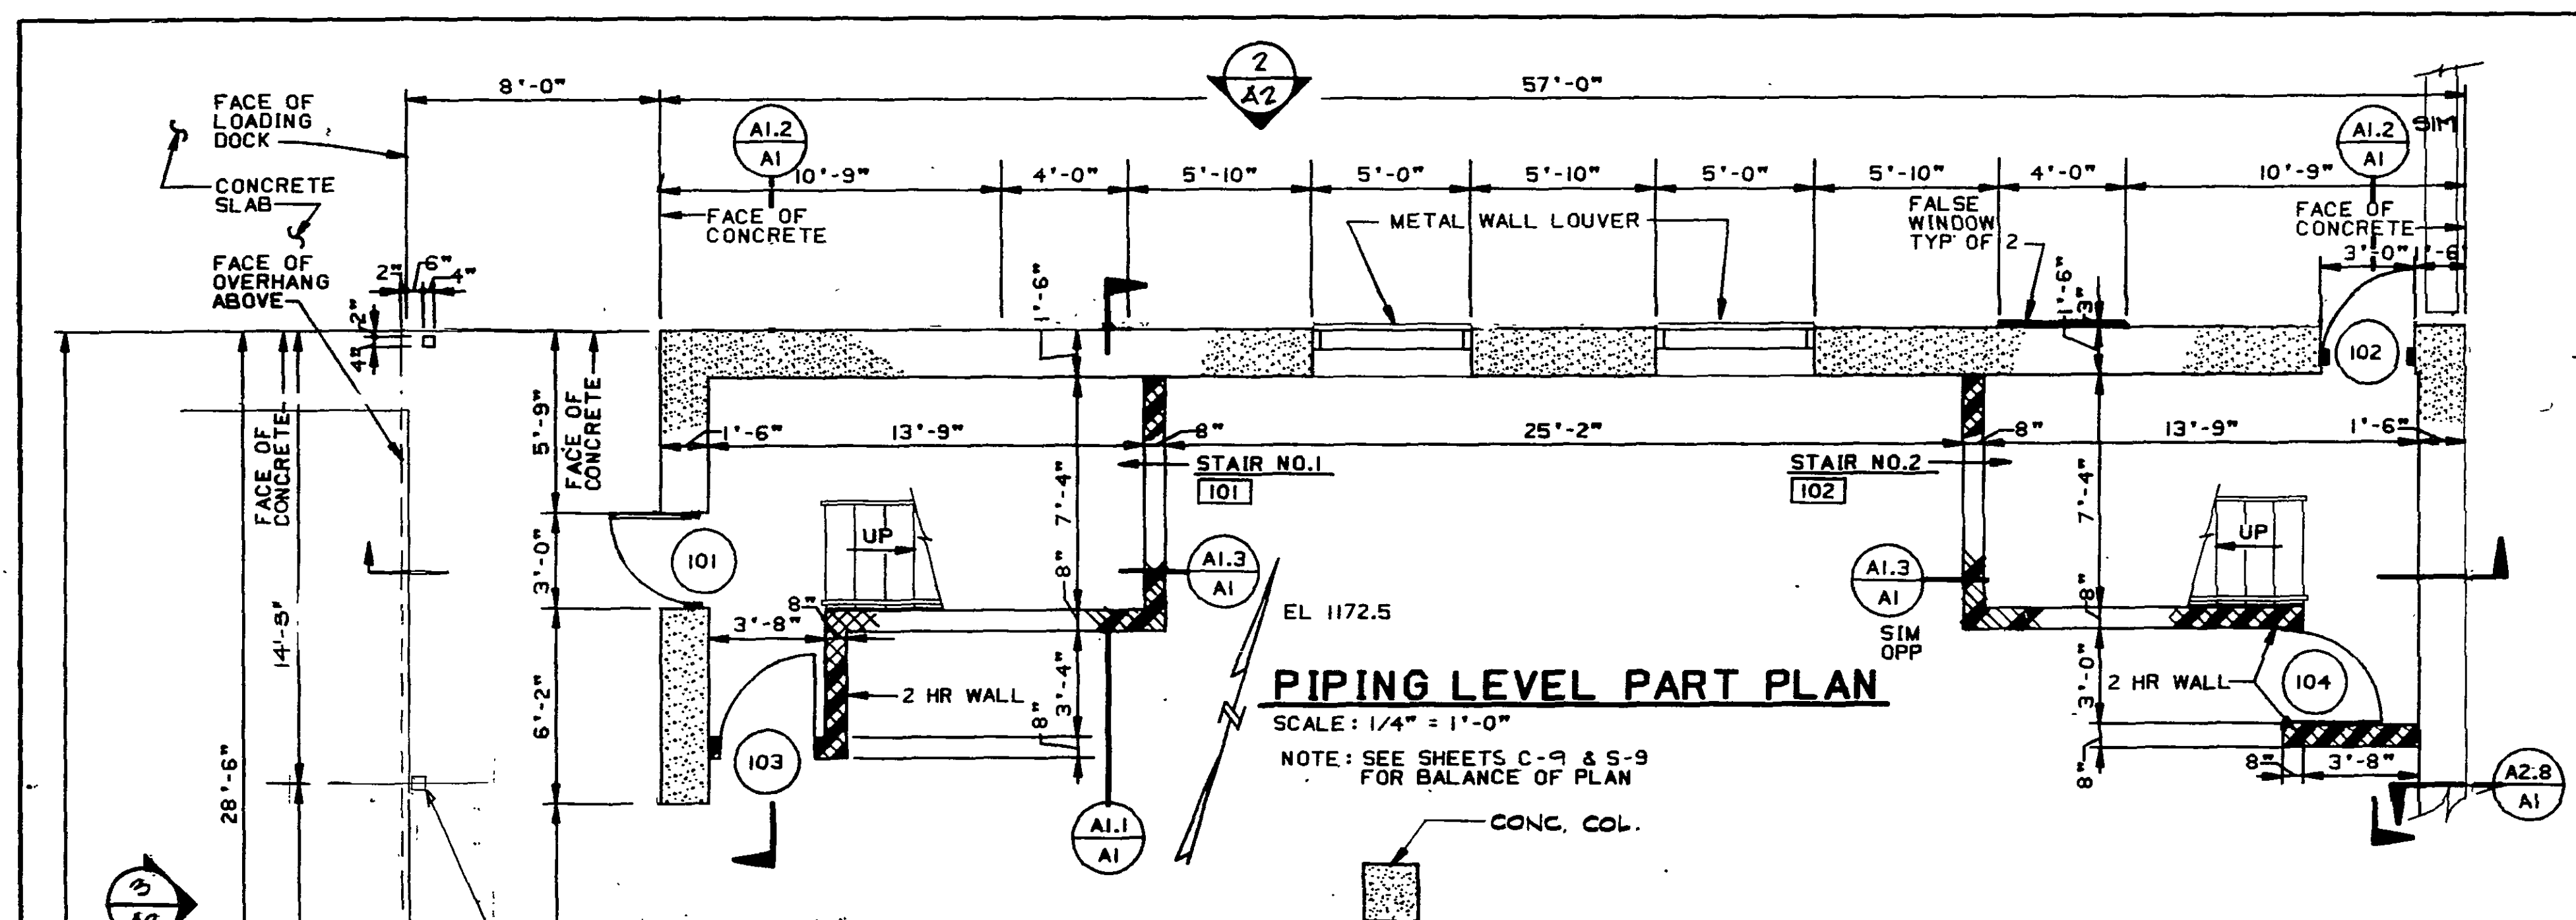

DESIGNED	HG	DATE	8/4/91	REVISIONS	DATE	BY	DESCRIPTION	DATE	BY	DESCRIPTION
DRAWN	LAP	DATE	8/6/91	8-15-91 BA	PER CONTR RECORD DNG					
CHECKED	RBT	DATE	8/6/91	8-25-91 JBH	ISSUED TO VA DAM SAFETY					
APPROVED	SLS	DATE	8/6/91	8-31-91 RVF	RECORD DRAWING					
ISSUED	JPB	DATE	8/21/91							

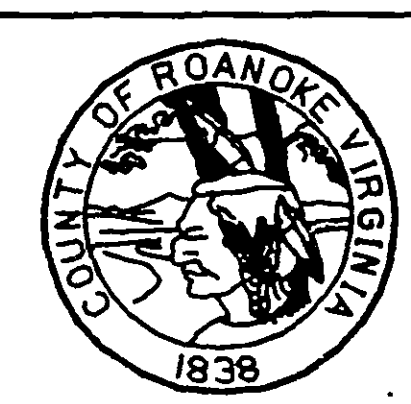

SPRING HOLLOW RESERVOIR
ROANOKE COUNTY, VIRGINIA
HAYES, SEAY, MATTERN & MATTERN, INC.
 ARCHITECTS - ENGINEERS - PLANNERS
 ROANOKE, VIRGINIA

SCALE	DATE	COMM	SHEET	DWG
AS NOTED	8/4/91	4194E	A-1	15