


FINISH SCHEDULE

SPACE NO	SPACE NAME	FLOOR	BASE	WALLS		CEILING			REMARKS
				MATERIAL	FINISH	MATERIAL	FINISH	HEIGHT	
101	STAIR NO. 1	CONC	-	CMU & CONC	PNT	-	PNT	VARIES	
102	STAIR NO. 2	CONC	-	CMU & CONC	PNT	-	PNT	VARIES	
103	PIPING ROOM	CONC	-	CONC	-	-	-	-	
201	STAIR NO. 1	CONC	-	CMU & CONC	PNT	-	PNT	VARIES	
202	STAIR NO. 2	CONC	-	CMU & CONC	PNT	-	PNT	VARIES	
203	TOILET	SV	RBR	CMU	PNT	ACT	PREFIN	9'-0"	3" BATT INSUL ABV
204	CONTROL ROOM	SV	RBR	CMU	PNT	ACT	PREFIN	9'-0"	3" BATT INSUL ABV
205	STORAGE	CONC	-	CMU	PNT	-	-	VARIES	
206	MOTOR CONT ROOM	CONC	-	CMU	PNT	-	-	VARIES	
207	JANITOR CLOSET	SV	RBR	CMU	PNT	ACT	PREFIN	9'-0"	3" BATT INSUL ABV


DOOR SCHEDULE

DOOR										REMARKS
NO	TYPE	MATL	WIDTH	HEIGHT	LOUVER OR UC	GLASS TYPE	TYPE	DEPTH	HEAD	
101	A	HM	2-8	6-8	-	-	I	6	2	1
102	A	HM	2-8	6-8	-	-	I	6	2	1
103	A	HM	2-8	6-8	-	-	I	8 3/4	1	1 1/2 HR
104	A	HM	2-8	6-8	-	-	I	8 3/4	1	1 1/2 HR
105	X	MTL	13-0	8-2	-	-	X	X	X	3 X ROLL-UP OVERHEAD DOOR
106	A	HM	2-8	6-8	-	-	I	8 3/4	1	7 3/4 HR
107	A	HM	2-8	6-8	-	-	I	8 3/4	1	7 3/4 HR
201	A	HM	2-8	6-8	-	-	I	8 3/4	1	1 1/2 HR
202	A	HM	2-8	6-8	-	-	I	8 3/4	1	6
203	A	HM	2-6	6-8	-	-	I	8 3/4	1	6
204	A	HM	2-8	6-8	-	-	I	8 3/4	1	6
205	A	HM	2-8	6-8	-	-	I	8 3/4	1	1 1/2 HR
206	A	HM	2-8	6-8	-	-	I	8 3/4	1	6
207	A	HM	2-8	6-8	-	-	I	8 3/4	1	7A
208	A	HM	2-8	6-8	-	-	I	8 3/4	1	7A
209	B	HM	6-0	9-0	-	-	2	8	3	8
210	A	HM	2-8	6-8	LOUVER	-	I	8 3/4	1	6
301	A	HM	2-8	6-8	LOUVER	-	I	8	2 5/8	11 SEE PLAN DETAIL S&S FOR LOCATION
302	A	HM	2-8	6-8	LOUVER	-	I	8	2 5/8	11 SEE PLAN DETAIL S&S FOR LOCATION

DOOR TYPES

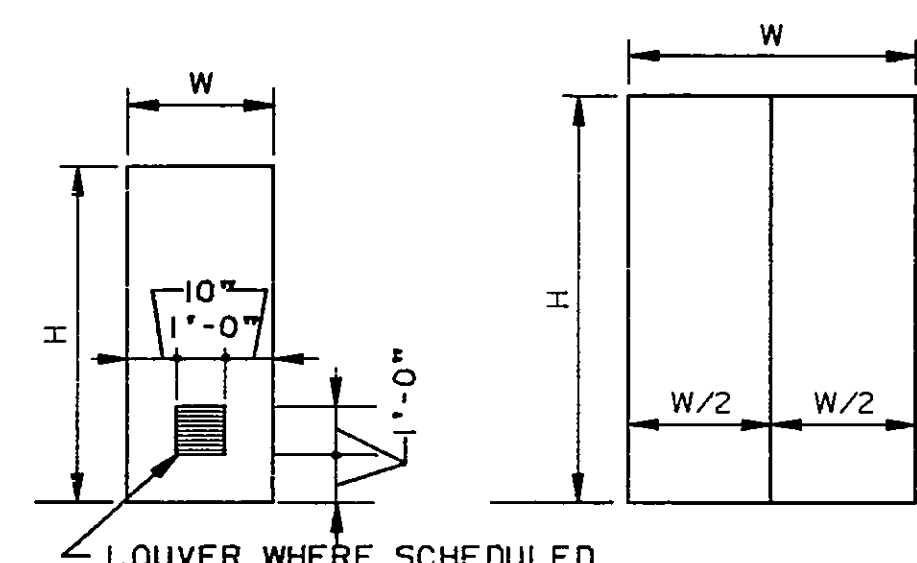


TYPE A

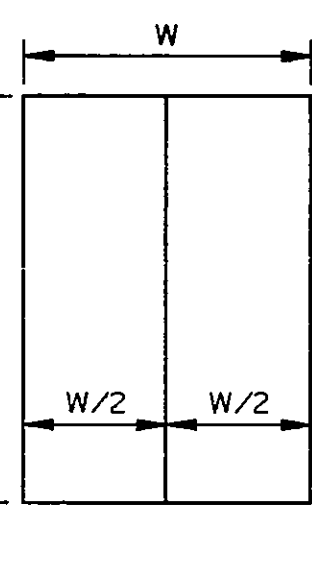


TYPE B

TYPE C


FRAME TYPES

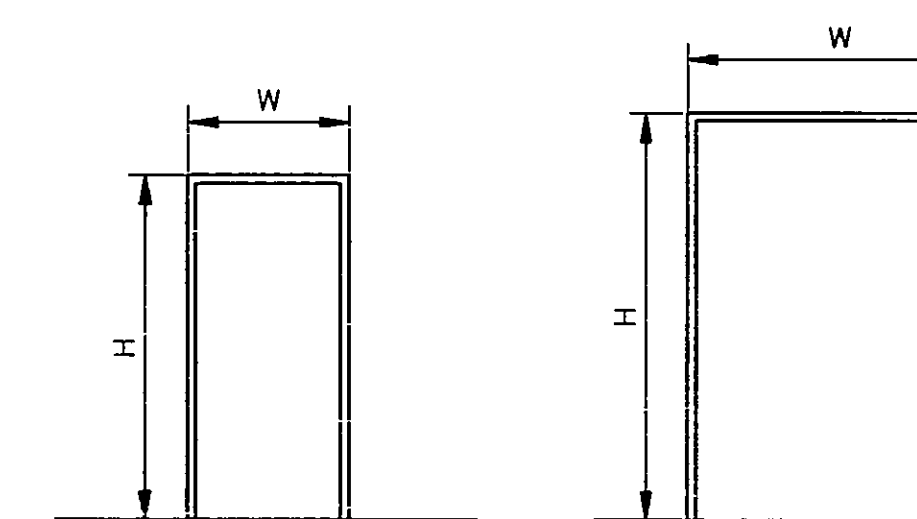

TYPE 1


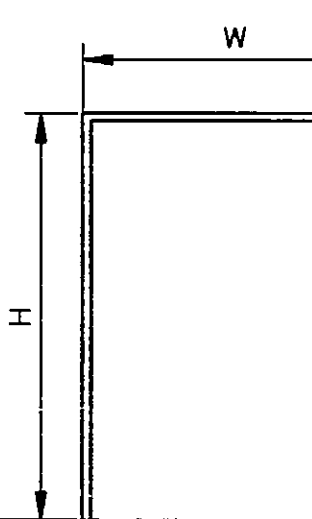


TYPE 2

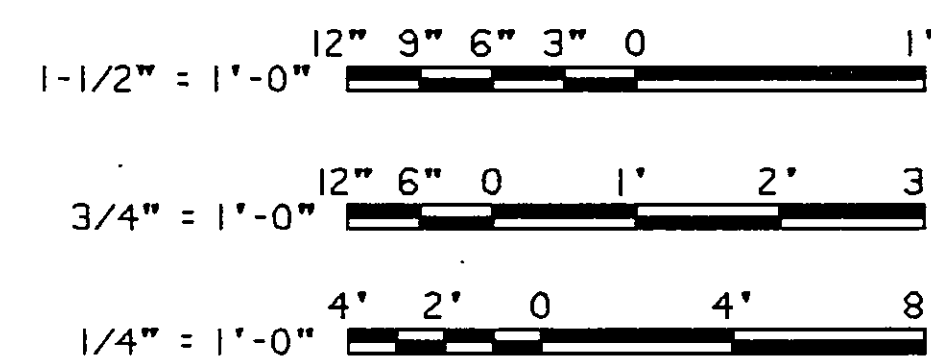


GRAPHIC SCALES






FRAME, JAMB & HEAD TYPES

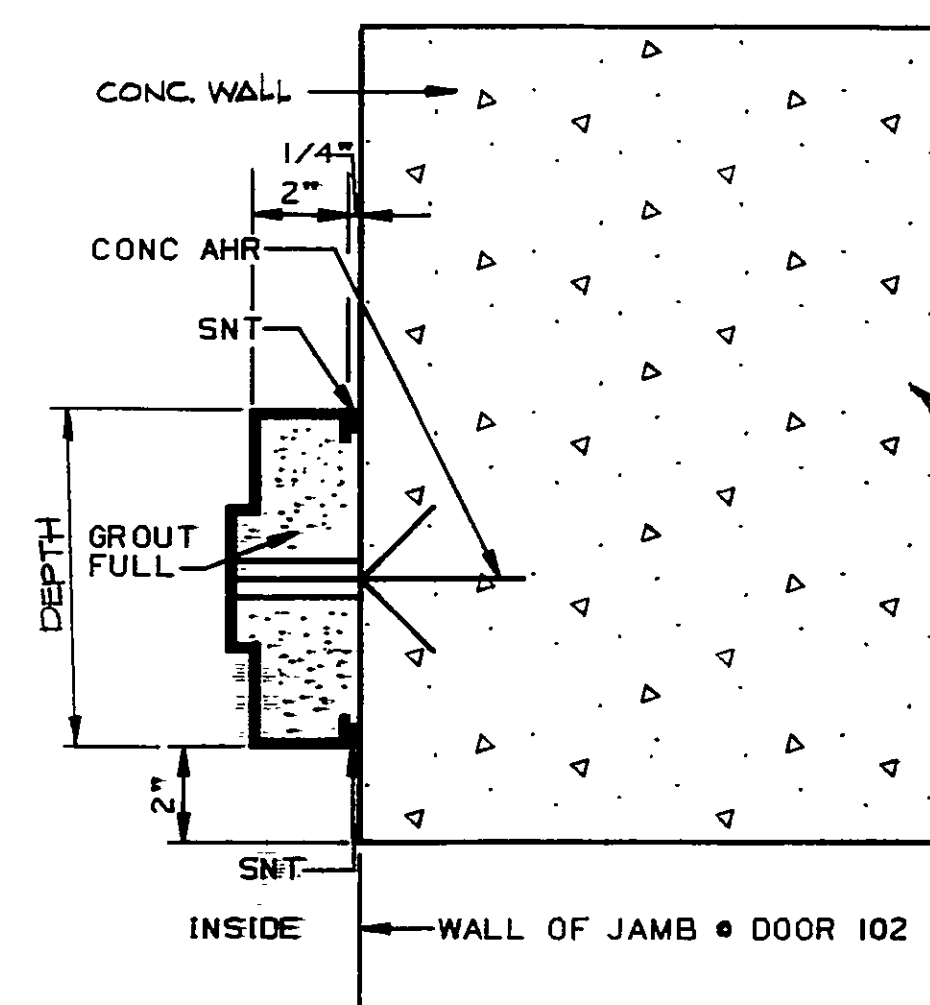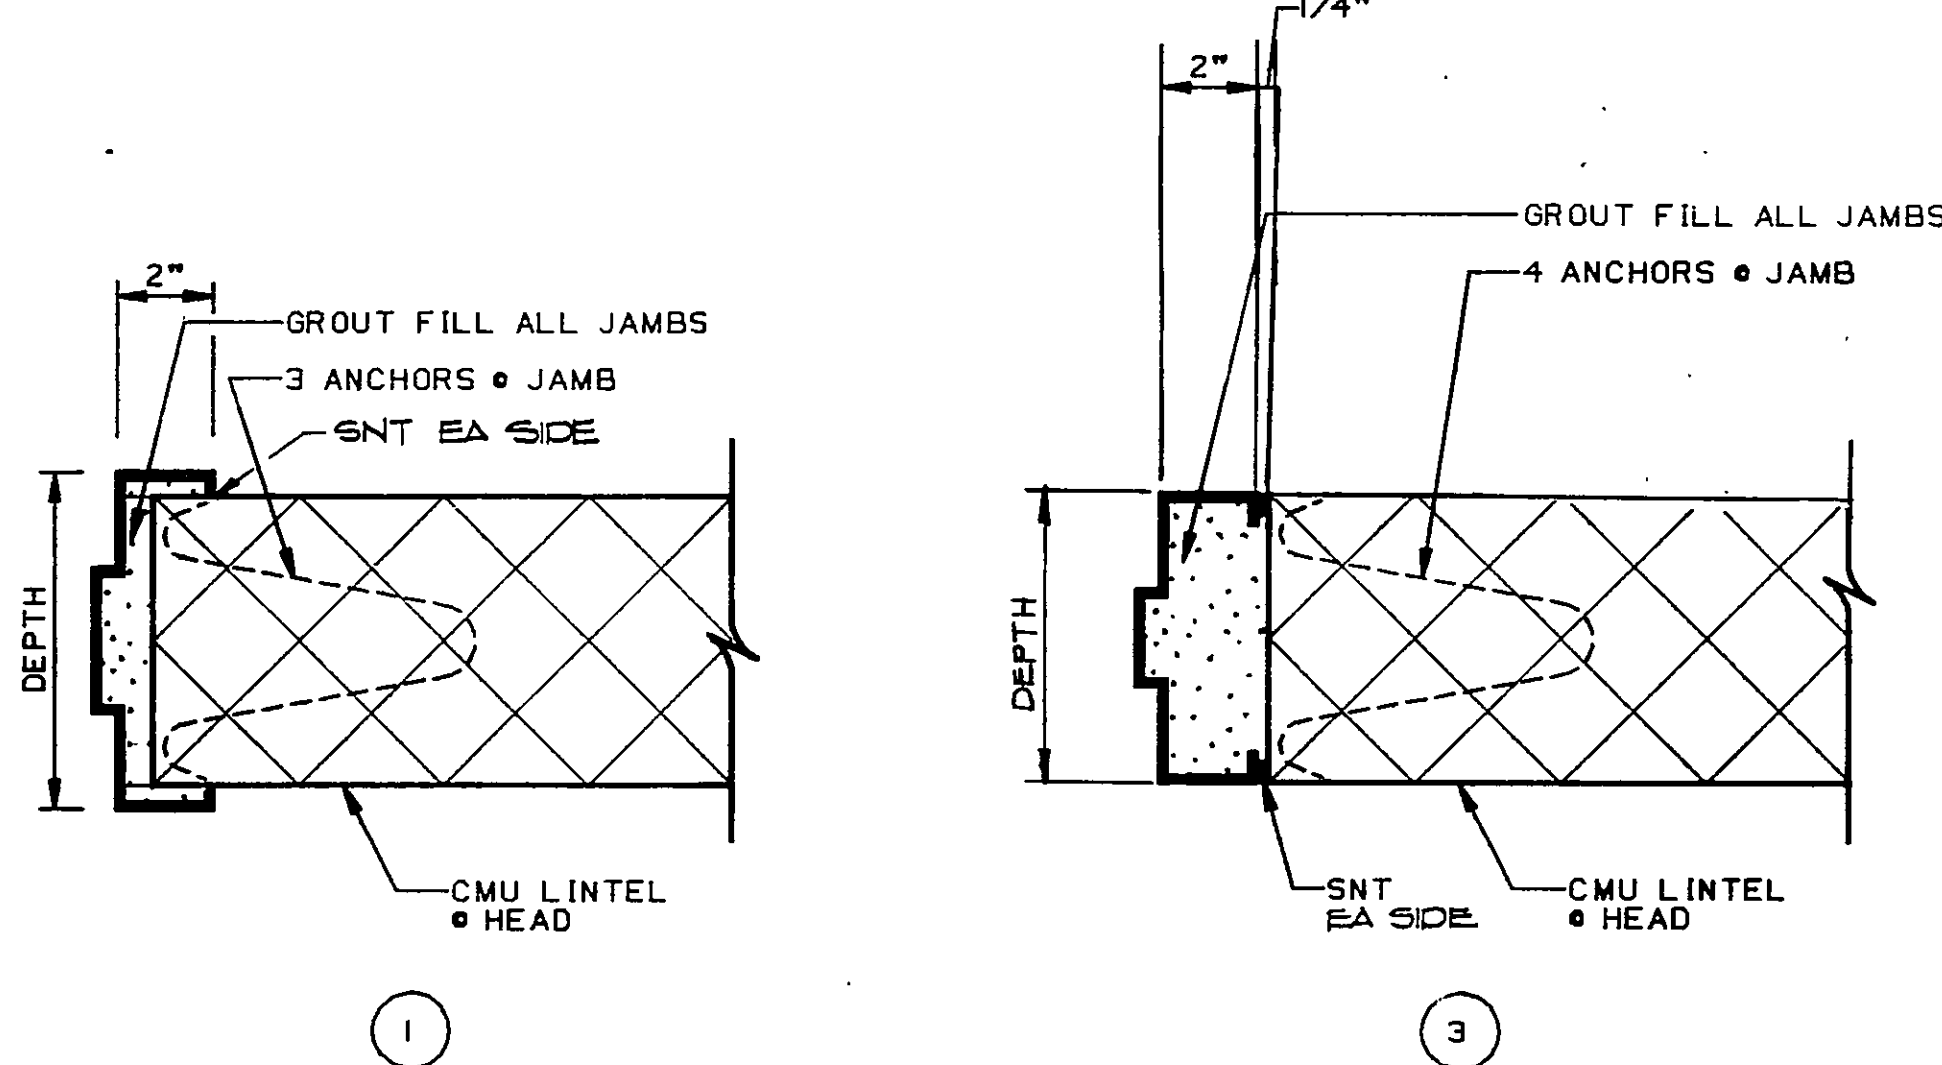

THRESHOLDS

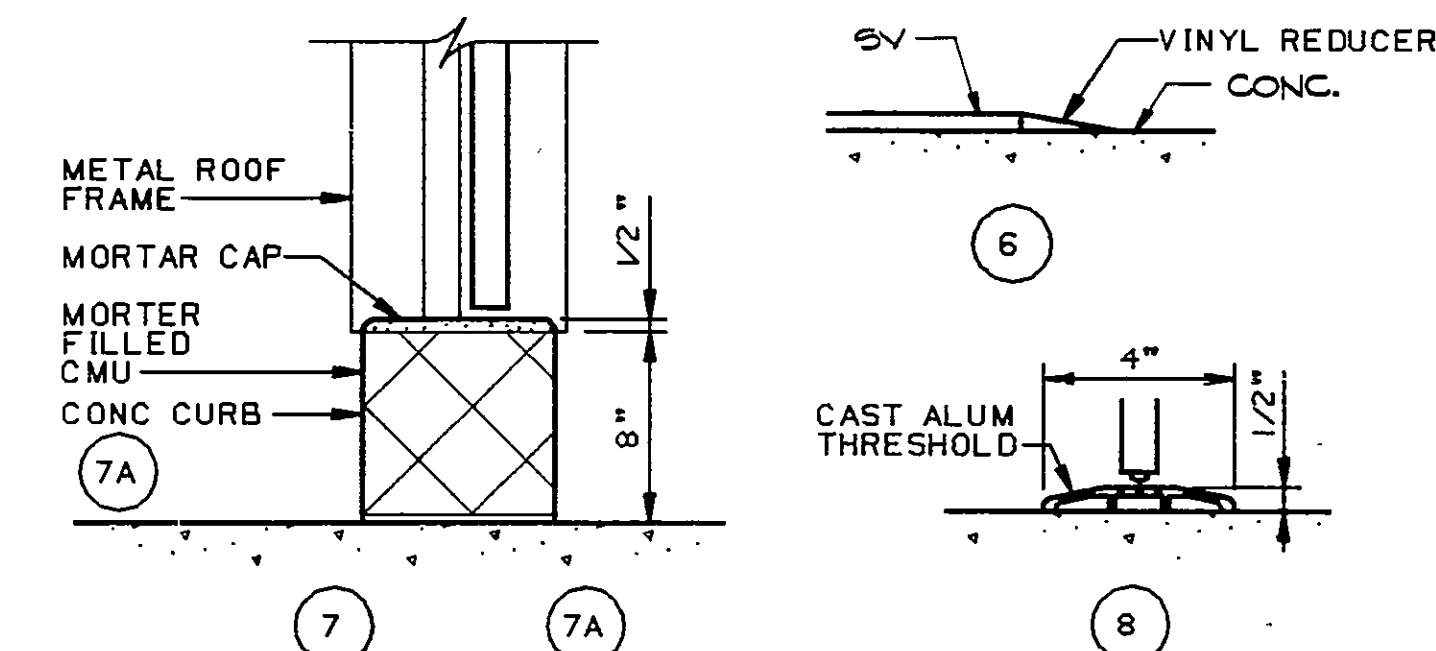

DETAILS

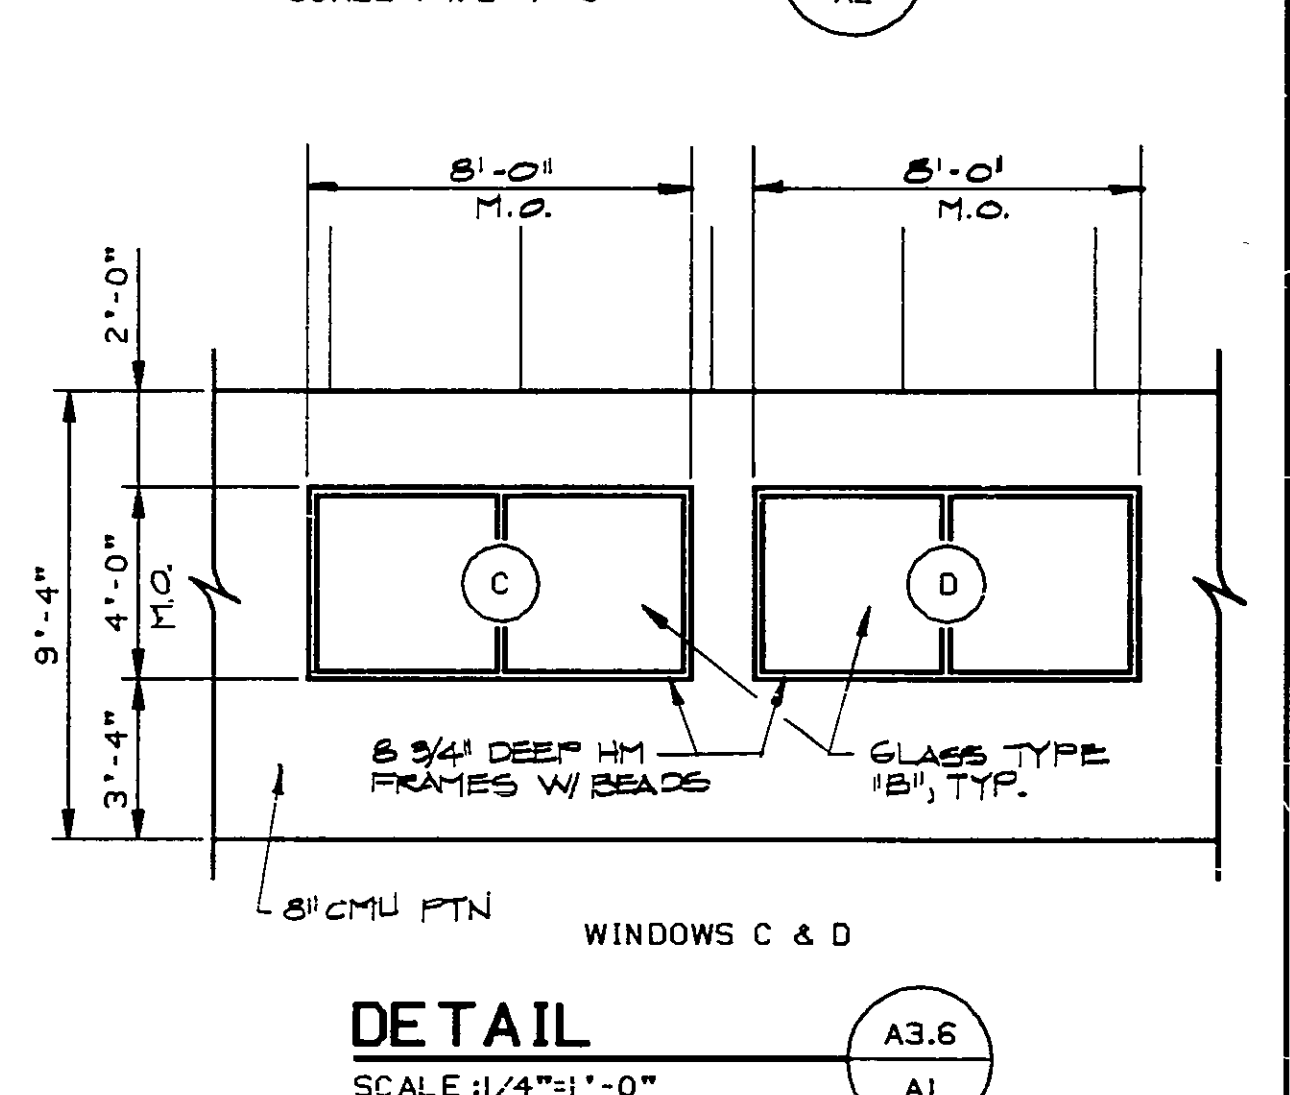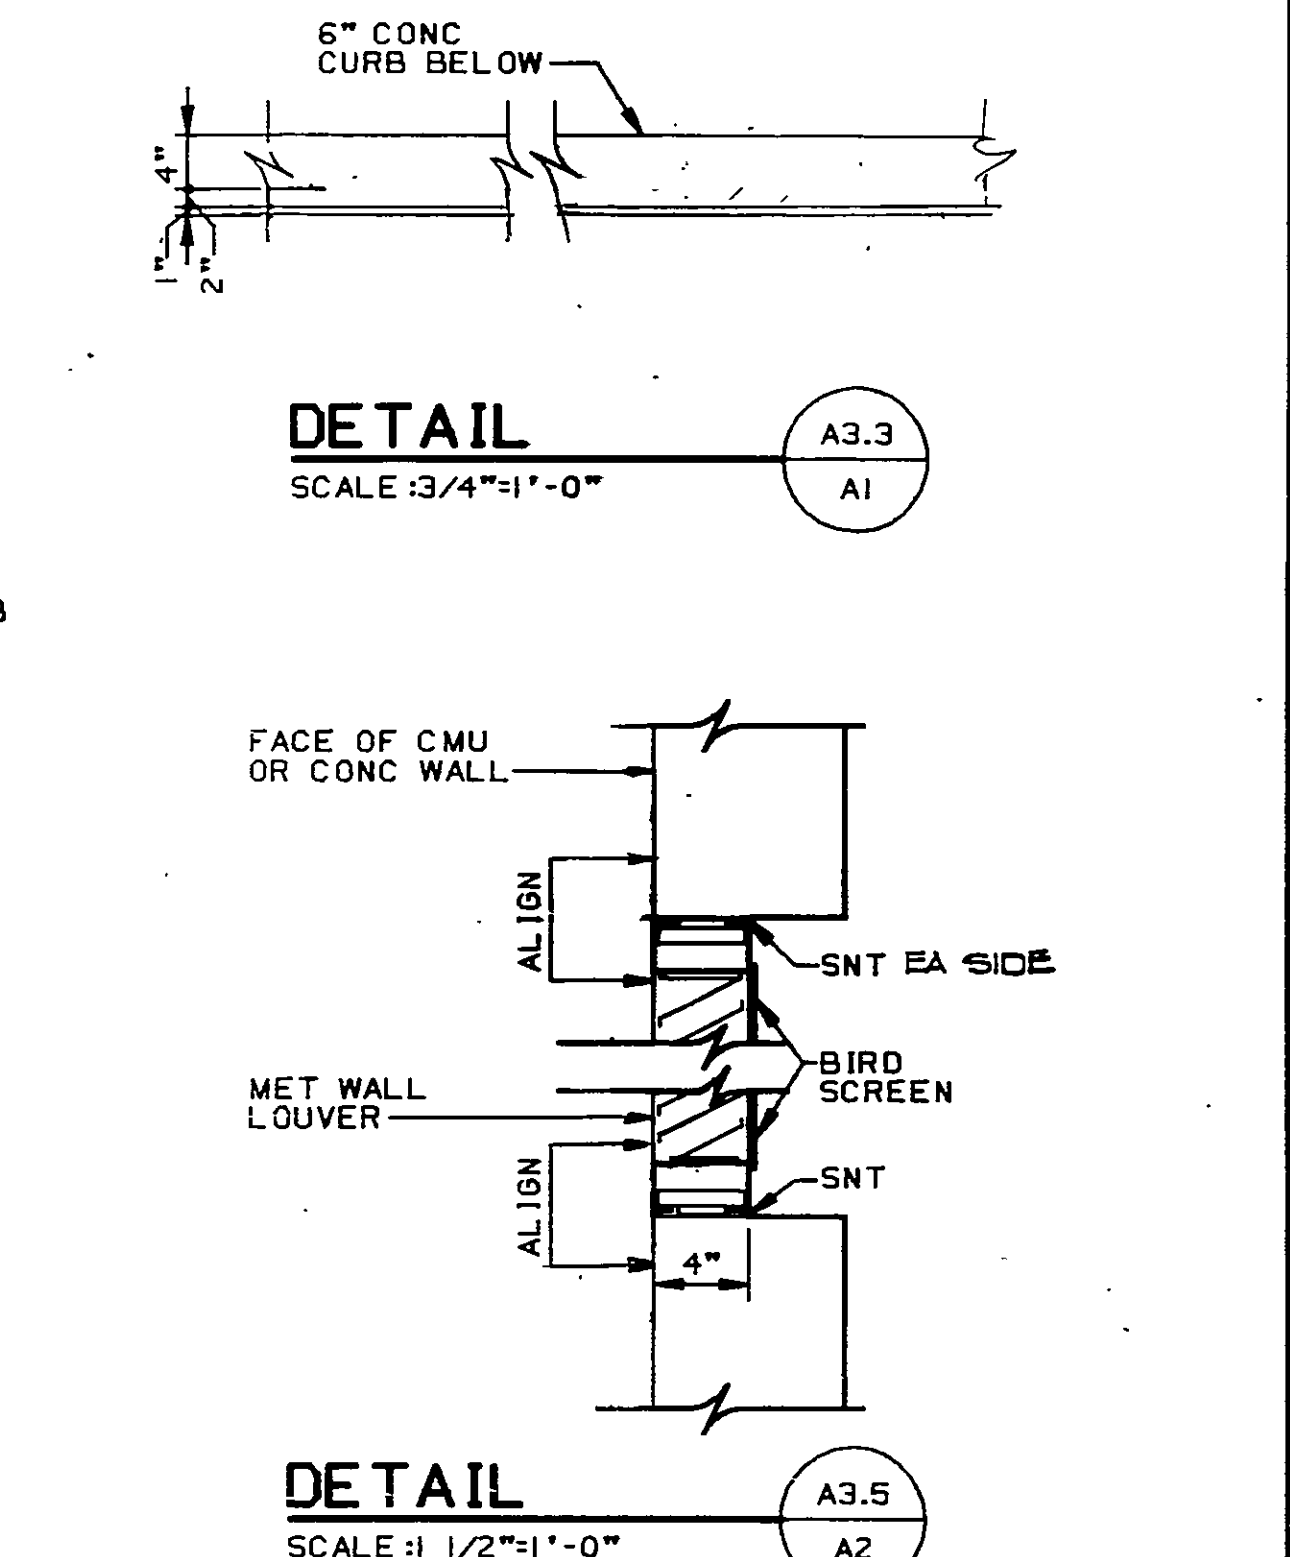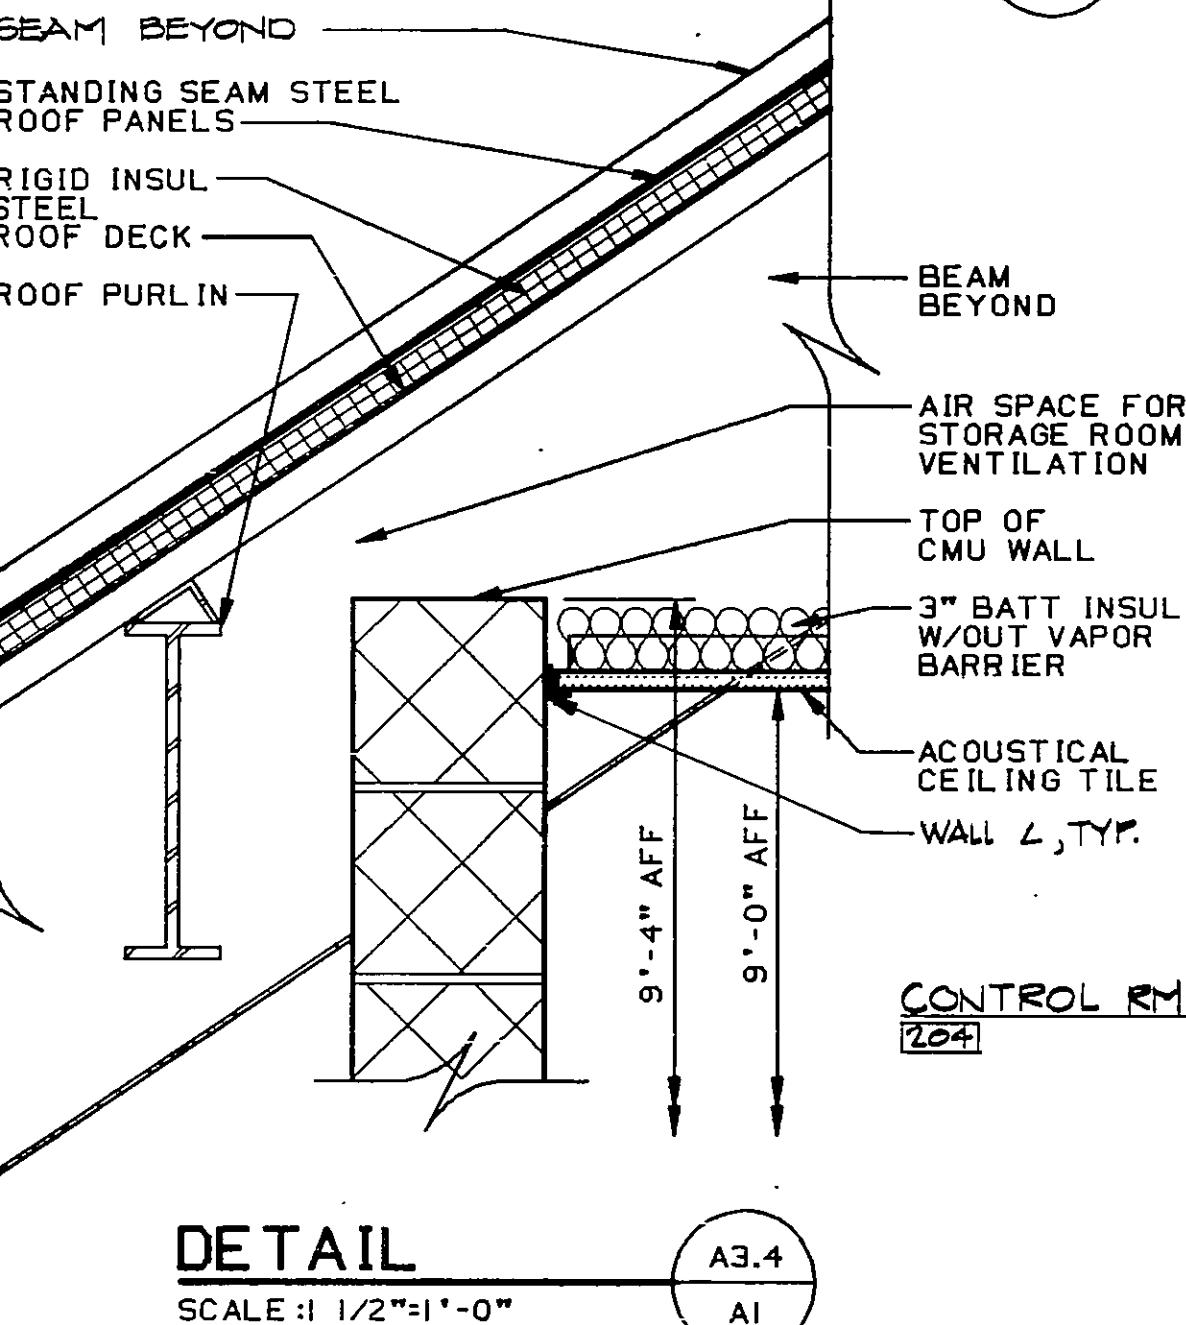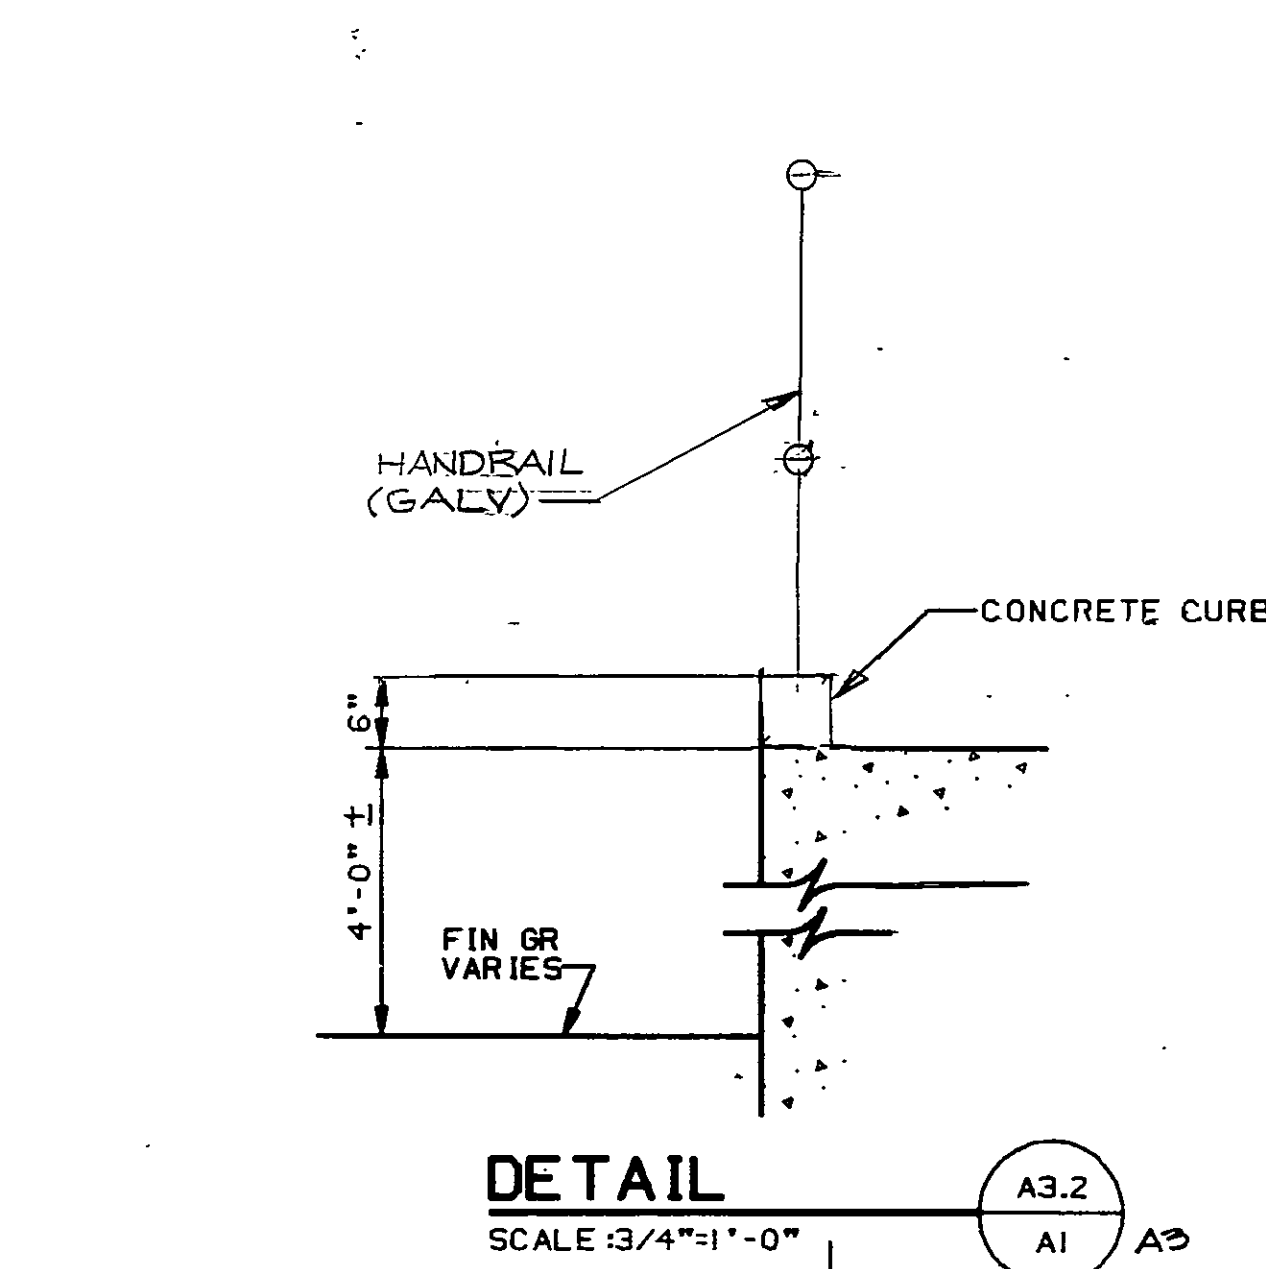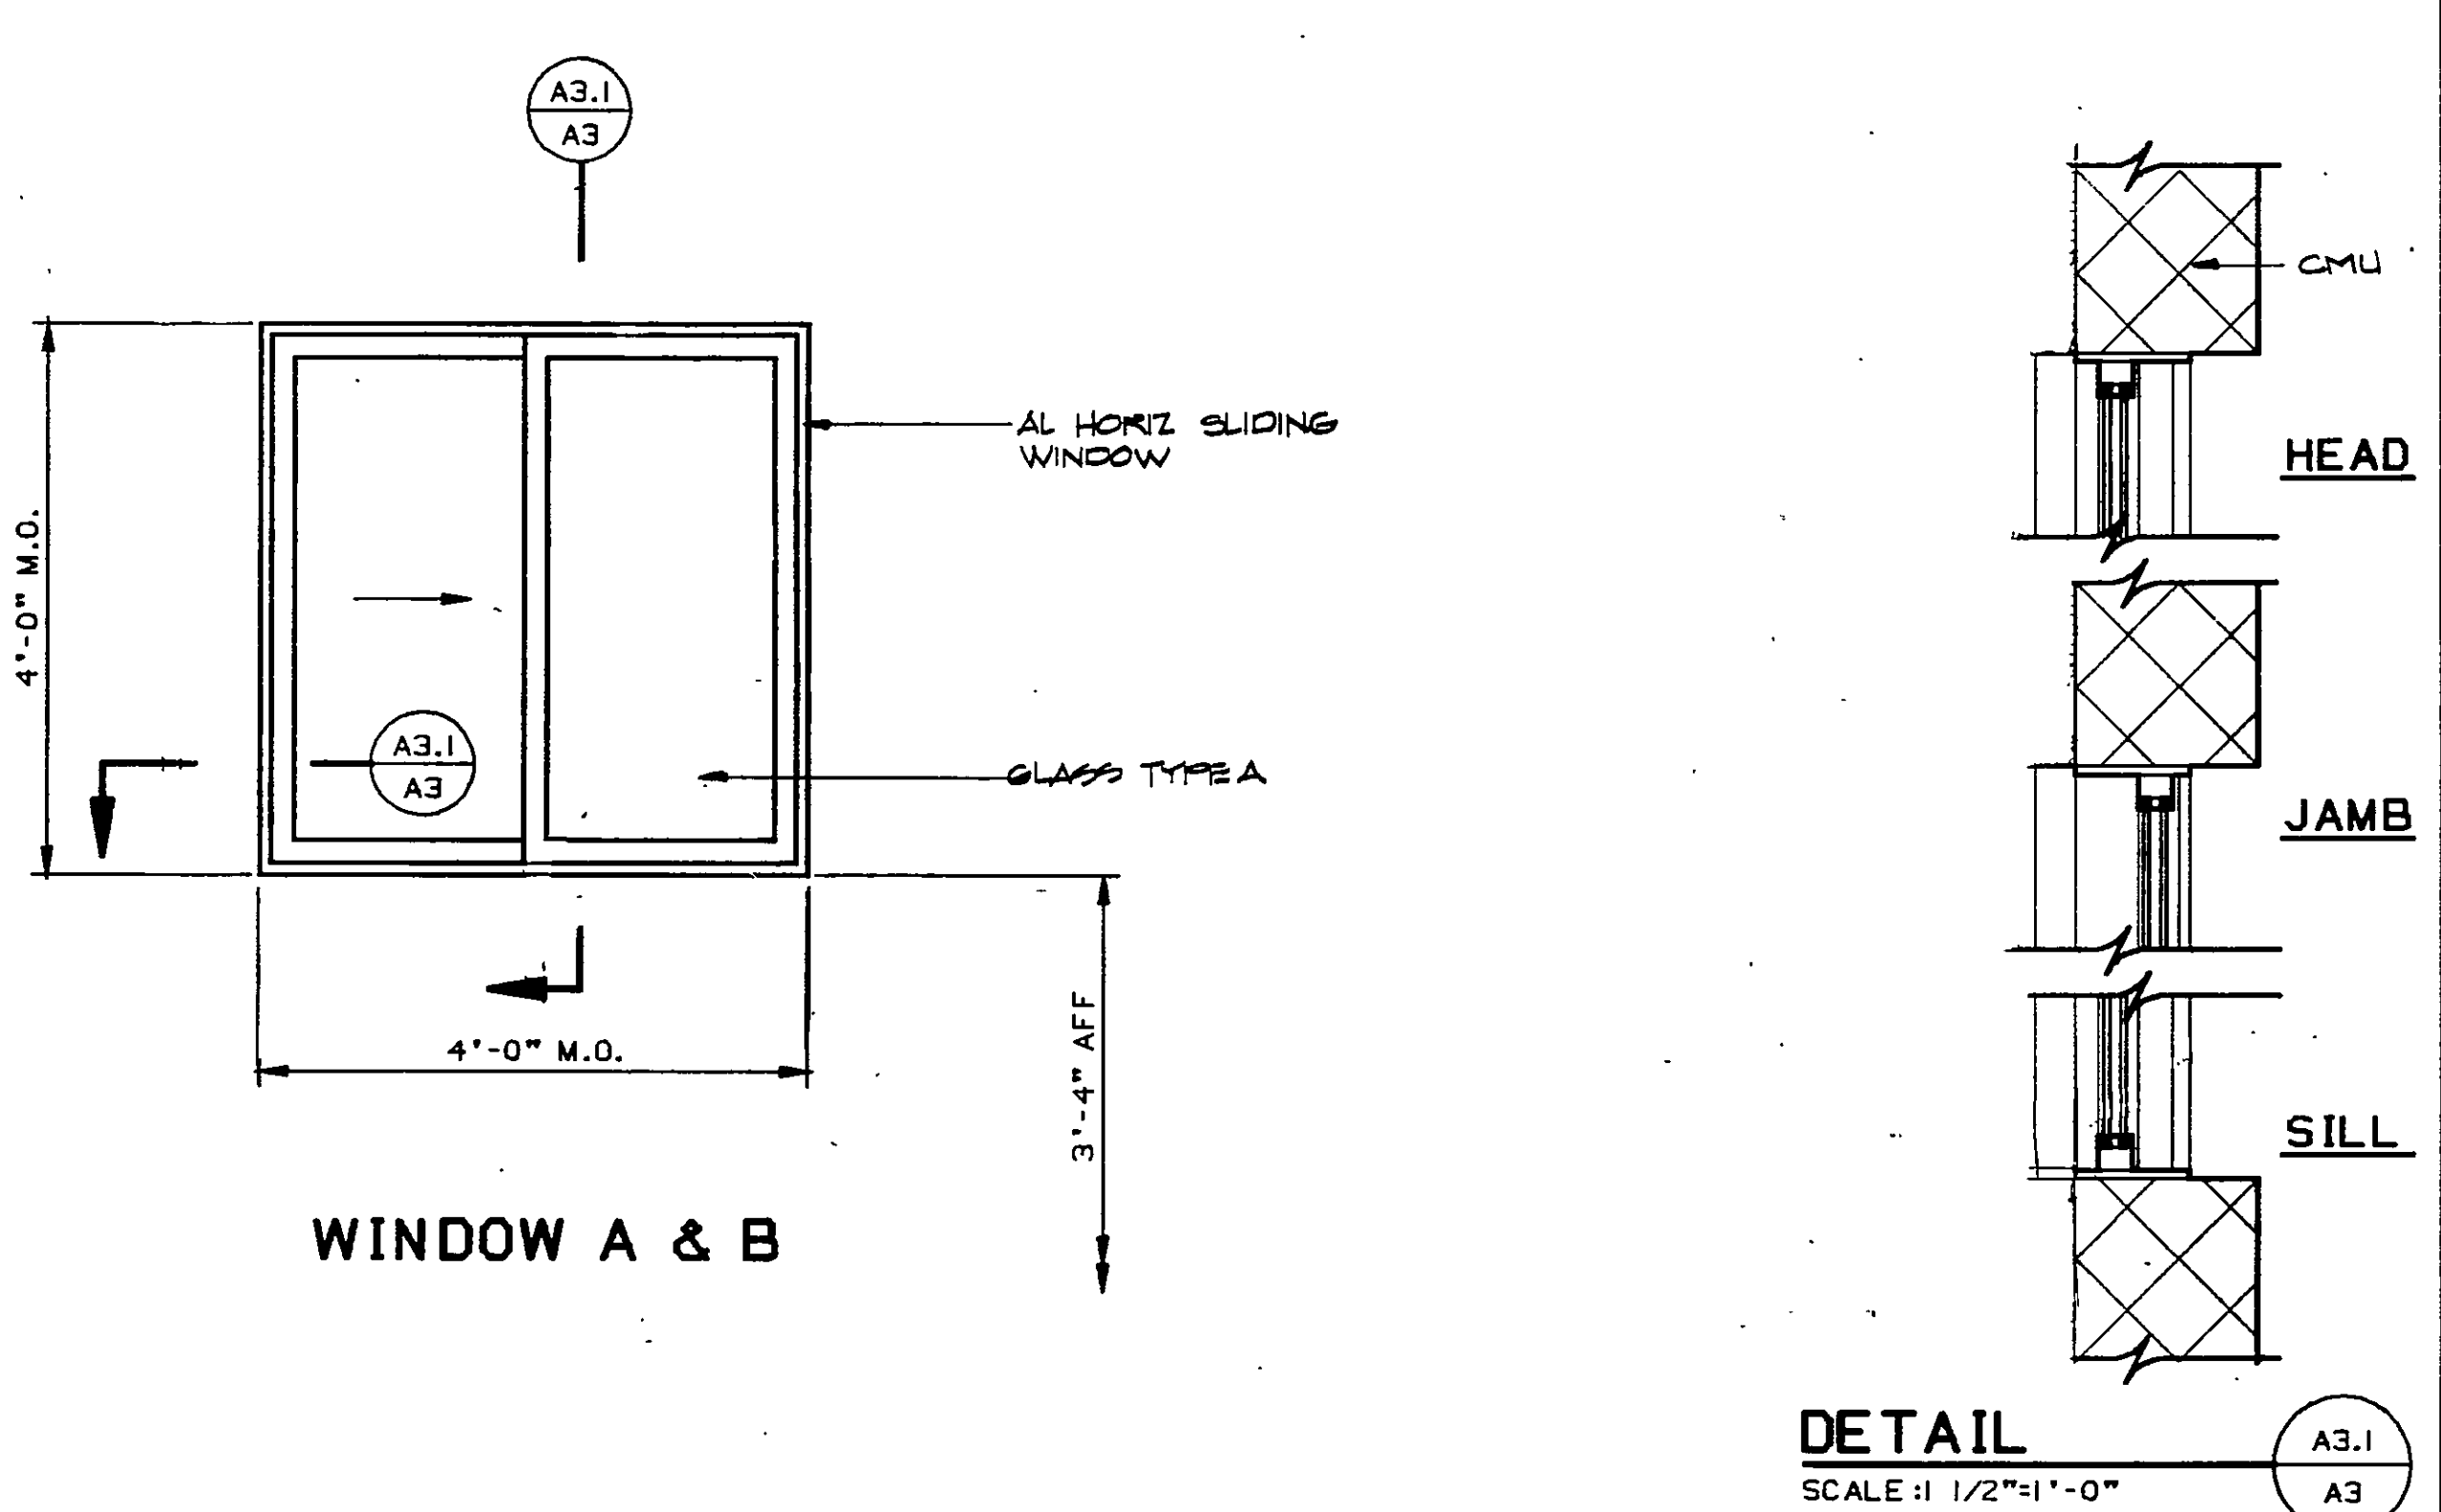


DESIGNED HG DATE 8/4/91

DRAWN JKB/EMP DATE 8/4/91

CHECKED RBT DATE 8/4/91

APPROVED JLS DATE 8/4/91

ISSUED APB/1 DATE 8/21/91

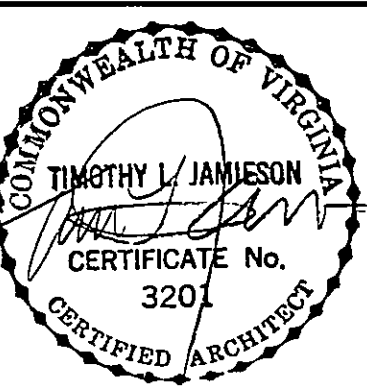


DATE	BY	DESCRIPTION	DATE	BY	DESCRIPTION
8/15/91	BA	PER CONTR RECORD DWS			
8/21/91	JKB	ISSUED TO VA DAM SAFETY			
8/21/91	RWF	RECORD DRAWING			

RECORD DRAWINGS

THESE DRAWINGS RECORDED ON THE BASIS OF INFORMATION FURNISHED BY THE CONTRACTOR OR SPECIFICALLY KNOWN TO HSM. NO OTHER REPRESENTATIONS ARE MADE OR IMPLIED

Date: 6-5-95

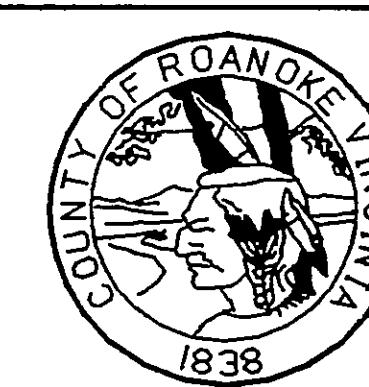

SPRING HOLLOW RESERVOIR

ROANOKE COUNTY, VIRGINIA

HAYES, SEAY, MATTERN & MATTERN, INC.

ARCHITECTS - ENGINEERS - PLANNERS

ROANOKE, VIRGINIA

SCALE	DATE	COMM	SHEET	DWG
AS NOTED	8/4/91	4194E	A-3	17