
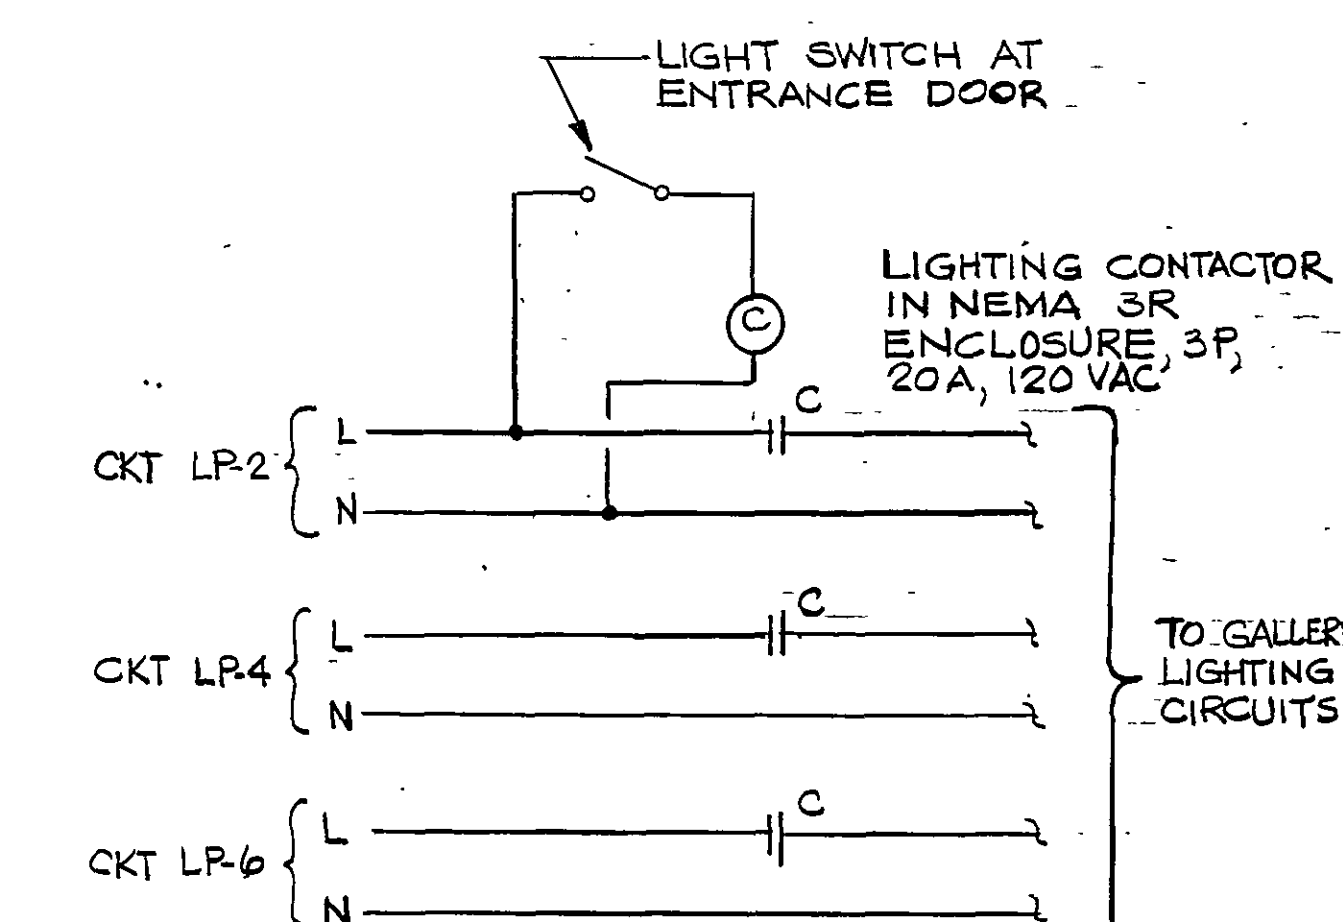
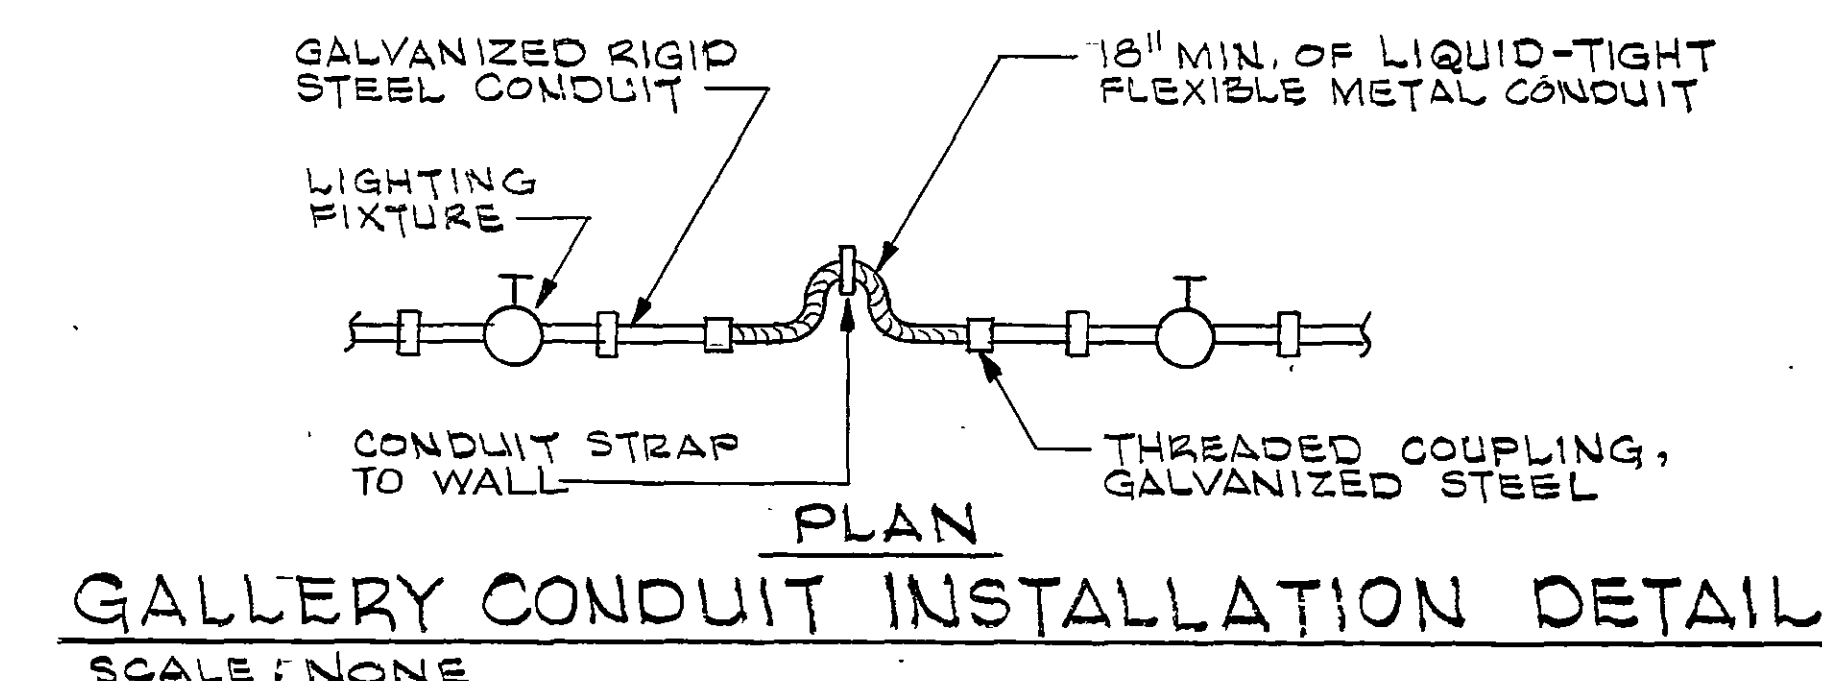
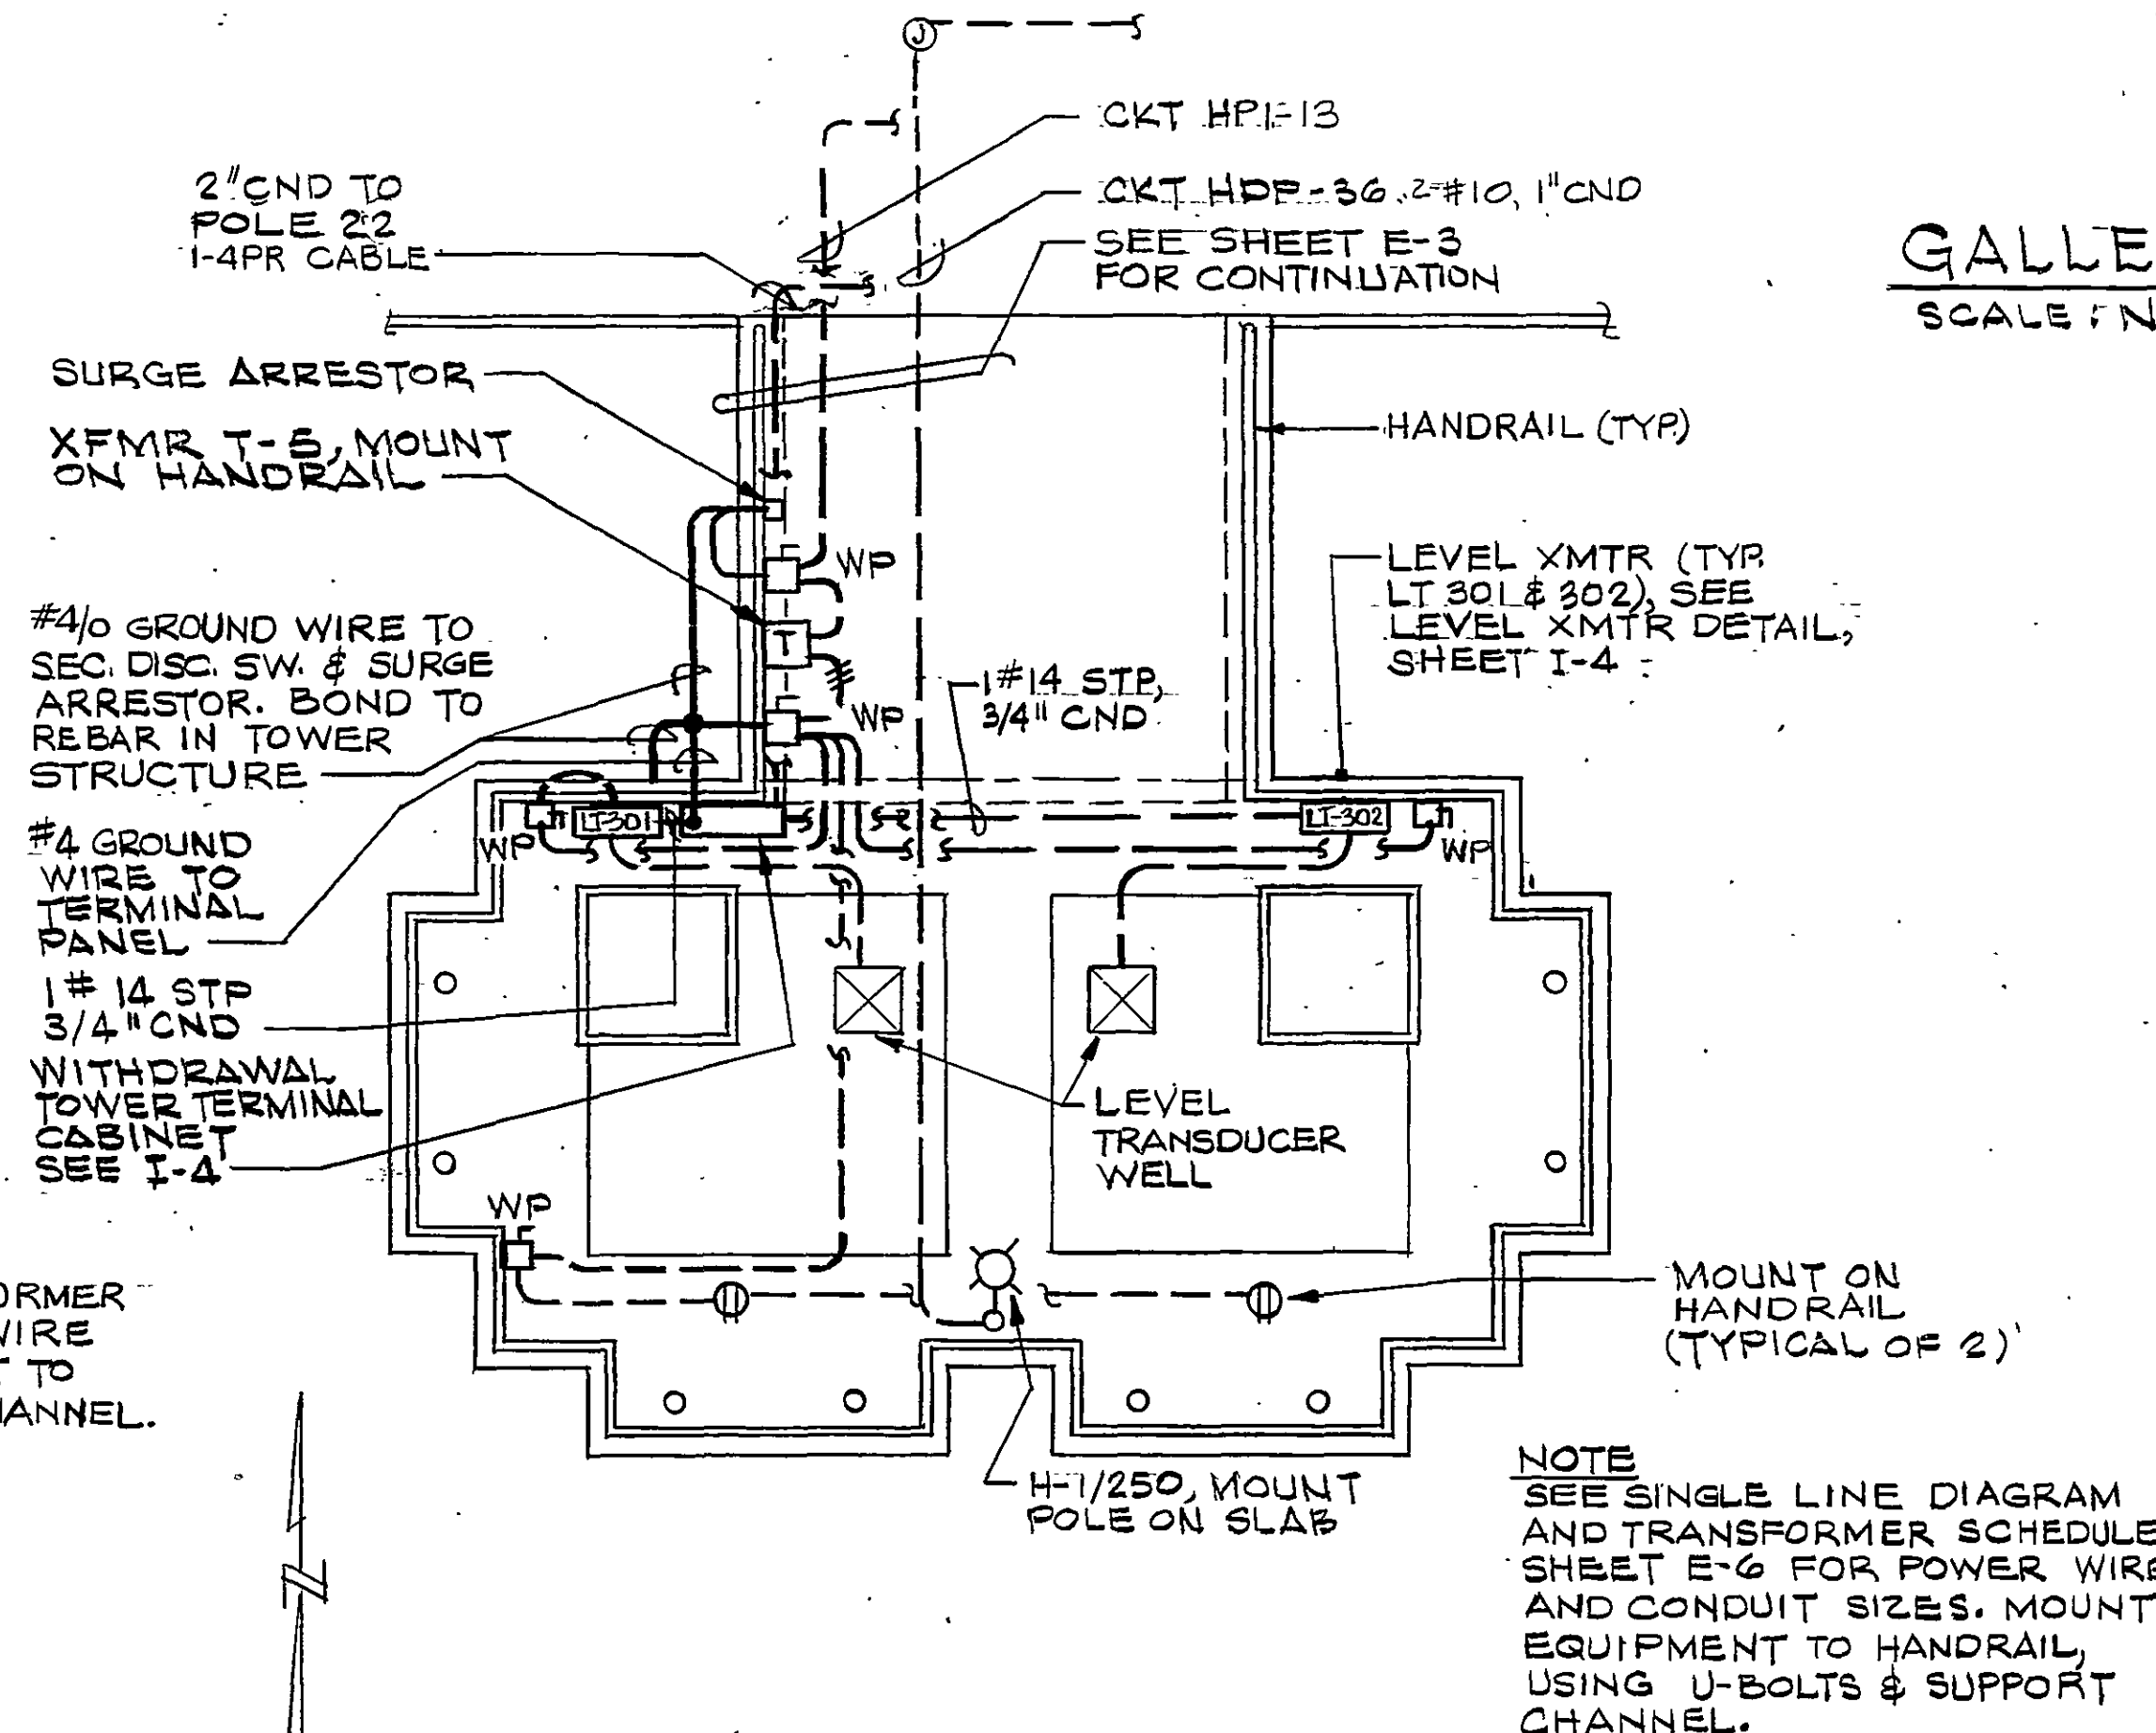
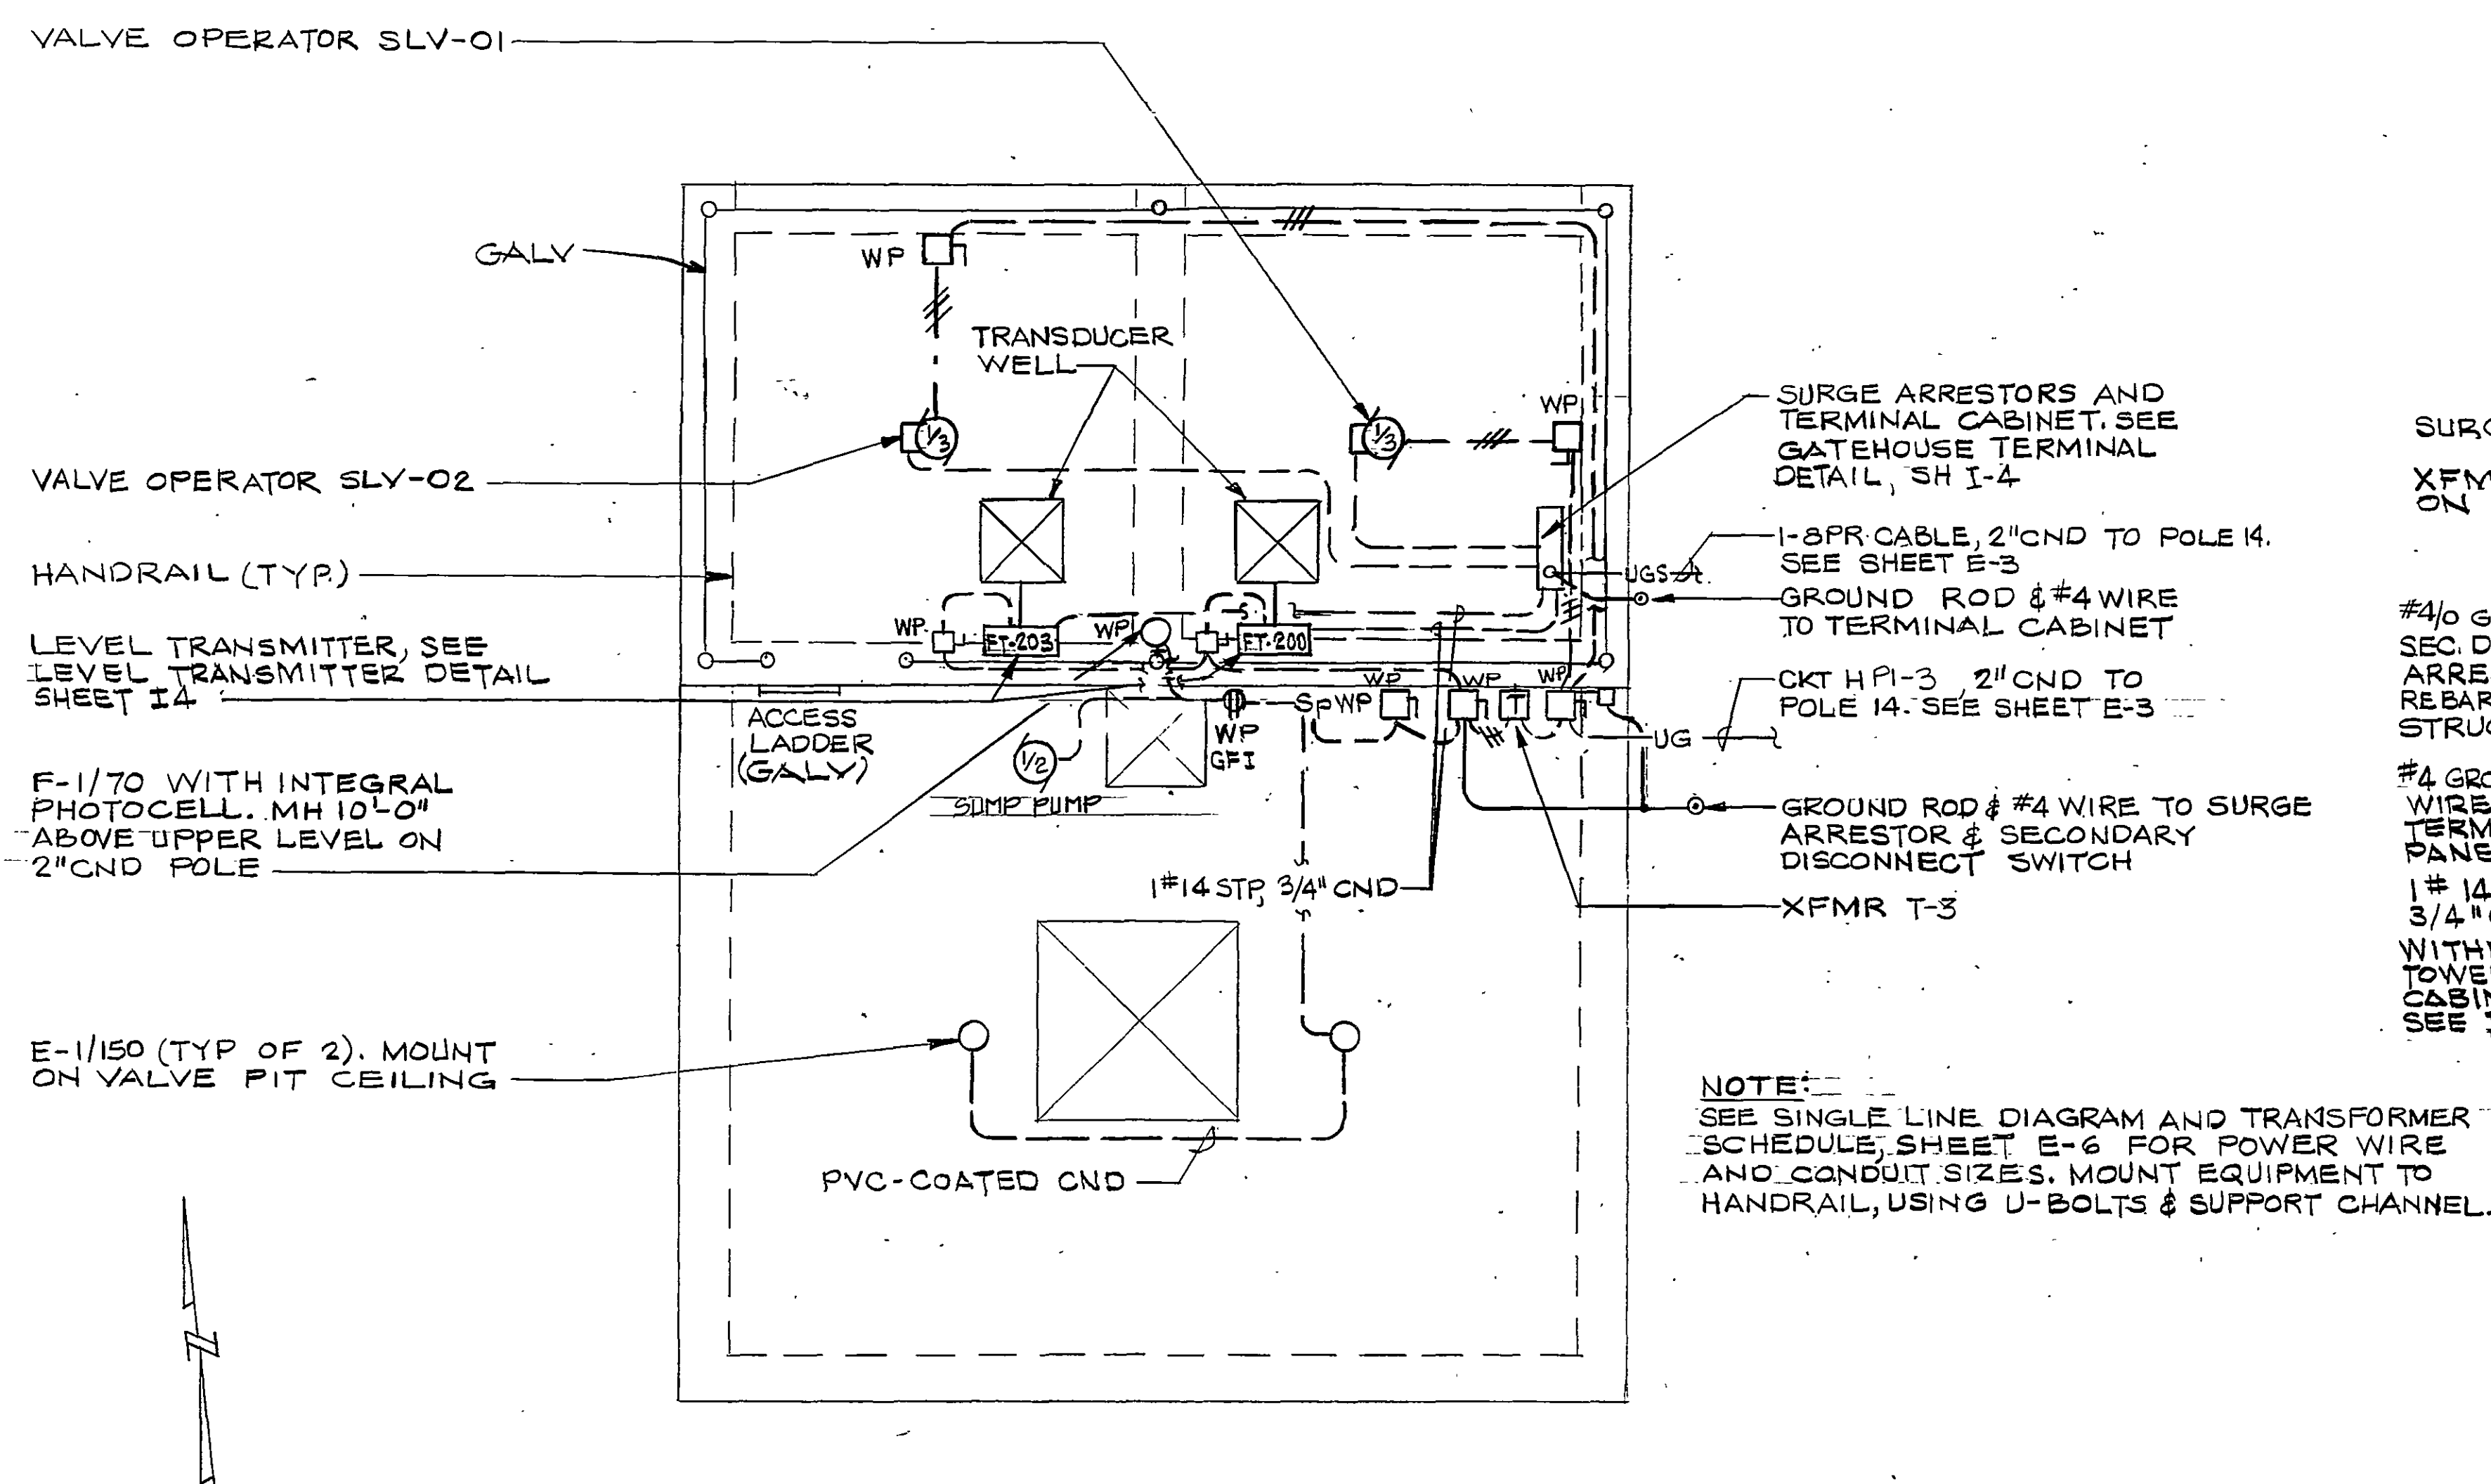
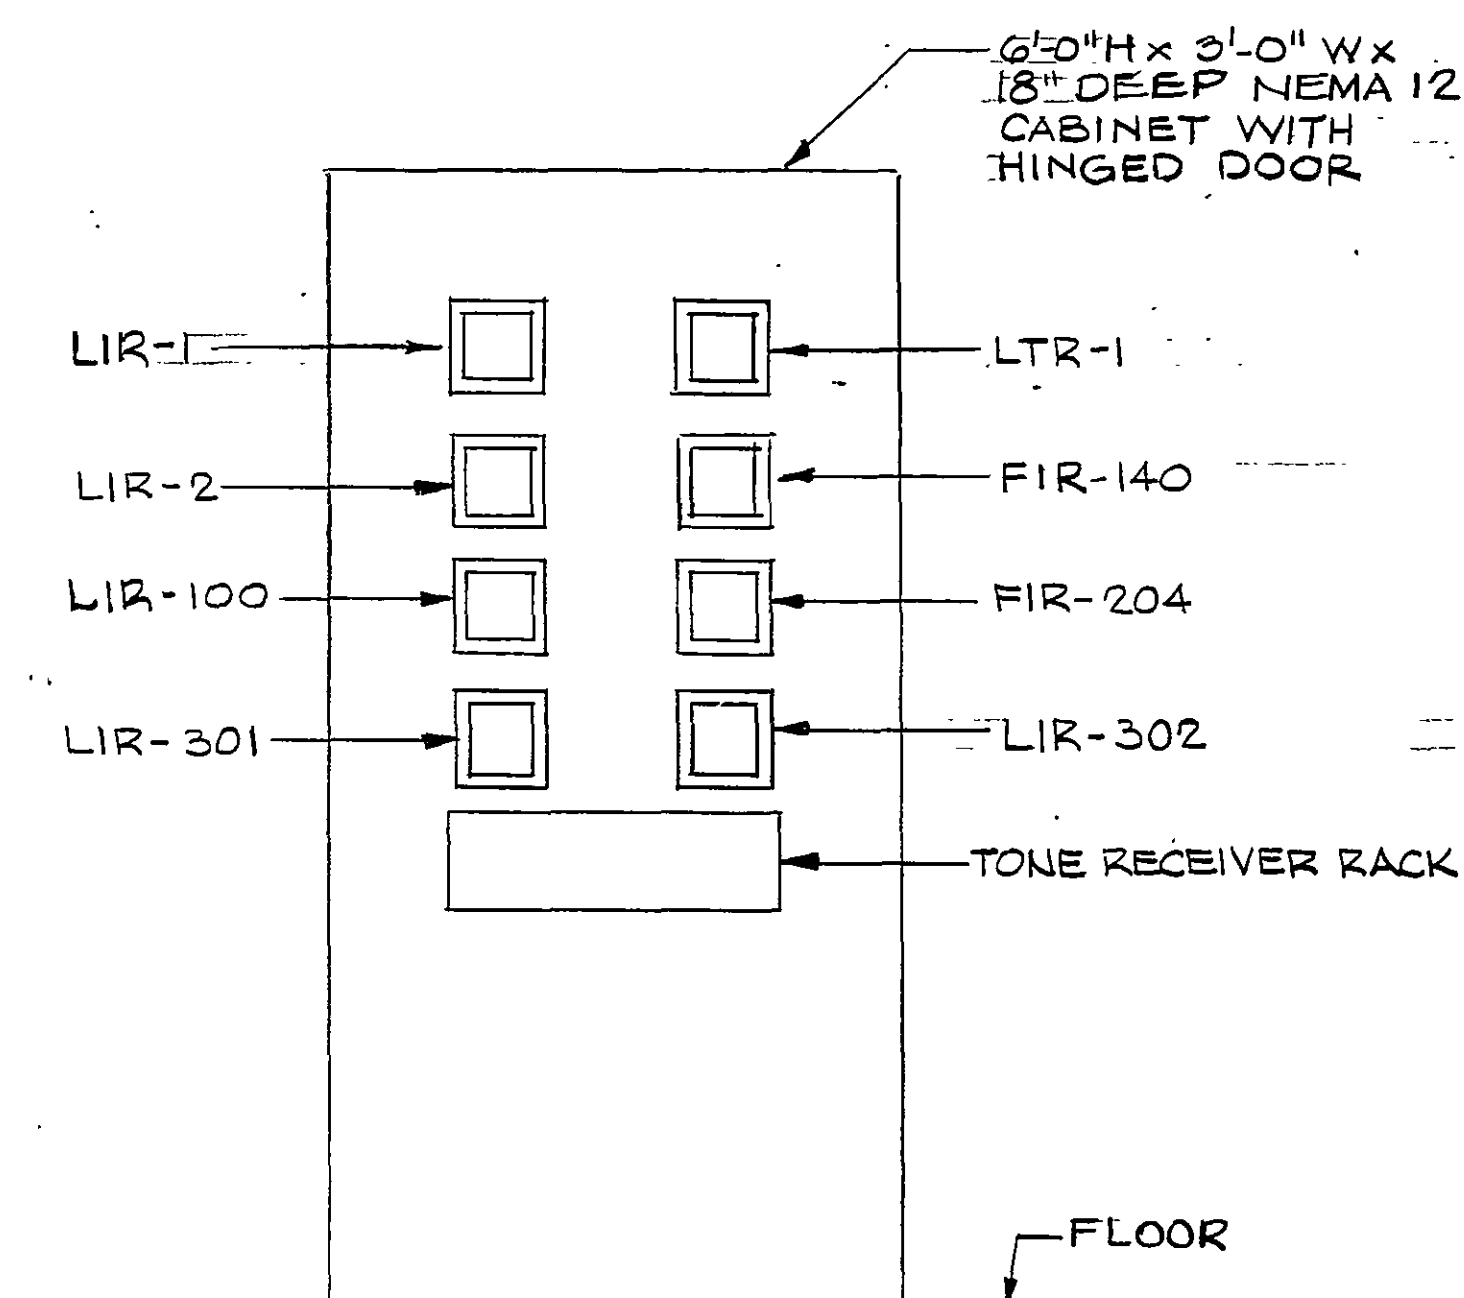
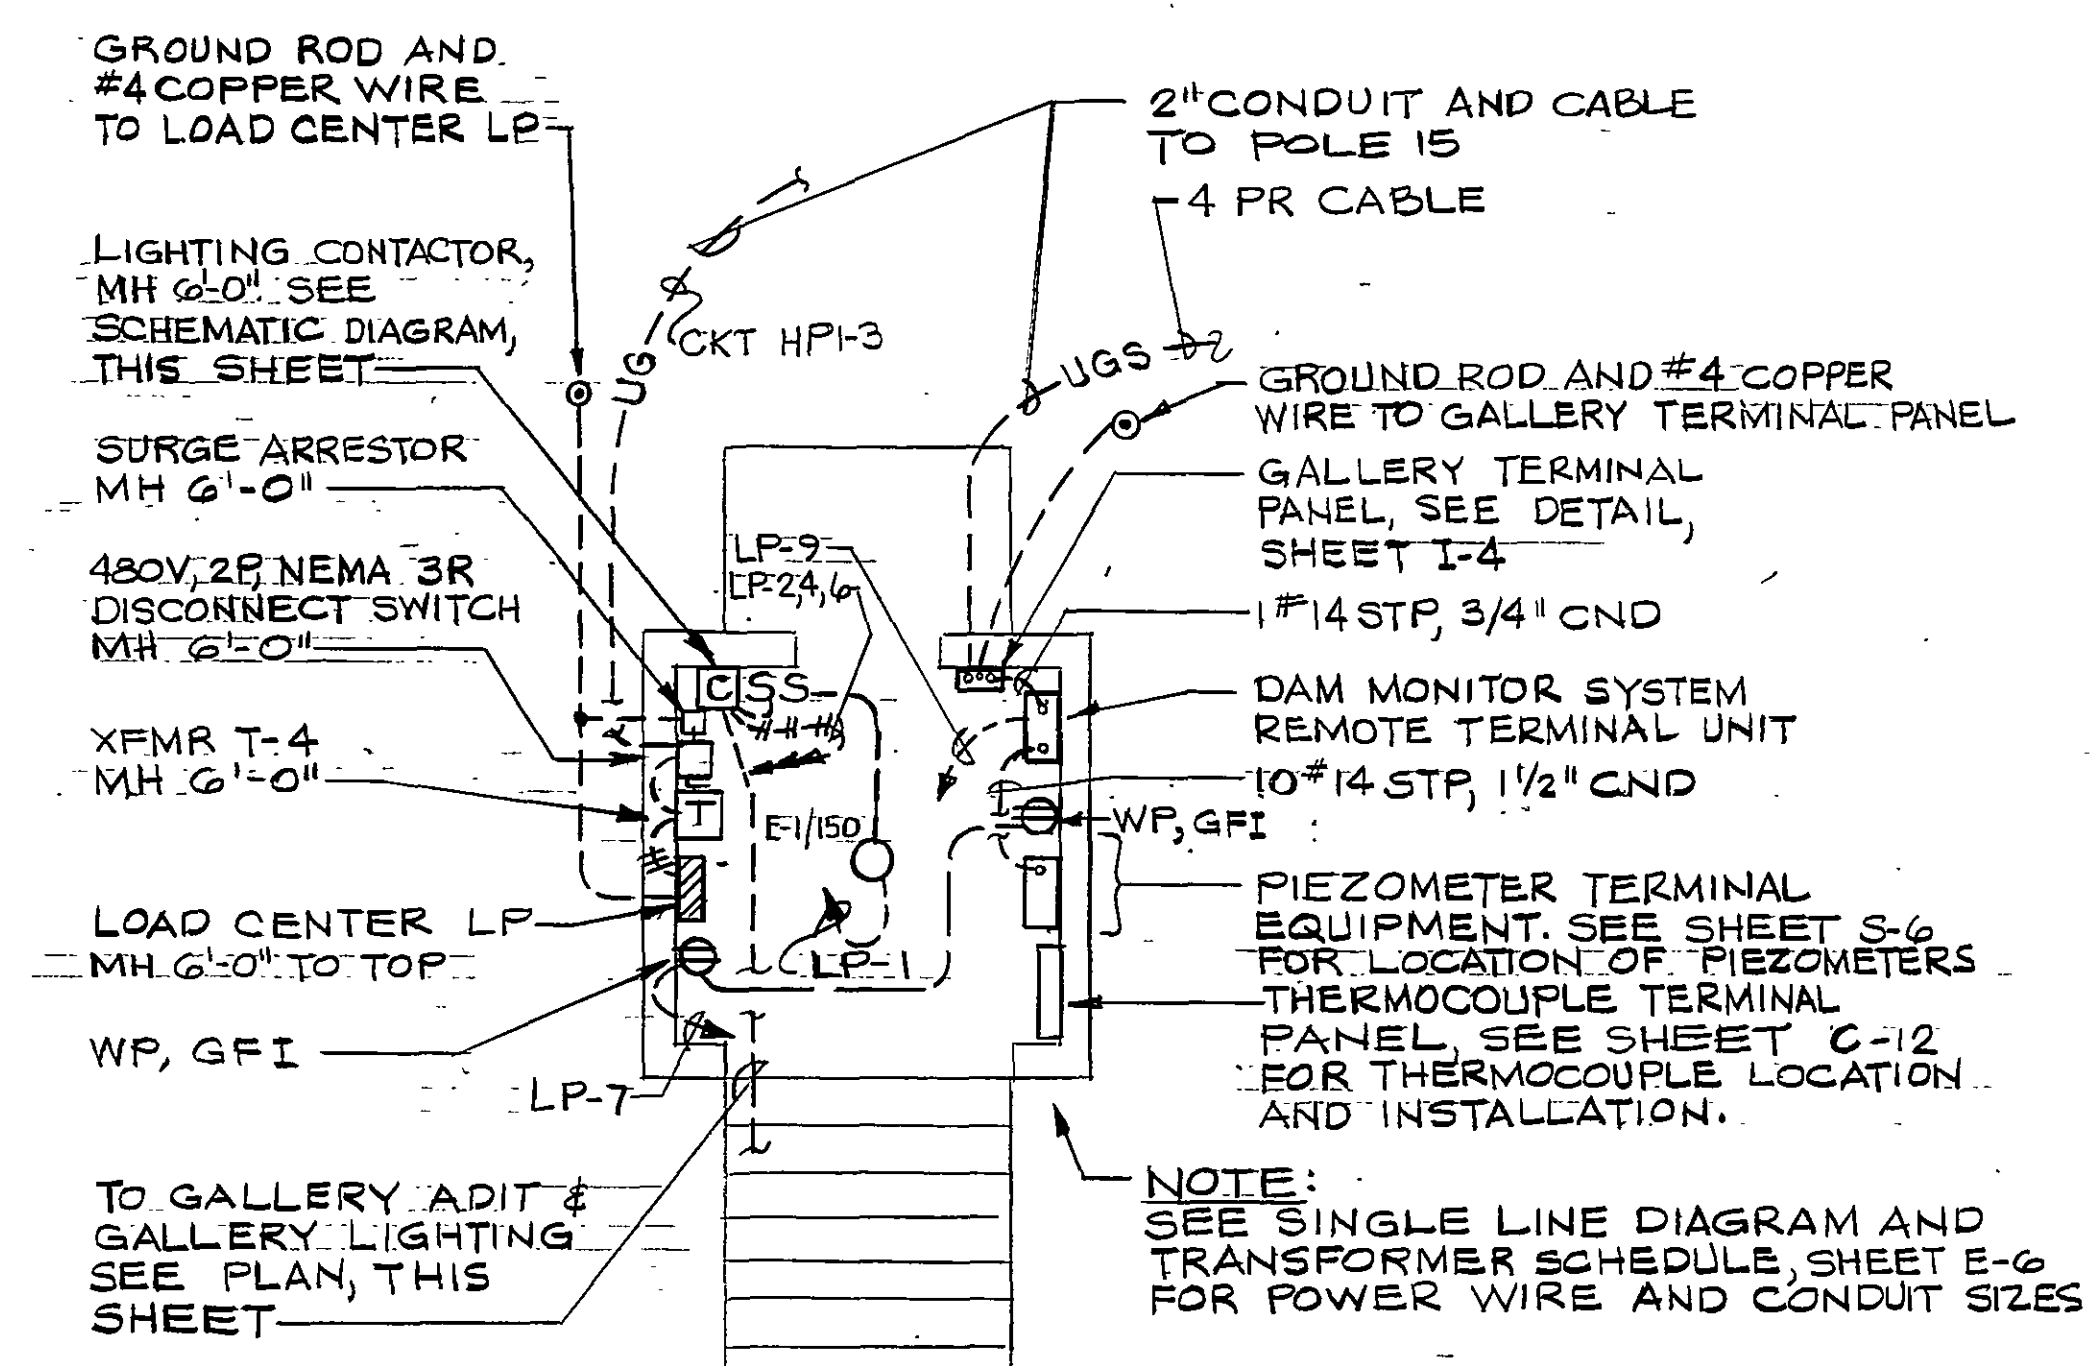


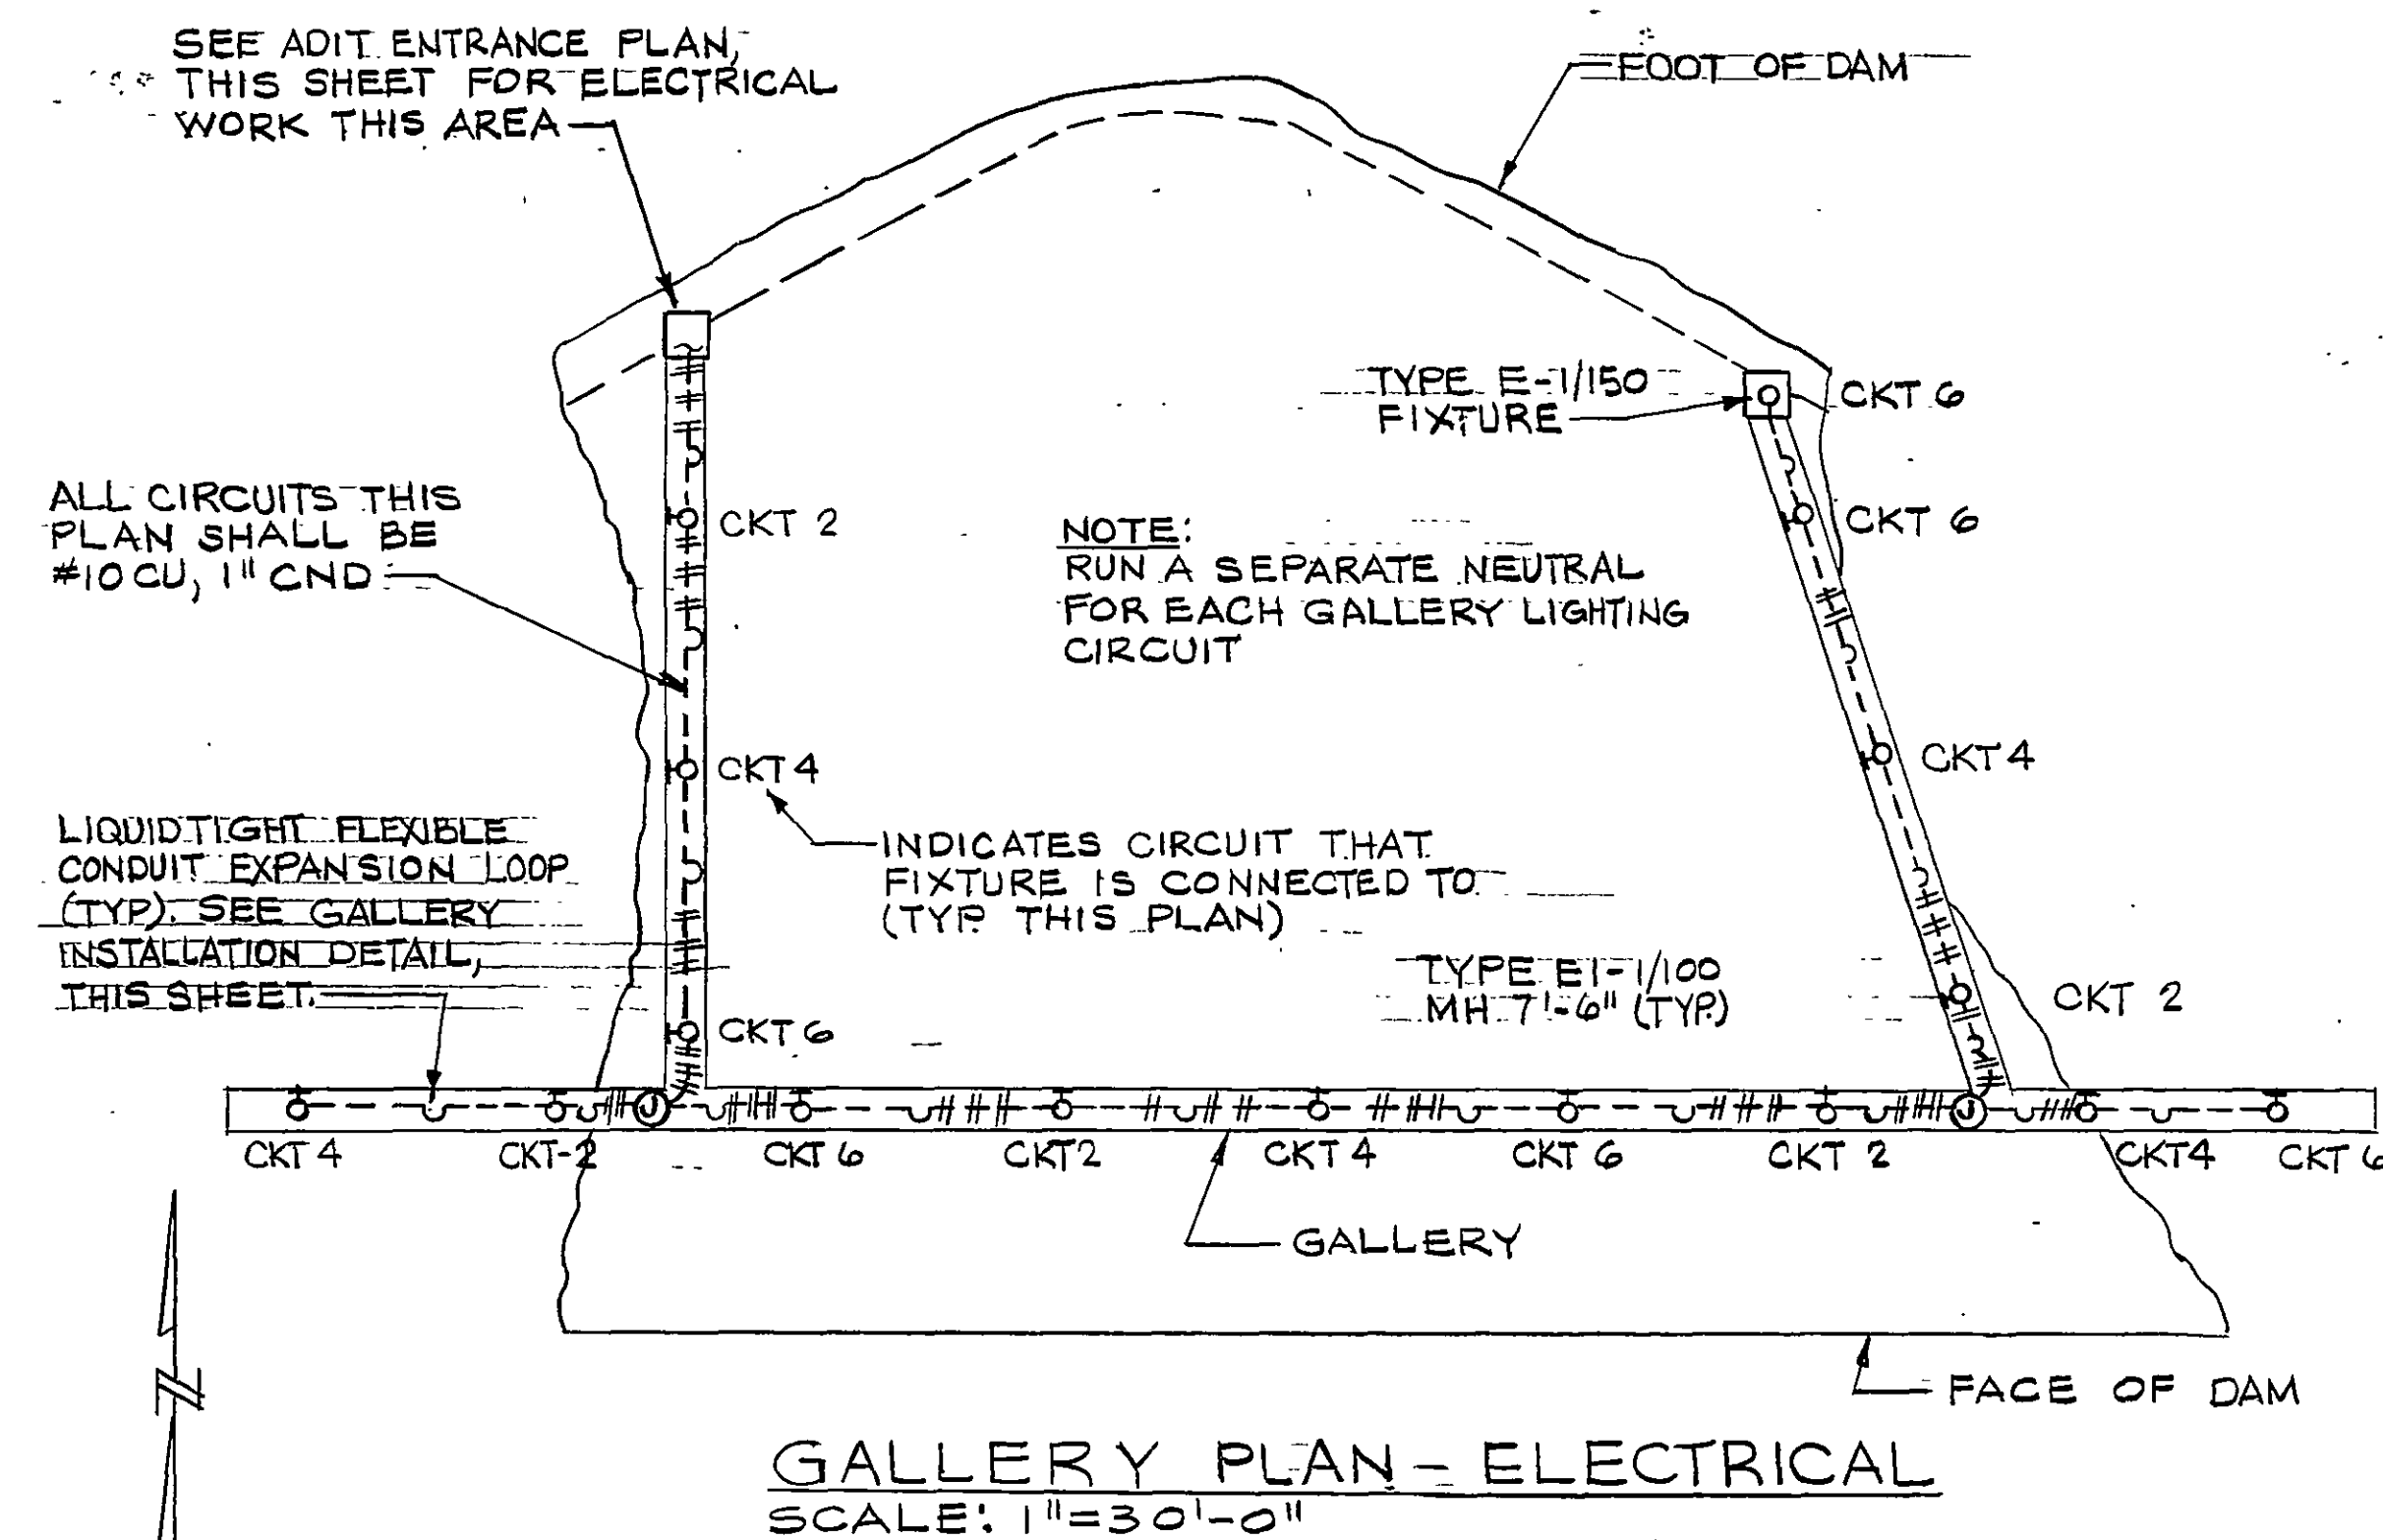

GATEHOUSE PLAN
ELECTRICAL AND INSTRUMENTATION
SCALE: 1/4" = 1'-0"

WITHDRAWAL TOWER PLAN
ELECTRICAL AND INSTRUMENTATION
SCALE: 1/4" = 1'-0"


RECORD DRAWINGS
THESE DRAWINGS RECORDED ON THE BASIS OF
INFORMATION FURNISHED BY THE CONTRACTOR
OR SPECIFICALLY KNOWN TO HSMM. NO OTHER
REPRESENTATIONS ARE MADE OR IMPLIED

Date: 6-5-95

1" = 30'

1/4" = 1'-0"

GRAPHIC SCALES

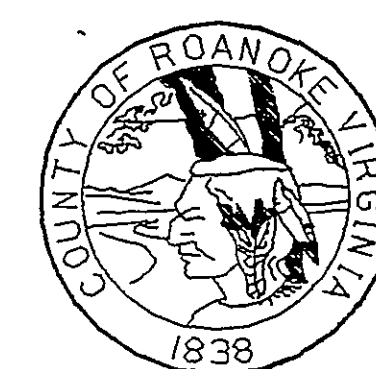[illegible]

SPRING HOLLOW RESERVOIR
ROANOKE COUNTY, VIRGINIA

HAYES, SEAY, MATTERN & MATTERN, INC.
ARCHITECTS - ENGINEERS - PLANNERS
ROANOKE, VIRGINIA

ELECTRICAL GATE HOUSE AND GALLERY POWER AND LIGHTING

SCALE	DATE	COMM	SHEET	DWG
AS NOTED	8/4/91	4194F	E-5	23