


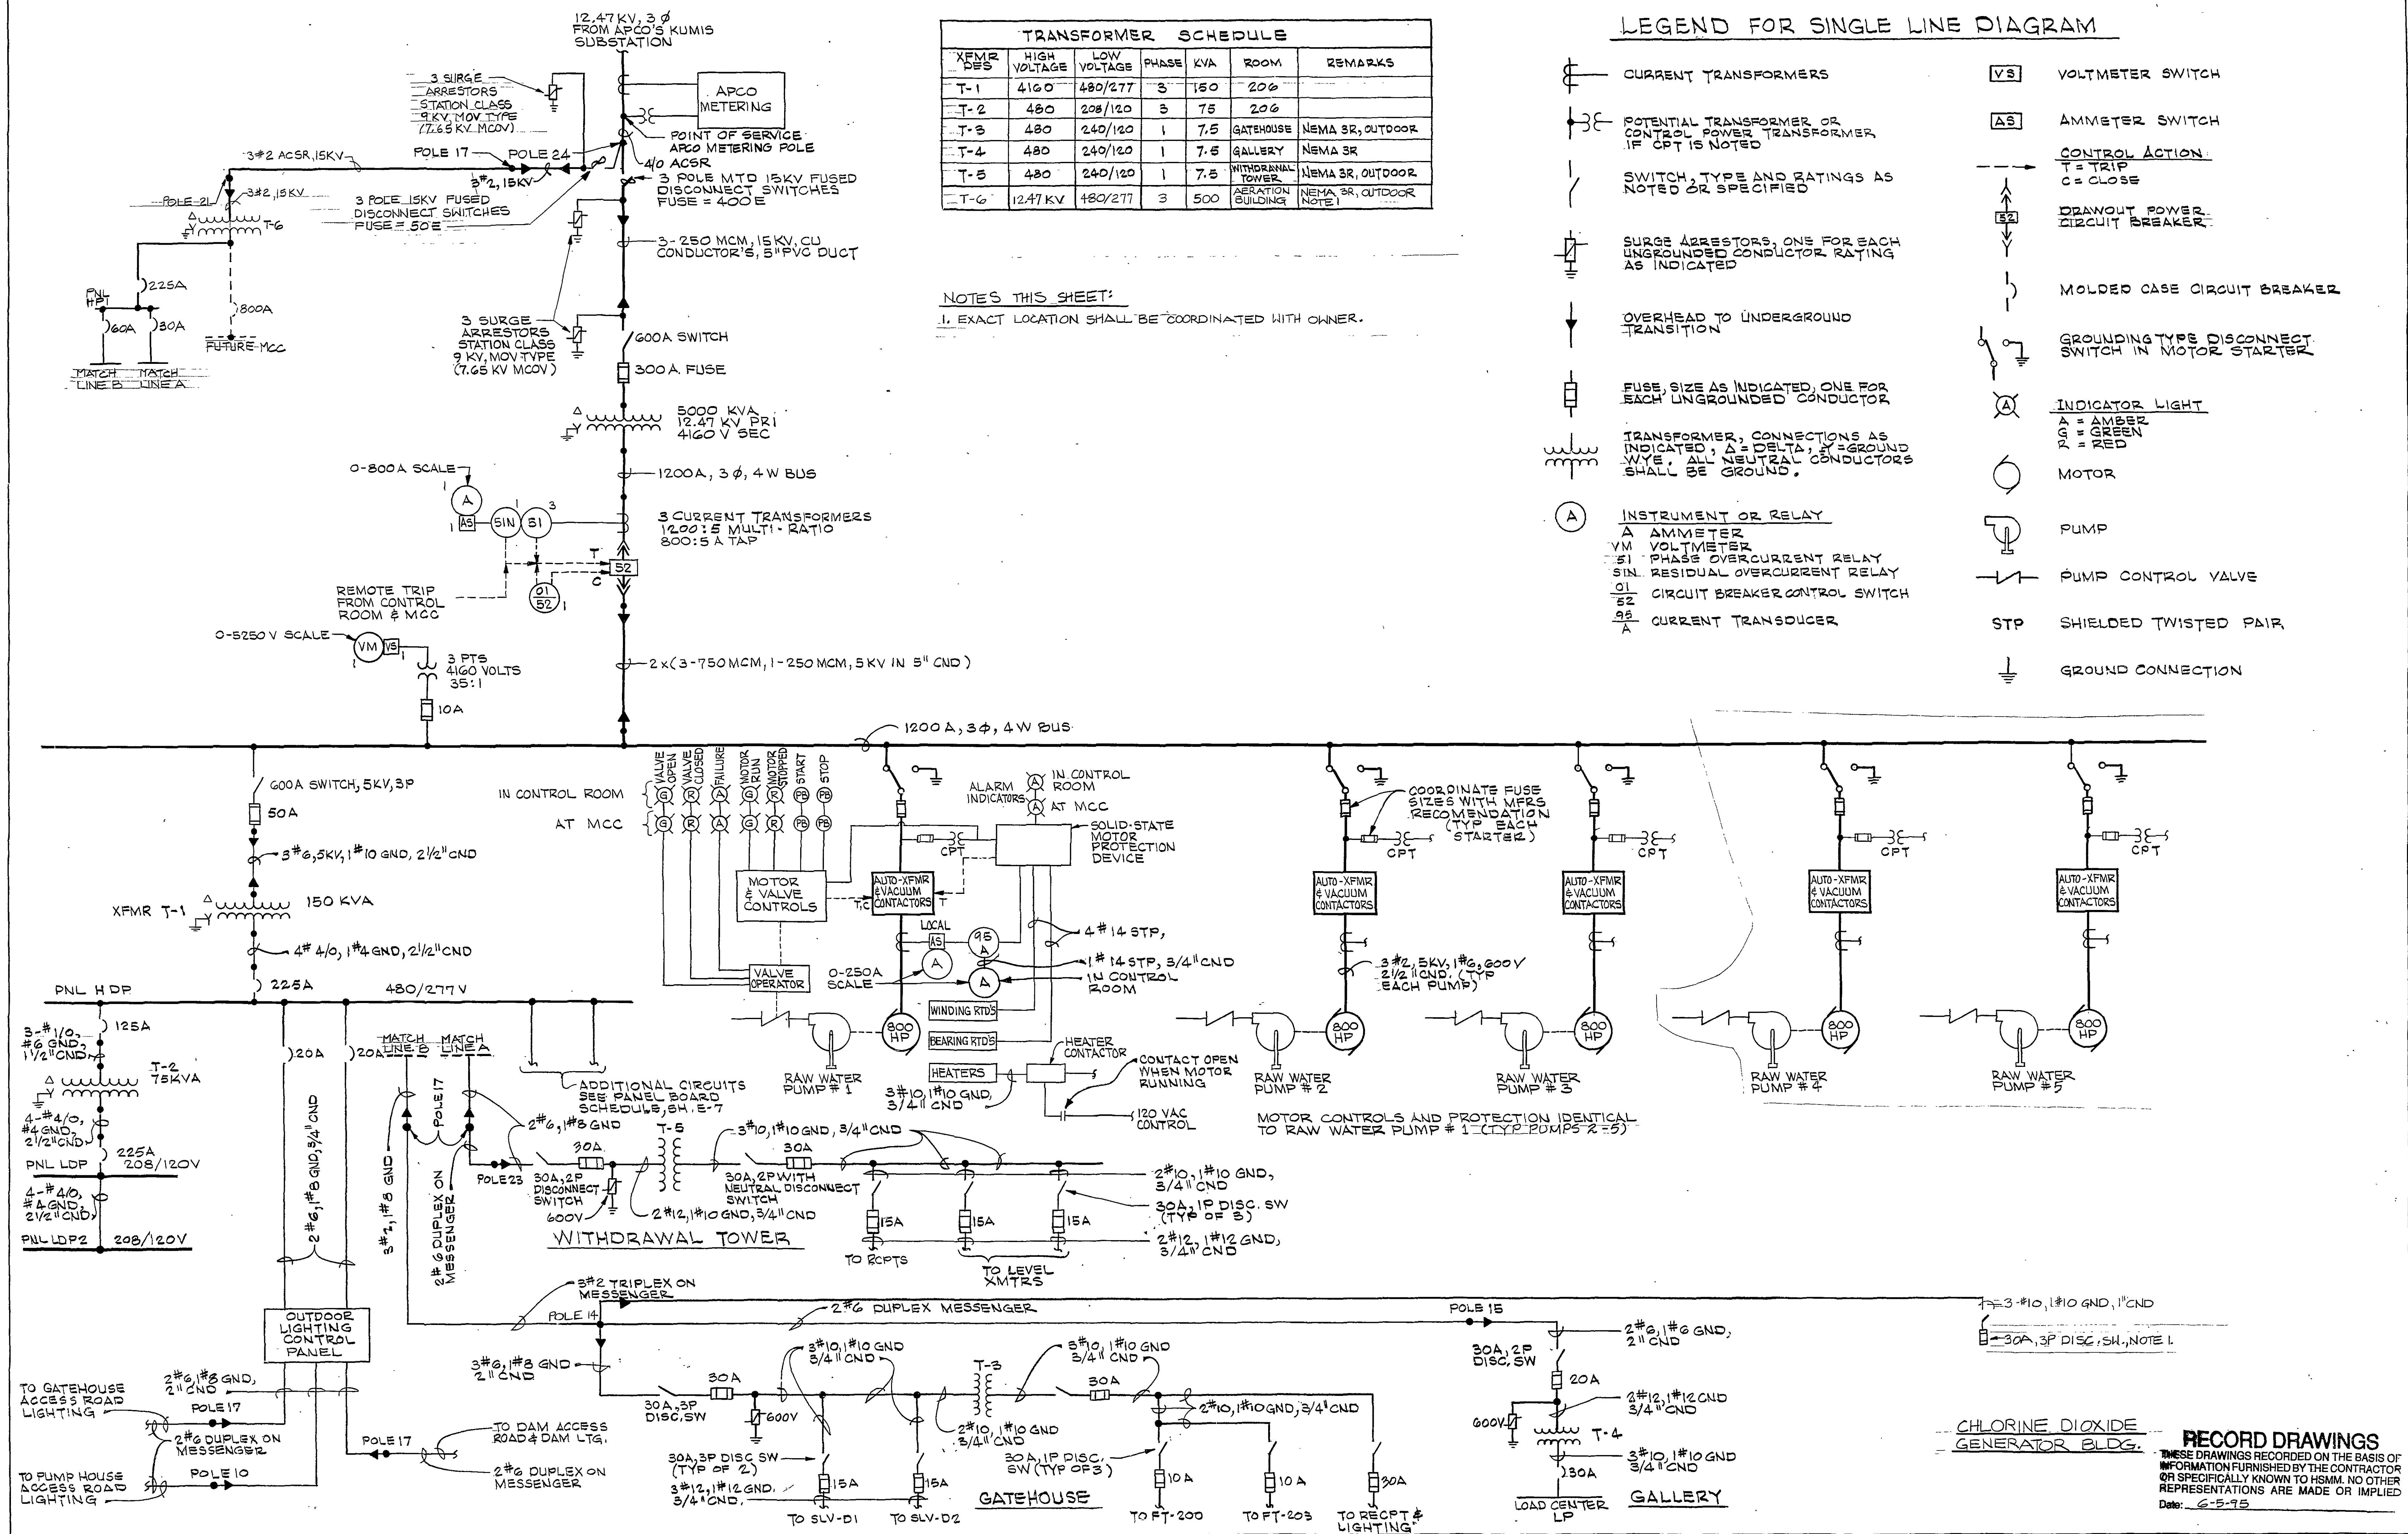

RECORD DRAWINGS
THESE DRAWINGS RECORDED ON THE BASIS OF INFORMATION FURNISHED BY THE CONTRACTOR OR SPECIFICALLY KNOWN TO HSM. NO OTHER REPRESENTATIONS ARE MADE OR IMPLIED.
Date: 6-5-95

DESIGNED <i>1/25</i>	DATE 3/10/90	REVISIONS			
DRAWN <i>RCS RHB</i>	DATE 3/30/90	DATE	BY	DESCRIPTION	DATE
CHECKED <i>RHB</i>	DATE 3/30/90	6/28/95	RHB	Δ ONE-LINE DIAG, XFMR SCHEDULE	
APPROVED <i>RHB</i>	DATE 8/4/91	6/5/94	BA	PER CONTR RECORD DNG	
ISSUED <i>1/25</i>	DATE 5/21/91	6-5-95	JBH	ISSUED TO VA DAM SAFETY	
		8-31-97	RWF	RECORD DRAWING	

SPRING HOLLOW RESERVOIR
ROANOKE COUNTY, VIRGINIA

HAYES, SEAY, MATTERN & MATTERN, INC.
ARCHITECTS - ENGINEERS - PLANNERS
ROANOKE, VIRGINIA

SCALE	DATE	COMM	SHEET	DWG
NONE	8/4/91	4194E	E-6	24