
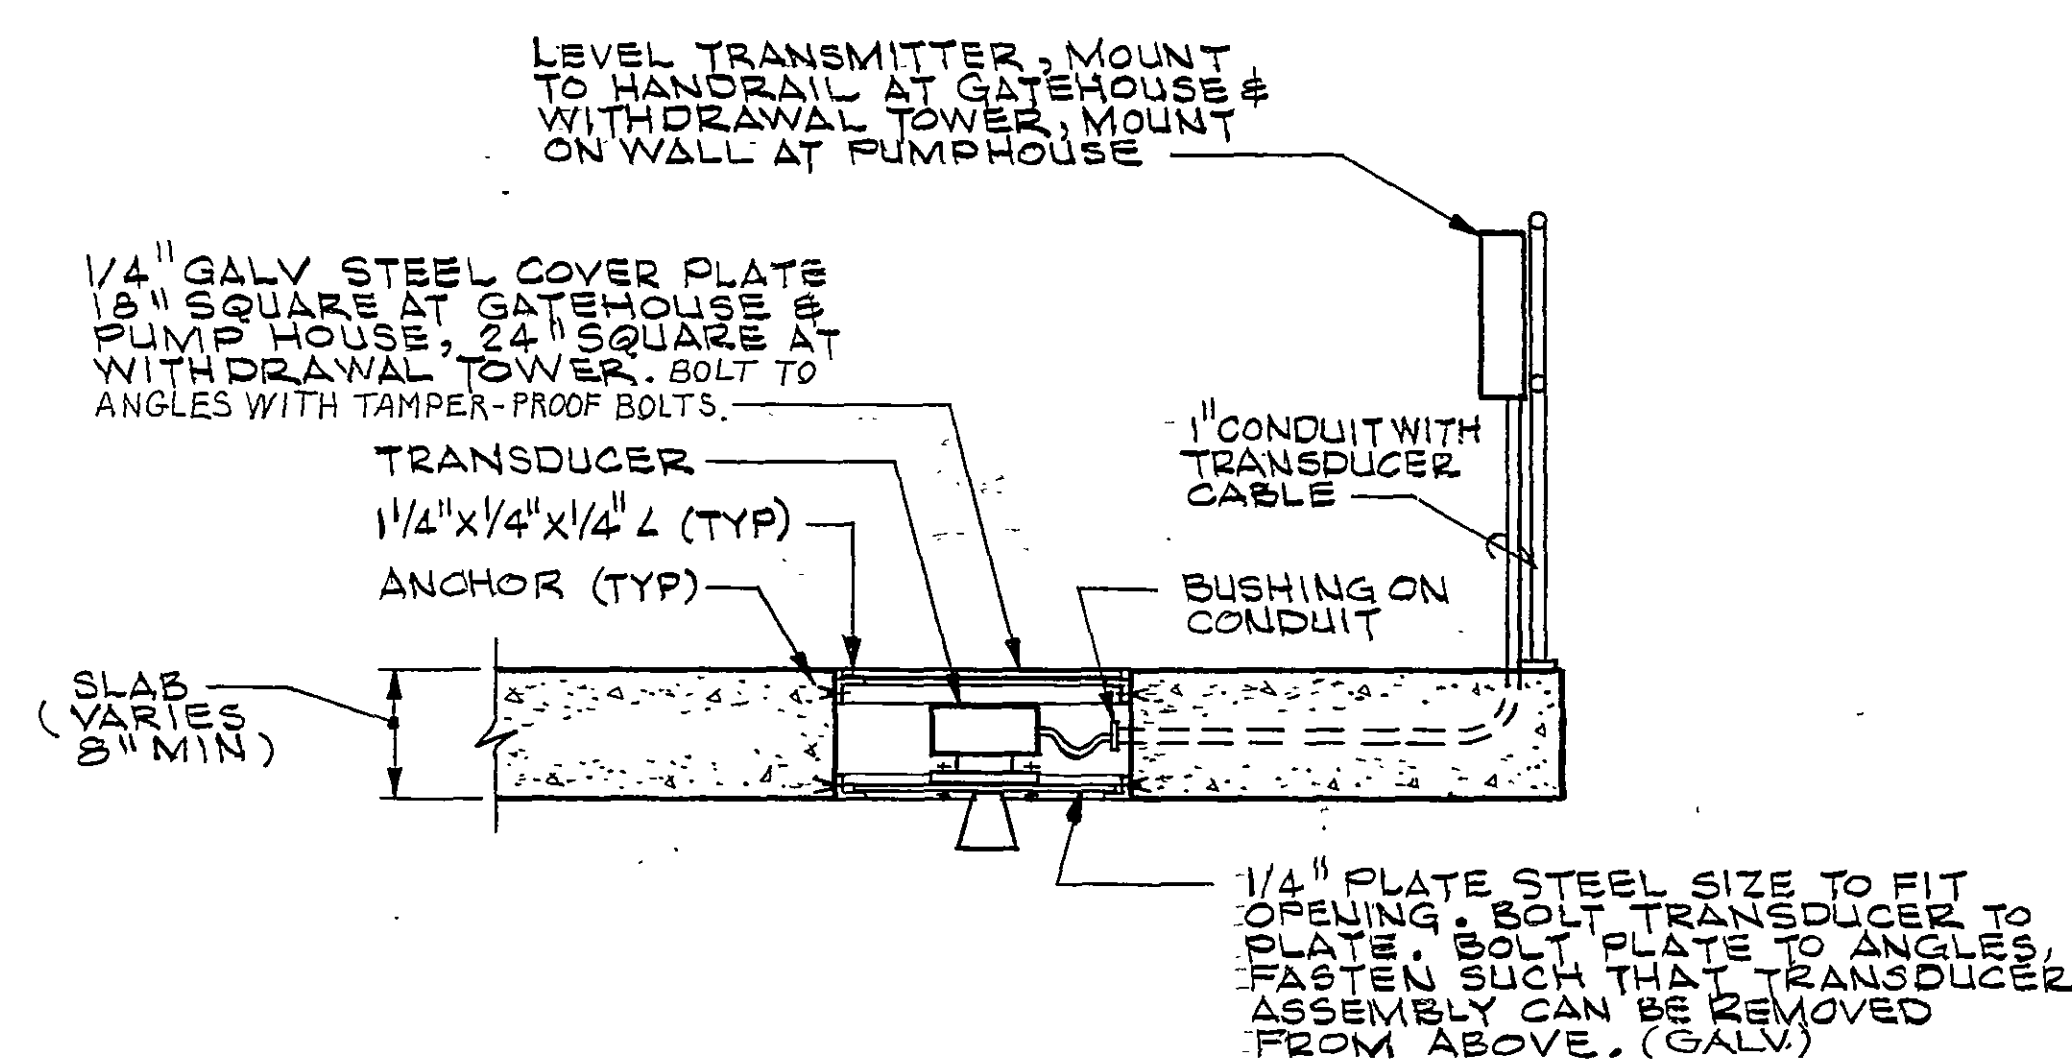
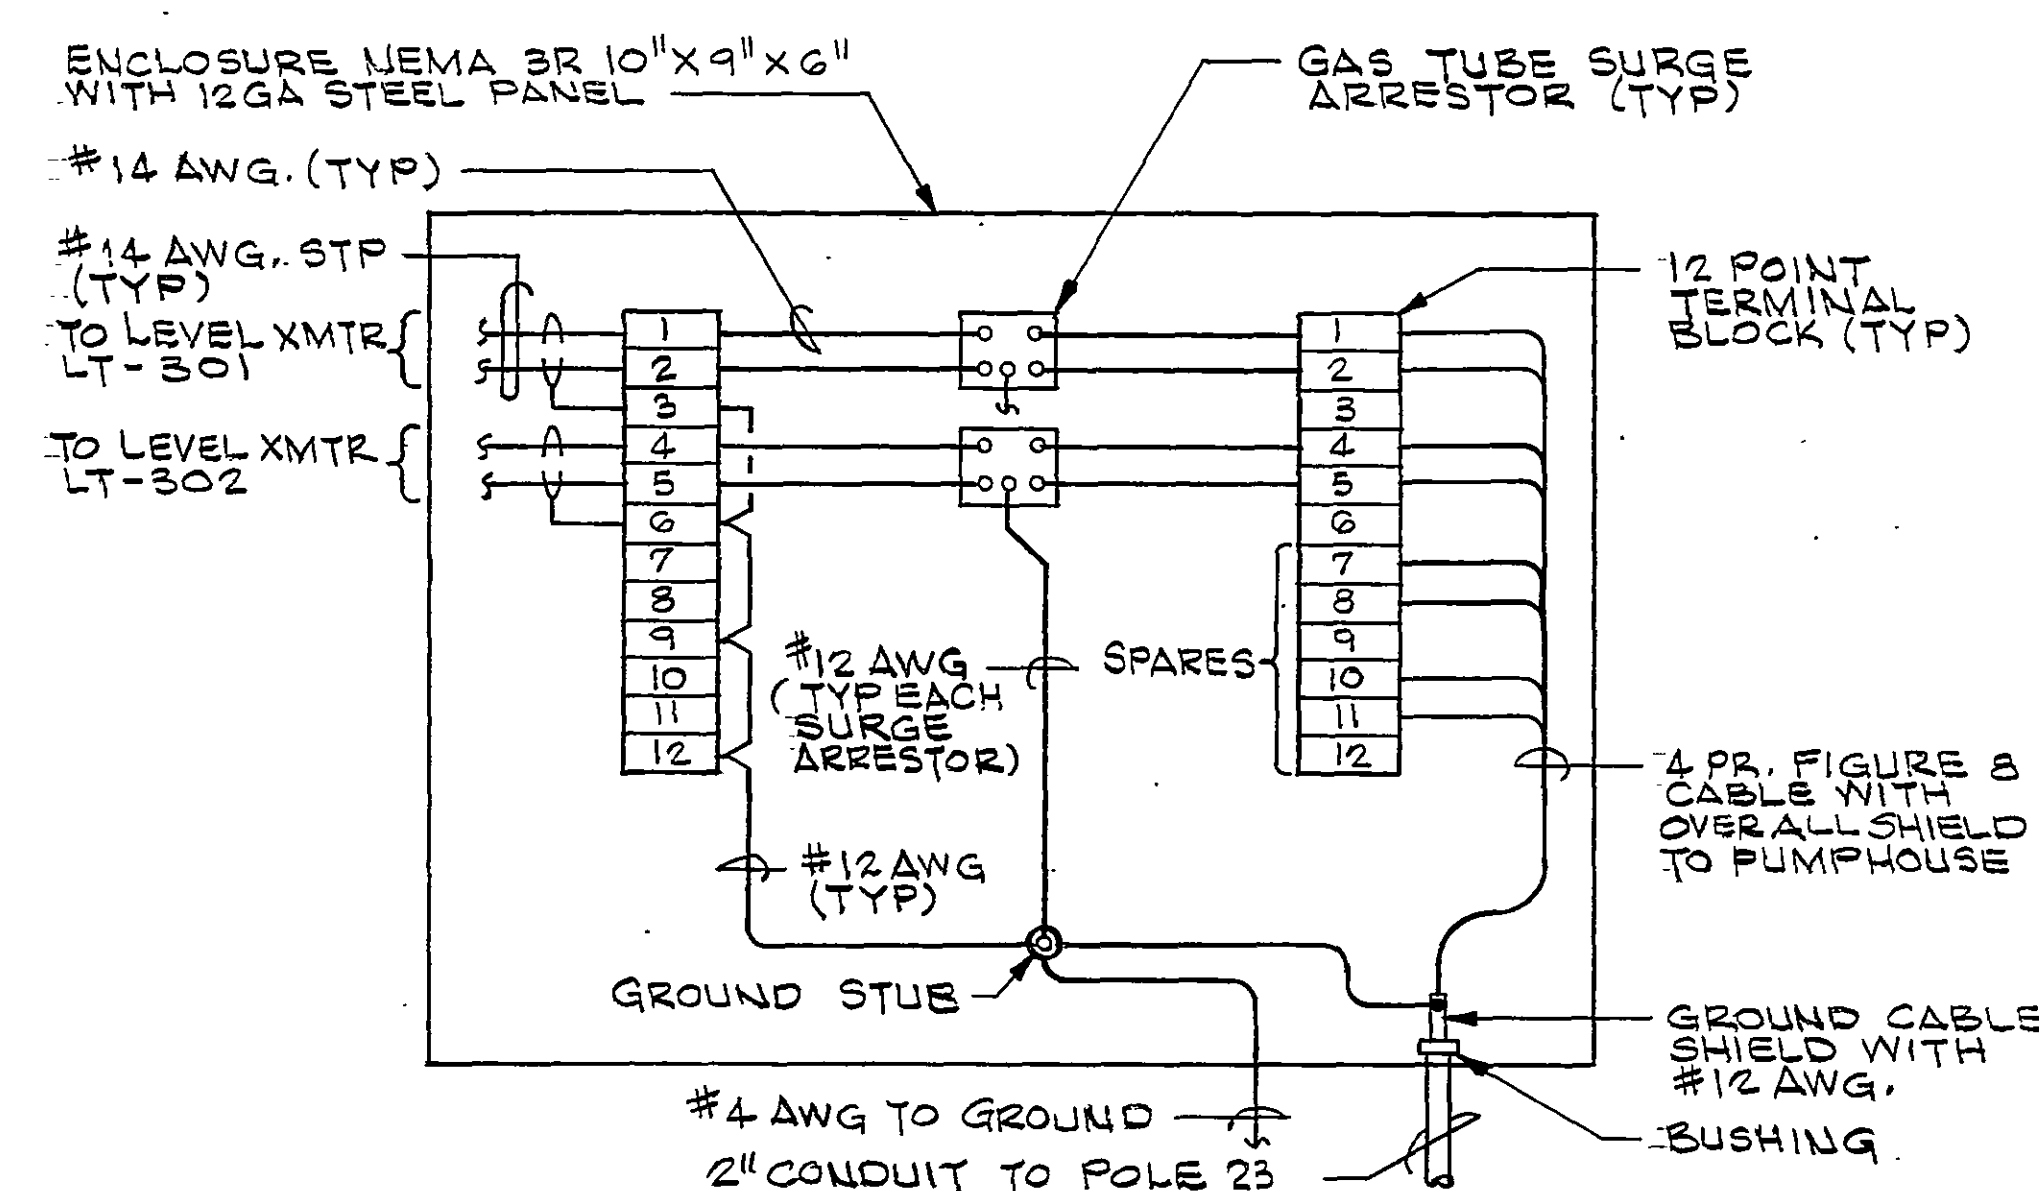
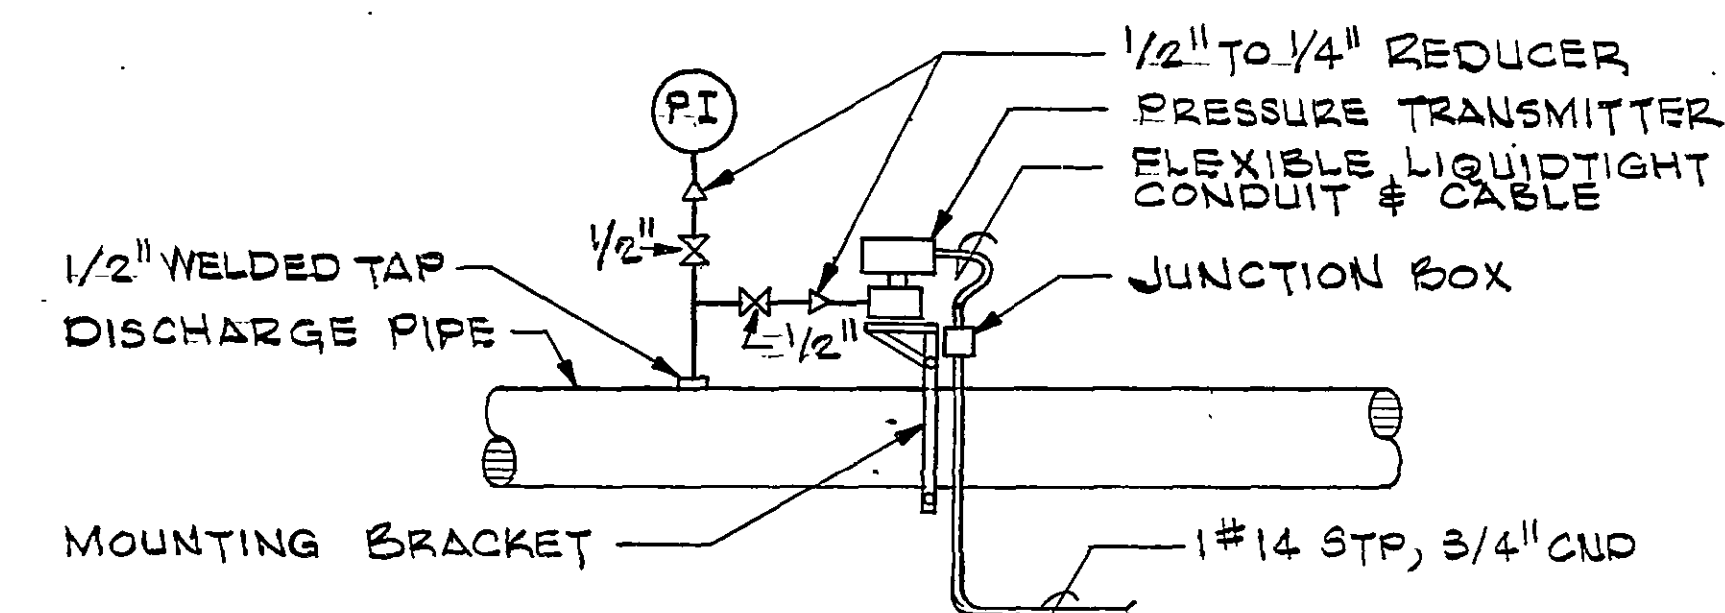
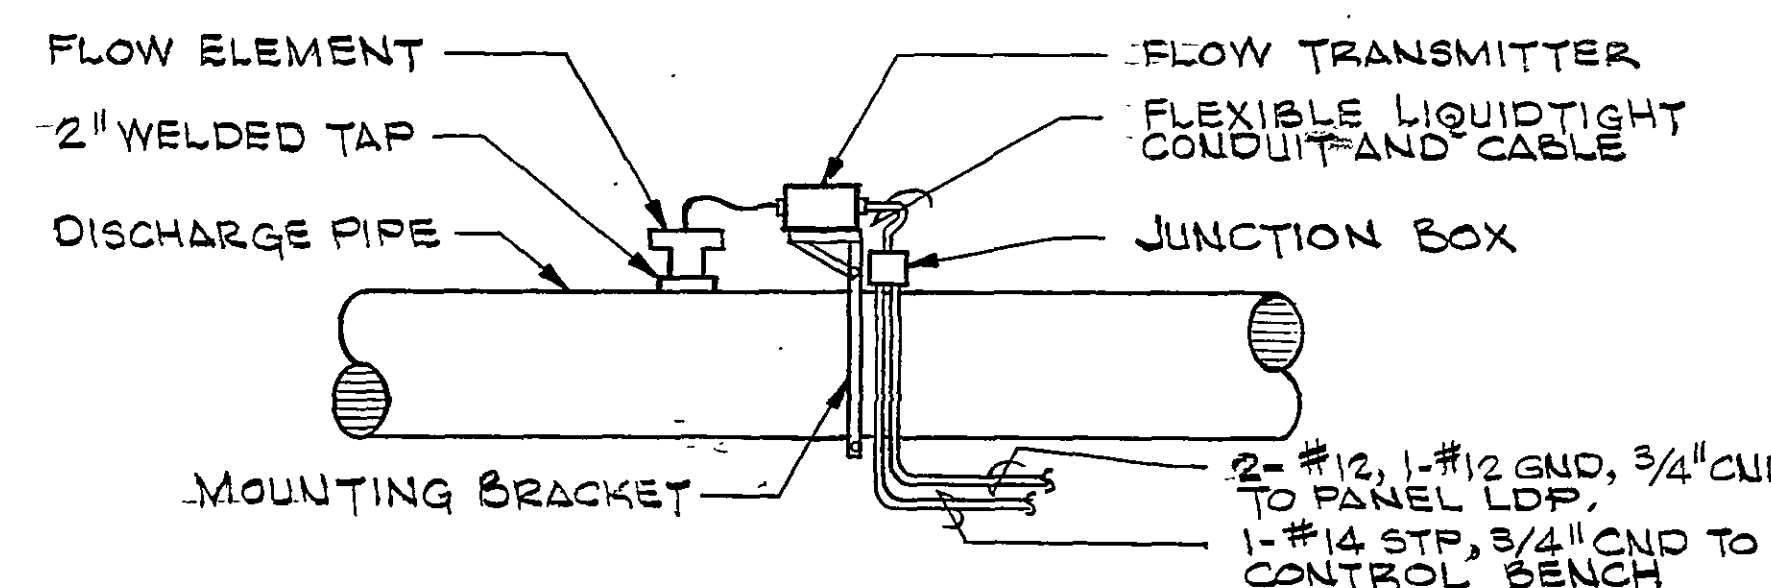
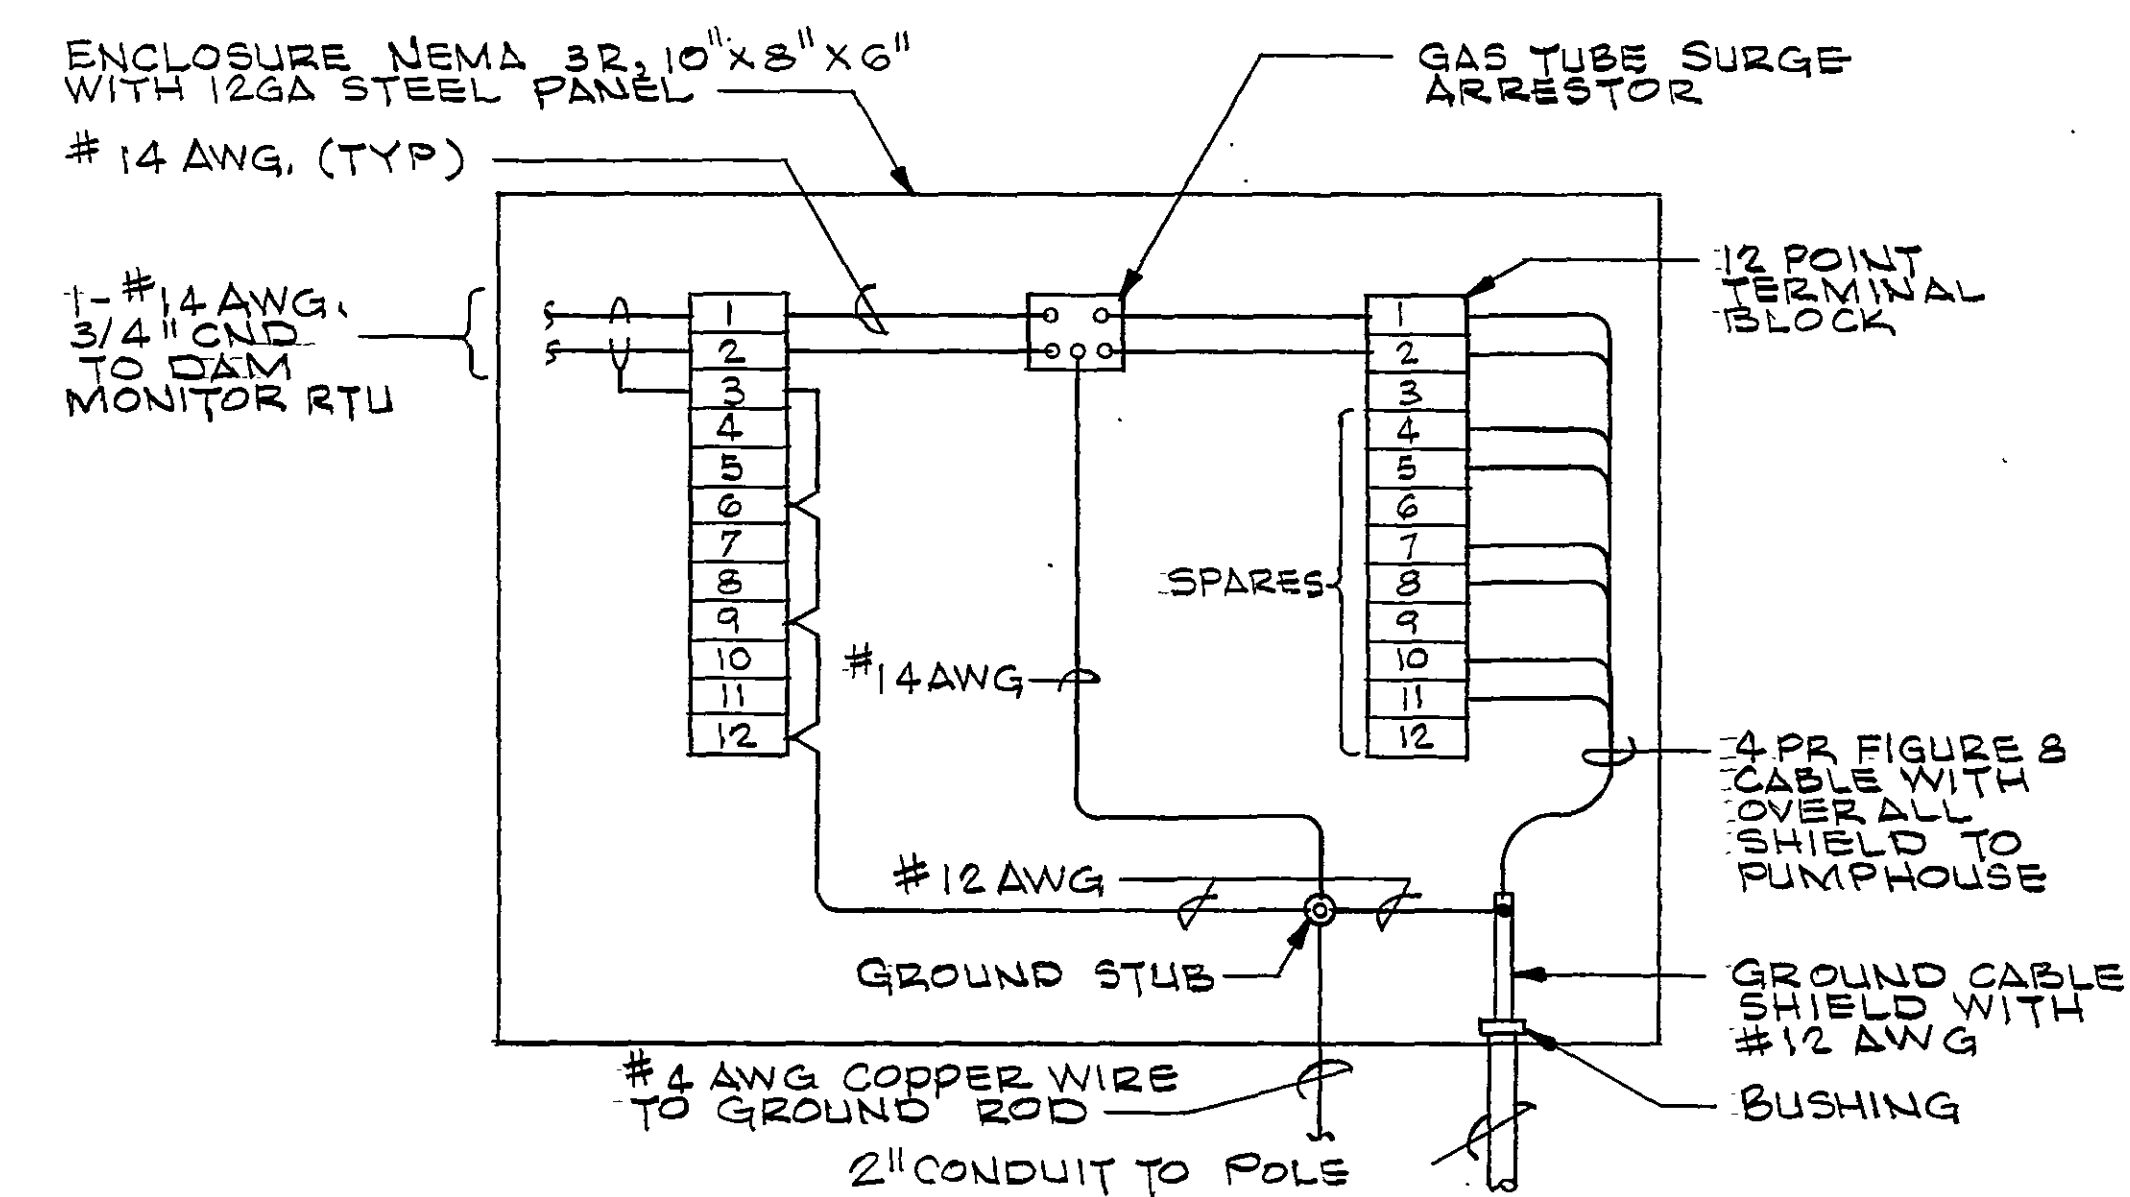
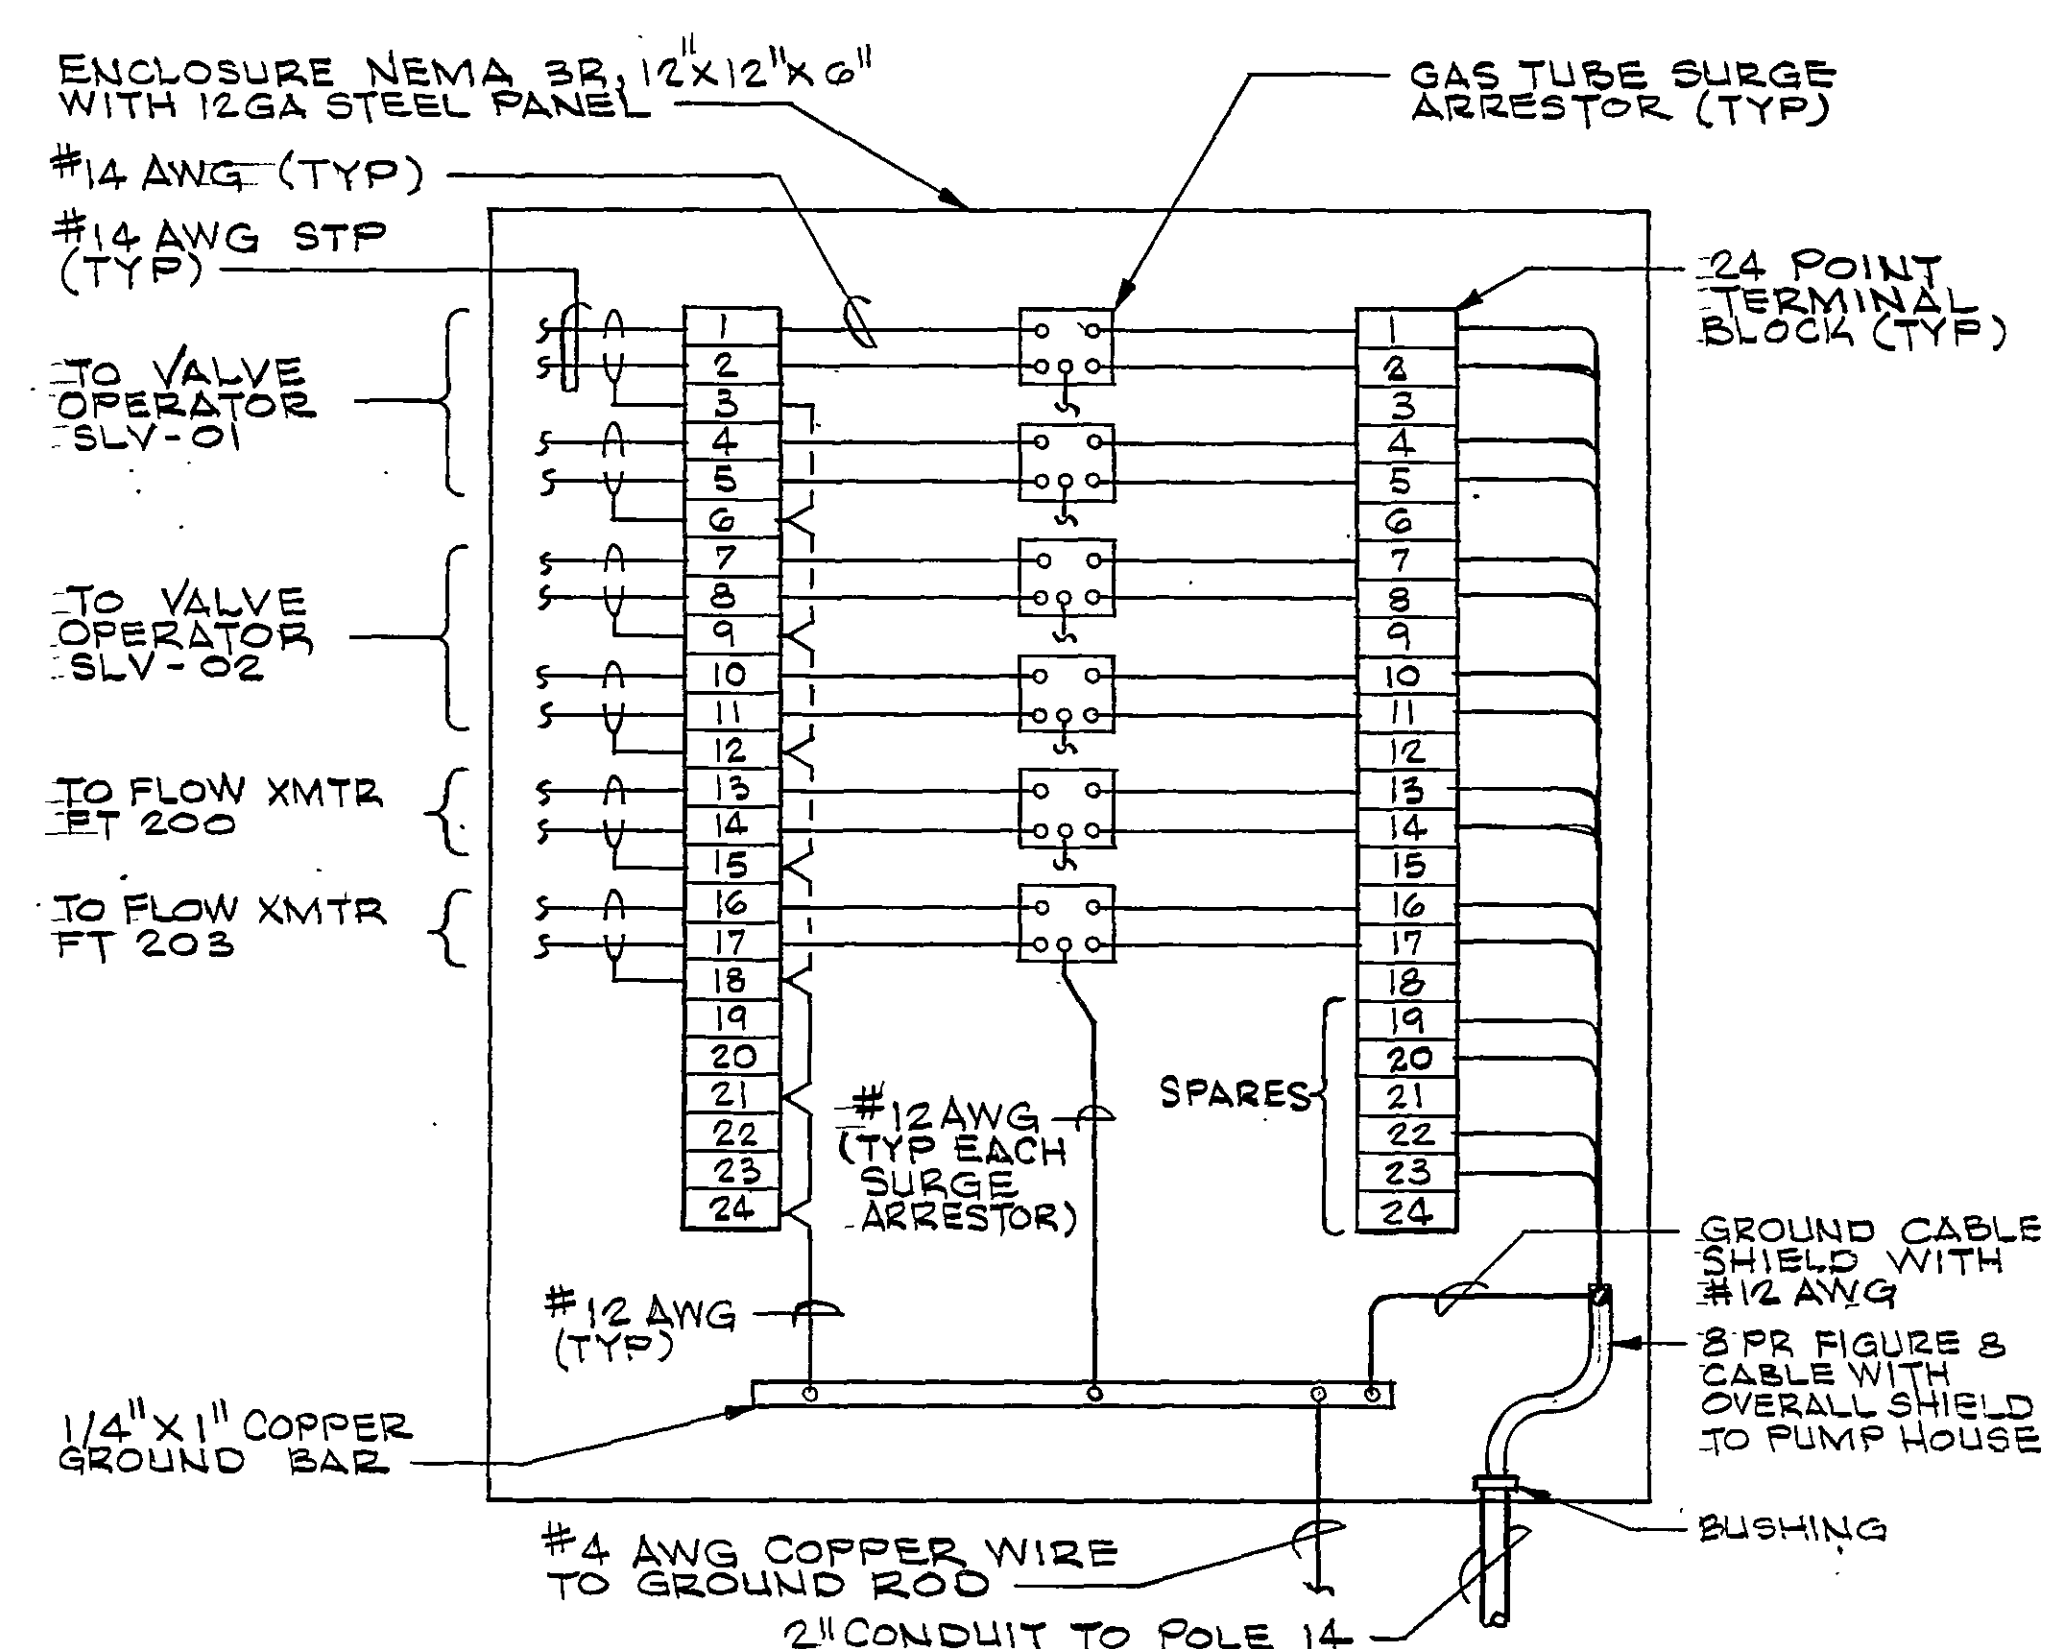
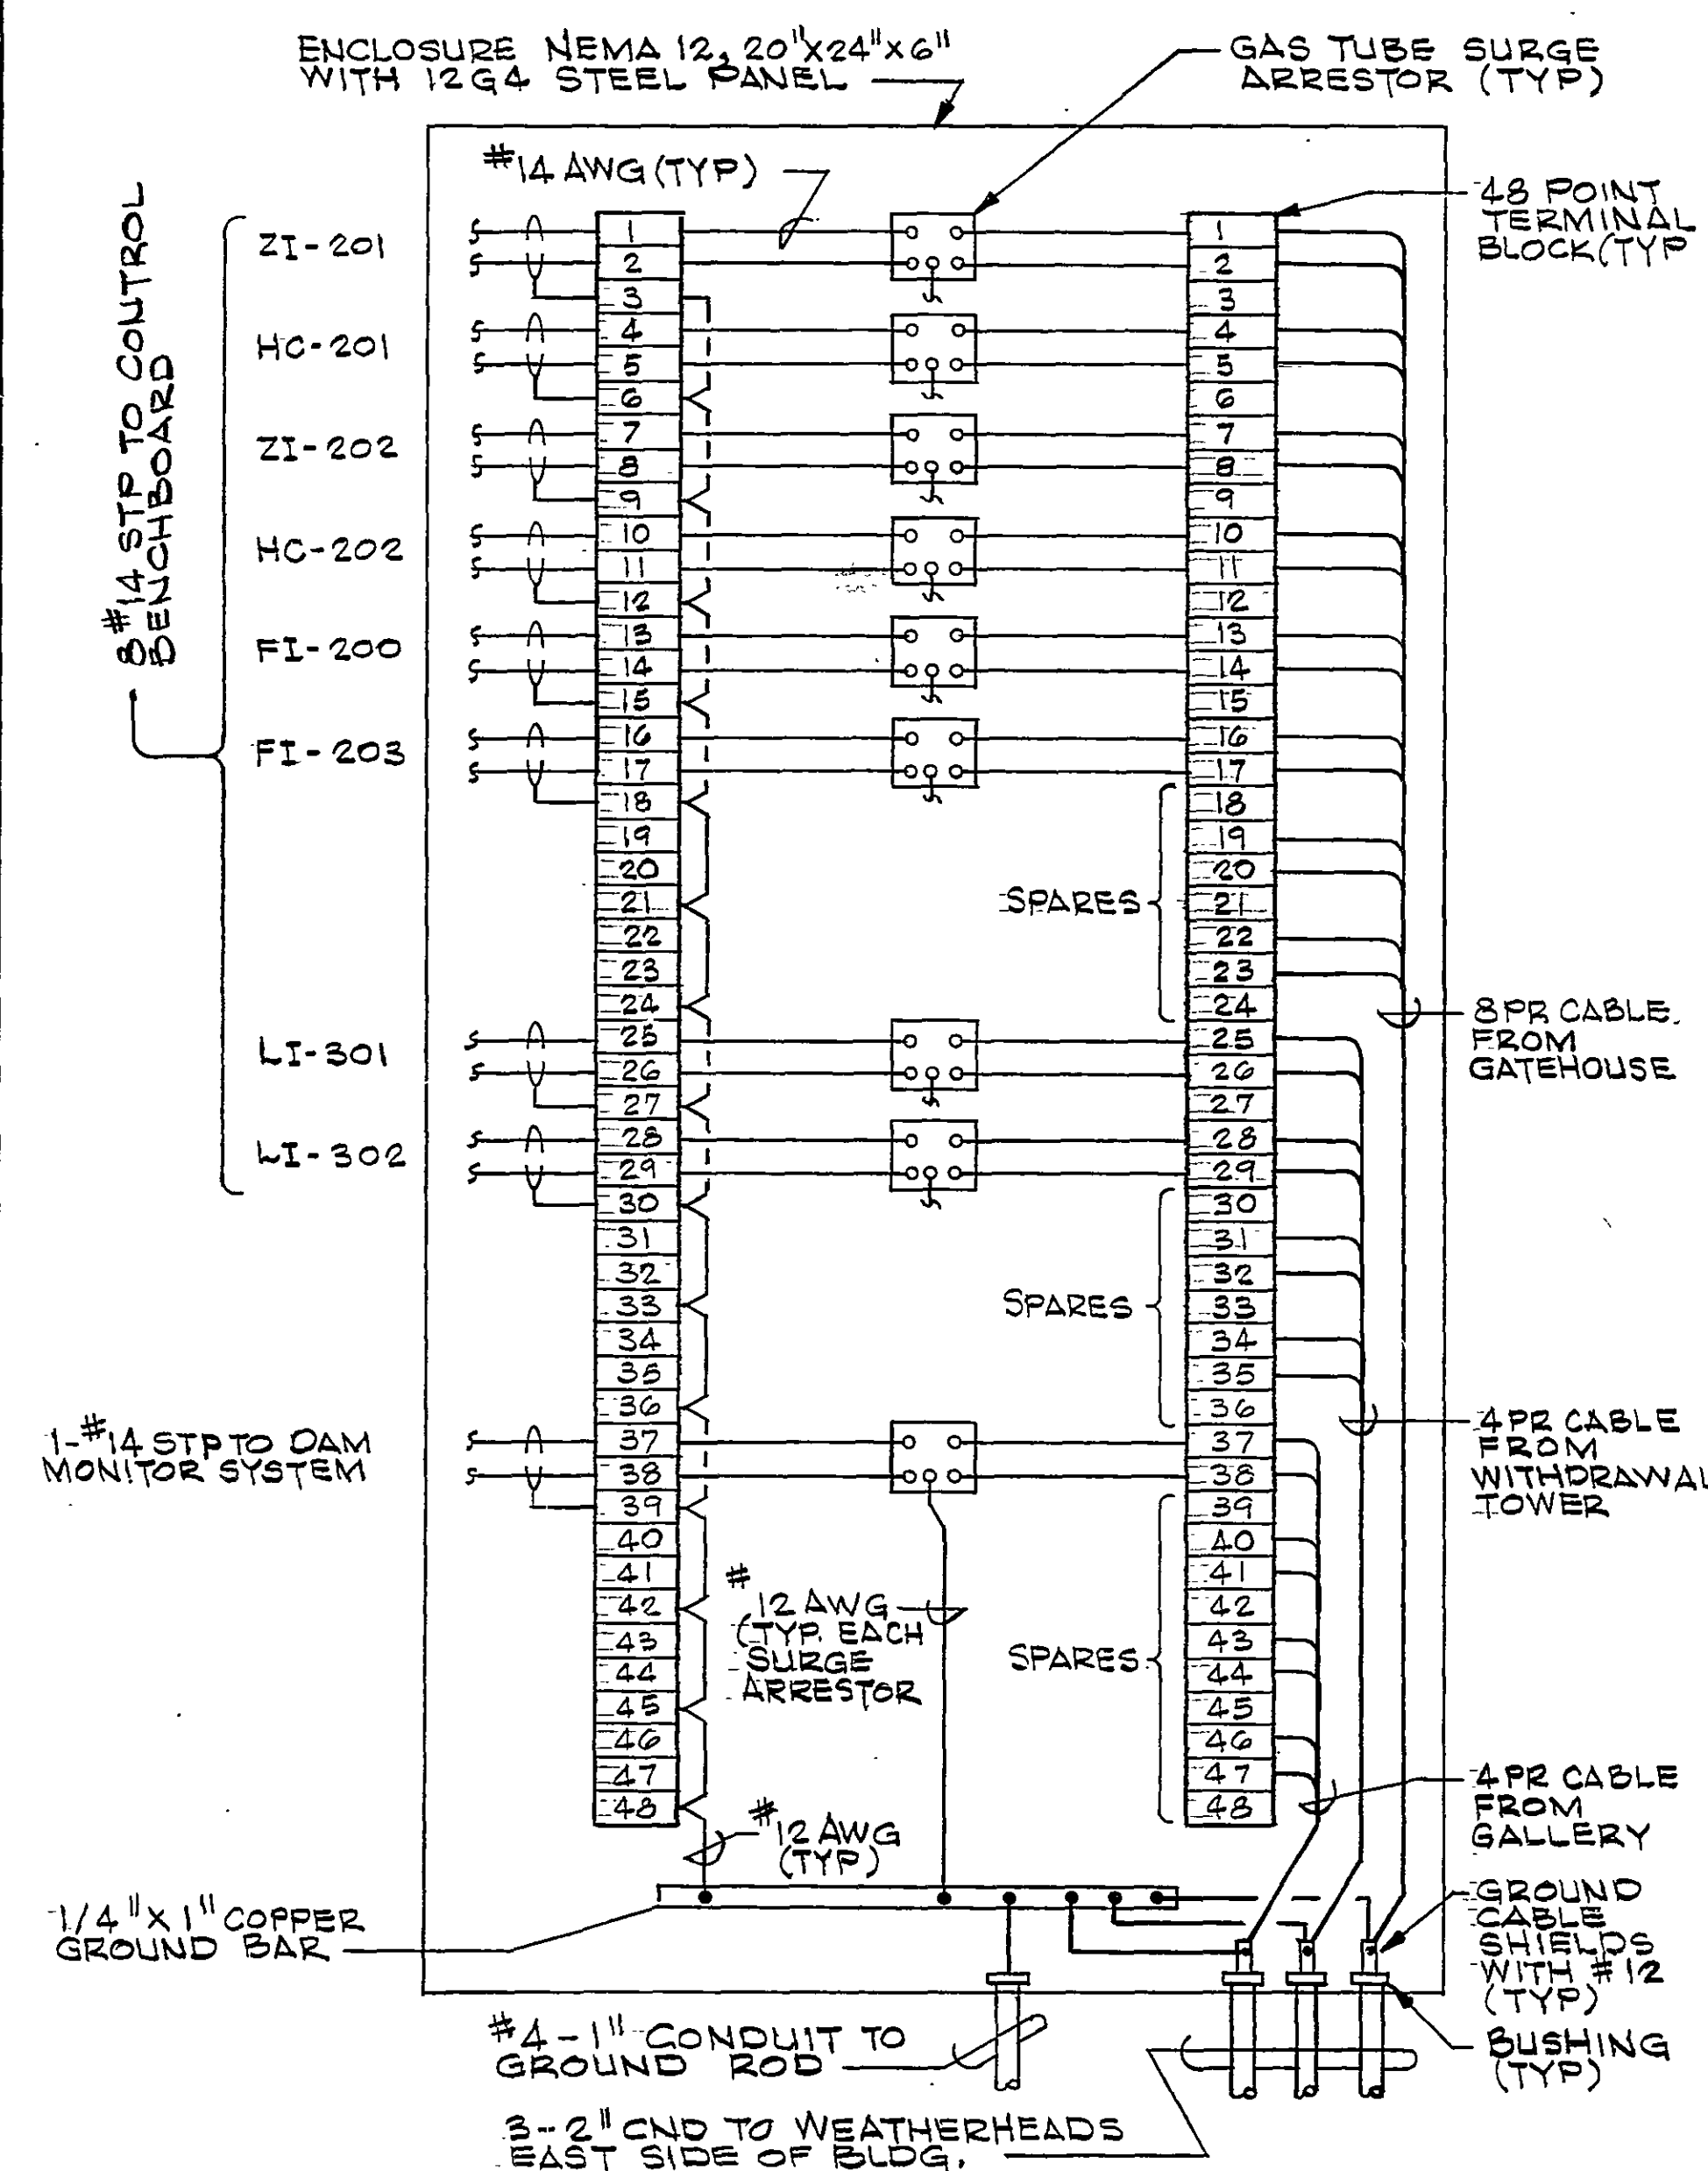
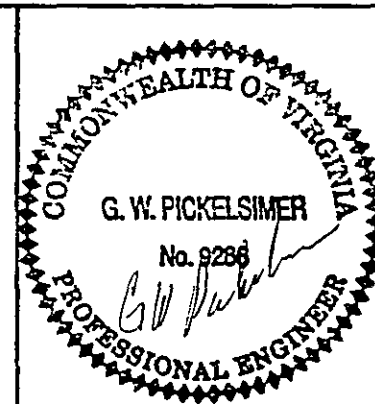


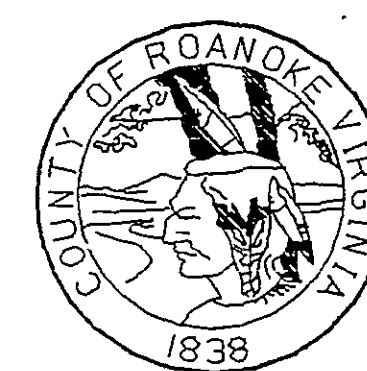

RECORD DRAWINGS
THESE DRAWINGS RECORDED ON THE BASIS OF
INFORMATION FURNISHED BY THE CONTRACTOR
OR SPECIFICALLY KNOWN TO HSMM. NO OTHER
REPRESENTATIONS ARE MADE OR IMPLIED
Date: 6-5-95

DESIGNED	<u>ESC</u>	DATE	<u>3/30/90</u>
DRAWN	<u>RCS</u>	DATE	<u>3/30/90</u>
CHECKED	<u>flm</u>	DATE	<u>3/30/90</u>
APPROVED	<u>RH2</u>	DATE	<u>8/4/93</u>
ISSUED	<u>APB</u>	DATE	<u>8/21/90</u>

[illegible]

SPRING HOLLOW RESERVOIR
ROANOKE COUNTY, VIRGINIA

HAYES, SEAY, MATTERN & MATTERN, INC.
ARCHITECTS - ENGINEERS - PLANNERS
ROANOKE, VIRGINIA

INSTRUMENTATION DETAILS AND DIAGRAMS				
SCALE NONE	DATE 8/4/91	COMM 4184E	SHEET I-4	DWG 29