



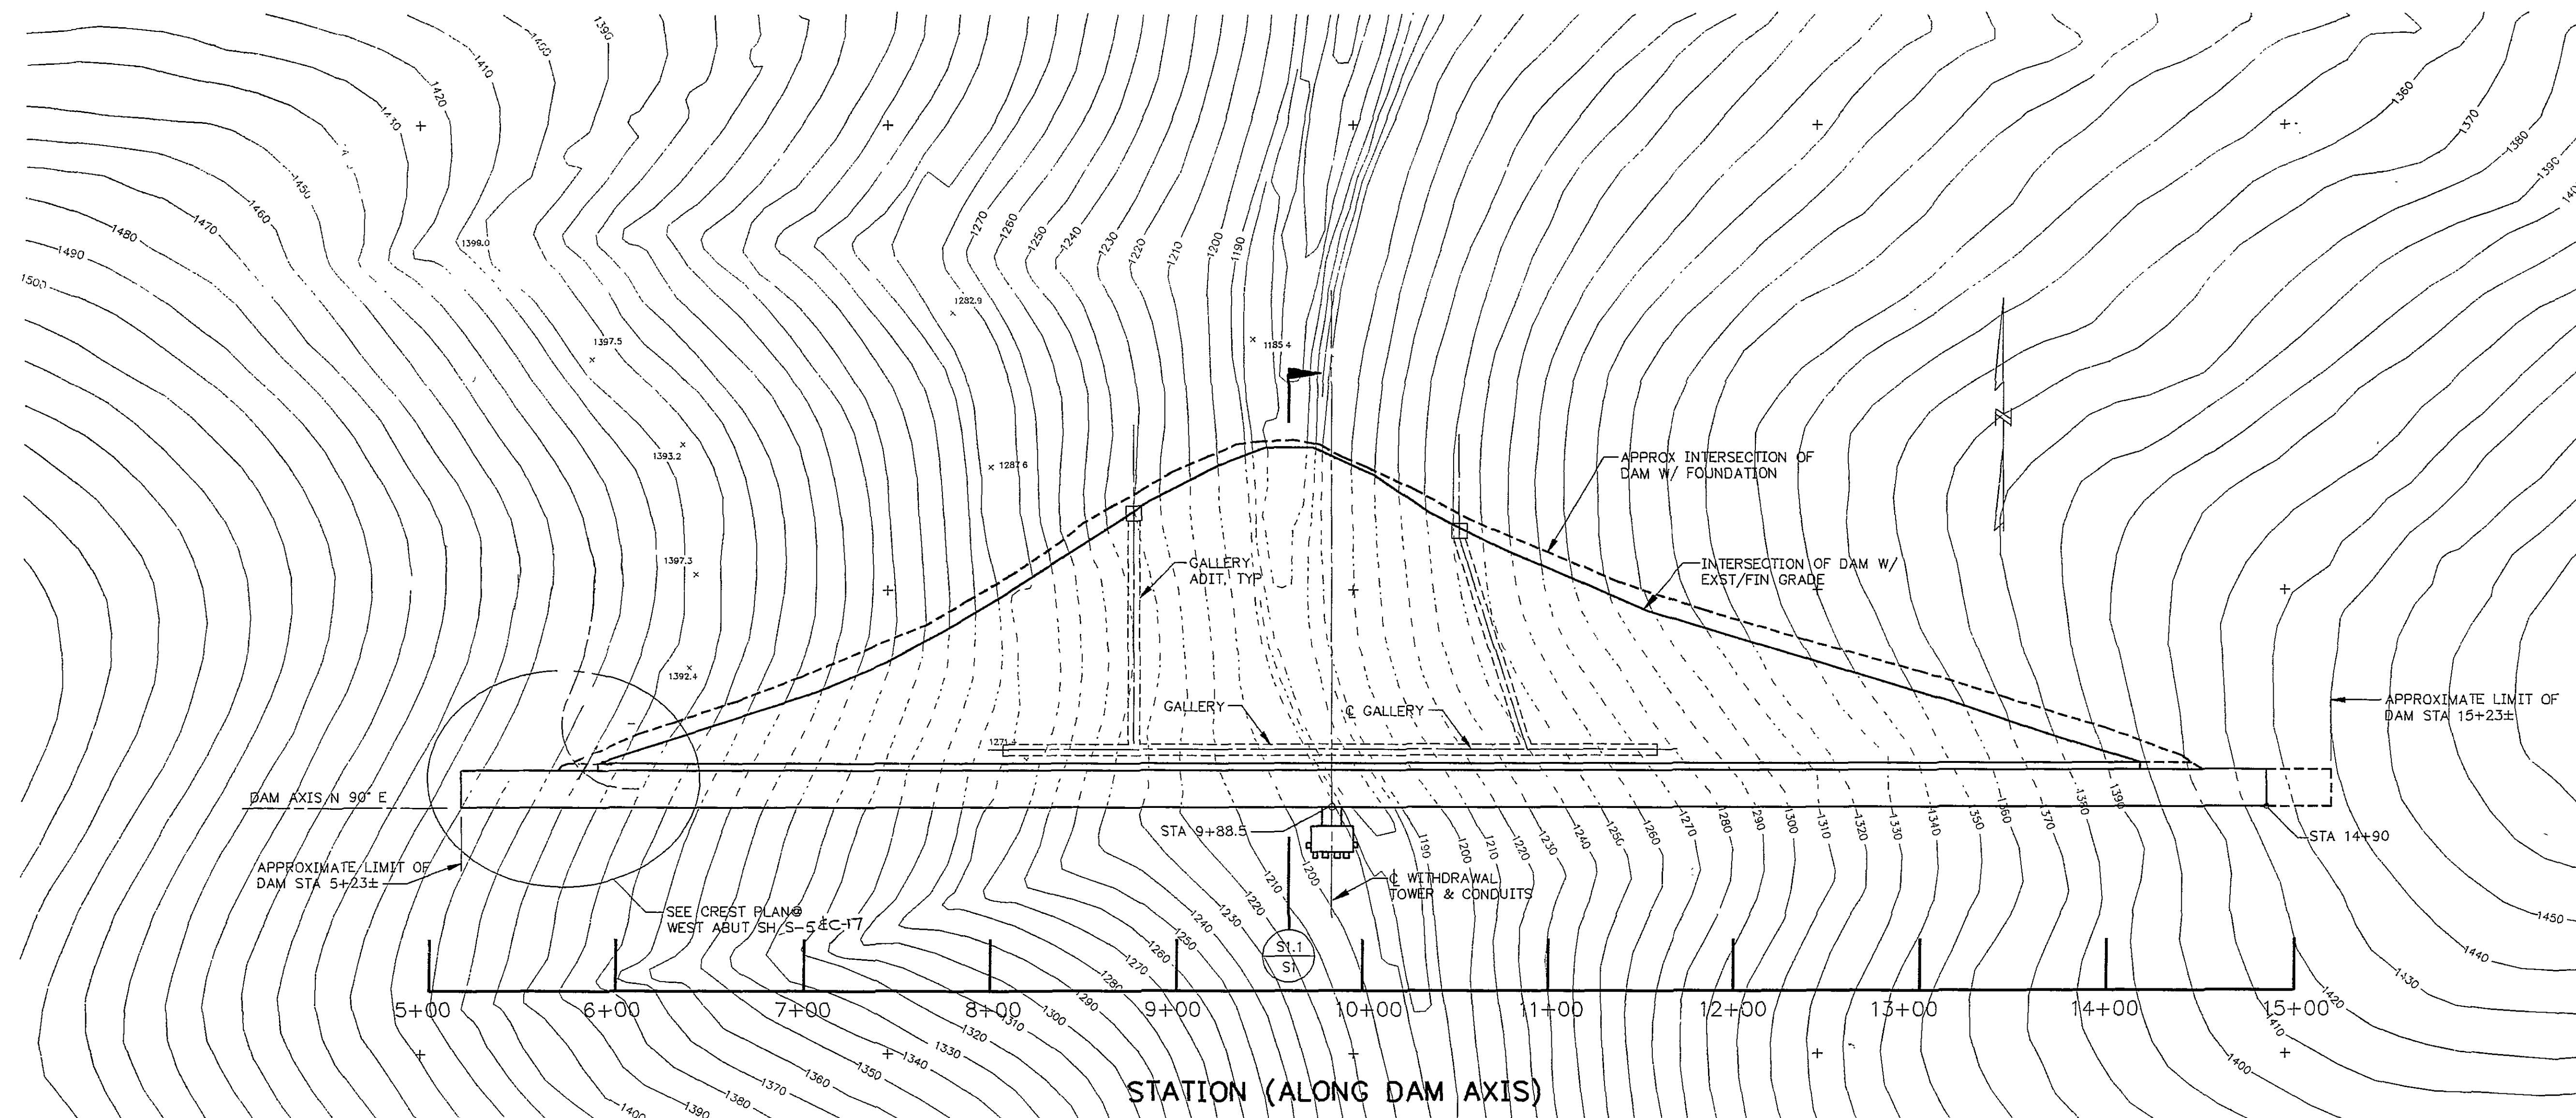


DAM PLAN
SCALE: 1"=50'

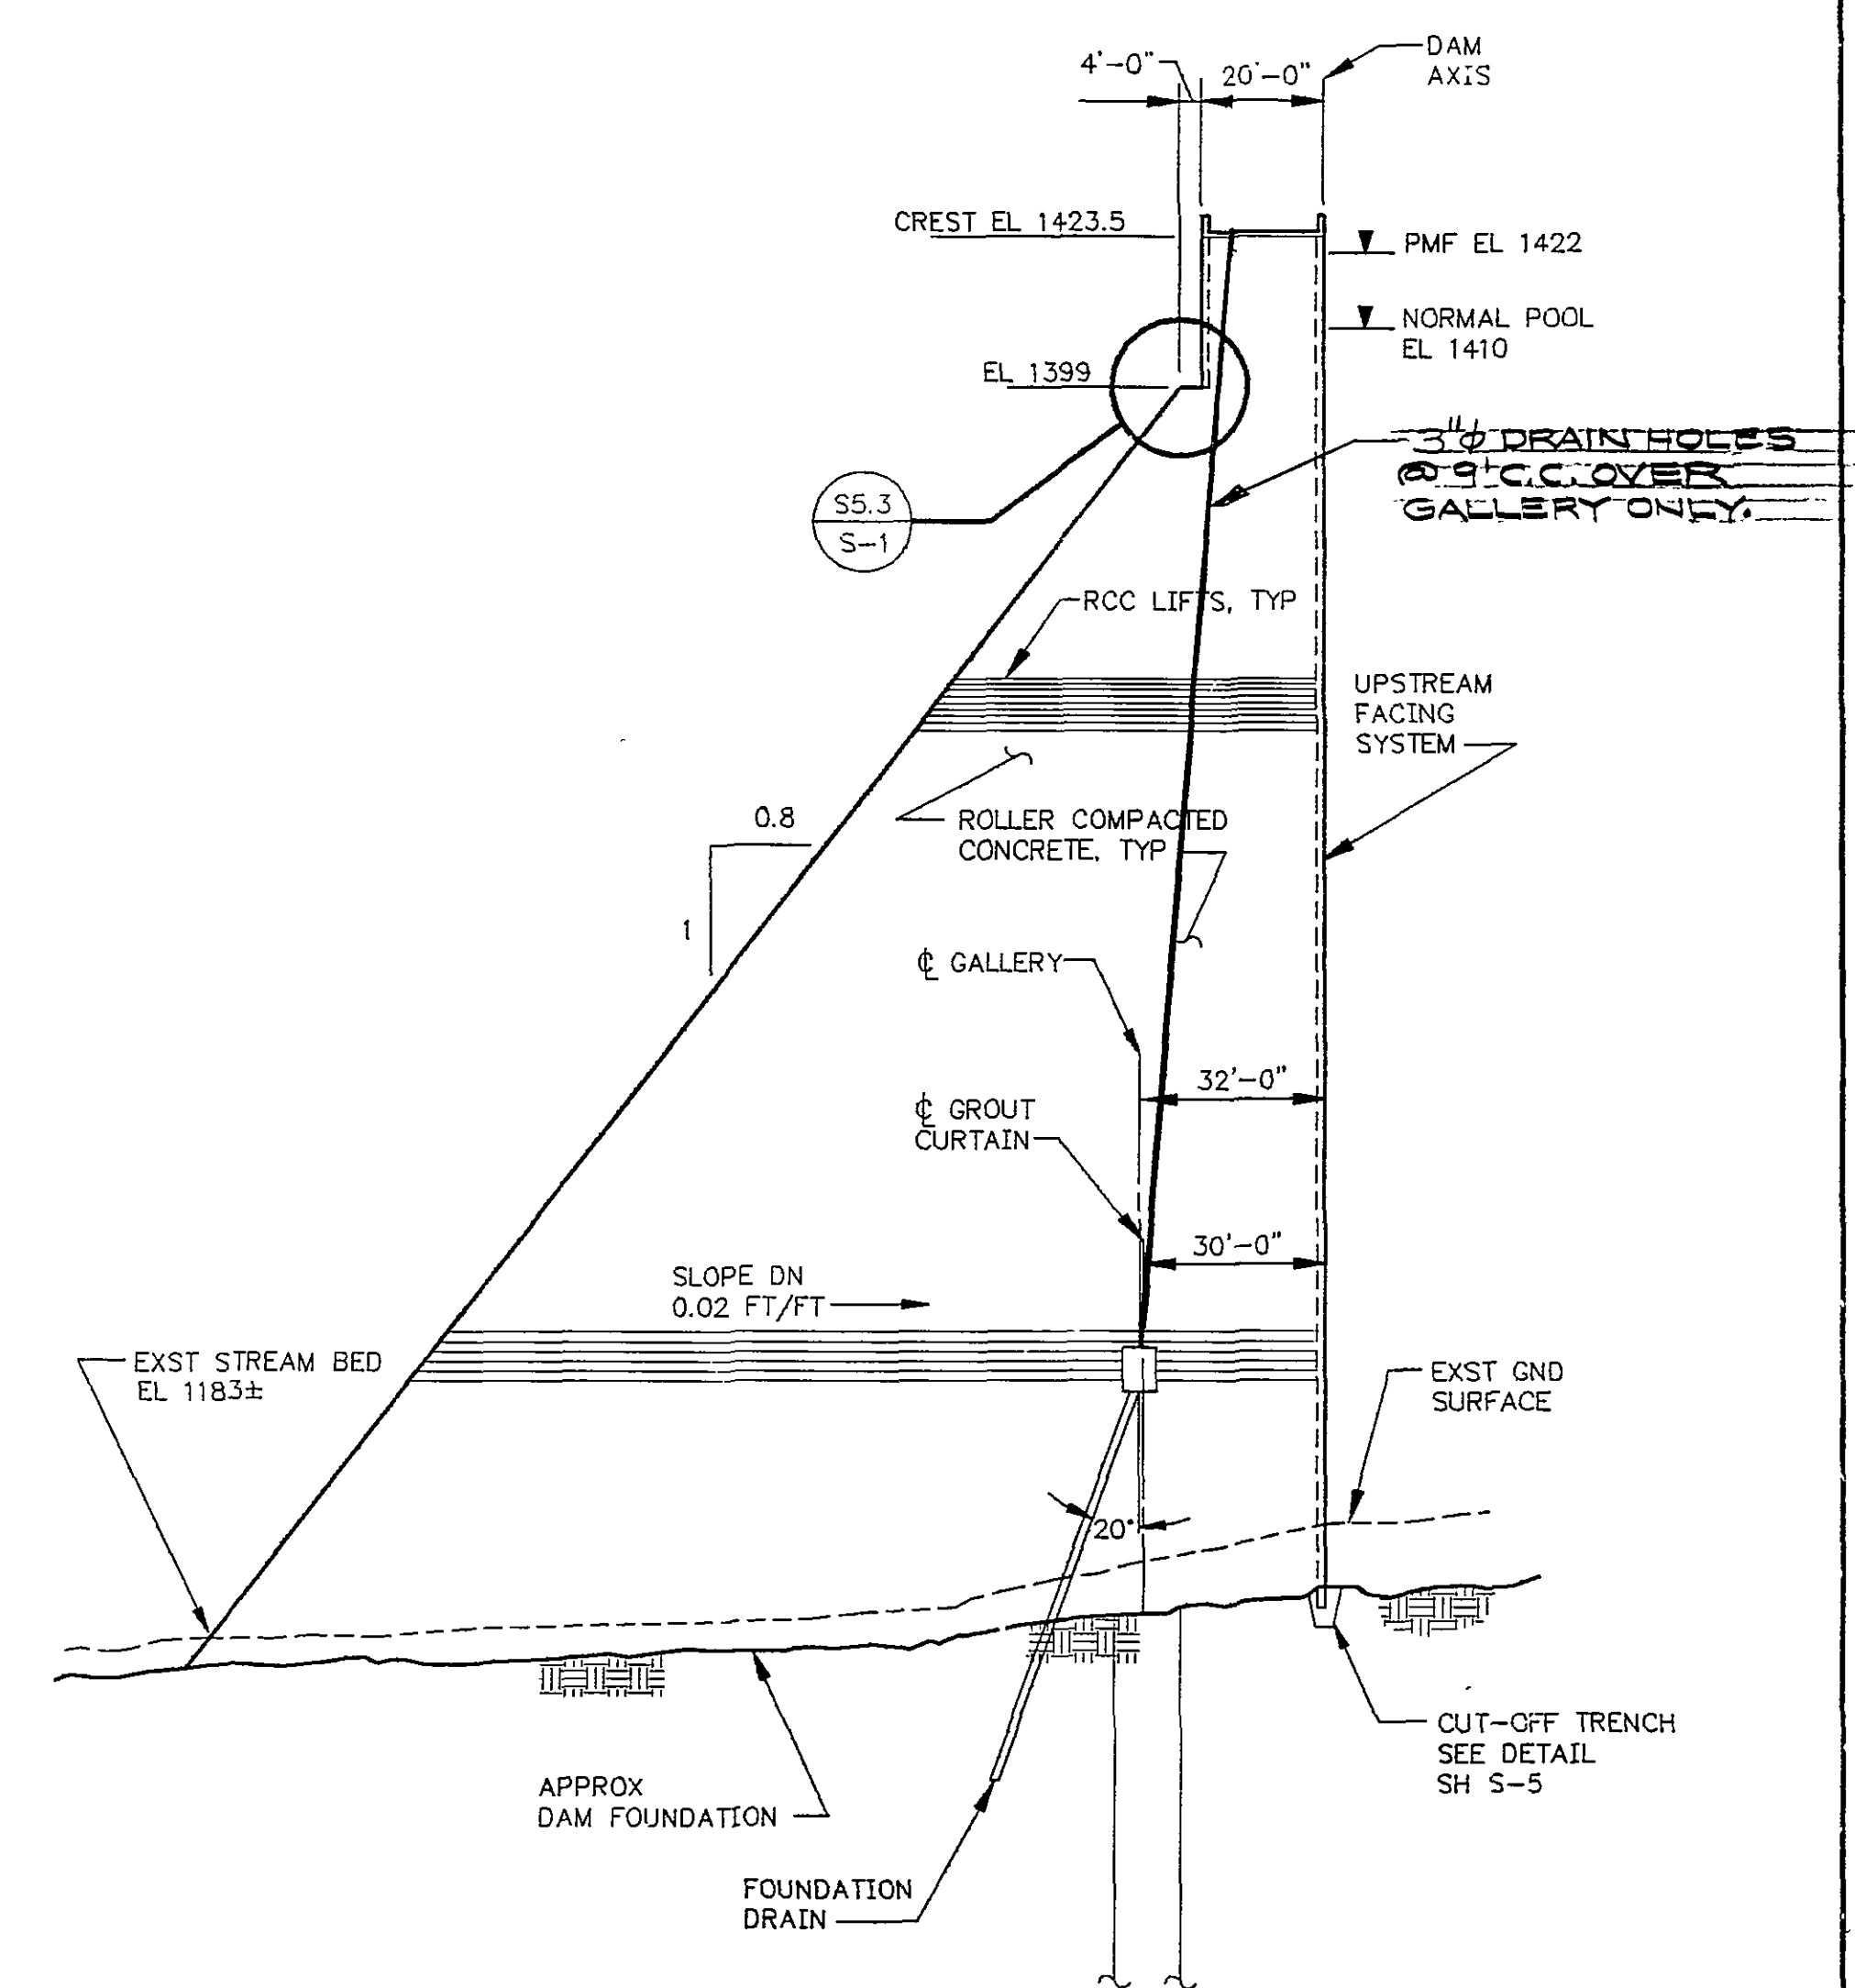

NOTE: 1. SECTION CUT @ STA 9+65.
2. WITHDRAWAL TOWER NOT SHOWN FOR CLARITY, SEE SH S-7.
3. SEE SH S-5 FOR DAM FACING & CREST DETAILS.

MAXIMUM SECTION
SCALE: 1"=30'

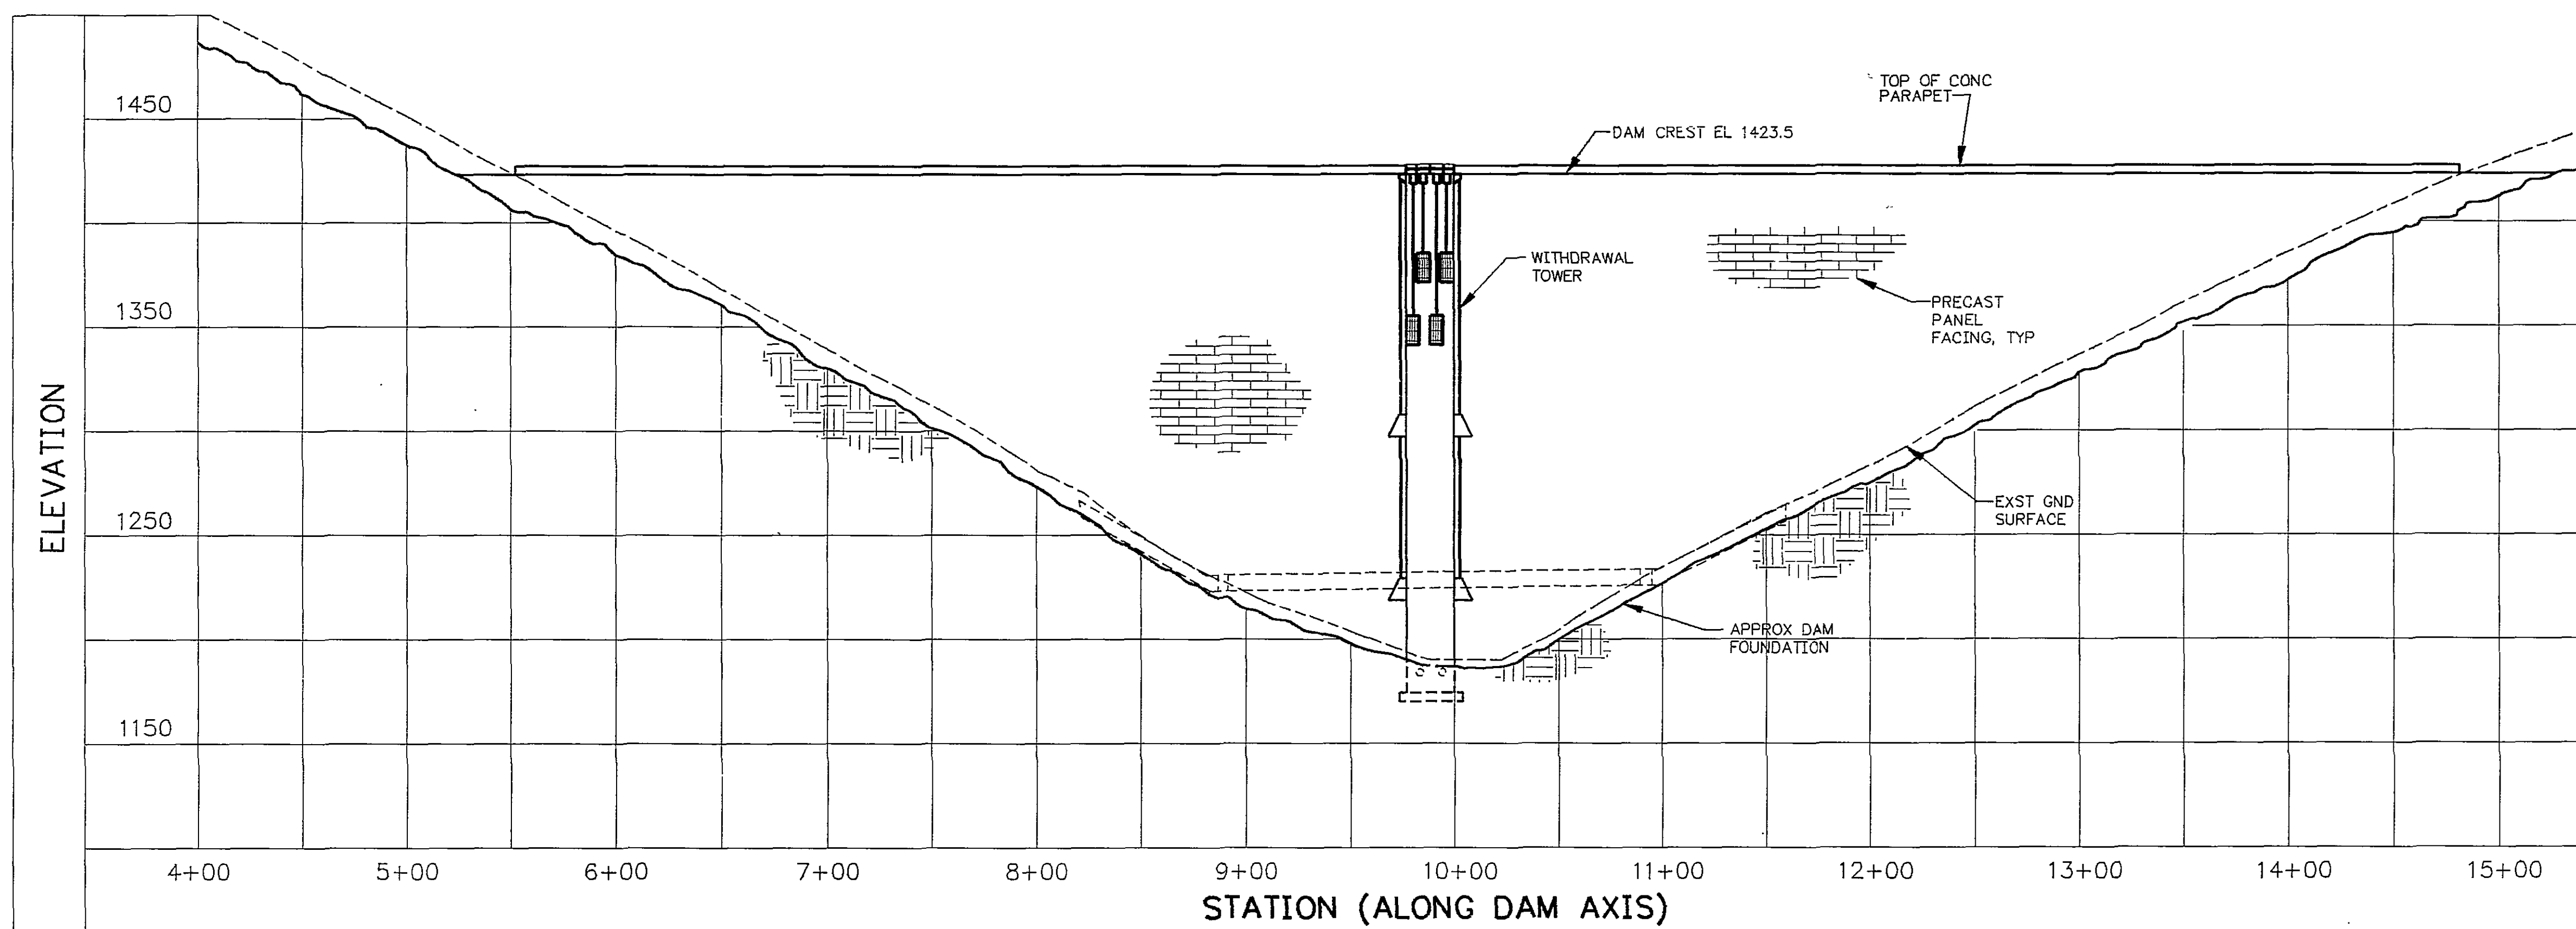

UPSTREAM ELEVATION
SCALE: 1"=50'

ROLLER COMPACTED CONCRETE DAM GENERAL NOTES:

- DAM SHALL BE CLASS I IN ACCORDANCE WITH VIRGINIA DAM SAFETY REGULATIONS/1989.
- DAM HEIGHT FROM CREST TO STREAMBED AT TOE OF DAM IS 240.5 FT.
- DAM WAS DESIGNED TO ALLOW FOR 1.25 FT OF EROSION ON DOWN STREAMFACE.
- DESIGN LOADS
 - WIND LOADS ARE BASED ON A BASIC SPEED OF 70 MPH, EXPOSURE B (IN ACCORDANCE WITH VIRGINIA UNIFORM STATEWIDE BUILDING CODE / BOCA 1987).
 - EARTHQUAKE LOADS ARE BASED ON A PSEUDOSTATIC ANALYSIS WITH, 1) AN ACCELERATION OF 0.1g PLUS HYDRODYNAMIC EFFECTS AT NORMAL POOL FOR UPSTREAM GROUND MOTION AND 2) AN ACCELERATION OF 0.05g WITH RESERVOIR EMPTY FOR DOWNSTREAM GROUND MOTION.
 - ICE PRESSURE IS 5 KIPS PER FT AT NORMAL POOL.
- STABILITY
 - BASE DESIGNED TO REMAIN IN COMPRESSION FOR ALL LOAD CASES EXCEPT EARTHQUAKE LOADINGS.
 - SLIDING STABILITY ANALYSIS IS IN ACCORDANCE WITH THE LIMIT EQUILIBRIUM METHOD WITH THE FOLLOWING PARAMETERS:

INTERFACE	FRICITION ANGLE	COHESION
CONC/ROCK INTERFACE	46°	25 psi
RCC LIFT INTERFACE	45°	0 psi
- MATERIALS


MATERIAL	STRENGTH
CONCRETE	
ROLLER COMPACTED CONCRETE (RCC)	f'c=1200 psi @ 28 DAYS f'c=2000 psi @ 90 DAYS f'c=2500 psi @ 365 DAYS
CLASS A: FOR PARAPET WALL, TOPPING, SLAB AT CREST, AND ALL OTHER CONCRETE NOT SPECIFIED	f'c=4000 psi @ 28 DAYS
CLASS C: FOR ALL CONCRETE INDICATED AS BEDDING, BACKING, DENTAL AND FILL	f'c=2500 psi @ 28 DAYS
REINFORCING BARS	f _y =60 ksi
ASTM A 615 GRADE 60, DEFORMED	

RECORD DRAWINGS
THESE DRAWINGS RECORDED ON THE BASIS OF INFORMATION FURNISHED BY THE CONTRACTOR OR SPECIFICALLY KNOWN TO HSM. NO OTHER REPRESENTATIONS ARE MADE OR IMPLIED.
Date: 6-5-95



GRAPHIC SCALES

DESIGNED	WJ, RWF, CJ	DATE	4/26/91	REVISIONS					
DRAWN	DAB	DATE	4/26/91	DATE	BY	DESCRIPTION	DATE	BY	DESCRIPTION
CHECKED	AWP	DATE	4/26/91	8-15-94	BA	PER CONTR RECORD DWG			
APPROVED		DATE	4/26/91	8-24-94	JBH	ISSUED TO VA DAM SAFETY			
ISSUED	APBj	DATE	8/21/91	9-31-97	RWF	RECORD DRAWING			

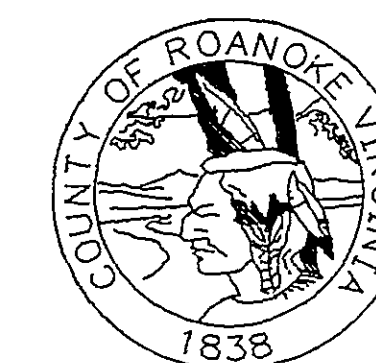

SPRING HOLLOW RESERVOIR
ROANOKE COUNTY, VIRGINIA
HAYES, SEAY, MATTERN & MATTERN, INC.
ARCHITECTS - ENGINEERS - PLANNERS
ROANOKE, VIRGINIA

STRUCTURAL
DAM PLAN, ELEVATION AND SECTION

SCALE	DATE	COMM	SHEET	DWG
AS NOTED	8/4/91	4194E	S-1	30